


**KELWOOD DEVELOPMENT COMPANY  
4S RANCH SANITATION DISTRICT  
4S RANCH WWTP EXPANSION AND RELATED PROJECTS**


**NEIGHBORHOOD NO. 1 PUMP STATION**

**NOVEMBER 2001**

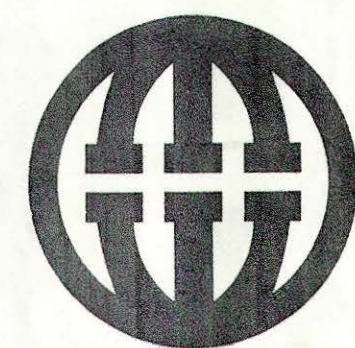

**MONTGOMERY WATSON**




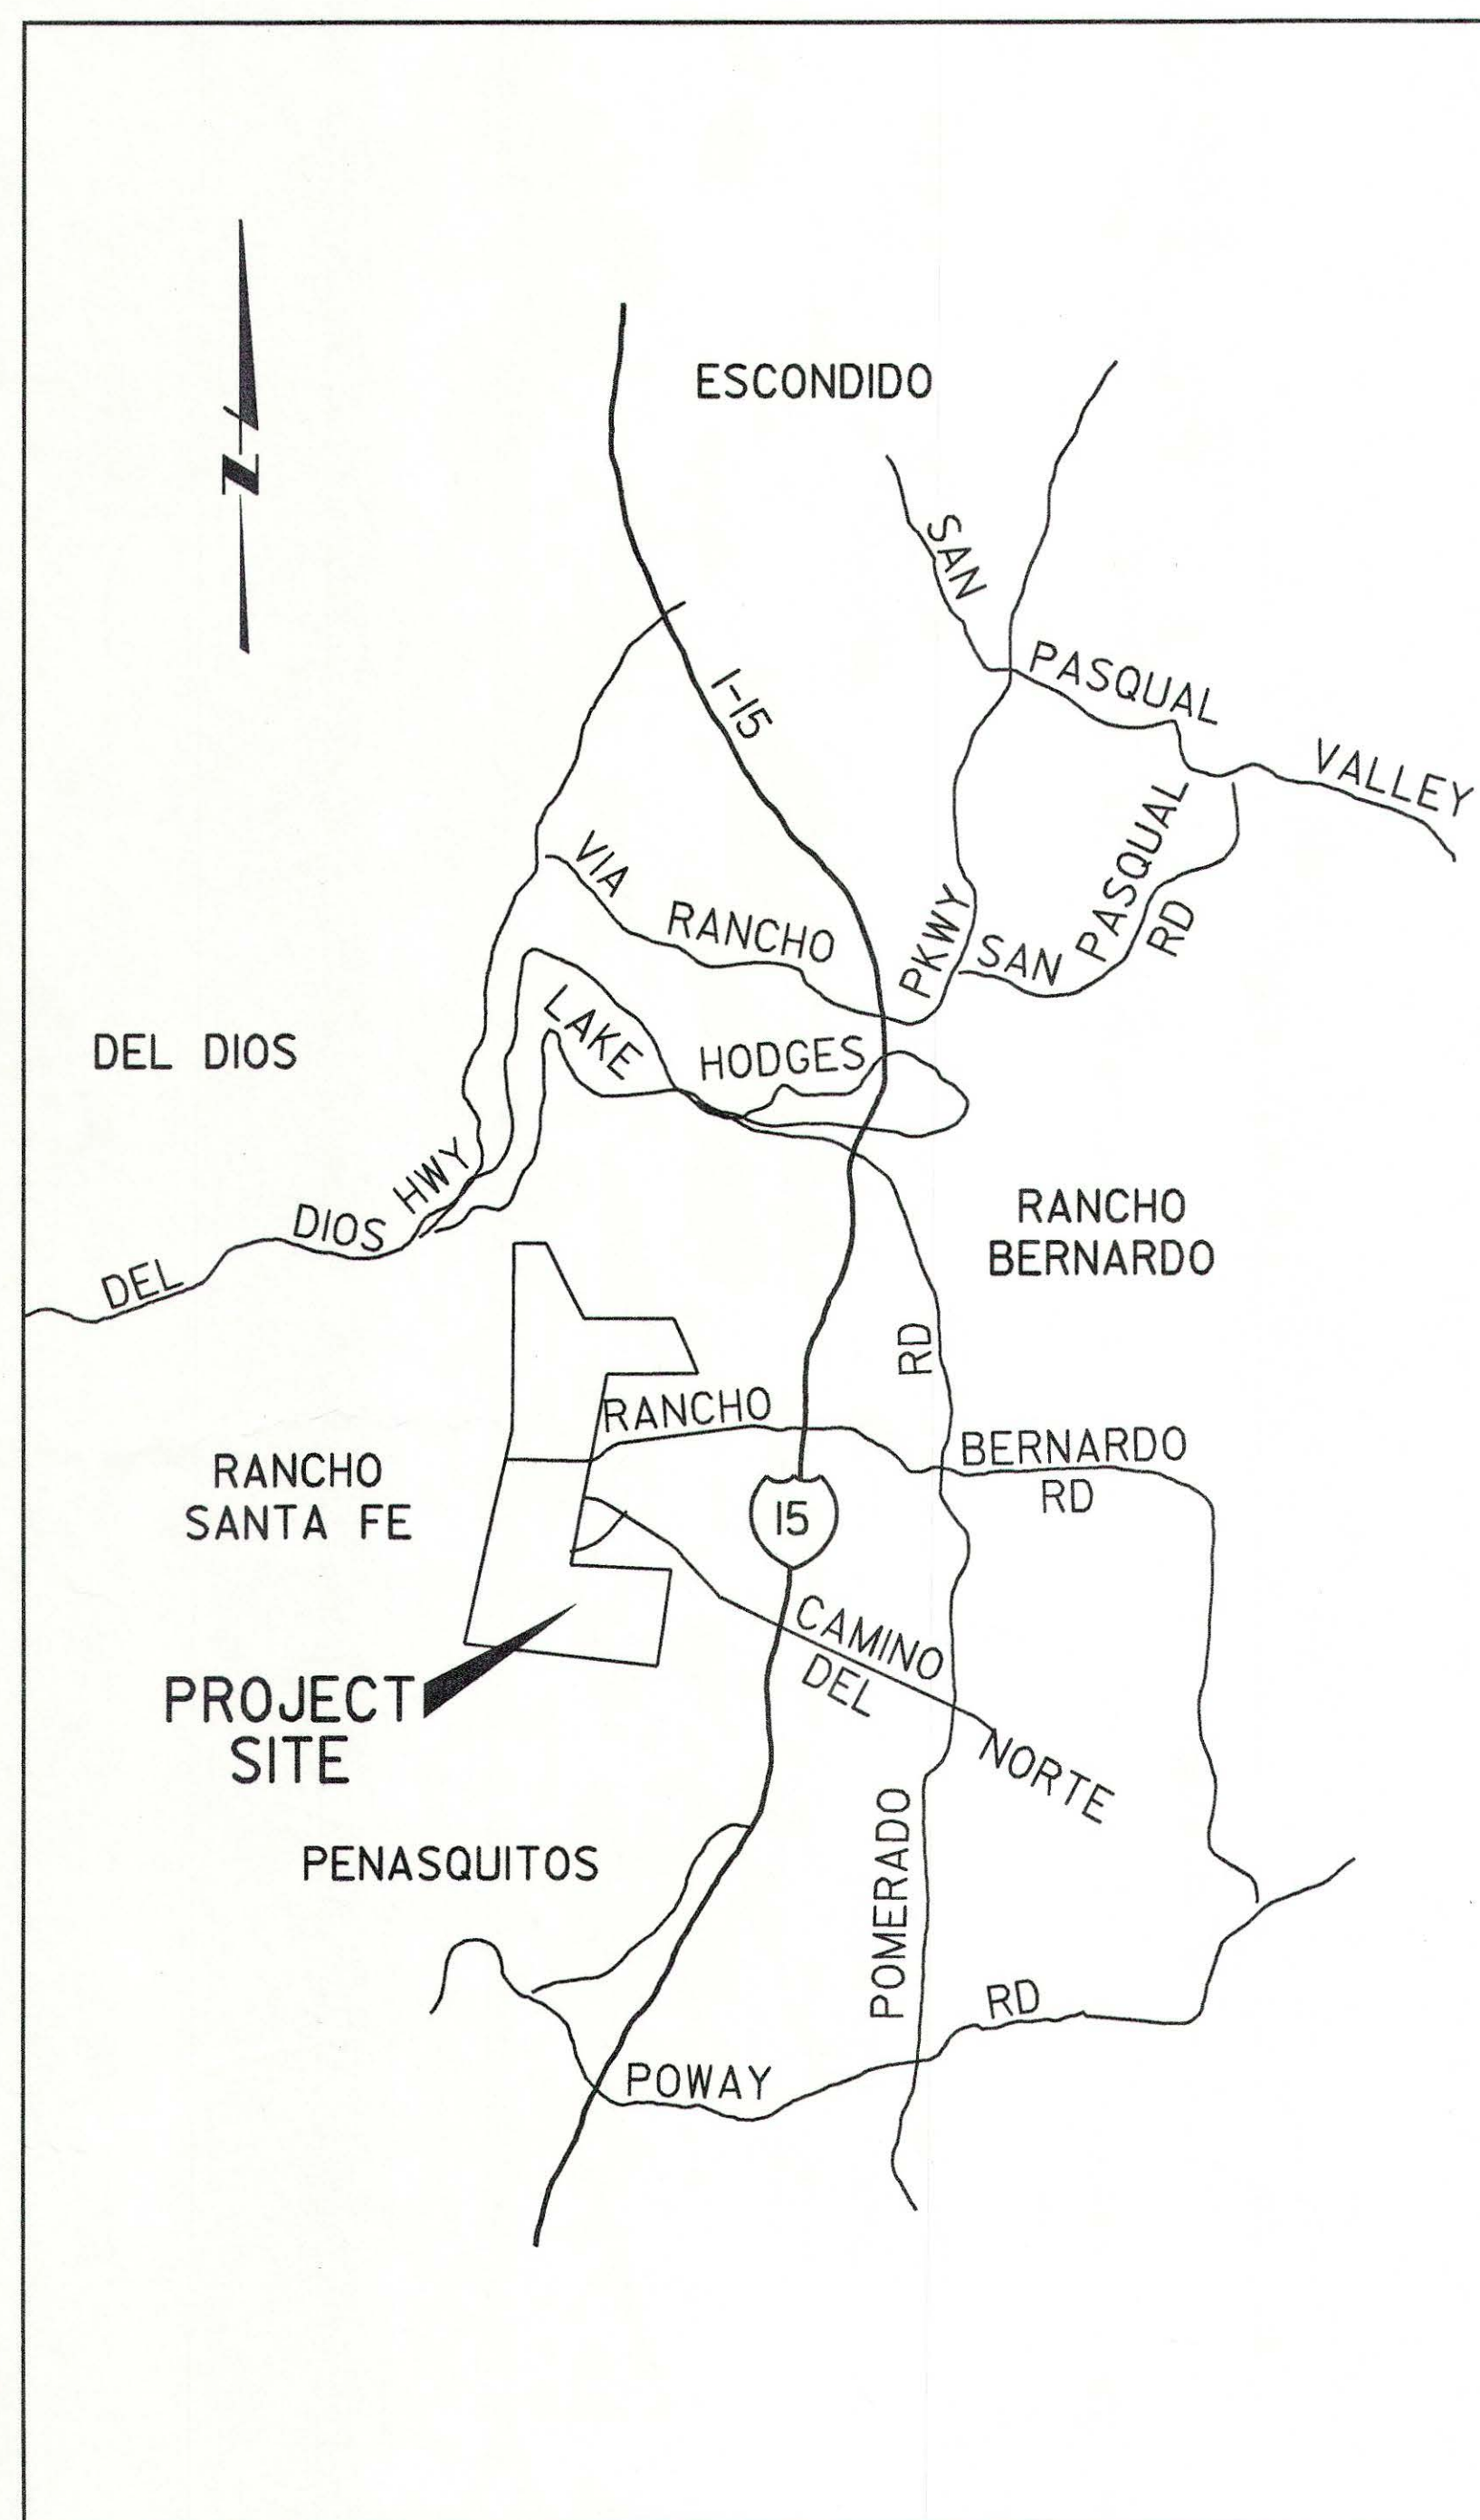

**VICINITY MAP**  
N.T.S.

The limited review of this document by PBS & J on behalf of the Olivenhain Municipal Water District is intended as a limited review only for general conformance with: (1) This approved Design/Build documents, (2) Accepted standards of practice within the industry, and (3) The standards of the Olivenhain Municipal Water District. This limited review is not intended to, nor shall it act, to relieve the Design/Build Team of any professional liability to the responsibility to provide a complete and functional facility that is compliant with all applicable specifications, standards, codes, and regulations.

PBS & J  
Date 12/13/01 By *[Signature]*

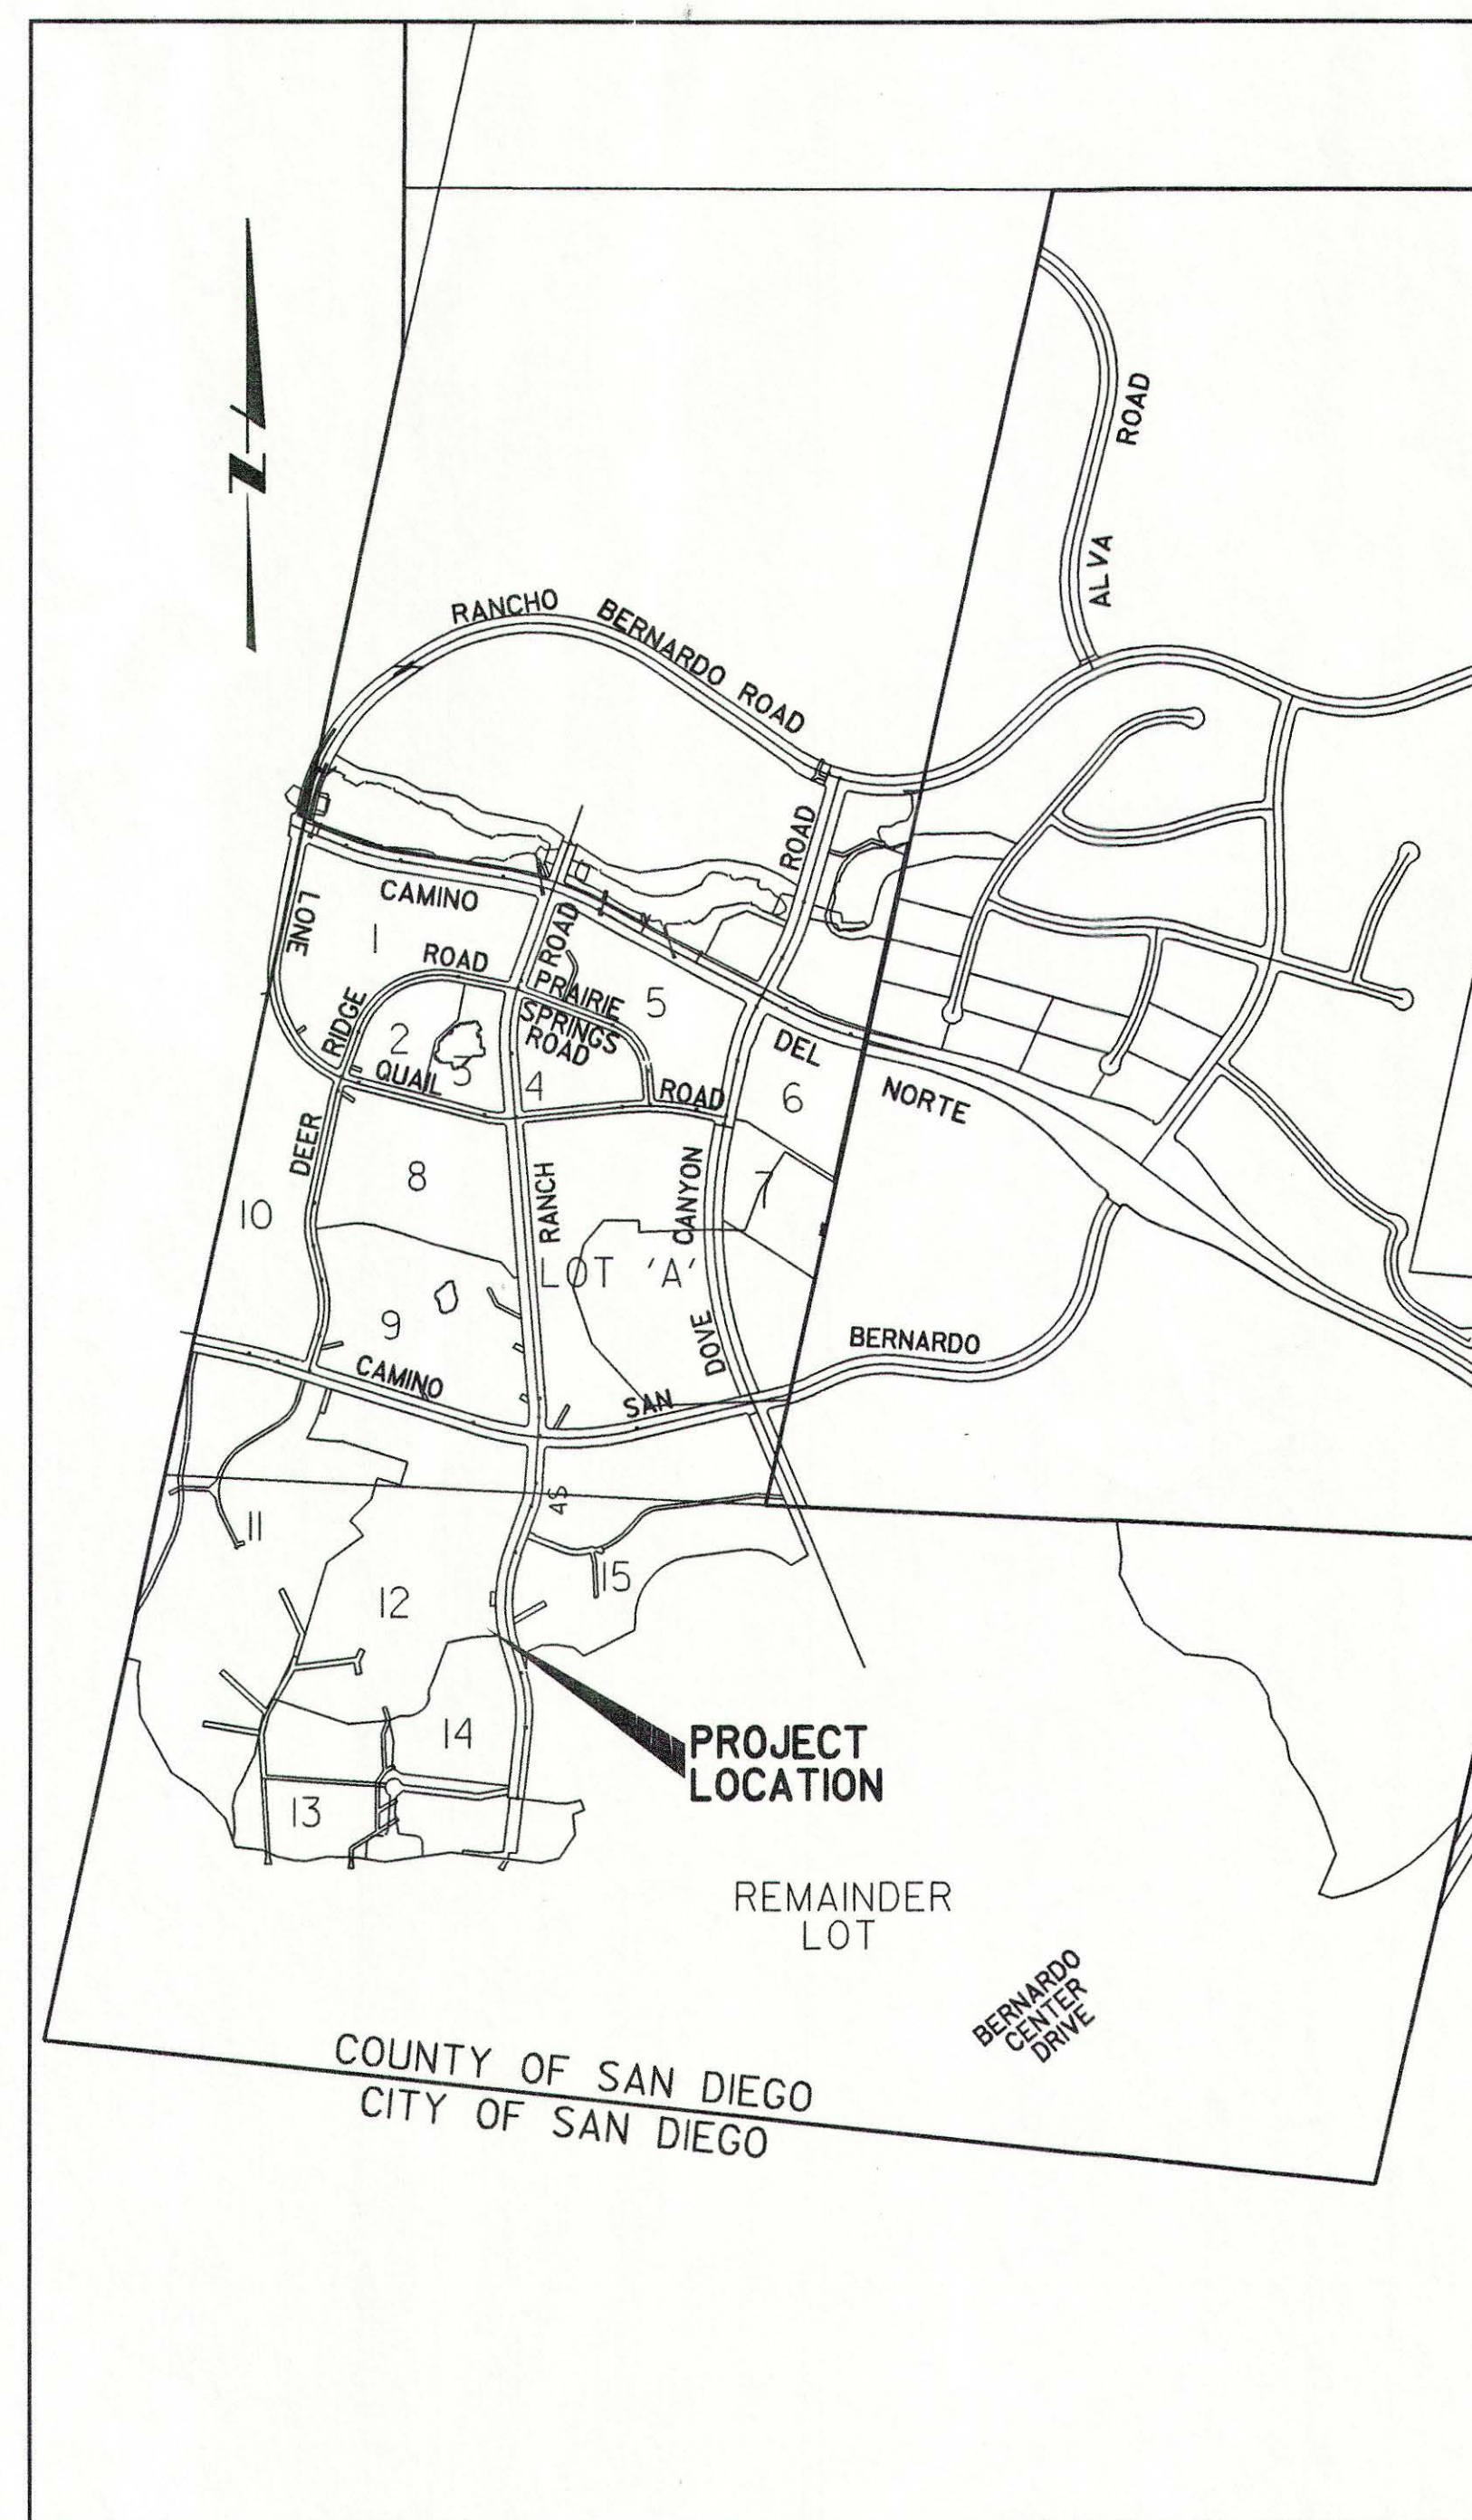

**LOCATION MAP**  
N.T.S.

## GENERAL

- ✓G-0 COVER SHEET
- ✓G-1 VICINITY MAP, LOCATION MAP AND LIST OF DRAWINGS
- G-2 SYMBOLS
- G-3 ABBREVIATIONS

## CIVIL

- GC-1 CIVIL GENERAL NOTES
- GC-2 CIVIL STANDARD DETAILS - 1
- GC-3 CIVIL STANDARD DETAILS - 2
- GC-4 CIVIL STANDARD DETAILS - 3
- I2C-1 HORIZONTAL CONTROL AND PAVING PLAN
- I2C-2 GRADING AND DRAINAGE PLAN
- ✓I2C-3 YARD PIPING PLAN
- I2C-4 HORIZONTAL CONTROL AND CALL-OUT DATA

## ARCHITECTURAL

- GA-1 ARCHITECTURAL DETAILS
- I2A-1 ARCHITECTURAL FLOOR PLAN AND ELEVATIONS

## MECHANICAL

- ✓GM-1 MECHANICAL EQUIPMENT LIST
- GM-2 MECHANICAL STANDARD DETAILS - 1
- GM-3 MECHANICAL STANDARD DETAILS - 2
- ✓I2M-1 NEIGHBORHOOD NO.1 PUMP STATION - PLAN
- ✓I2M-2 NEIGHBORHOOD NO.1 PUMP STATION - SECTION
- I2M-3 NEIGHBORHOOD NO.1 PUMP STATION - FERRIC CHLORIDE FEED AND STORAGE FACILITY
- ✓I2M-4 NEIGHBORHOOD NO.1 PUMP STATION - PROCESS SCHEMATIC
- I2M-5 NEIGHBORHOOD NO.1 PUMP STATION - GENERATOR PAD AND FUEL TANK
- I2M-6 NEIGHBORHOOD NO.1 PUMP STATION - STORM WATER P.S. PLAN AND PROFILE

## STRUCTURAL

- GS-1 GENERAL NOTES AND CONSTRUCTION JOINT DETAILS
- GS-2 STANDARD DETAILS - I
- GS-3 STANDARD DETAILS - II
- GS-4 STANDARD DETAILS - III
- GS-5 STANDARD DETAILS - IV
- GS-6 STANDARD DETAILS - V
- GS-7 STANDARD DETAILS - VI
- GS-8 STANDARD DETAILS - VII
- I2S-1 NEIGHBORHOOD NO.1 PUMP STATION - PLANS
- I2S-2 NEIGHBORHOOD NO.1 PUMP STATION - SECTIONS
- I2S-3 NEIGHBORHOOD NO.1 PUMP STATION - FERRIC CHLORIDE FEED AND STORAGE FACILITY
- I2S-4 NEIGHBORHOOD NO.1 PUMP STATION - GENERATOR PAD AND FUEL TANK

## ELECTRICAL

- GE-1 NEIGHBORHOOD NO.1 PUMP STATION - ELECTRICAL SYMBOLS
- GE-2 NEIGHBORHOOD NO.1 PUMP STATION - ELECTRICAL ABBREVIATIONS AND GENERAL NOTES
- GE-3 NEIGHBORHOOD NO.1 PUMP STATION - ELECTRICAL STANDARD DETAILS - 1
- GE-4 NEIGHBORHOOD NO.1 PUMP STATION - ELECTRICAL STANDARD DETAILS - 2
- E-1 NEIGHBORHOOD NO.1 PUMP STATION - ELECTRICAL SITE PLAN
- E-2 NEIGHBORHOOD NO.1 PUMP STATION - SINGLE LINE DIAGRAM AND EQUIPMENT ELEVATION
- ✓E-3 NEIGHBORHOOD NO.1 PUMP STATION - SCHEMATIC DIAGRAMS
- ✓E-3.1 NEIGHBORHOOD NO.1 PUMP STATION - SCHEMATIC DIAGRAMS - 2
- E-4 NEIGHBORHOOD NO.1 PUMP STATION - PANEL, FIXTURE AND CONDUIT SCHEDULES
- I2E-1 NEIGHBORHOOD NO.1 PUMP STATION - LIGHTING AND RECEPTACLE PLAN
- ✓I2E-2 NEIGHBORHOOD NO.1 PUMP STATION - POWER AND CONTROL PLAN
- I2E-3 NEIGHBORHOOD NO.1 PUMP STATION - FERRIC CHLORIDE FEED FACILITY ELECTRICAL PLAN
- I2E-4 NEIGHBORHOOD NO.1 PUMP STATION - GENERATOR PAD AND FUEL TANK ELECTRICAL PLAN

## INSTRUMENTATION

- GI-1 NEIGHBORHOOD NO.1 PUMP STATION INSTRUMENTATION ABBREVIATIONS & SYMBOLS - I
- GI-2 NEIGHBORHOOD NO.1 PUMP STATION INSTRUMENTATION ABBREVIATIONS & SYMBOLS - II
- ✓I2I-1 NEIGHBORHOOD NO.1 PUMP STATION P & ID - I
- ✓I2I-2 NEIGHBORHOOD NO.1 PUMP STATION P & ID - II
- ✓I2I-3 NEIGHBORHOOD NO.1 PUMP STATION FERRIC CHLORIDE FEED SYSTEM P & ID
- ✓I2I-4 NEIGHBORHOOD NO.1 PUMP STATION UTILITY WATER SYSTEM P & ID



SCALE AS SHOWN WARNING IF THIS BAR DOES NOT MEASURE 1" THEN DRAWING IS NOT TO SCALE				DESIGNED N. NAZARIAN DRAWN N. NAZARIAN CHECKED T. BUI		SUBMITTED BY <i>[Signature]</i> PROJECT MANAGER DATE 11/5/01 COMPANY OFFICER		43137 LICENSE NO. 33699 LICENSE NO.		11/5/01 DATE 11/5/01 DATE		APPROVED <i>[Signature]</i> OLIVENHAIN MWD APPROVED FILANC CONSTRUCTION CO.		1/2/02 DATE		KELWOOD DEVELOPMENT COMPANY 4S RANCH SANITATION DISTRICT WASTEWATER TREATMENT PLANT EXPANSION TO 2.0 MGD NEIGHBORHOOD NO.1 PUMP STATION VICINITY MAP, LOCATION MAP, AND LIST OF DRAWINGS		SHEET G-1 OF 5 SHEETS	
--	--	--	--	---	--	---	--	--	--	------------------------------------	--	--	--	----------------	--	--	--	-----------------------------	--



	MASONRY
	CAST IRON
	STEEL
	BRONZE
	INSULATION
	GRAVEL
	CONCRETE
	EARTH
	SAND
	ALUMINUM OR METAL DECKING
	CHECKERED PLATE
	GRATING
	PLASTIC, RUBBER OR NEOPRENE
	WOOD (FINISH)
	WOOD (ROUGH FRAMING) OR OPENING OR DEPRESSION IN SLAB OR WALL
	DUCT (FIRST DIMENSION DUCT SIDE SHOWN, SECOND DIMENSION DUCT SIDE NOT SHOWN)
	SUPPLY OR OUTSIDE AIR DUCT (FIRST DIMENSION, DUCT WIDTH)
	EXHAUST OR RETURN AIR DUCT (FIRST DIMENSION, DUCT WIDTH)
	CEILING SUPPLY DIFFUSER (SIZE IN INCHES)
	CEILING RETURN OR EXHAUST AIR GRILLE OR REGISTER (SIZE IN INCHES, WIDTH X HEIGHT)
	EXHAUST OR RETURN AIR GRILLE OR REGISTER (SIZE IN INCHES, WIDTH X HEIGHT)
	SUPPLY GRILLE OR REGISTER (SIZE IN INCHES, WIDTH X HEIGHT)
	AIR TURNING VANES IN DUCT
	DEFLECTING DAMPER
	FHC FIRE HOSE CABINET
	FE FIRE EXTINGUISHER
	UNIT HEATER
	CENTERLINE
	PROPERTY LINE
	NEW STRUCTURE OR FACILITY
	EXISTING STRUCTURE OR FACILITY
	FUTURE STRUCTURE OR FACILITY
	NEW FENCE
	EXISTING FENCE
	NEW PIPELINE (CIVIL SHEETS) 36" DIA. AND LARGER
	NEW PIPELINE (CIVIL SHEETS) 12" DIA. TO 34" DIA.
	NEW PIPELINE (CIVIL SHEETS) 10" DIA. AND SMALLER
	EXISTING PIPELINE



	CONTOUR LINE, FINISHED GRADE
	CONTOUR LINE, EXISTING GRADE
	FINISHED ELEVATION
	EXISTING ELEVATION
	CUT OR FILL SLOPE TO BE CONSTRUCTED
	NEW A.C. PAVING
	EXISTING A.C. PAVING
	RAILROAD
	FH FIRE HYDRANT
	MH MANHOLE
	PCOTG PRESSURE CLEANOUT TO GRADE
	WCO WALL CLEANOUT
	FCO FLOOR CLEANOUT
	COTG CLEANOUT TO GRADE
	BLOW OFF ASSEMBLY
	HUB DRAIN
	FLOOR DRAIN
	FLOOR SINK
	DRAIN TRAP
	SOIL BORING
	BENCHMARK
	HORIZONTAL AND VERTICAL CONTROL POINT
	VAULT OR JUNCTION STRUCTURE
	CHANGE IN PIPING MATERIAL
	ROUND OR DIAMETER
	SQUARE
	AT
	ANGLE
	24" RW-RCP PIPE SIZE, FLUID ABBREVIATION AND TYPE OF PIPE
	2" UW (2) PIPE CALLOUT (SEE PIPING SCHEDULE)
	ME-2 EQUIPMENT NUMBER (SEE EQUIPMENT SCHEDULE)
	BACKWATER VALVE
	BACKFLOW PREVENTER
	STOP GATE
	SLIDE GATE
	SLUICE GATE

	GATE VALVE, BURIED WITH VALVE BOX
	BUTTERFLY VALVE, BURIED WITH VALVE BOX
	ECCENTRIC PLUG VALVE, BURIED WITH VALVE BOX
	LUBRICATED PLUG VALVE, BURIED WITH VALVE BOX
	GATE VALVE
	BUTTERFLY VALVE
	ECCENTRIC PLUG VALVE
	LUBRICATED PLUG VALVE
	GLOBE VALVE
	BALL VALVE
	DIAPHRAGM VALVE
	CHECK VALVE
	PRESSURE REGULATING VALVE
	BACK-PRESSURE VALVE
	MOTOR OPERATOR FOR VALVES (M = ELECTRIC, P = PNEUMATIC)
	TEMPERATURE CONTROL VALVE
	SOLENOID VALVE
	MULTI-PORT VALVE - 3 WAY
	MULTI-PORT VALVE - 4 WAY
	FLOAT OPERATED VALVE
	NEEDLE VALVE
	PRESSURE RELIEF VALVE
	ANGLE VALVE
	HOSE BIBB (H/B)
	BUBBLER LEVEL CONTROL
	CENTRIFUGAL OR TURBINE PUMP OR FAN
	METERING PUMP
	PROGRESSING CAVITY, POSITIVE DISPLACEMENT PUMP
	BLOWER OR COMPRESSOR
	INJECTOR OR EDUCTOR
	FLAME ARRESTER
	AIR VACUUM AND AIR RELEASE ASSEMBLY
	THERMOMETER
	PIPE ANCHOR



	ROOM THERMOSTAT
	PRESSURE GAUGE
	PRESSURE GAUGE WITH DIAPHRAGM SEAL
	PRESSURE SWITCH
	PRESSURE SWITCH WITH DIAPHRAGM SEAL
	FLANGED FITTING
	WELDED FITTING
	MECHANICAL-TYPE FITTING (GROOVED)
	SCREWED, SOCKET-WELD, BELL AND SPIGOT OR HUBLESS FITTING
	SLEEVE-TYPE COUPLING
	FLANGED ADAPTER COUPLING
	FLANGED ADAPTER - SET SCREW TYPE
	EXPANSION JOINT
	MECHANICAL TYPE COUPLING
	FLEXIBLE COUPLING
	UNION
	QUICK DISCONNECT COUPLER
	CAPPED END OR PLUGGED END
	BLIND FLANGE
	REDUCER OR INCREASER
	CUT PIPE
	STRAINER
	DRAIN
	FLOW TUBE
	MAGNETIC METER
	DENSITY METER
	PROPELLER METER
	ORIFICE PLATE AND FLANGES
	ROTAMETER
	CONDENSATE TRAP
	PIPE SUPPORT (IN PLAN ONLY)
	CATCH BASIN
	PULSATION DAMPENER
	EXPANSION CHAMBER WITH RUPTURE DISC
	RUPTURE DISC
	FLOW SIGHT

## SECTION AND DETAIL IDENTIFICATION



## SECTION IDENTIFICATION

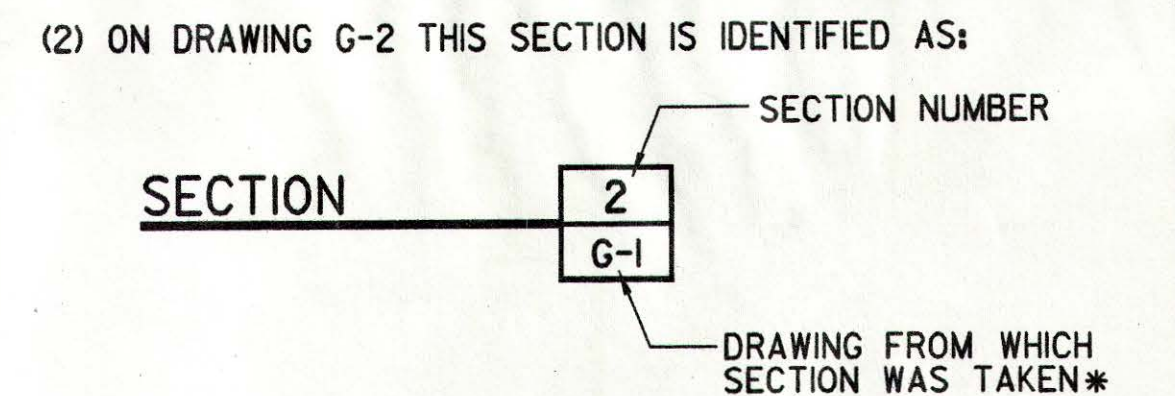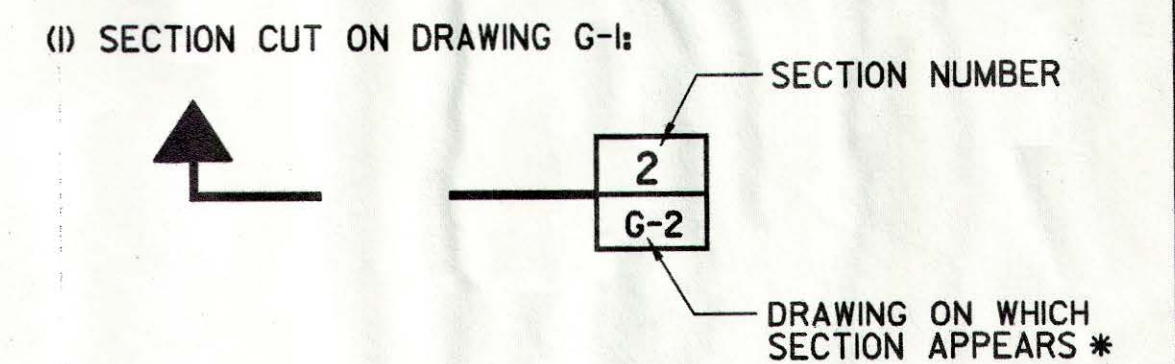

## DETAIL IDENTIFICATION

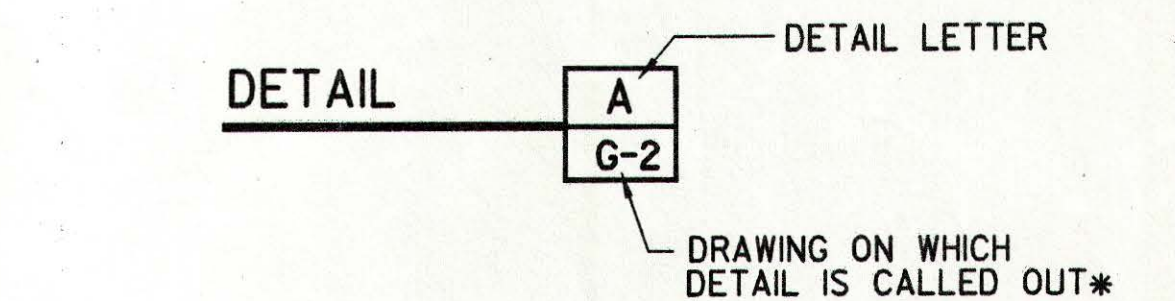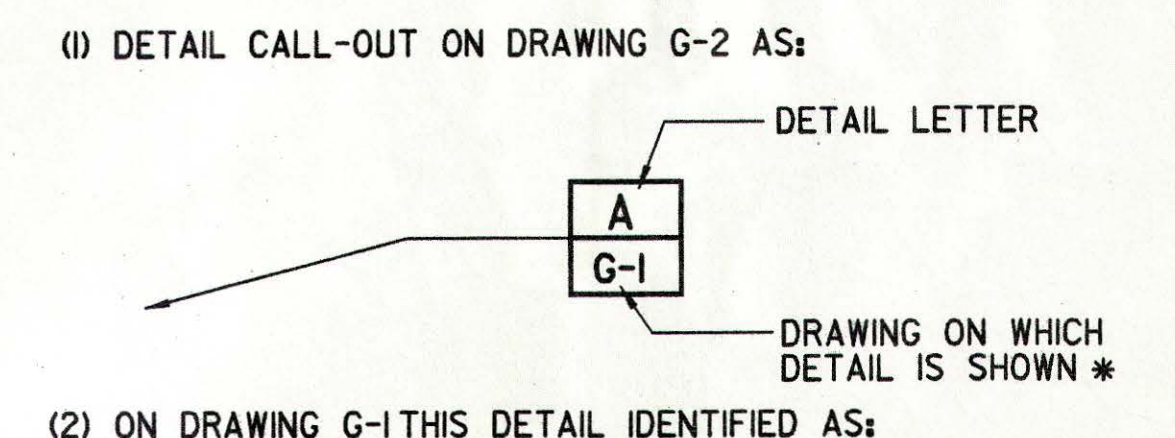

## STANDARD DETAIL IDENTIFICATION

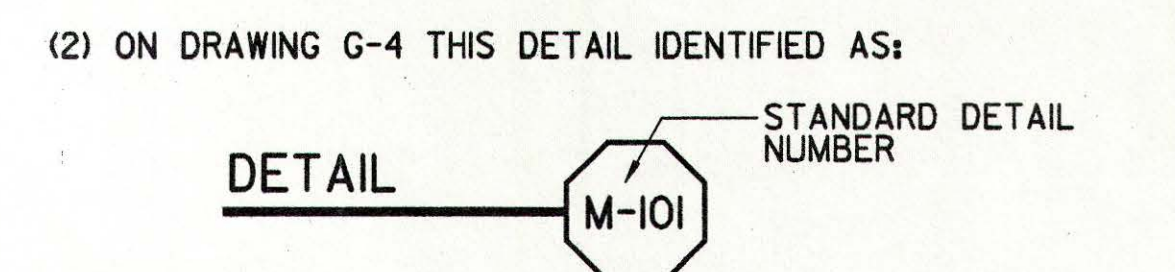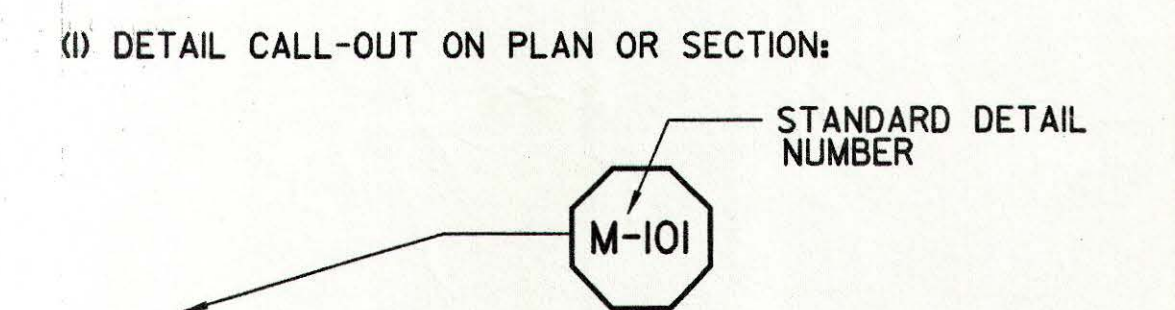

\*NOTE: IF PLAN AND SECTION (OR DETAIL CALL-OUT AND DETAIL) ARE SHOWN ON SAME DRAWING, DRAWING NUMBER IS REPLACED BY A LINE.

## NOTES:

- (1) ELECTRICAL SYMBOLS SHOWN ON ELECTRICAL SHEETS.  
 (2) FOR WELDING SYMBOLS USE AMERICAN WELDING SOCIETY STANDARD SYMBOLS. SEE AMERICAN INSTITUTE OF STEEL CONSTRUCTION MANUAL.

The limited review of this document by PBS & J on behalf of the Olivenhain Municipal Water District is intended as a limited review only for general conformance with: (1) This approved standard documents, (2) Accepted standards of practice within the industry, and (3) The standards of the Olivenhain Municipal Water District. This limited review is not intended, nor shall it act, to relieve the Design/Build Team of any professional liability to the responsibility to provide a complete and functional facility that is compliant with all applicable specifications, standards, codes, and laws.

PBS &amp; J

Date: 8/23/01

APPROVED

George R. Bunt

OLIVENHAIN MWD

APPROVED

FILANC CONSTRUCTION CO.

8.29.01

DATE

DATE

KELWOOD DEVELOPMENT COMPANY

45 RANCH SANITATION DISTRICT

WASTEWATER TREATMENT PLANT EXPANSION TO 2.0 MGD

SYMBOLS

SHEET

G-2

OF 5 SHEETS

SCALE

NONE

WARNING

0 1/2 1  
 IF THIS BAR DOES NOT MEASURE 1" THEN DRAWING IS NOT TO SCALE

DESIGNED MW

DRAWN MW

CHECKED MW

SUBMITTED BY

George R. Bunt

PROJECT MANAGER

COMPANY OFFICER

50802

LICENSE NO.

DATE

33699

LICENSE NO.

DATE



MONTGOMERY WATSON

Pasadena, California



A AIR  
 AB ANCHOR BOLT  
 ABBR ABBREVIATION  
 ABS ABSOLUTE TEMPERATURE  
 AC ACTIVATED CARBON, ASPHALTIC CONCRETE, OR ALTERNATING CURRENT  
 A/C AIR CONDITIONING  
 ACOUS ACOUSTIC OR ACOUSTICAL  
 ACP ASPHALTIC CONCRETE PAVEMENT OR ASBESTOS CEMENT PIPE  
 ADJ ADJUSTABLE  
 AER AERATION  
 AL ALUMINUM OR ALUM  
 ALUM ALUMINUM  
 AMB AMBIENT  
 ANSI AMERICAN NATIONAL STANDARDS INSTITUTE (FORMERLY A.S.A.)  
 API AMERICAN PETROLEUM INSTITUTE  
 APPD APPROVED  
 APPROX APPROXIMATE  
 ARCH ARCHITECTURAL  
 ASA AMERICAN STANDARDS ASSOCIATION (NOW ANSI)  
 ASME AMERICAN SOCIETY OF MECHANICAL ENGINEERS  
 ASTM AMERICAN SOCIETY FOR TESTING AND MATERIAL  
 ASSY ASSEMBLY  
 AT ACOUSTICAL TILE  
 ATM ATMOSPHERE  
 AVAR AIR VACUUM AND AIR RELEASE VALVE  
 AWWA AMERICAN WATER WORKS ASSOCIATION

BC BEGIN CURVE, BOLT CIRCLE OR BETWEEN CENTERS  
 BCR BEGIN CURB RETURN  
 BD BOARD  
 BF BLIND FLANGE  
 BFP BACK FLOW PREVENTER  
 BHP BRAKE HORSEPOWER  
 BLDG BUILDING  
 BLD FLG BLIND FLANGE  
 BLK BLACK OR BLOCK  
 BLKG BLOCKING  
 BM BEAM OR BENCH MARK  
 BO BLOW-OFF ASSEMBLY  
 BOD BIOCHEMICAL OXYGEN DEMAND  
 BOT BOTTOM  
 BPV BACK PRESSURE VALVE  
 BRK BRICK  
 B & S BELL AND SPIGOT  
 BSMT BASEMENT  
 BT BRITISH THERMAL UNIT  
 BTU BUTTERFLY VALVE  
 BV BEGIN VERTICAL CURVE  
 BVC BEGIN VERTICAL CURVE  
 BWV BACK WATER VALVE

C CENTIGRADE  
 CAB CABINET  
 CAP CAPACITY  
 CB CATCH BASIN OR CHALK BOARD  
 CC CENTER TO CENTER  
 CD CEILING DIFFUSER  
 CLR CLEAR  
 CEM CEMENT  
 CER CERAMIC  
 CFH CUBIC FEET PER HOUR  
 CFM CUBIC FEET PER MINUTE  
 CFS CUBIC FEET PER SECOND  
 CHEM CHEMICAL  
 CHG CHANGE  
 CHK V CHECK VALVE  
 CHKD PL CHECKERED PLATE  
 CI CAST IRON  
 CJ CONSTRUCTION JOINT  
 CLG CHLORINE GAS, CHLORINATOR, CHAIN LINK, CLEARANCE OR CENTERLINE  
 CLOS CLOSE  
 CLR CLEAR  
 CM CENTIMETER  
 CML & C CEMENT MORTAR LINED AND COATED  
 CMP CORRUGATED METAL PIPE  
 CMU CONCRETE MASONRY UNIT  
 CO CLEANOUT  
 COL COLUMN  
 CONC CONCRETE OR CONCENTRIC  
 COND CONDENSER OR CONDENSATE  
 CONN CONNECTION  
 CONSTR CONSTRUCTION OR CONSTRUCT  
 CONT CONTINUED OR CONTINUOUS  
 CONTR CONTRACTOR  
 COMP COMPRESSOR  
 COTG CLEAN-OUT TO GRADE  
 CPLG COUPLING  
 CPVC CHLORINATED POLYVINYL CHLORIDE  
 CS CAUSTIC SODA OR CAST STEEL  
 CT CERAMIC TILE  
 CTSK COUNTERSINK  
 CTR CENTER  
 CU COPPER OR CUBIC  
 CYL CYLINDER

d PENNY  
 DBL DOUBLE  
 DC DIRECT CURRENT  
 DET DETAIL  
 DG DRINKING FOUNTAIN OR DOUGLAS FIR  
 DI DOOR GRILLE  
 DIA DUCTILE IRON  
 DIA DIAMETER  
 DIAG DIAGONAL  
 DIAPH DIAPHRAGM  
 DISCH DISCHARGE  
 DISP DISPENSER  
 DN DOWN OR DECAANT  
 DO DISSOLVED OXYGEN  
 DR DOOR OR DRAIN  
 DS DRENCH SHOWER AND EYE WASH  
 DWG DRAWING  
 DIFF DIFFUSER OR DIFFERENTIAL

E EAST  
 EA EACH  
 EB EXPANSION BOLT OR ANCHOR  
 EC END CURVE  
 ECC ECCENTRIC  
 ECR END CURB RETURN  
 EF EACH FACE OR EXHAUST FAN  
 EFF EFFLUENT  
 EG EXHAUST GRILLE OR EXISTING GRADE  
 EL ELEVATION  
 ELEC ELECTRICAL OR ELECTRONIC  
 ENG ENGINE  
 EPT ETHYLENE PROPYLENE  
 ENCL ENCLOSURE  
 ENT ENTRANCE  
 EQ EQUAL  
 EQUIP EQUIPMENT  
 EVAP EVAPORATOR  
 EVC END VERTICAL CURVE  
 EW EACH WAY OR EYE WASH  
 EXH EXHAUST  
 EX-HY EXTRA HEAVY  
 EXIST EXISTING  
 EXP JT EXPANSION JOINT  
 EXT EXTERIOR OR EXTENSION  
 EXTR EXTRUDED

F FAHRENHEIT OR FINISH  
 FABR FABRICATION, FABRICATE OR FABRICATED  
 FAI FRESH AIR INTAKE  
 FB FLAT BAR, FLOOR BEAM OR FIELD BOOK  
 FCO FLOOR CLEANOUT  
 FD FLOOR DRAIN  
 FE FEEDER  
 FE FIRE EXTINGUISHER OR FINAL EFFLUENT  
 FEM FEMALE (PIPE THREAD)  
 FF FLAT FACE OR FAR FACE  
 F TO F FACE TO FACE  
 FG FINISHED GRADE  
 FH FIRE HYDRANT  
 FIG FIGURE  
 FIN FINISHED  
 FIX FIXTURE  
 FL FLOWLINE OR FLOOR  
 FLEX FLEXIBLE  
 FLOCC FLOCCULATOR OR FLOCCULATION  
 FLG FLANGE OR FLOORING  
 FLGD FLANGED  
 FLR FLOOR  
 FM FACTORY MUTUAL (LAB. APPROVED)  
 FMH FLEXIBLE METAL HOSE  
 FND FOUNDATION  
 FOC FACE OF CONCRETE  
 FOM FACE OF MASONRY  
 FOS FACE OF STUDS  
 FOW FACE OF WALL  
 FPC FLEXIBLE PIPE COUPLING  
 FPM FEET PER MINUTE  
 FPS FEET PER SECOND  
 FR FRAME  
 FRP FIBERGLASS REINFORCED PLASTIC  
 FS FATHOM, FLOOR SINK, FINISHED SURFACE, FORGED STEEL  
 FT FEET OR FOOT  
 FT.LB FOOT-POUND  
 FTG FOOTING  
 FUT FUTURE

GA GAGE OR GAUGE  
 GAL GALLON  
 GALV GALVANIZED  
 GEN GENERAL OR GENERATOR  
 GFA GROOVED FLANGE ADAPTER  
 GI GALVANIZED IRON  
 GL GLASS  
 GL/BM GLUE LAMINATED BEAM  
 GLV GLOBE VALVE  
 GPD GALLONS PER DAY  
 GPH GALLONS PER HOUR  
 GPM GALLONS PER MINUTE  
 GRD GRADE OR GROUND  
 GR BRK GRADE BREAK OR GRADE CHANGE  
 GRTG GRATING  
 GV GATE VALVE  
 GYP GYPSUM

H/B HOSE BIBB  
 HDR HEADER  
 HDW HARDWARE  
 HEX HEXAGONAL  
 HQ MERCURY  
 HGR HANGER  
 HGT HEIGHT  
 HM HOLLOW METAL  
 HORIZ HORIZONTAL  
 HP HORSEPOWER OR HIGH PRESSURE  
 H/P HIGH POINT  
 HTG HEATING RETURN OR HOUR  
 HTG HEATING  
 HTR HEATER  
 H & V HEATING AND VENTILATING  
 HVAC HEATING, VENTILATING AND AIR CONDITIONING  
 HWL HIGH/WATER LEVEL  
 HWD HARDWOOD  
 HWO HANDWHEEL OPERATED  
 HV HORIZONTAL AND VERTICAL CONTROL POINT  
 HYD HYDRAULIC OR HYDRANT

ID INSIDE DIAMETER  
 IF INSIDE FACE  
 IN INCH  
 INFL INFLUENT  
 IN LB IN-POUND  
 INSL INSULATION OR INSULATED  
 INSTR INSTRUMENT  
 INT INTERIOR  
 INV INVERT ELEVATION  
 IP IRON PIPE  
 IPS IRON PIPE SIZE  
 IRRG IRRIGATION

JAN JANITOR  
 JT JOINT

K KELVIN, KILO OR KARAT  
 KG KILOGRAM  
 KM KILOMETER  
 KV KILOVOLT  
 KW KILOWATT  
 KWH KILOWATT HOUR

L/P LOW POINT  
 L LITER OR LENGTH  
 LAB LABORATORY  
 LAM LAMINATED  
 LAV LAVATORY  
 LB POUND  
 LDG LANDING  
 LEV LEVEL  
 LG LENGTH OR LONG  
 LT LEFT OR LIGHT  
 LWL LOW WATER LEVEL  
 LWR LOWER

M METER OR MALE (PIPE THREAD)  
 MAG MAGNETIC  
 MAN MANUAL  
 MACH MACHINE  
 MAX MAXIMUM  
 MCC MOTOR CONTROL CENTER  
 MECH MECHANICAL  
 MED MEDIUM  
 MEMB MEMBRANE  
 MFR MANUFACTURER  
 MFR'D MANUFACTURED  
 MGD MILLION GALLONS PER DAY  
 MH MANHOLE  
 MI MALLEABLE IRON  
 MICRON 1/1,000,000 METER  
 MIL MILITARY, 1/1,000 INCH  
 MIN MINIMUM OR MINUTE  
 MIR MIRROR  
 MISC MISCELLANEOUS  
 MK MARK  
 MO MOTOR OPERATED OR MASONRY OPENING  
 MOD MODEL  
 MS MOP SINK  
 MTC MECHANICAL-TYPE COUPLING  
 MTD MOUNTED  
 MTO MOUNTING  
 MTL MATERIAL OR METAL  
 MTR MOTOR

N NORTH  
 NBS NATIONAL BUREAU OF STANDARDS  
 NC NORMALLY CLOSED  
 NEC NATIONAL ELECTRICAL CODE  
 NEMA NATIONAL ELECTRICAL MANUFACTURERS ASSOCIATION  
 NFPA NATIONAL FIRE PROTECTION ASSOCIATION  
 NF NEAR FACE  
 NG NATURAL GRADE OR NATURAL GAS  
 NIC NOT IN CONTRACT  
 NO NUMBER OR NORMALLY OPEN  
 NOM NOMINAL  
 NPS NOMINAL PIPE SIZE (FORMERLY I.P.S.)  
 NPT NATIONAL PIPE THREAD  
 NRS NON-RISING STEM  
 NS NEAR SIDE  
 NTS NOT TO SCALE

OC OVER-CROSSING OR ON CENTER  
 OD OUTSIDE DIAMETER OR OVERALL DIMENSION  
 OF OVERFLOW OR OUTSIDE FACE  
 OFF OFFICE  
 OH OVER HEAD  
 OPER OPERATOR OR OPERATING  
 OPNG OPENING  
 ORW OVERFLOW POND WATER  
 OS & Y OUTSIDE SCREW AND YOKE  
 OWG OIL WATER, GAS  
 OZ OUNCE

P/S POLE AND SHELF  
 P POLE, PAGE OR PIPE  
 PART PARTITION  
 PAVMT PAVEMENT  
 PB POLYBUTYLENE  
 PC PRIMARY CLARIFIER OR PORTLAND CEMENT  
 PCC PORTLAND CEMENT CONCRETE  
 PCOTG PRESSURE CLEANOUT TO GRADE  
 PE PLANT EFFLUENT, POLYELECTROLYTE POLYMER OR POLYETHYLENE  
 PG PRESSURE GAGE  
 PH HYDROGEN ION CONCENTRATION  
 PI PLANT INFLUENT OR POINT OF INTERSECTION  
 PLAS PLATE, PROPERTY LINE OR PLACE  
 PLYWD PLYWOOD  
 PNEU PNEUMATIC  
 PNL PANEL  
 PM PRESSED METAL  
 PP POWER POLE OR POLYPROPYLENE  
 PLT PLANT  
 PPD POUNDS PER DAY  
 PPH POUNDS PER HOUR  
 PPM PARTS PER MILLION  
 PR PRECAST  
 PRCT PREFABRICATED  
 PRESS PRESSURE  
 PRV PRESSURE REGULATING, RELIEF OR REDUCING VALVE  
 PS PRESSURE SWITCH  
 PSF POUNDS PER SQUARE FOOT  
 PSI POUNDS PER SQUARE INCH  
 PSIA POUNDS PER SQUARE INCH ABSOLUTE  
 PSIG POUNDS PER SQUARE INCH GAUGE  
 PT PAINT  
 PTDF PRESSURE TREATED DOUGLAS FIR  
 PTFE POLYTETRAFLUOROETHYLENE (TEFLON®)  
 PUG VALVE  
 PVC POLYVINYL CHLORIDE  
 PVDF POLYVINYLIDENE FLUORIDE (KYNAR®)

QT QUARRY TILE  
 QTY QUANTITY

R RADIUS, RISER, RETURN OR RATE OF SLOPE  
 RAG RETURN AIR GRILLE  
 RC REINFORCED CONCRETE  
 RCP REINFORCED CONCRETE PIPE  
 RD ROOF DRAIN, ROUND, OR ROAD  
 REDWOOD REDWOOD  
 RECIRC RECIRCULATED  
 RED REDUCER OR REDUCING  
 REF REFERENCE OR REFER  
 REG REGULATING  
 REIN REINFORCE OR REINFORCED  
 RE-STL REINFORCING STEEL  
 REQD REQUIRED  
 RESIL RESILIENT  
 REV REVISION  
 RFG ROOFING  
 RF ROOF OR RAISED FACE  
 RM ROOM  
 RO ROUGH OPENING  
 RPM REVOLUTIONS PER MINUTE OR REINFORCED PLASTIC MORTAR  
 RS RISING STEM  
 RT RIGHT  
 RTP REINFORCED THERMOSETTING PLASTIC  
 R/W RIGHT OF WAY  
 RW REDWOOD  
 RWL RAINWATER LEADER

S SOUTH, SCUM, SINK, SECOND OR SLOPE  
 SA SAMPLE  
 SBR STYRENE BUTADIENE (RUBBER)  
 SC SPARE CHEMICAL OR SECONDARY CLARIFIER  
 SCD SCREWED  
 SCFM STANDARD CUBIC FEET PER MINUTE  
 SCH SCHEDULE  
 SDR STORM DRAINS  
 SEC SECONDARY  
 SECT SECTION  
 SER SERIES  
 SETT SETTLING  
 SH SHOWER  
 SHT SHEET OR SHELF  
 SHTG SHEATHING  
 SIM SIMILAR  
 SL SLUDGE OR SLOPE  
 SOLN SOLUTION  
 SLDG SLIDING  
 SP STATIC PRESSURE  
 SPECS SPECIFICATIONS  
 SPECF SPECIFIED  
 SQ SQUARE  
 SS SANITARY SEWER, STAINLESS STEEL OR SERVICE SINK  
 SSU SECONDS SAYBOLT UNIVERSAL  
 STA STATION  
 STC SLEEVE-TYPE COUPLING  
 STD STANDARD  
 STL STEEL  
 STM STEAM  
 STN STAINLESS  
 STN STL STAINLESS STEEL  
 STRUCT STRUCTURAL OR STRUCTURE  
 SUCT SUCTION  
 SV SOLENOID VALVE  
 SWR SIDEWALL REGISTER  
 SYM SYMMETRICAL OR SYMBOL  
 SYS SYSTEM

T THERMOSTAT, TREAD OF STAIR, TANGENT OR TOP  
 TB TACK BOARD  
 T & B TOP AND BOTTOM  
 TBE THREAD BOTH ENDS  
 TBM TEMPORARY BENCH MARK  
 TC TOP OF CURB  
 TEMP TEMPERATURE OR TEMPORARY  
 T & G TONGUE AND GROOVE  
 THK THICK OR THICKNESS  
 THR THRESHOLD  
 THR'D THREADED  
 TK TANK  
 TOE TREAD ONE END  
 TOL TOILET  
 TP TELEPHONE POLE OR TELEGRAPH POLE  
 TRANS TRANSITION OR TRANSMITTER  
 TSB TOP SET BASE  
 TV THERMOSTATIC VALVE OR TELEVISION  
 TW TOP OF WALL OR THERMOMETER WELL  
 TYP TYPICAL

UB UNION BONNET  
 UC UNDER-CROSSING  
 UG UNDERGROUND  
 UGC UNDERGROUND CONDUIT  
 UH UNIT HEATER  
 UL UNDERWRITERS LABORATORIES  
 UNO UNLESS NOTED OTHERWISE  
 UR URINAL

V VACUUM, VALVE, VERTICAL, VENT, VOLT OR VOLUME  
 VAR VARIES OR VARIABLE  
 VCP VITRIFIED CLAY PIPE  
 VERT VERTICAL  
 VOL VOLUME  
 VTC VENT TO CEILING  
 VTR VENT THROUGH ROOF  
 VWC VINYL WALL COVERING

W WEST OR WASTE OR WATER  
 WC WITH  
 WC WATER COLUMN OR WATER CLOSET  
 WCO WALL CLEANOUT  
 WD WOOD  
 WH WATER HEATER  
 W/ WITHOUT  
 W/O W/OUT  
 WOG WATER, OIL OR GAS WORKING PRESSURE  
 WP WATER PROOFING  
 WS WATER SURFACE  
 WSTP WATER STOP  
 WT WEIGHT  
 WWM WELDED WIRE MESH  
 WWP WATER WORKING PRESSURE

XS EXTRA STRONG  
 XXS DOUBLE EXTRA STRONG


YD YARD  
 YR YEAR

Z ZERO OR ZONE  
 ZN ZINC

The limited review of this document by PBS & J on behalf of the Olivenhain Municipal Water District, is intended as a limited review only for general conformance with: (1) This approved Design/Build documents, (2) Accepted standards of practice within the industry, and (3) The standards of the Olivenhain Municipal Water District. This limited review in no way is intended, nor shall it act, to relieve the Design/Build Team of any professional liability to the responsibility to provide a complete and functional facility that is compliant with all applicable specifications, standards, codes, and regulations.

PBS & J  
 Date 8/23/01 By J. J. J.

NOTES:  
 ADDITIONAL PIPING ABBREVIATIONS SHOWN ON PIPE SCHEDULE SHEET GM-1  
 ELECTRICAL ABBREVIATIONS SHOWN ON ELECTRICAL SHEET GE-2  
 ADDITIONAL ABBREVIATIONS CONFORM TO ANSISTANDARD ABBREVIATIONS Z32.2.3  
 REV. 091587

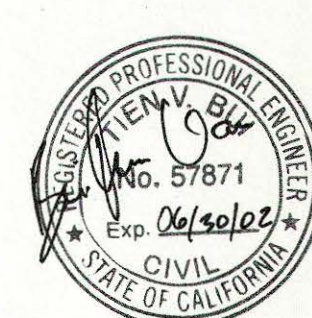

REV	DATE	BY	OMWD	DESCRIPTION

SCALE

NONE

WARNING

0 1/2 1

IF THIS BAR DOES NOT MEASURE 1" THEN DRAWING IS NOT TO SCALE

DESIGNED MW

DRAWN MW

CHECKED MW

SUBMITTED BY

PROJECT MANAGER

COMPANY OFFICER

50522

LICENSE NO.

33699

LICENSE NO.

12/13/00

DATE

12/13/00

DATE



**MONTGOMERY WATSON**  
Pasadena, California

APPROVED

George J. J.

OLIVENHAIN NWO

APPROVED

FILANC CONSTRUCTION CO.

8.29.01

DATE

DATE

KELWOOD DEVELOPMENT COMPANY

4S RANCH SANITATION DISTRICT

WASTEWATER TREATMENT PLANT EXPANSION TO 2.0 MGD

ABBREVIATIONS

SHEET





G-3

OF 5 SHEETS



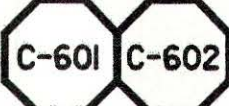



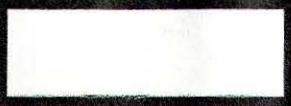

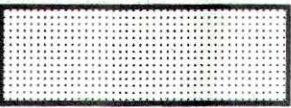










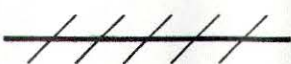

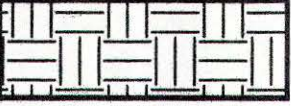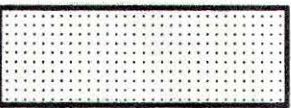




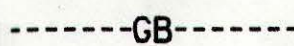
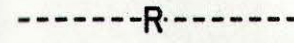
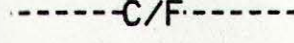

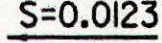
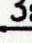

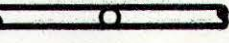





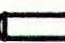

Job No: MW Job # File: P:\Projects\45R\00\civil\45r-nbbs-gc01.dwg Plot Date: 12-DEC-2000 14:57

## CIVIL GENERAL NOTES

1. PRIOR TO START OF CONSTRUCTION, THE CONTRACTOR SHALL LOCATE ALL EXISTING UTILITIES IN AND AROUND THE AREAS OF NEW CONSTRUCTION.
2. THE CONTRACTOR SHALL PROTECT ALL EXISTING UTILITIES TO REMAIN.
3. THE CONTRACTOR SHALL COMPLY WITH THE STATE DEPARTMENT OF HEALTH SERVICES CRITERIA FOR THE SEPARATION OF WATER MAINS AND SANITARY SEWERS AS SET FORTH IN SECTION 64630, TITLE 22 OF THE CALIFORNIA ADMINISTRATIVE CODE. NOTE THAT THESE CRITERIA ARE APPLICABLE TO HOUSE LATERALS AS WELL AS SEWERS.
4. THE CONTRACTOR SHALL PROVIDE A MINIMUM OF 42 INCHES COVER ON ALL PIPELINES UNLESS OTHERWISE SHOWN OR DIRECTED.
5. SEWER ELEVATIONS SHOWN ARE TO INVERT (FLOWLINE) OF CONDUIT.
6. STRAIGHT SLOPES SHALL BE MAINTAINED BETWEEN INVERTS SHOWN.
7. THE CONTRACTOR SHALL ADJUST ALL VALVE BOXES, PULL BOXES AND MANHOLES TO FINISHED GRADE UNLESS OTHERWISE SHOWN OR DIRECTED. MANHOLES IN OPEN FIELDS SHALL BE SET ONE FOOT ABOVE GRADE. APPROXIMATE RIM ELEVATIONS ARE SHOWN ON DRAWINGS.
8. THE CONTRACTOR SHALL DISPOSE OF ALL DEBRIS FROM DEMOLITION PROPERLY.
9. ALL TRENCHING AND BACKFILL SHALL BE IN ACCORDANCE WITH DETAIL  
10. ALL BURIED VALVE INSTALLATIONS SHALL BE IN ACCORDANCE WITH DETAIL 
11. THRUST BLOCKS SHALL BE INSTALLED ON ALL PRESSURE PIPELINES 4" OR GREATER IN ACCORDANCE WITH DETAIL 
12. ALL BUILDING COORDINATES ARE TO OUTSIDE CORNER OF COLUMN OR BUILDING.
13. LOCATION OF ELECTRICAL MANHOLES & PULLBOXES ARE APPROXIMATE. CONTRACTOR SHALL COORDINATE EXACT LOCATION OF MANHOLES & PULLBOXES WITH MECHANICAL, ELECTRICAL, AND CIVIL WORK.
14. PRIOR TO ANY CONNECTION TO AN EXISTING UTILITY, THE CONTRACTOR SHALL COORDINATE WITH THE OWNER OR WITH THE CORRESPONDING AGENCIES.
15. FOR PIPING CONNECTIONS TO STRUCTURE SEE MECHANICAL DRAWINGS.
16. CONTRACTOR SHALL PROVIDE TWO FLEXIBLE CONNECTIONS FOR EACH PIPE PENETRATING A STRUCTURE, WHETHER REFLECTED ON THE DRAWINGS OR NOT. THE CONNECTION SHALL BE 3' AND 8' AWAY FROM THE STRUCTURE, OR AS SHOWN ON PLANS.
17. EXISTING SURFACE FEATURES SHOWN ON ALL SHEETS HEREIN ARE BASED ON UNVERIFIED AERIAL PHOTO. THE CONTRACTOR IS RESPONSIBLE FOR FIELD VERIFICATION OF ALL EXISTING SURFACE FEATURES, WHETHER SHOWN OR NOT HEREIN.
18. PRIOR TO SUBMITTAL OF PIPE SHOP DRAWINGS THE CONTRACTOR SHALL VERIFY THE INVERT ELEVATION, OUTSIDE DIAMETER, LOCATION AND MATERIAL OF ALL EXISTING PIPELINES TO WHICH NEW PIPELINES WILL BE CONNECTED.
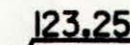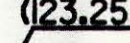
## CIVIL SYMBOLS

	PROPOSED IMPROVEMENT
	EXISTING IMPROVEMENT
	EXISTING IMPROVEMENT TO BE REMOVED OR DEMOLISHED
	SOIL BORING
	BENCH MARK
	HORIZONTAL AND VERTICAL CONTROL POINT
	STRUCTURE, TANK OR BUILDING
	ASPHALT CEMENT PAVING
	CONCRETE PAVING
	GRAVEL PAVING
	EARTH (IN SECTION)
	COMPACTED EARTH (IN SECTION)
	POND LINER (SEE SPECIFICATIONS)
	CONCRETE CURB
	CONCRETE CURB AND GUTTER
	DROP INLET CATCH BASIN
	CURBSIDE DROP INLET CATCH BASIN WITH LOCAL DEPRESSION
	SIDE INLET CATCH BASIN WITH LOCAL DEPRESSION
	CONCRETE WALK
	DRIVEWAY / ACCESS RAMP
	MASONRY WALL, RETAINING WALL, HEADWALL

	FINISHED ELEVATION
	EXISTING ELEVATION
	CUT OR FILL SLOPE
	GRADE BREAK
	RIDGE LINE
	CUT/FILL OR DAYLIGHT LINE
	FLOW LINE
	SLOPE ON PAVED SURFACE
	BERM SLOPE (HORIZ. TO VERT)
	BURIED ACCESS MH (IN PLAN) LOCATE ON SIDE SHOWN.
	BURIED ACCESS MH (IN PROFILE).
	A/R VALVE (IN PROFILE)
	A/R VALVE LOCATE ON SIDE SHOWN (IN PLAN)
	BLOWOFF (IN PROFILE)
	BLOWOFF (IN PLAN) LOCATE ON SIDE SHOWN
	DELTA
	BUMPED HEAD
	FLEX COUPLING

## BASIS OF BEARINGS


THE BASIS OF BEARING FOR THIS MAP IS THE NAD 83, ZONE 6, GRID BEARING POINT NO'S. 350 AND 399 AS SAID STATIONS ARE PUBLISHED IN THE SAN DIEGO HORIZONTAL CONTROL BOOK. I.E. N14° 28' 44" W


QUOTED BEARINGS FROM REFERENCE MAPS OR DEEDS MAY OR MAY NOT BE IN TERMS OF SAID SYSTEM. THE COMBINED SCALE FACTOR AT STATION NO. 399 IS 0.9999448  
GRID DISTANCE = GROUND DISTANCE × SCALE FACTOR

## BENCHMARK

3" BRASS DISK IN MONUMENT WELL STAMPED LS 5894, LOCATED AT THE C/L INTERSECTION OF THORNHUNT ROAD AND THORNHUNT COURT RECORD FROM CITY OF SAN DIEGO (PT NO. 399, R.O.S. 14492)  
ELEVATION: 622.05 DATUM: NGVD 29(Feet)

The limited review of this document by PBS & J on behalf of the Olivenhain Municipal Water District, is intended as a limited review only for general conformance with: (1) This approved Design/Build documents, (2) Accepted standards of practice within the industry, and (3) The standards of the Olivenhain Municipal Water District. This limited review in no way is intended, nor shall it act, to relieve the Design/Build Team of any professional liability to the responsibility to provide a complete and functional facility that is compliant with all applicable specifications, standards, codes, and regulations.

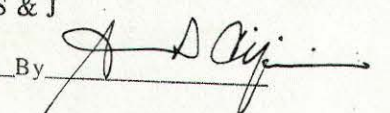


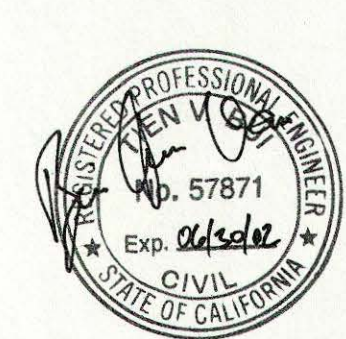PBS & J  
Date 8/27/01 By 



REV	DATE	BY	OMWD	DESCRIPTION

SCALE	WARNING
NONE	0 1/2 IF THIS BAR DOES NOT MEASURE 1" THEN DRAWING IS NOT TO SCALE

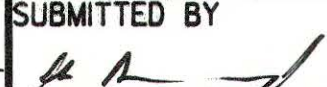DESIGNED	N. NAZARIAN
DRAWN	N. NAZARIAN
CHECKED	T. BUI

SUBMITTED BY	PROJECT MANAGER	LICENSE NO.	DATE
		50802	12/13/00
COMPANY OFFICER		33699	12/13/00












**MONTGOMERY WATSON**  
Pasadena, California

APPROVED	George R. Bunt	8.29.01
OLIVENHAIN MWD		DATE
APPROVED		
FILANC CONSTRUCTION CO.		DATE

KELWOOD DEVELOPMENT COMPANY
4S RANCH SANITATION DISTRICT
WASTEWATER TREATMENT PLANT EXPANSION TO 2.0 MGD
CIVIL GENERAL NOTES

SHEET  
GC-1  
OF 5 SHEETS



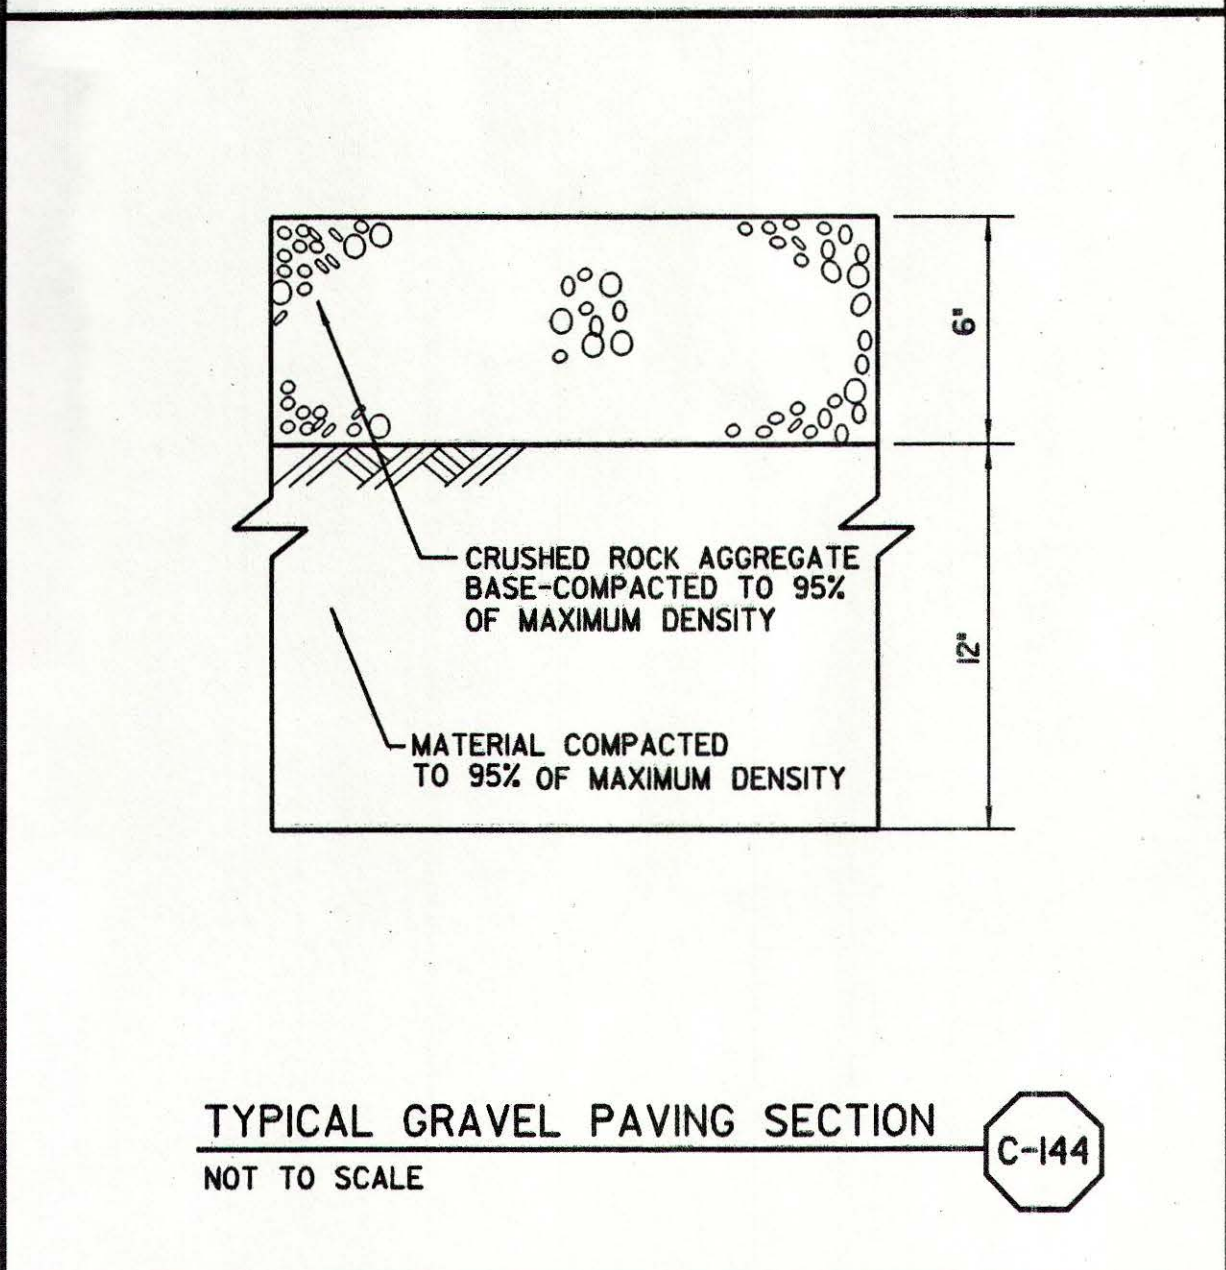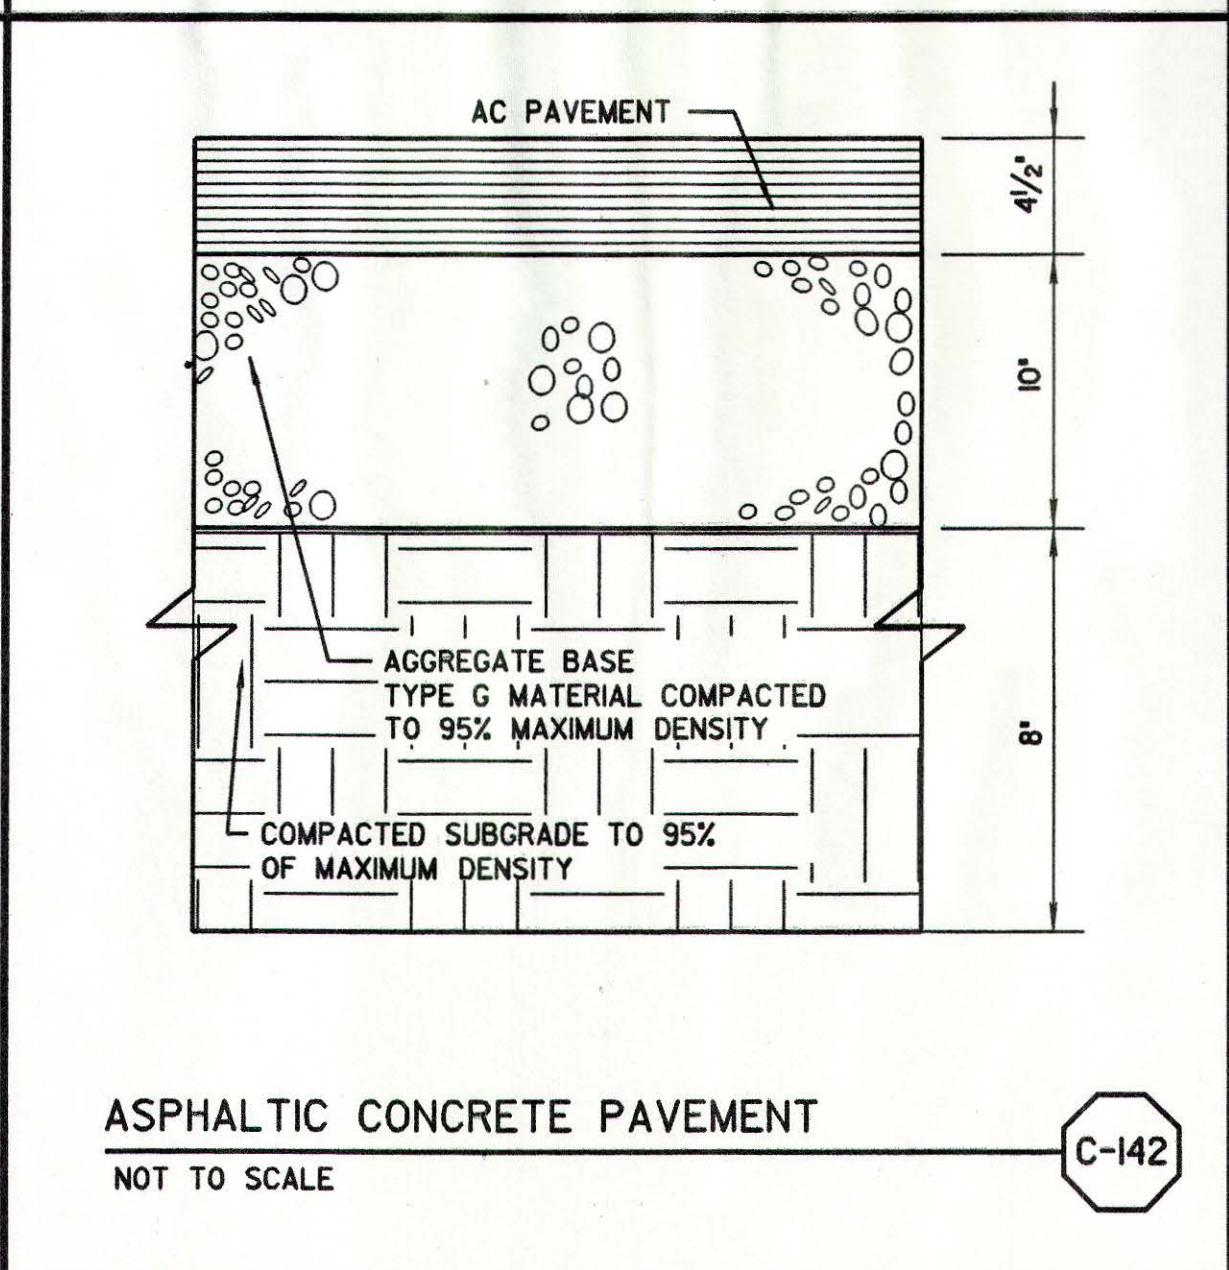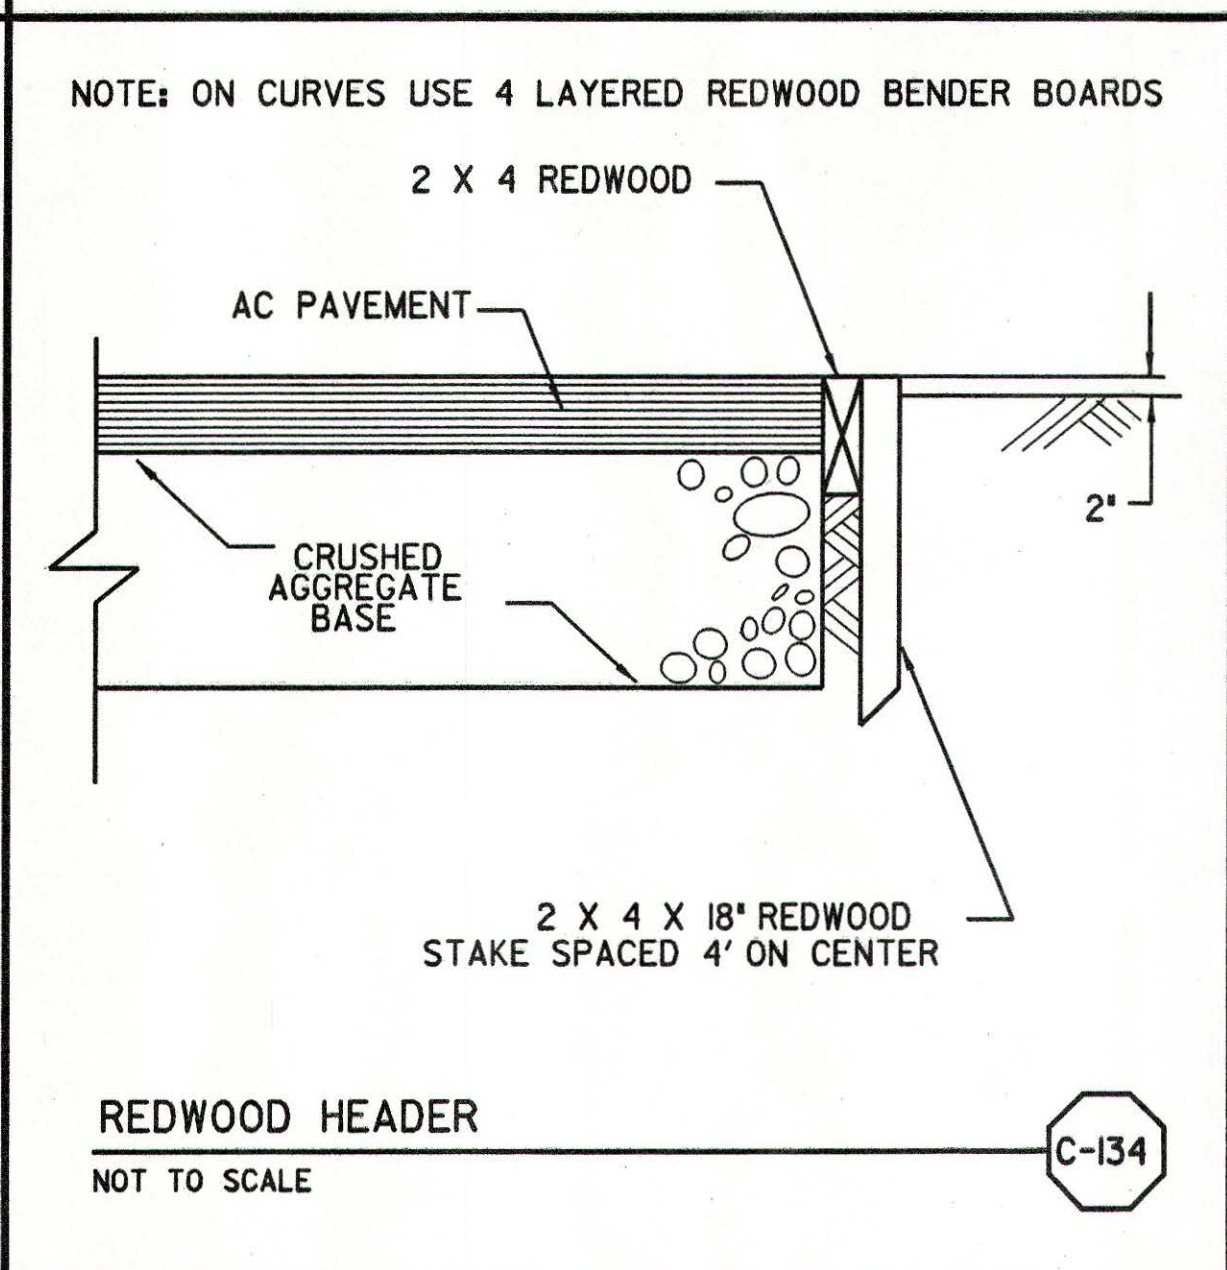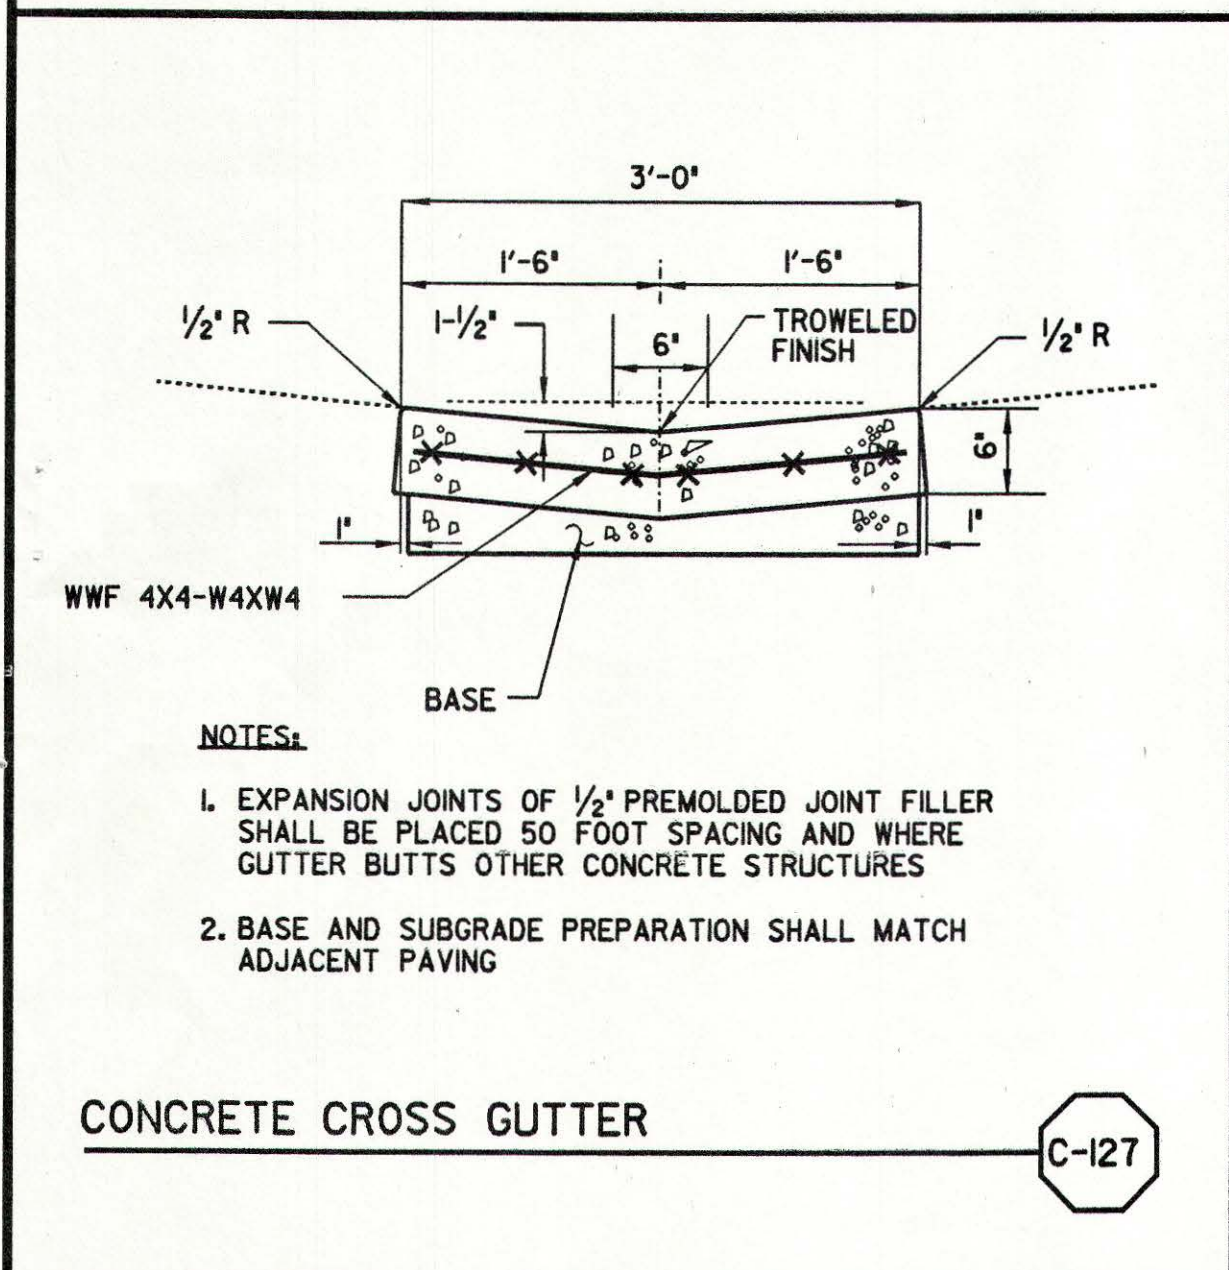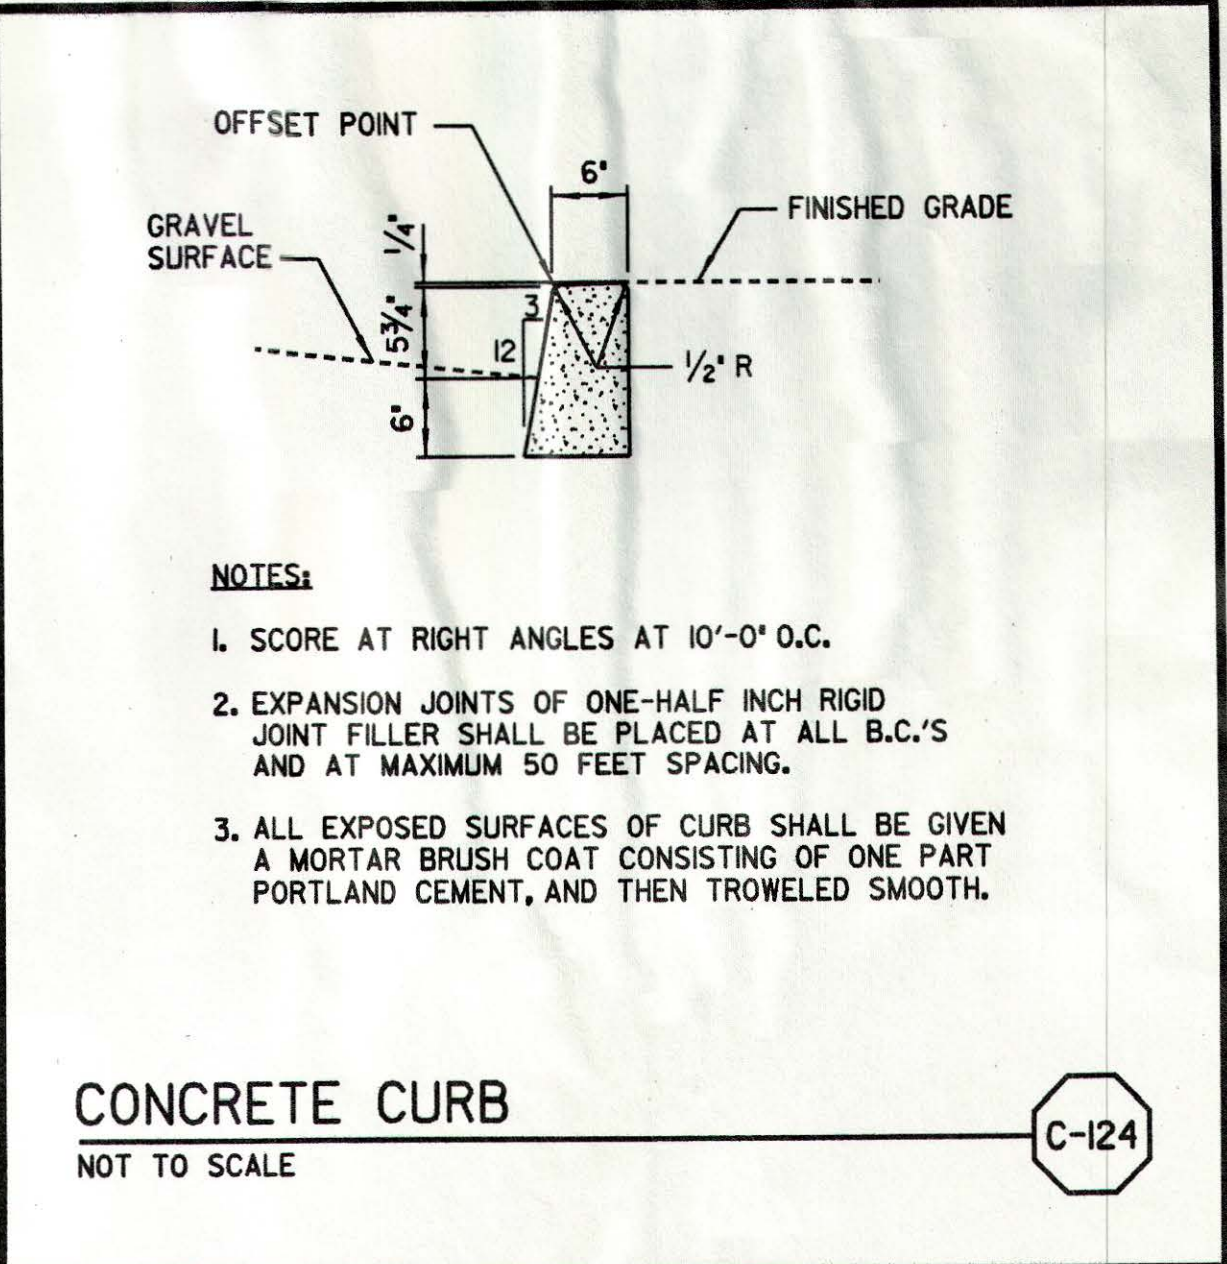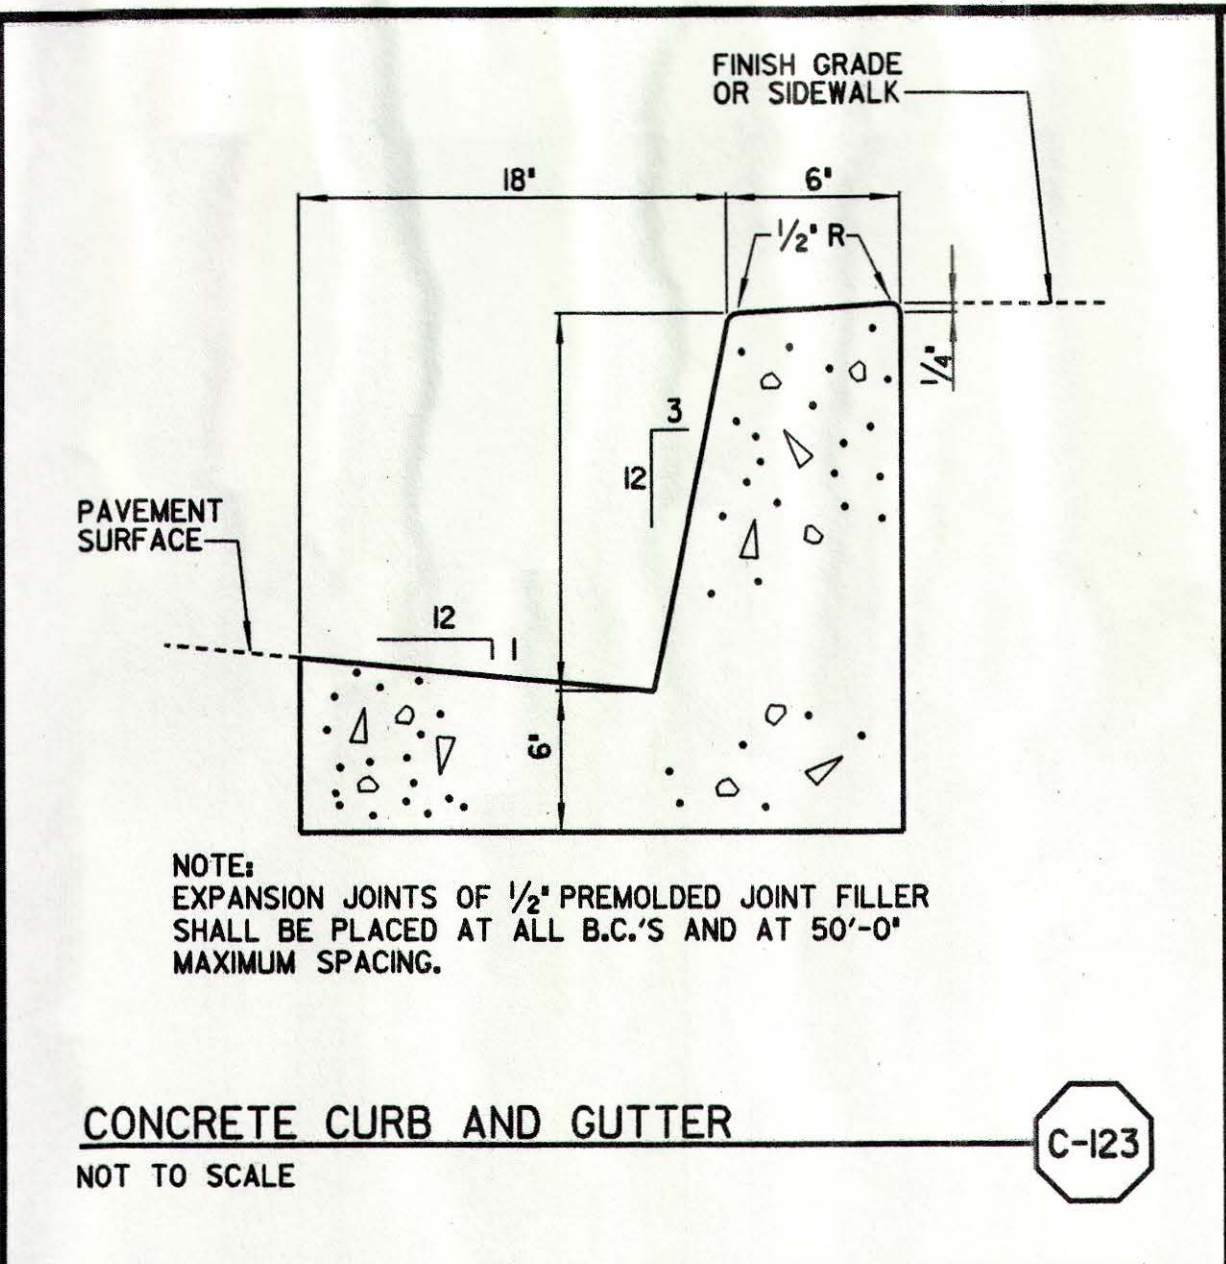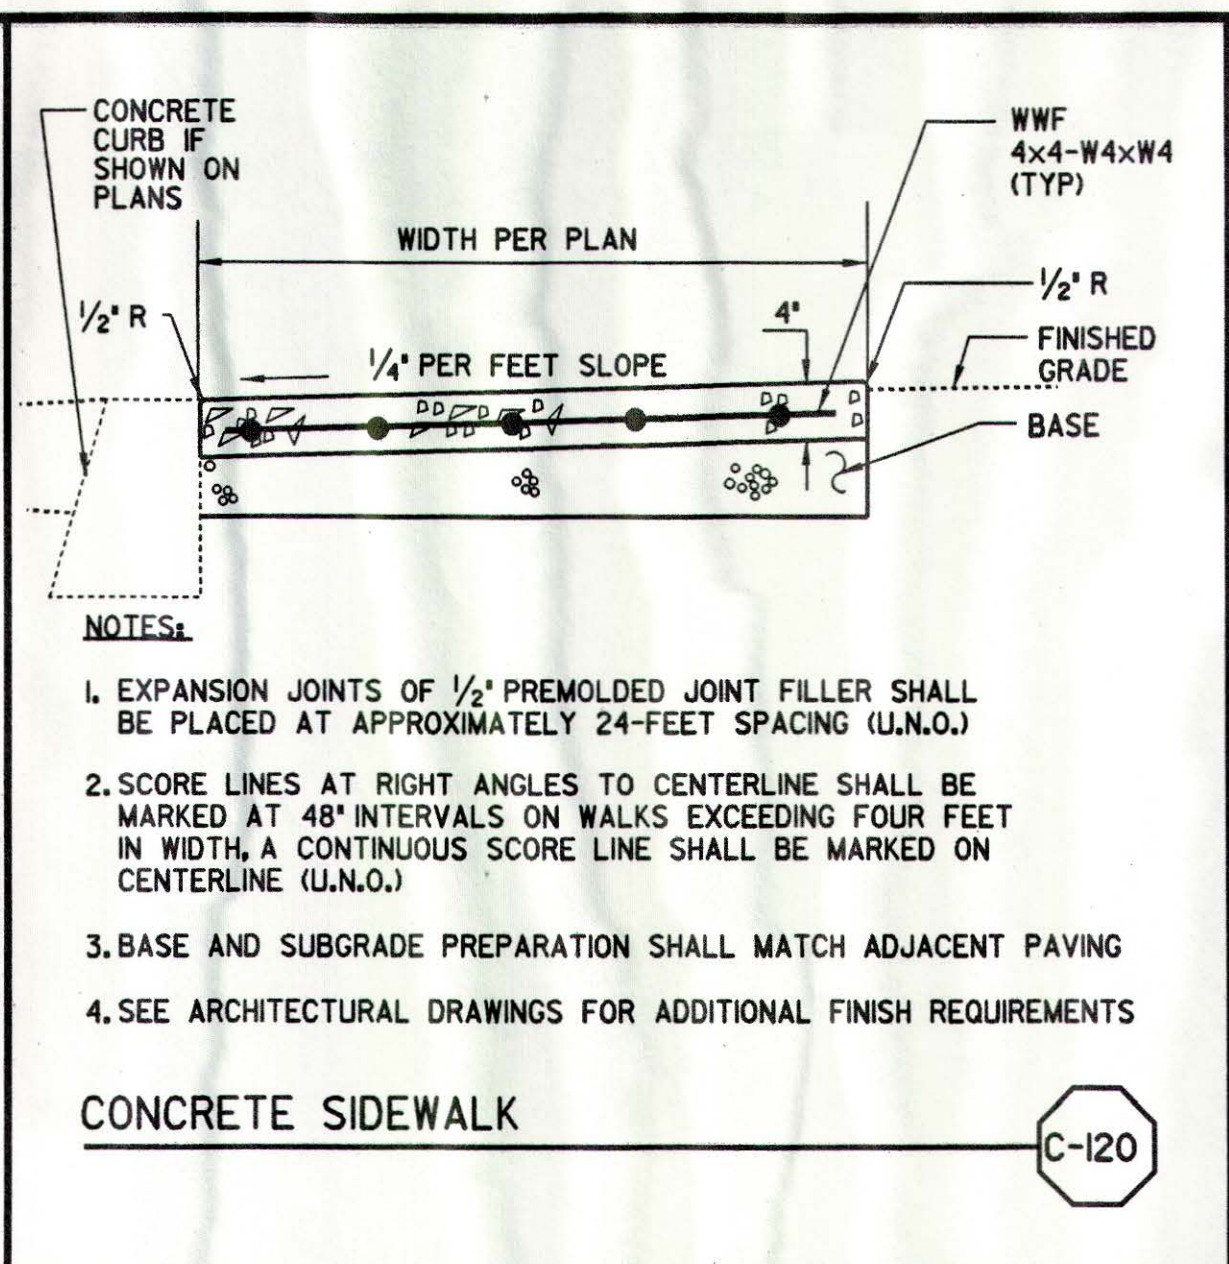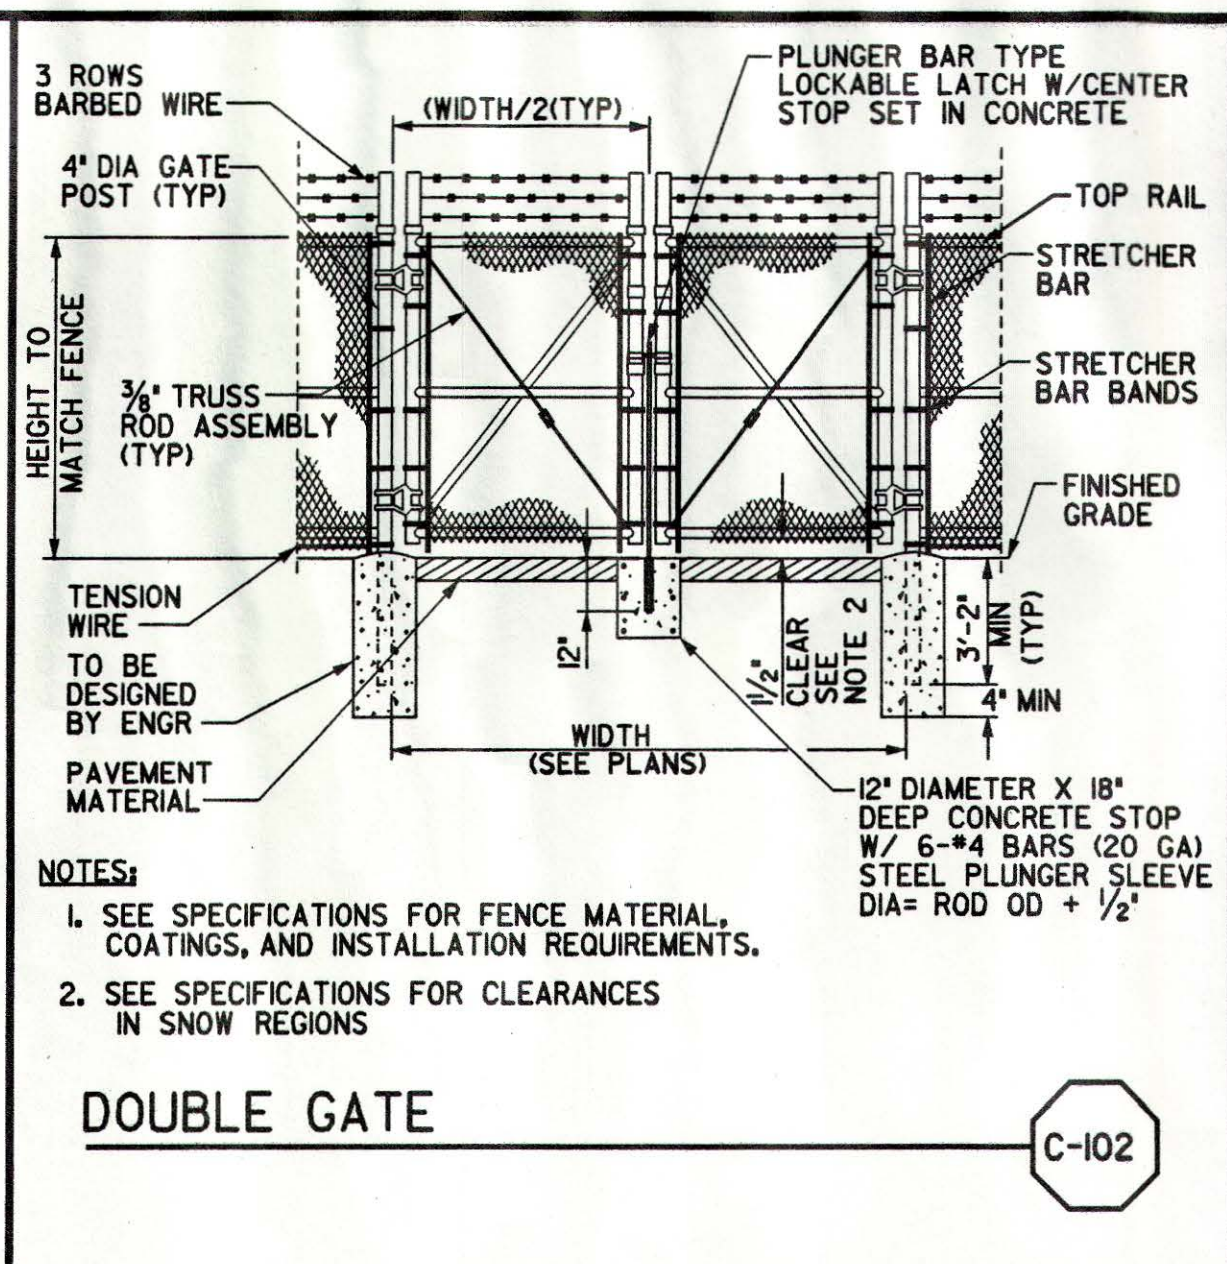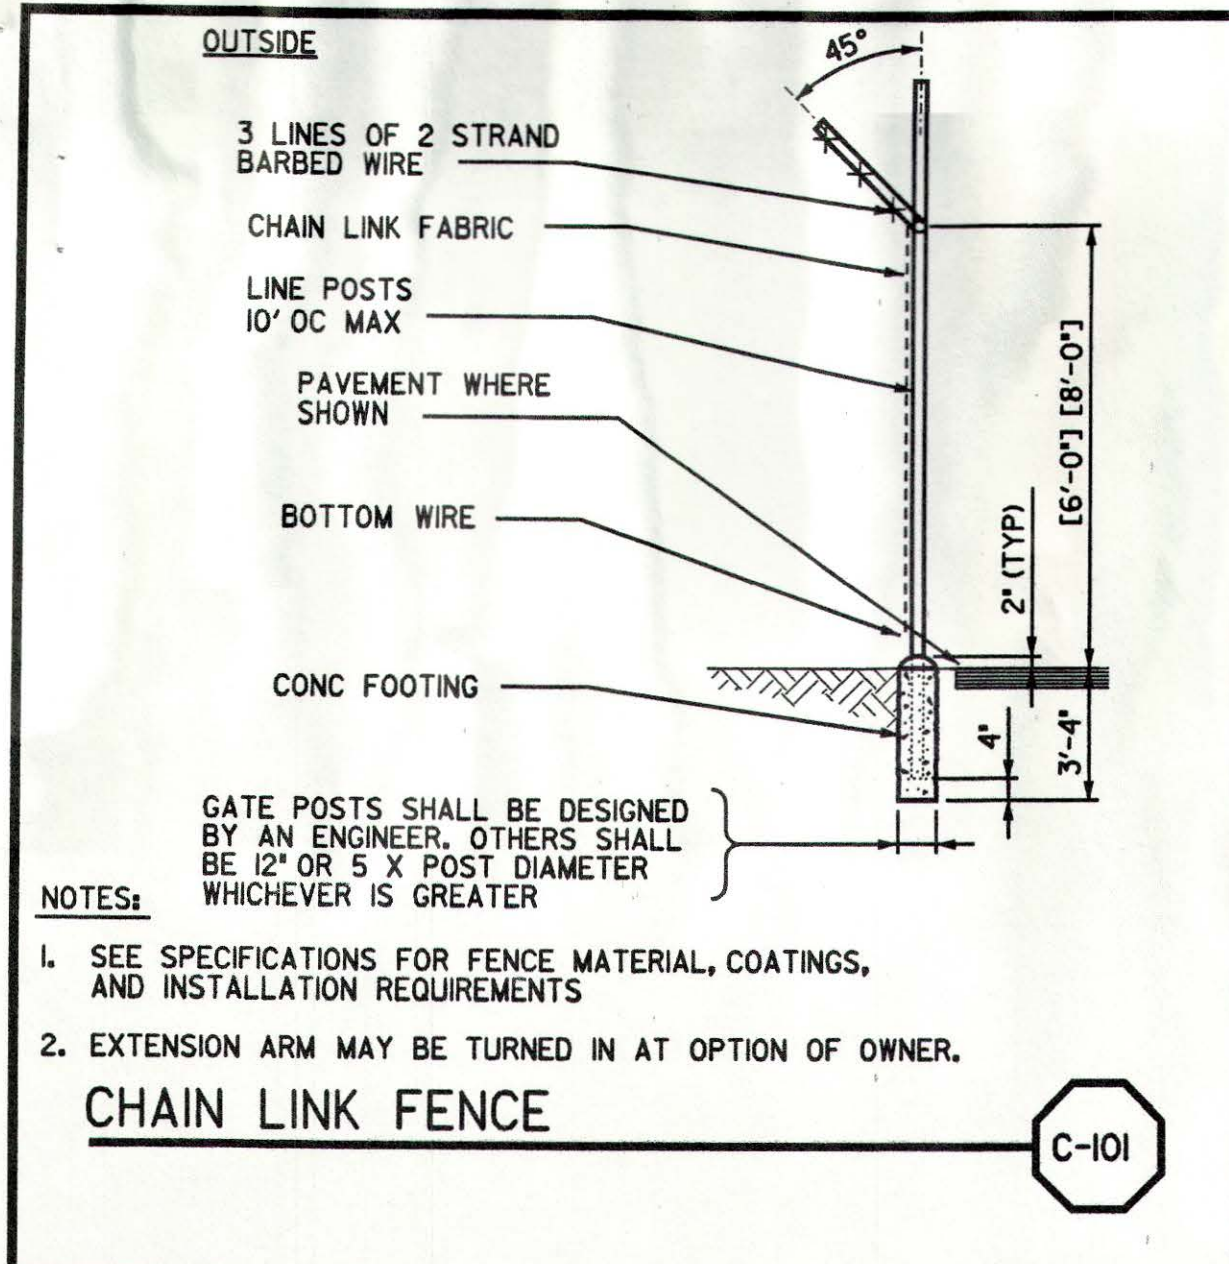

The limited review of this document by PBS & J on behalf of the Olivenhain Municipal Water District, is intended as a limited review only for general conformance with: (1) This approved Design/Build documents, (2) Accepted standards of practice within the industry, and (3) The standards of the Olivenhain Municipal Water District. This limited review in no way is intended, nor shall it act, to relieve the Design/Build Team of any professional liability to the responsibility to provide a complete and functional facility that is compliant with all applicable specifications, standards, codes, and regulations.





PBS & J  
Date 8/23/01 By [Signature]



<p>DESIGNED N. NAZARIAN PROJECT MANAGER DRAWN N. NAZARIAN CHECKED T. BUI SUBMITTED BY [Signature] PROJECT MANAGER COMPANY OFFICER</p>				<p>50802 LICENSE NO. 12/13/00 DATE</p> <p>33699 LICENSE NO. 12/13/00 DATE</p>				<p>APPROVED [Signature] OLIVENHAIN MWD APPROVED FILANC CONSTRUCTION CO. DATE</p>				<p>KELWOOD DEVELOPMENT COMPANY 4S RANCH SANITATION DISTRICT WASTEWATER TREATMENT PLANT EXPANSION TO 2.0 MGD CIVIL STANDARD DETAILS - I</p>				<p>SHEET GC-2 OF 5 SHEETS</p>
---	--	--	--	---	--	--	--	--	--	--	--	--	--	--	--	---------------------------------------



Job No. MW Job # File: P:\Projects\45R\00.civ\46r\_nbds.gc03.dwg Plot Date: 12-DEC-2000 1457

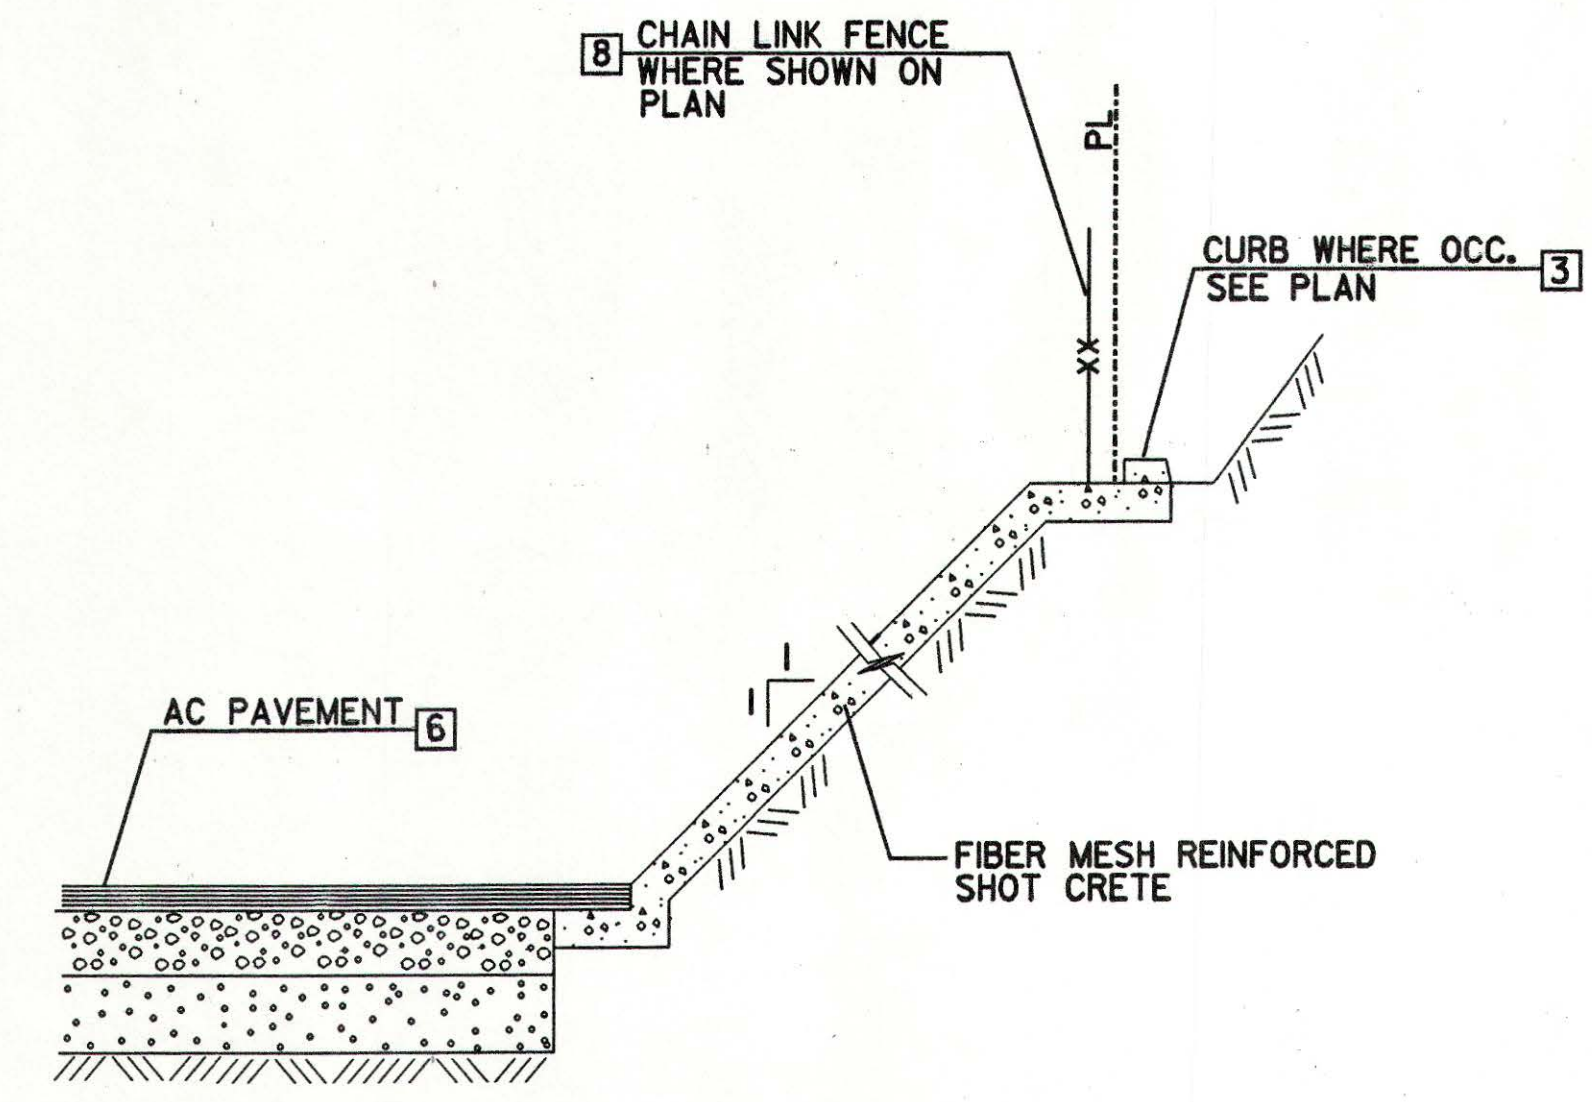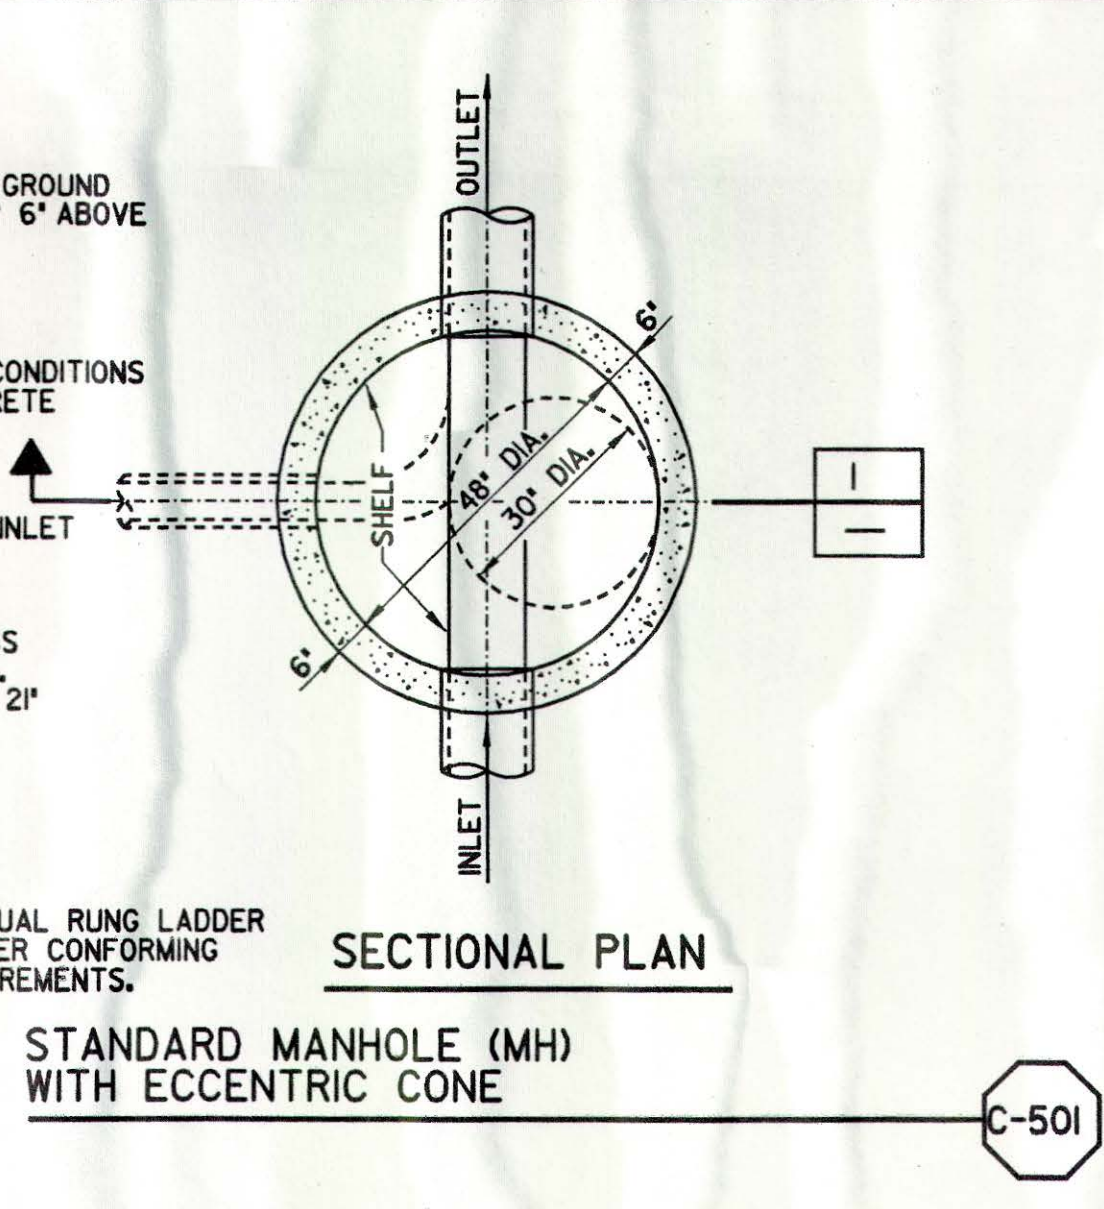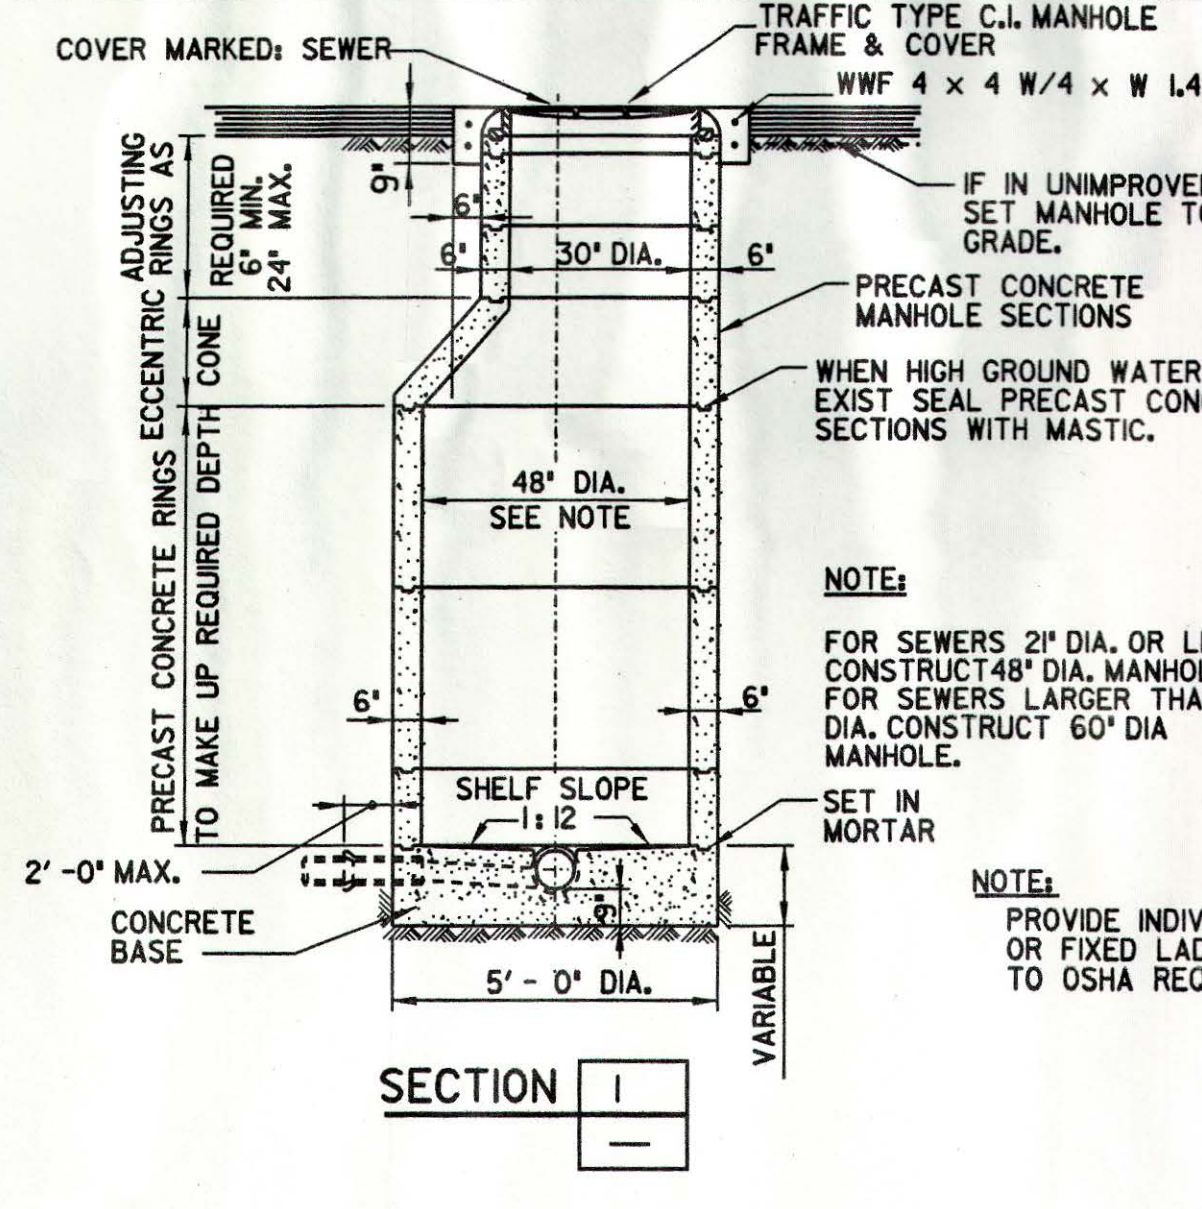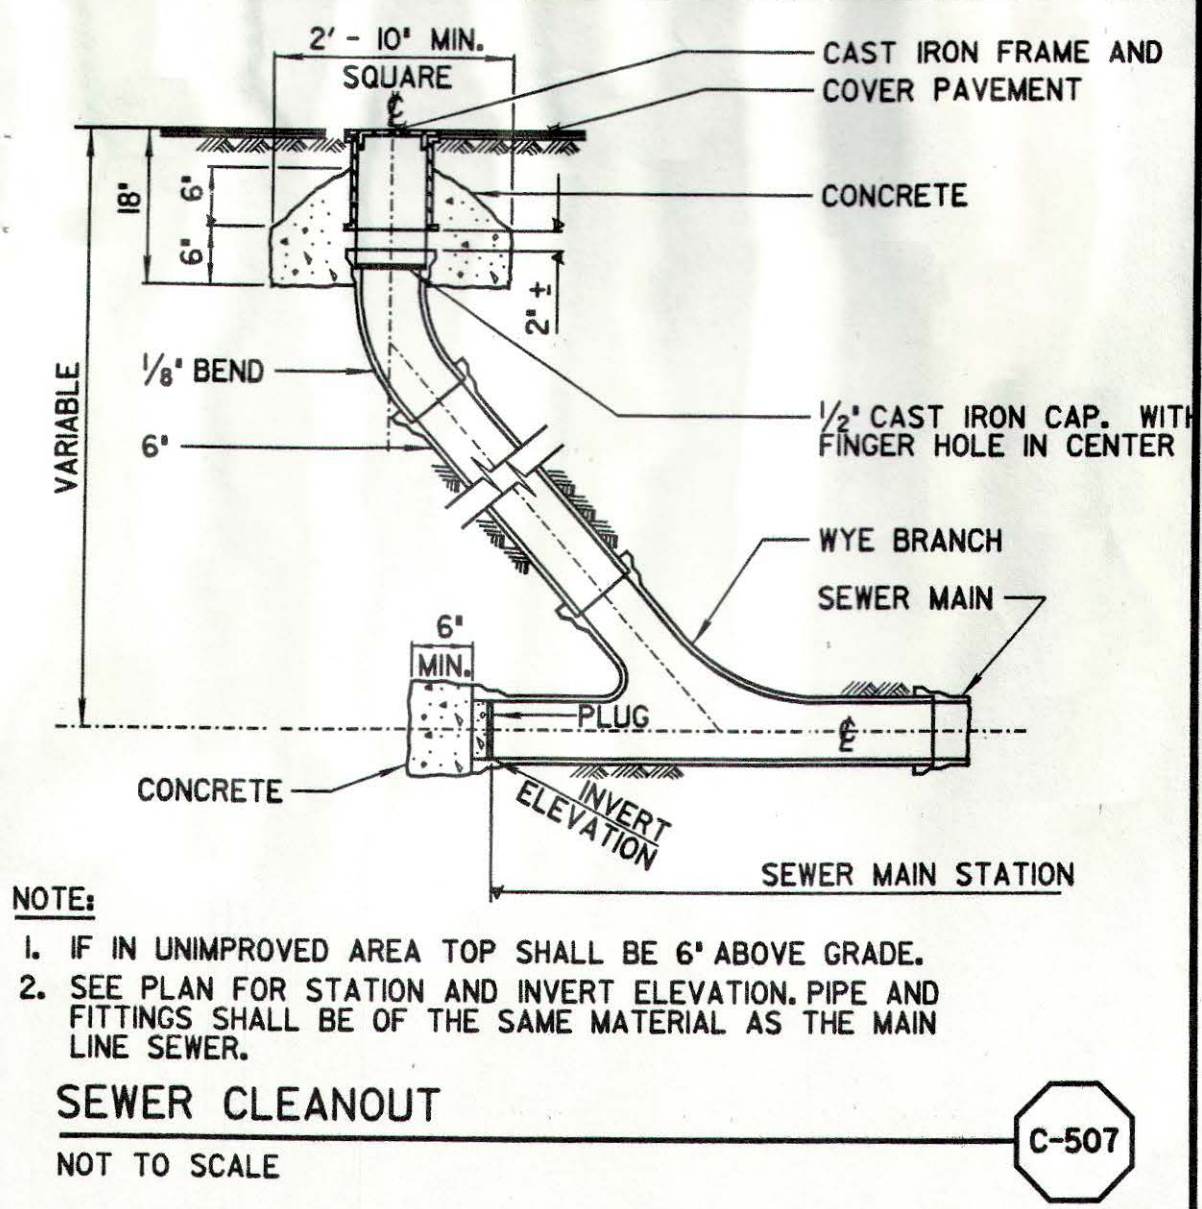

EMERGENCY OVERFLOW POND PAVING DETAIL C-190

The limited review of this document by PBS & J on behalf of the Olivenhain Municipal Water District, is intended as a limited review only for general conformance with: (1) This approved Design/Build documents, (2) Accepted standards of practice within the industry, and (3) The standards of the Olivenhain Municipal Water District. This limited review in no way is intended, nor shall it act, to relieve the Design/Build Team of any professional liability to the responsibility to provide a complete and functional facility that is compliant with all applicable specifications, standards, codes, and regulations.

PBS & J  
Date 8/23/01 By J. S. Ogilvie



REV	DATE	BY	OMWD	DESCRIPTION

SCALE	WARNING
AS SHOWN	IF THIS BAR DOES NOT MEASURE 1\"/>

DESIGNED	N. NAZARIAN
DRAWN	N. NAZARIAN
CHECKED	T. BUI

SUBMITTED BY	DATE
PROJECT MANAGER	12/13/00
COMPANY OFFICER	12/13/00

**MONTGOMERY WATSON**  
Pasadena, California

APPROVED	DATE
OLIVENHAIN MWD	8.29.01
APPROVED	DATE
FILANC CONSTRUCTION CO.	DATE

KELWOOD DEVELOPMENT COMPANY
45 RANCH SANITATION DISTRICT
WASTEWATER TREATMENT PLANT EXPANSION TO 2.0 MGD
CIVIL STANDARD DETAILS - 2



A. FLEXIBLE PIPE REFERS TO ALL STEEL, DUCTILE-IRON AND PLASTIC PIPES.

B. TYPICAL TRENCH SECTIONS (I, II AND III) ARE TO BE USED ONLY WHERE STABLE, COMPACT SOIL CONDITIONS EXIST. IF BOULDER OR LARGE OBSTRUCTIONS WOULD BE ENCOUNTERED, TRENCH SECTIONS MAY BE DEEPER OR WIDER THAN SHOWN. THE ENGINEER SHOULD BE ADVISED SHOULD THIS OCCUR.

C. THE NEED FOR PROTECTIVE SYSTEMS, AND EXCAVATION SLOPES SHALL BE DETERMINED CONSIDERING APPLICABLE LOCAL, STATE AND FEDERAL (OSHA) SAFETY STANDARDS AND REGULATIONS AND GEOTECHNICAL CONSULTANTS' RECOMMENDATIONS.

D. PROTECTIVE SYSTEMS SHALL BE DESIGNED AND BUILT IN ACCORDANCE WITH THE APPLICABLE LOCAL, STATE AND FEDERAL (OSHA) SAFETY STANDARDS AND REGULATIONS.


E. SUPPORTING DOCUMENTATION SHALL BE SUBMITTED TO THE ENGINEER REGARDING PIPE DESIGN AND COMPLIANCE WITH APPLICABLE LOCAL, STATE AND FEDERAL (OSHA) SAFETY STANDARDS.

F. UNSUPPORTED VERTICAL AND/OR SLOPING TRENCH WALL SLOPES SHALL NOT BE STEEPER THAN ALLOWED BY APPLICABLE LOCAL, STATE AND FEDERAL (OSHA) SAFETY STANDARDS AND REGULATIONS, UNLESS SUPPORTING DOCUMENTATION IS SUBMITTED, ACCORDING TO AFOREMENTIONED SAFETY STANDARDS.

G. TRENCH SECTIONS OTHER THAN THE TYPICAL SECTIONS SHOWN MAY BE UTILIZED PROVIDED THEY COMPLY WITH APPLICABLE LOCAL, STATE AND FEDERAL (OSHA) SAFETY STANDARDS AND REGULATIONS. DOCUMENTATION SUPPORTING THIS COMPLIANCE AND PIPE DESIGN CALCULATIONS SHALL BE SUBMITTED TO THE ENGINEER.

H. IF OVER-EXCAVATION DUE TO POOR FOUNDATION MATERIAL IS ORDERED BY THE ENGINEER, THE BACKFILL MATERIAL SHALL BE ACCORDING TO THE EARTHWORK SECTION OF THE SPECIFICATIONS ARTICLE ENTITLED, "USE OF FILL, BACKFILL AND EMBANKMENT MATERIAL TYPES."

I. IF DURING CONSTRUCTION, THE WATER TABLE WILL BE DISCOVERED TO BE ABOVE THE TRENCH BOTTOM, THE ENGINEER SHALL BE NOTIFIED, AND APPROPRIATE DEWATERING SHALL BE IMPLEMENTED TO LOWER THE WATER LEVEL BELOW THE TRENCH BOTTOM. THE BACKFILL MATERIAL SHALL BE ACCORDING TO THE EARTHWORK SECTIONS OF THE SPECIFICATIONS, OR AS ORDERED BY THE ENGINEER.

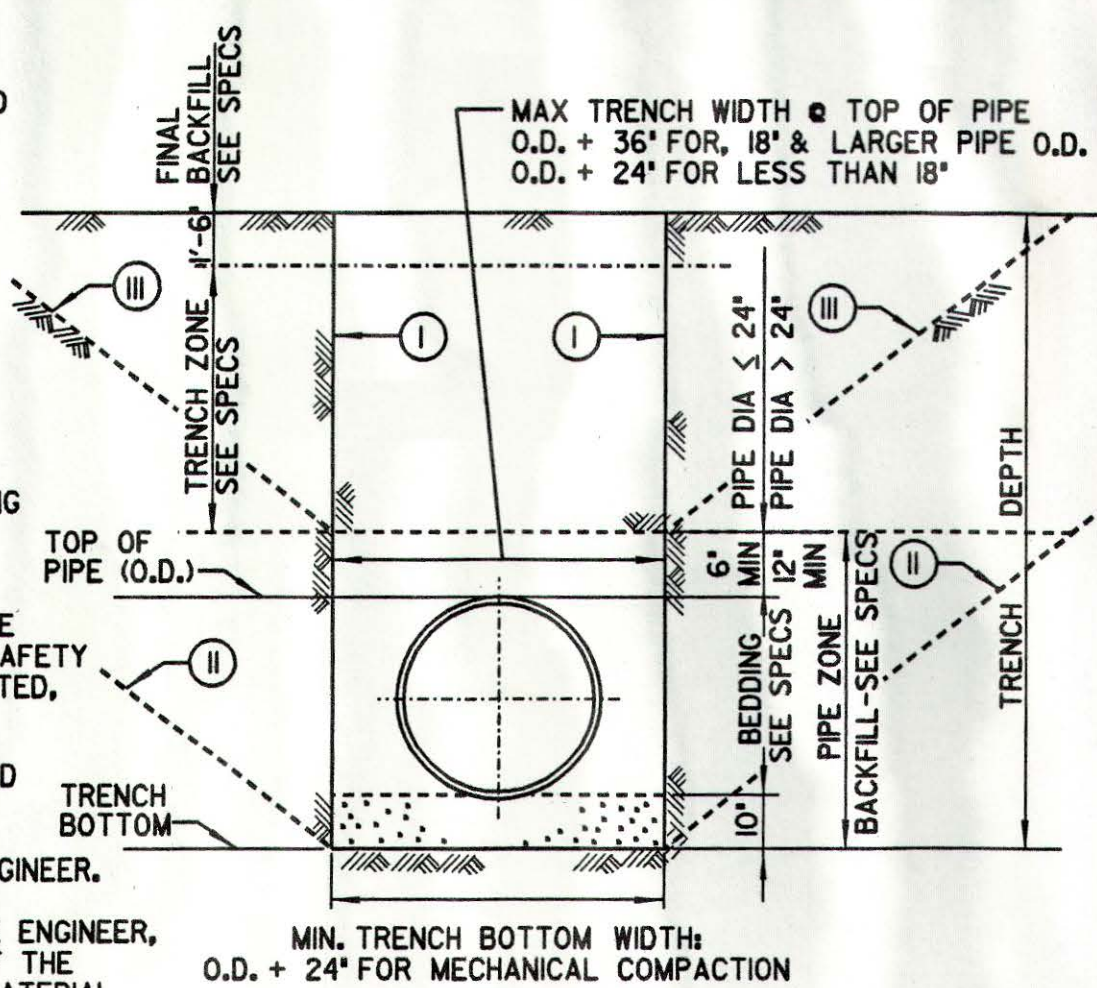

TRENCH SECTION - FLEXIBLE PIPE

NOT TO SCALE

C-601

A. RIGID PIPE REFERS TO ALL TYPES OF REINFORCED AND UN-REINFORCED CONCRETE PIPE AND VITRIFIED CLAY PIPE.

B. TYPICAL TRENCH SECTIONS (I, II AND III) ARE TO BE USED ONLY WHERE STABLE, COMPACT SOIL CONDITIONS EXIST. IF BOULDER OR LARGE OBSTRUCTIONS WOULD BE ENCOUNTERED, TRENCH SECTIONS MAY BE DEEPER OR WIDER THAN SHOWN. THE ENGINEER SHOULD BE ADVISED SHOULD THIS OCCUR.

C. THE NEED FOR PROTECTIVE SYSTEMS, AND EXCAVATION SLOPES SHALL BE DETERMINED CONSIDERING APPLICABLE LOCAL, STATE AND FEDERAL (OSHA) SAFETY STANDARDS AND REGULATIONS AND GEOTECHNICAL CONSULTANTS' RECOMMENDATIONS.

D. PROTECTIVE SYSTEMS SHALL BE DESIGNED AND BUILT IN ACCORDANCE WITH THE APPLICABLE LOCAL, STATE AND FEDERAL (OSHA) SAFETY STANDARDS AND REGULATIONS.


E. SUPPORTING DOCUMENTATION SHALL BE SUBMITTED TO THE ENGINEER REGARDING PIPE DESIGN AND COMPLIANCE WITH APPLICABLE LOCAL, STATE AND FEDERAL (OSHA) SAFETY STANDARDS.

F. UNSUPPORTED VERTICAL AND/OR SLOPING TRENCH WALL SLOPES SHALL NOT BE STEEPER THAN ALLOWED BY APPLICABLE LOCAL, STATE AND FEDERAL (OSHA) SAFETY STANDARDS AND REGULATIONS, UNLESS SUPPORTING DOCUMENTATION IS SUBMITTED, ACCORDING TO AFOREMENTIONED SAFETY STANDARDS.

G. TRENCH SECTIONS OTHER THAN THE TYPICAL SECTIONS SHOWN MAY BE UTILIZED PROVIDED THEY COMPLY WITH APPLICABLE LOCAL, STATE AND FEDERAL (OSHA) SAFETY STANDARDS AND REGULATIONS. DOCUMENTATION SUPPORTING THIS COMPLIANCE AND PIPE DESIGN CALCULATIONS SHALL BE SUBMITTED TO THE ENGINEER.

H. IF OVER-EXCAVATION DUE TO POOR FOUNDATION MATERIAL IS ORDERED BY THE ENGINEER, THE BACKFILL MATERIAL SHALL BE ACCORDING TO THE EARTHWORK SECTION OF THE SPECIFICATIONS ARTICLE ENTITLED, "USE OF FILL, BACKFILL AND EMBANKMENT MATERIAL TYPES."


I. IF DURING CONSTRUCTION, THE WATER TABLE WILL BE DISCOVERED TO BE ABOVE THE TRENCH BOTTOM, THE ENGINEER SHALL BE NOTIFIED, AND APPROPRIATE DEWATERING SHALL BE IMPLEMENTED TO LOWER THE WATER LEVEL BELOW THE TRENCH BOTTOM. THE BACKFILL MATERIAL SHALL BE ACCORDING TO THE EARTHWORK SECTIONS OF THE SPECIFICATIONS, OR AS ORDERED BY THE ENGINEER.

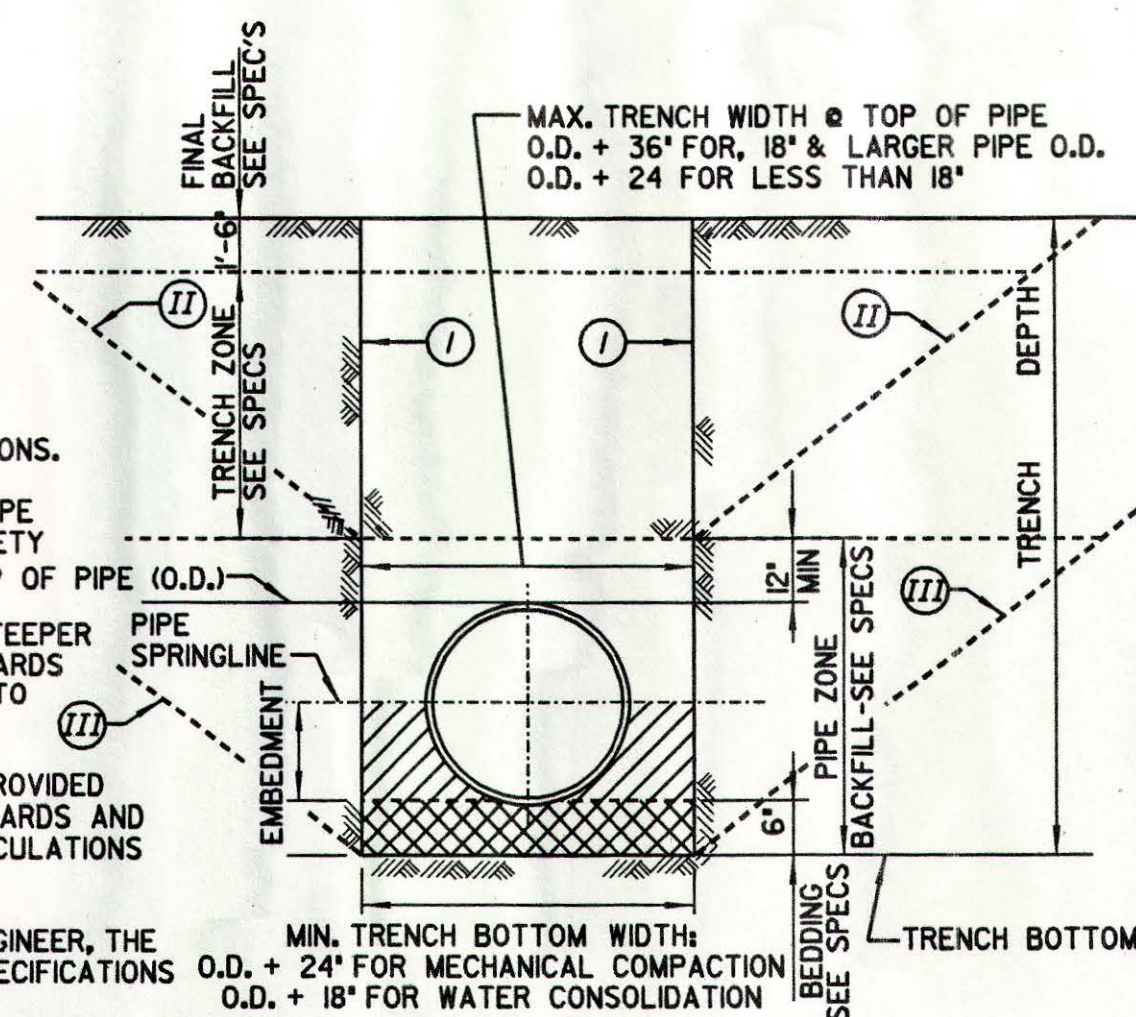

TRENCH SECTION - RIGID PIPE

NOT TO SCALE

C-602

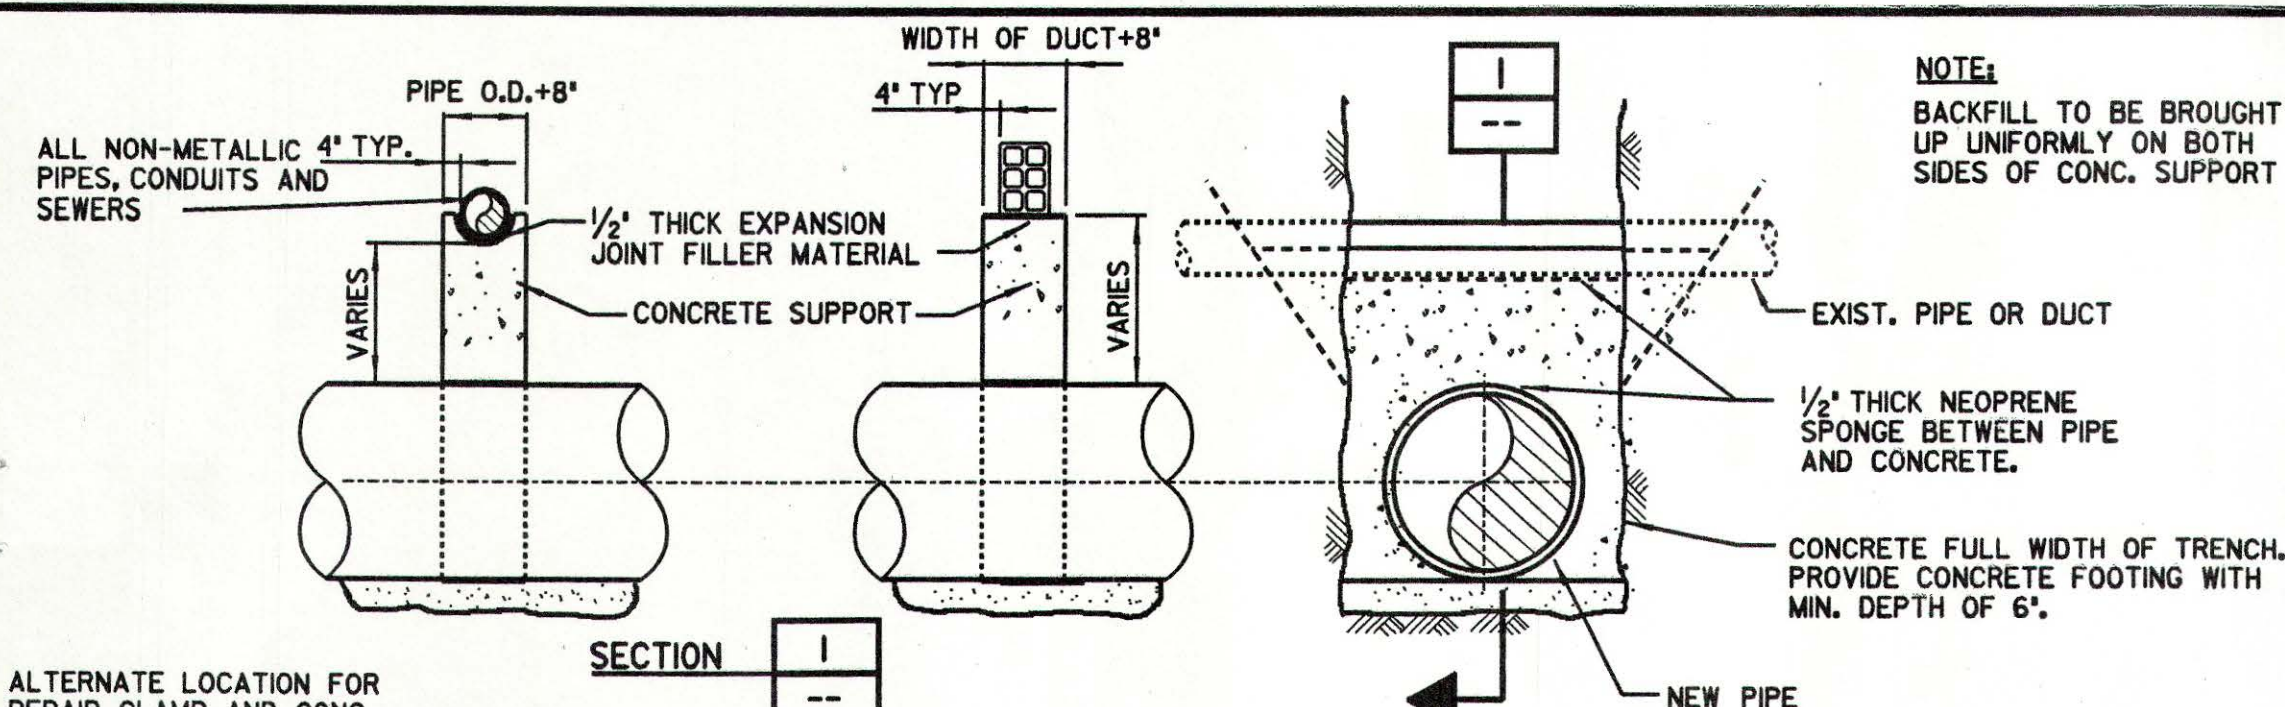


NOTES:

1. UNDERGROUND UTILITY SUPPORTS ARE TO BE PROVIDED WHEN MINIMUM CLEARANCE OF 12 INCHES CANNOT BE PROVIDED.
2. EXISTING PIPE OR DUCT SHALL BE FIRMLY SUPPORTED DURING INSTALLATION OF NEW PIPE AND SUPPORT.

UNDERGROUND UTILITY SUPPORT

NOT TO SCALE

C-614

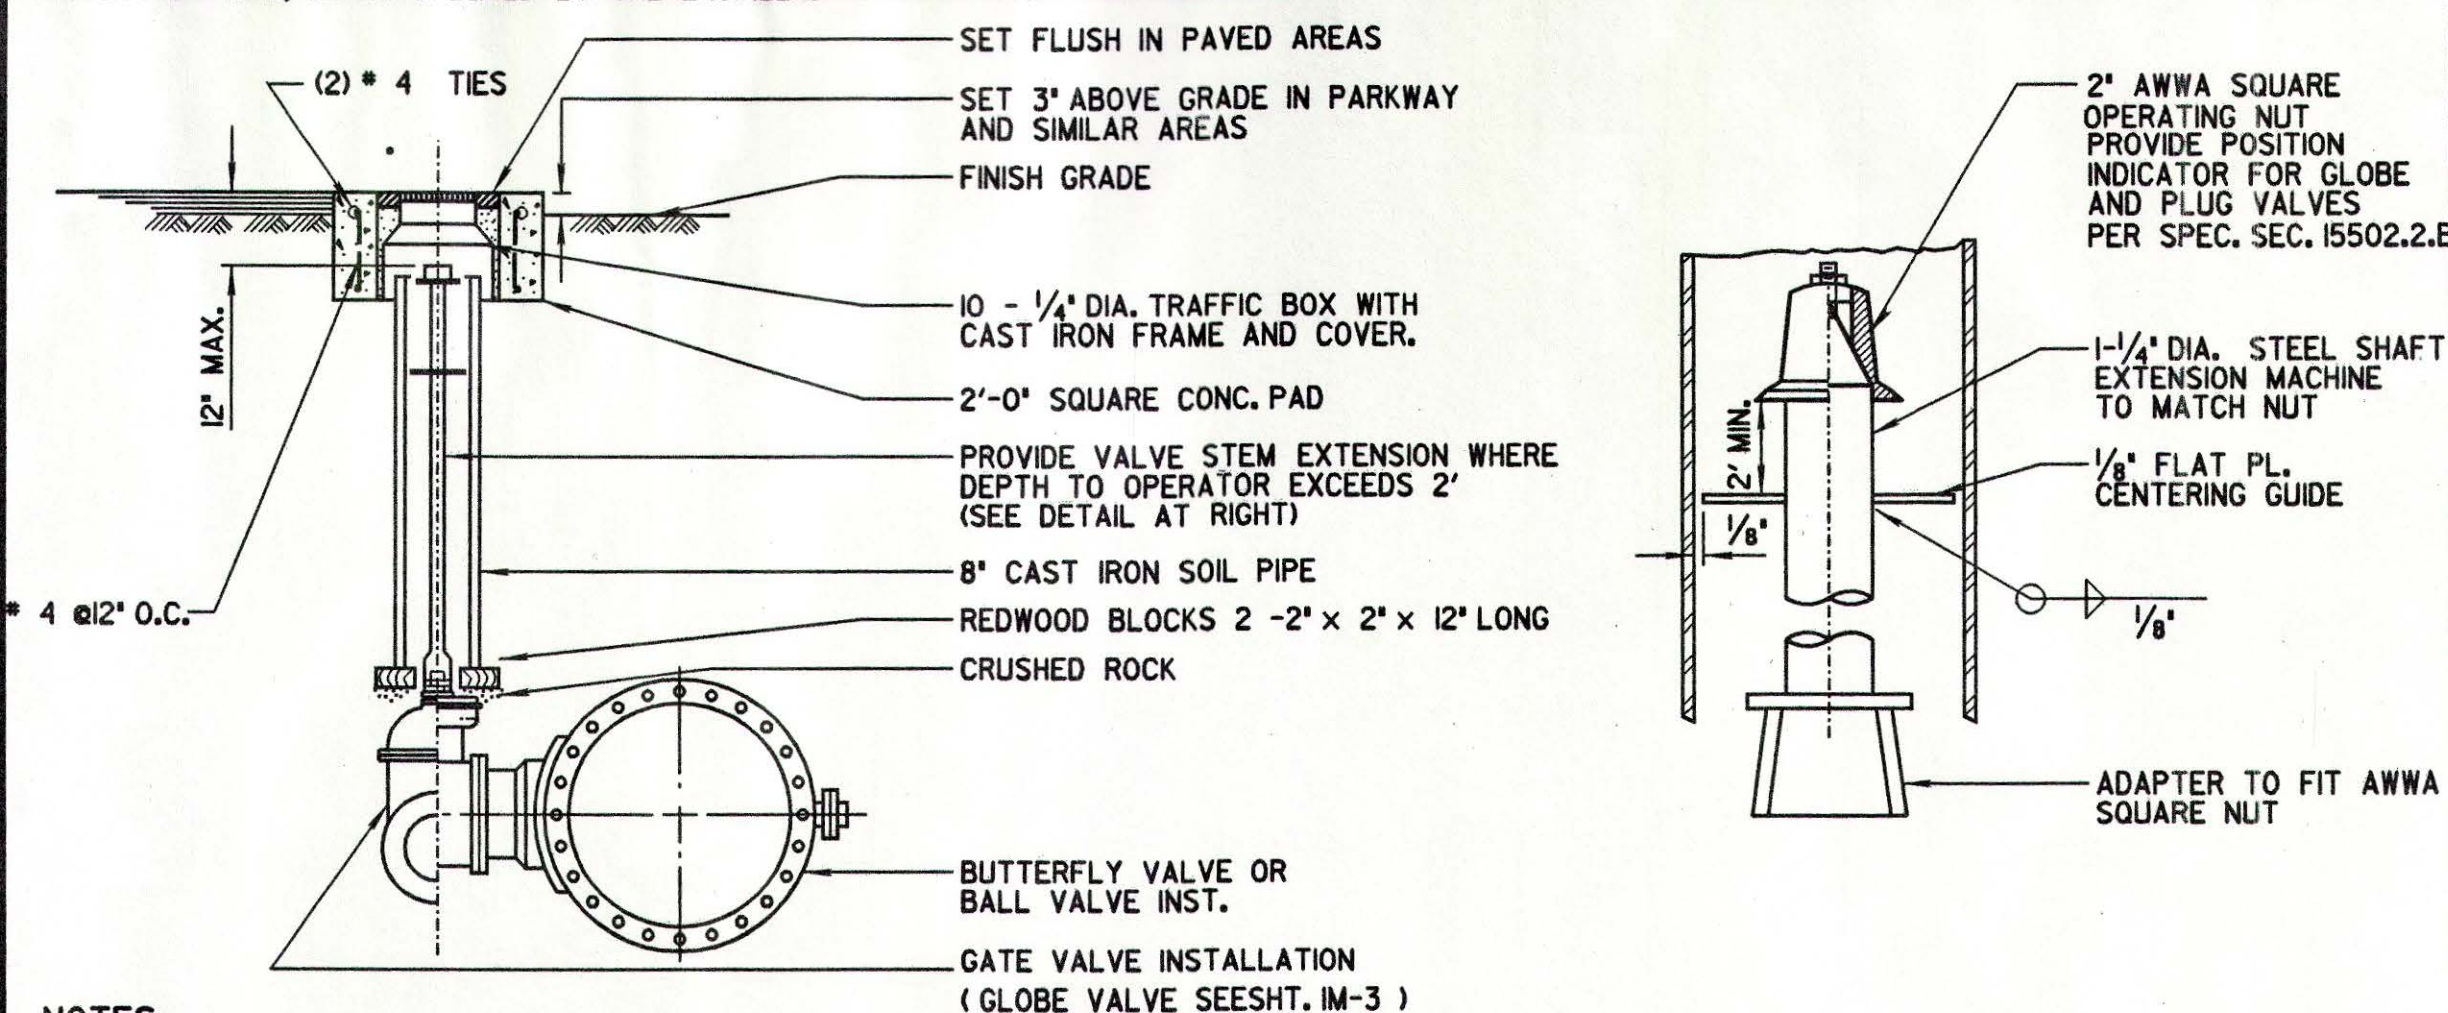

NOTES:


PROVIDE PROTECTIVE COATING TO EXTERIOR SURFACE OF VALVE BODY IN ACCORDANCE WITH SPECS.

FOR LUBRICATED PLUG VALVE, EXTEND LUBRICATION LINE TO GRADE PER MANUFACTURERS INSTRUCTIONS.

BURIED VALVE INSTALLATION

NOT TO SCALE

C-640

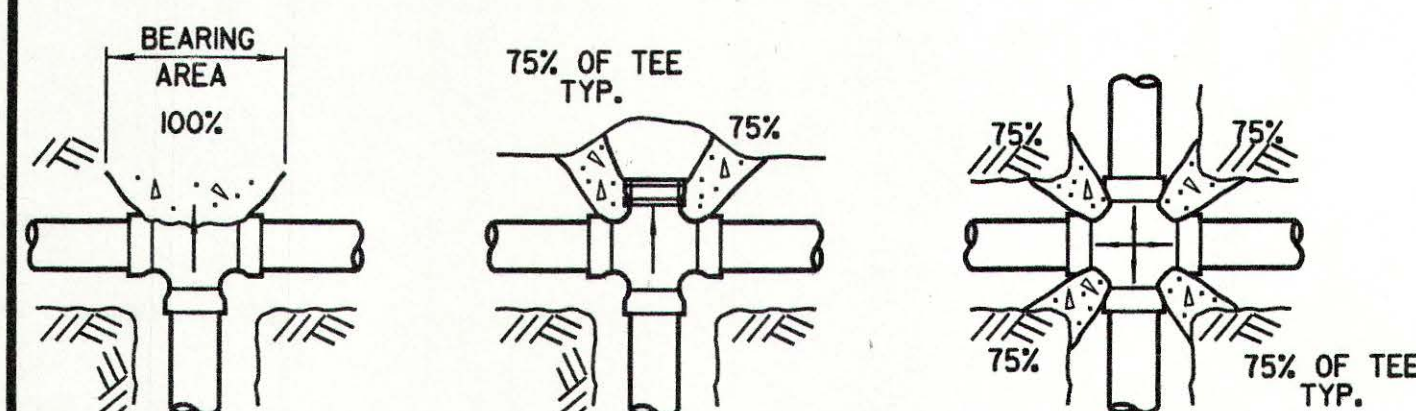


PLANS

PIPE SIZE	DEAD END OR TEE	90° ELBOW	45° ELBOW	22 1/2° ELBOW
4	19	27	15	7
6	39	55	30	15
8	67	94	51	26
10	109	154	84	43
12	155	218	119	61
14	210	296	161	82
16	275	383	209	106
18	351	494	269	137
20	434	611	333	169
24	623	878	478	244

EXAMPLE:

8 INCH 90° ELBOW, PRESSURE = 200LB./ SQ. IN. FROM TABLE:  
THRUST = 94 x 200 = 18,800 LBS.  
ASSUME BEARING STRENGTH OF SOIL = 2000 LB./SQ. FT.  
18,800 = 9.4 SQ. FT. = AREA OF BEARING REQUIRED FOR THRUST BLOCK.

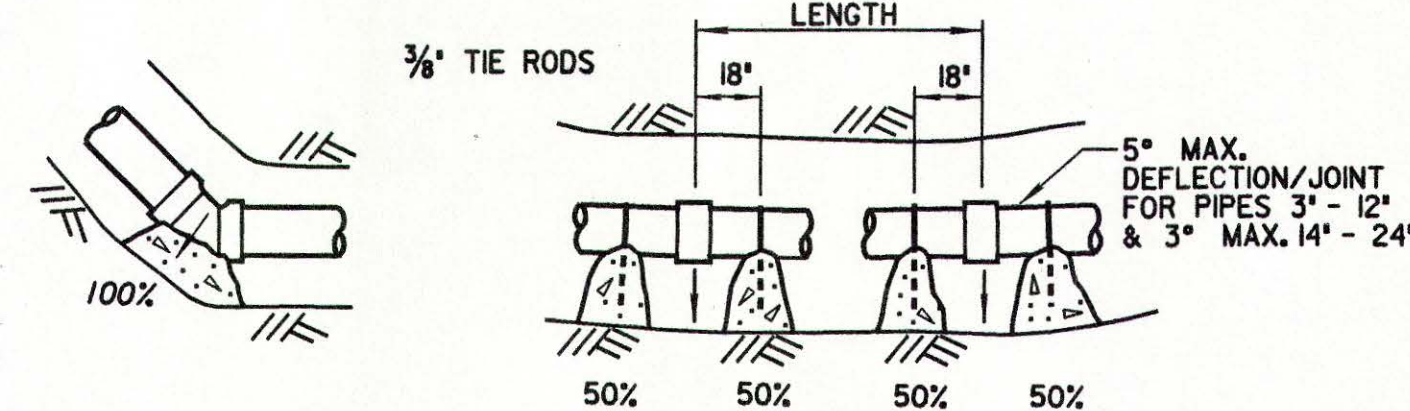


CURVE THRUST BLOCKING

PIPE SIZE	SIDE THRUST-10°	PIPE SIZE	SIDE THRUST-10°
4	35	14	377
6	72	16	486
8	122	18	665
10	197	20	790
12	278	24	1150

MULTIPLY THRUST BY DEGREE OF DEFLECTION TO OBTAIN TOTAL THRUST.

NOTES:

1. IN USING THE ABOVE TABLES, USE THE MAXIMUM INTERNAL PRESSURE ANTICIPATED (I.e. HYDROSTATIC TEST PRESSURE, POSSIBLE SURGE PRESSURE DUE TO PUMP SHUT-OFF, ETC.).
2. SEE SOILS REPORT FOR BEARING STRENGTH OF SOIL. IN THE ABSENCE OF A SOILS REPORT, AN AVERAGE SOIL (SPADABLE MEDIUM CLAY) CAN BE ASSUMED TO HAVE A BEARING STRENGTH OF 2000 P.S.F.
3. THRUST BLOCKS ARE NOT REQUIRED ON P.V.C. PIPE WITH SOLVENT WELDED JOINTS.
4. CONCRETE FOR THRUST BLOCKS TO BE 2000 P.S.I.
5. ARROWS (—) INDICATE THRUST DIRECTION.
6. FIGURE (100%) AT THRUST BLOCK INDICATES PERCENT OF TOTAL THRUST TO BE APPLIED FOR BEARING AREA.

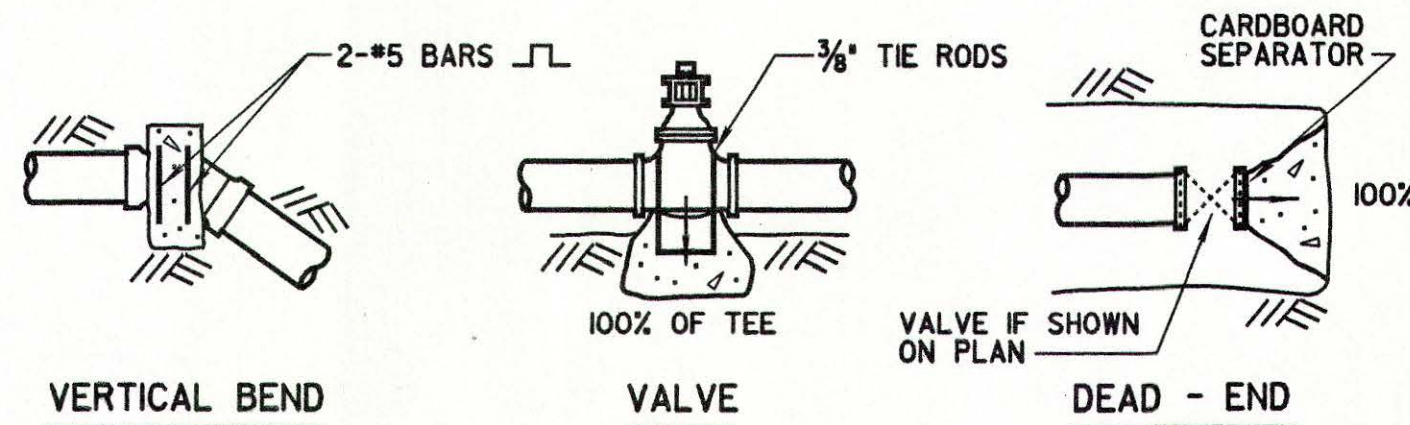

VERTICAL BEND

VALVE

DEAD - END

CONCRETE THRUST BLOCKS FOR DUCTILE IRON AND P.V.C. PIPE

NOT TO SCALE

C-610

REV	DATE	BY	OWMD	DESCRIPTION

SCALE

AS SHOWN

WARNING

IF THIS BAR DOES NOT MEASURE 1" THEN DRAWING IS NOT TO SCALE

DESIGNED

MW

DRAWN

N. NAZARIAN

CHECKED

T. BUI

SUBMITTED BY

PROJECT MANAGER

COMPANY OFFICER

50812

12/13/00

DATE

33699

12/13/00

DATE



MONTGOMERY WATSON

Pasadena, California

APPROVED

George R. Bunt

OLIVENHAIN MWD

APPROVED

FILANC CONSTRUCTION CO.

DATE

8.29.01

DATE

KELWOOD DEVELOPMENT COMPANY

45 RANCH SANITATION DISTRICT

WASTEWATER TREATMENT PLANT EXPANSION TO 2.0 MGD

CIVIL STANDARD DETAILS - 3


SHEET

GC-4


OF SHEETS

The limited review of this document by PBS & J on behalf of the Olivenhain Municipal Water District, is intended as a limited review only for general conformance with: (1) This approved Design and documents, (2) Accepted standards of practice within the industry, and (3) The standards of the Olivenhain Municipal Water District. This limited review in no way is intended, nor shall it be construed, to relieve the Design/Build Team of any professional liability to the responsibility to provide a complete and functional facility that is compliant with all applicable specifications, standards, codes, and regulations.

PBS & J  
Date: 8/23/01 By: [Signature]

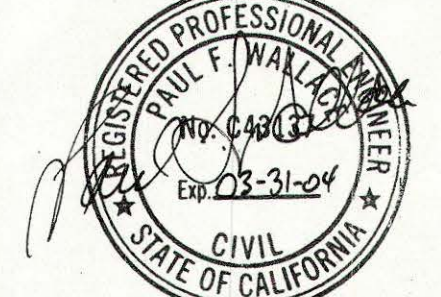




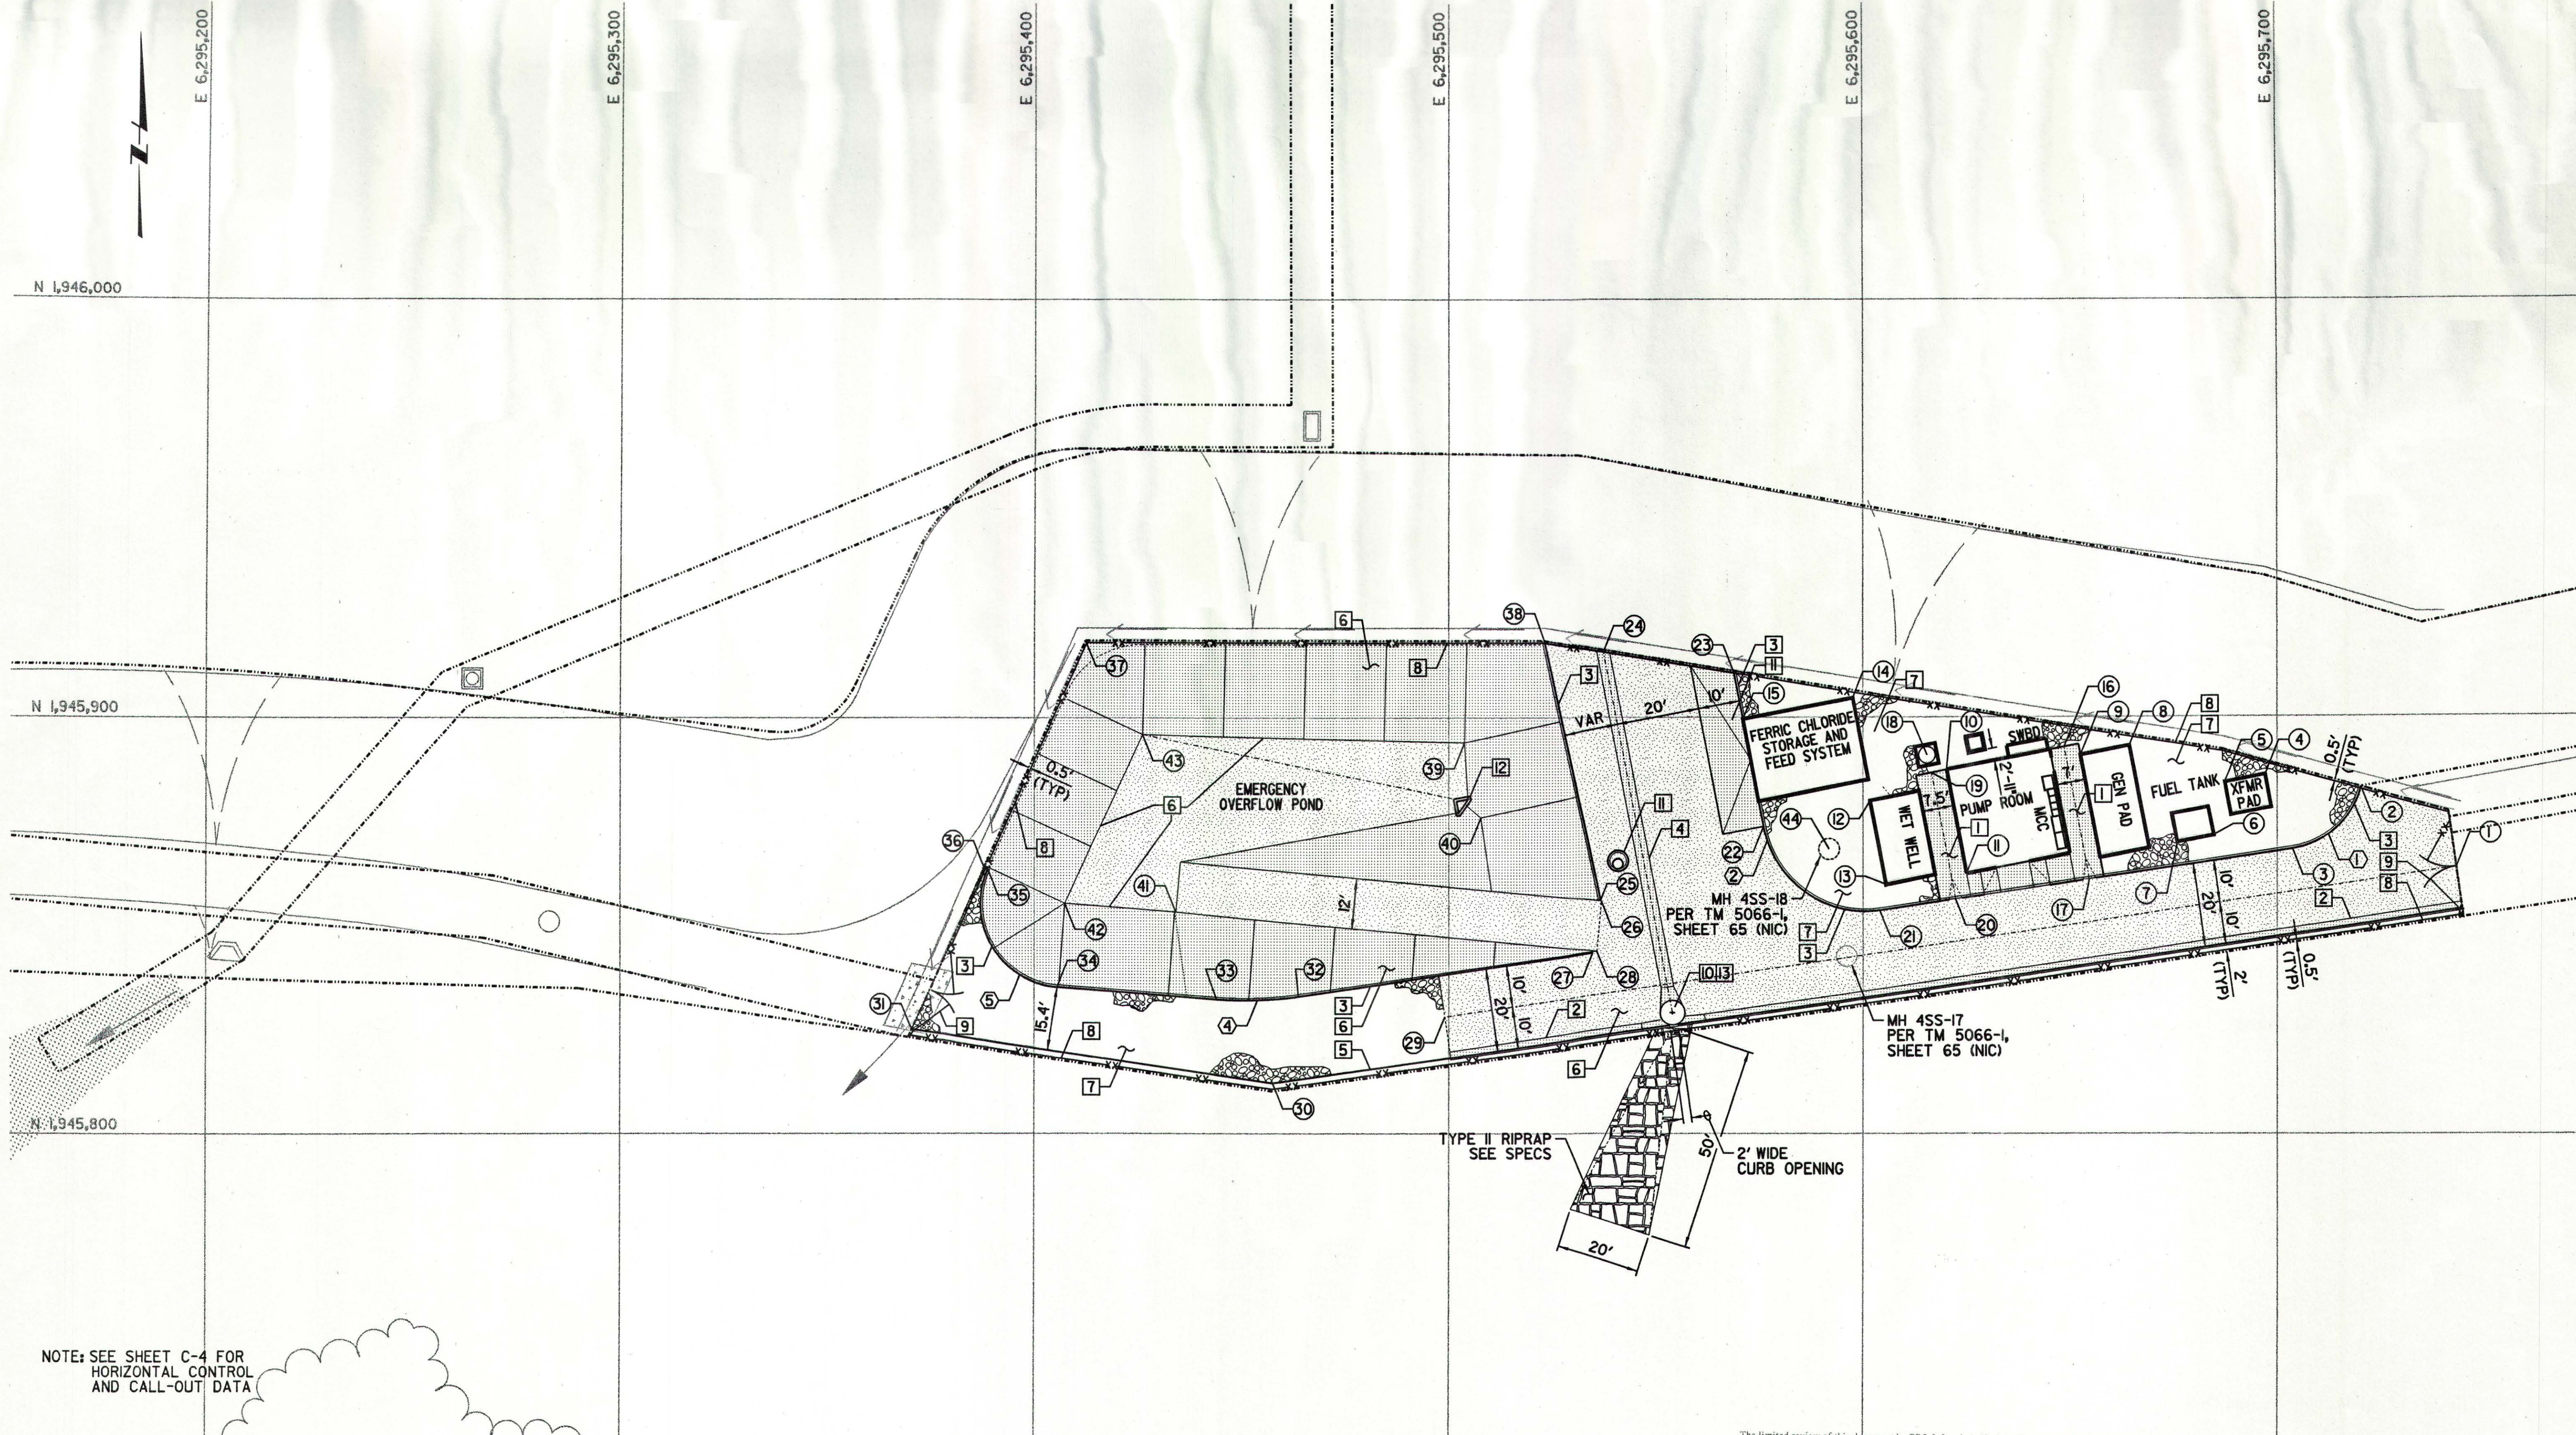

The limited review of this document by PBS & J on behalf of the Olivenhain Municipal Water District, is intended as a limited review only for general conformance with: (1) This approved Design/Build documents, (2) Accepted standards of practice within the industry, and (3) The standards of the Olivenhain Municipal Water District. This limited review in no way is intended, nor shall it act, to relieve the Design/Build Team of any professional liability to the responsibility to provide a complete and functional facility that is compliant with all applicable specifications, standards, codes, and regulations.

PBS &amp; J

Date: 8/23/01 By: J. A. J.

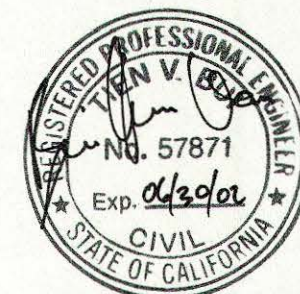

REV	DATE	BY	OMWD	DESCRIPTION

SCALE
1" = 20'
WARNING
0 1/2 1
IF THIS BAR DOES NOT MEASURE 1" THEN DRAWING IS NOT TO SCALE

DESIGNED	T BUI
DRAWN	T BUI
CHECKED	J. MOUAWAD

SUBMITTED BY	DATE
PROJECT MANAGER	12/13/00
LICENSE NO.	33699
DATE	12/13/00
COMPANY OFFICER	LICENSE NO.



**MONTGOMERY WATSON**  
Pasadena, California

APPROVED	DATE
George R. Bont	8.29.01
OLIVENHAIN MWD	DATE
APPROVED	DATE
FILANC CONSTRUCTION CO.	DATE


KELWOOD DEVELOPMENT COMPANY
45 RANCH SANITATION DISTRICT
WASTEWATER TREATMENT PLANT EXPANSION TO 2.0 MGD
NEIGHBORHOOD NO. 1 PUMP STATION
HORIZONTAL CONTROL AND PAVING PLAN

SHEET

12C-1


OF 4 SHEETS



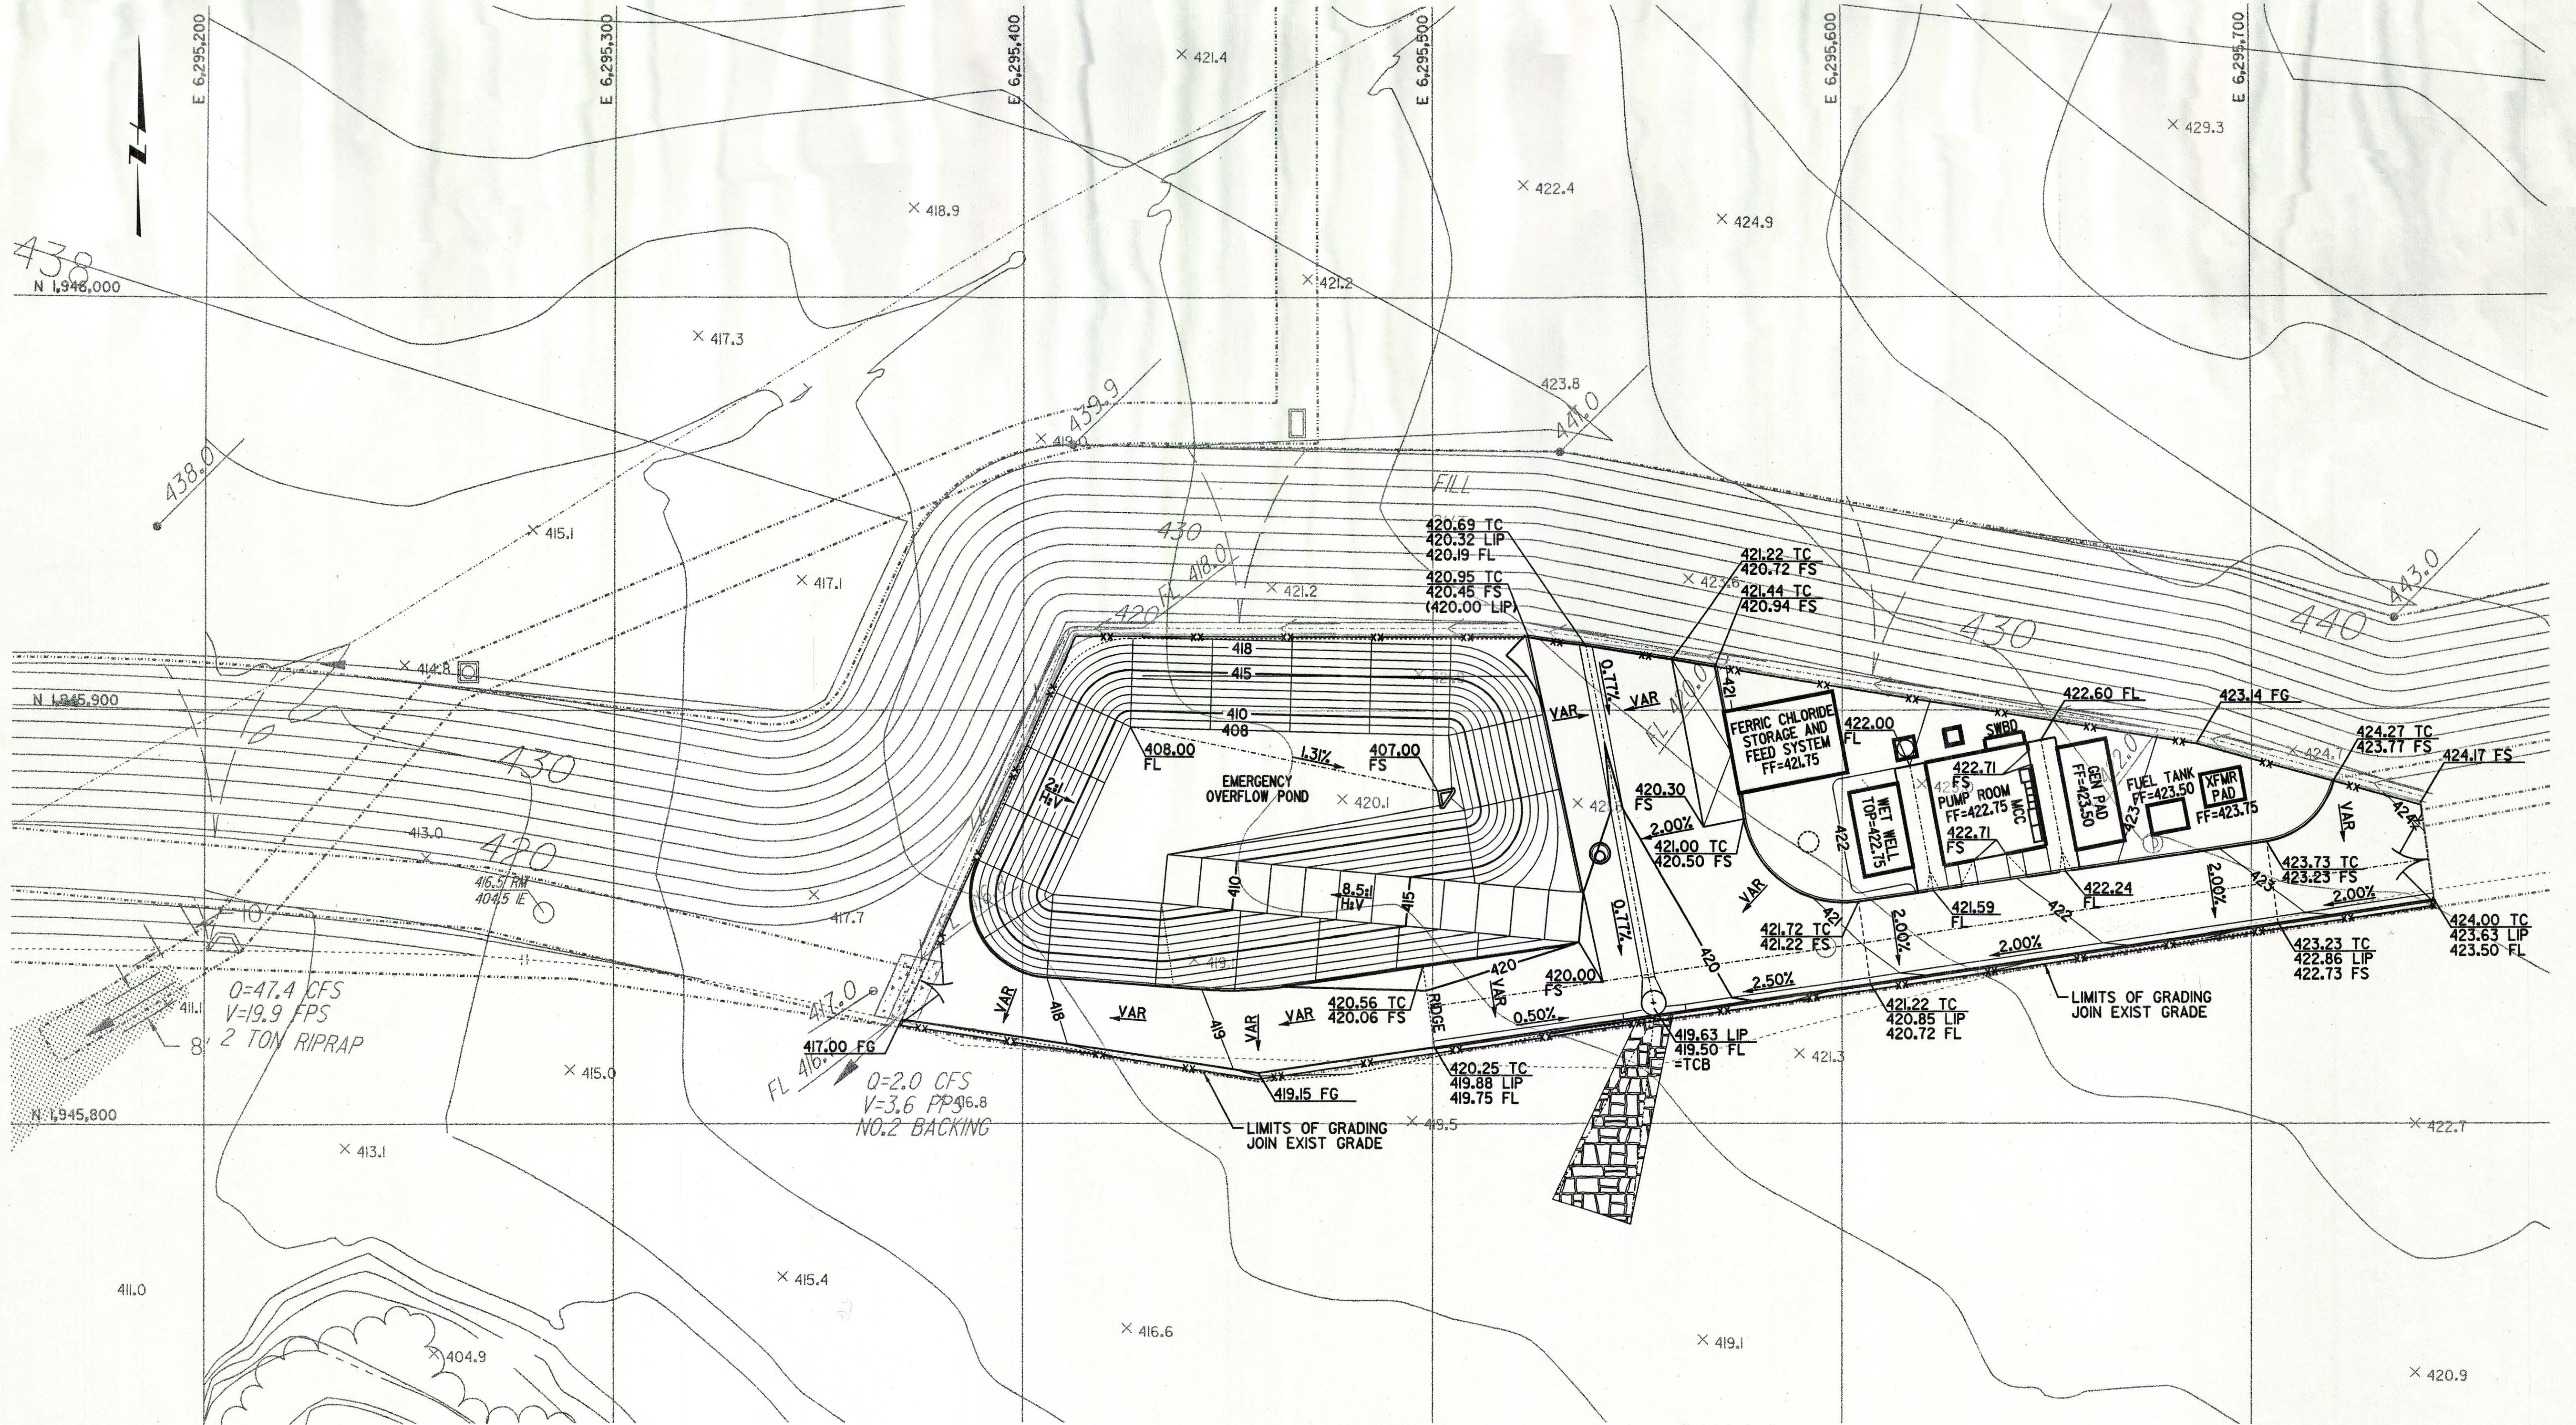

The limited review of this document by PBS & J on behalf of the Olivenhain Municipal Water District, is intended as a limited review only for general conformance with: (1) This approved Design/Build documents, (2) Accepted standards of practice within the industry, and (3) The standards of the Olivenhain Municipal Water District. This limited review in no way is intended, nor shall it act, to relieve the Design/Build Team of any professional liability to provide a complete and functional facility that is compliant with all applicable specifications, standards, codes, and regulations.

PBS & J  
Date: 8/23/01 By: J. O'Connell

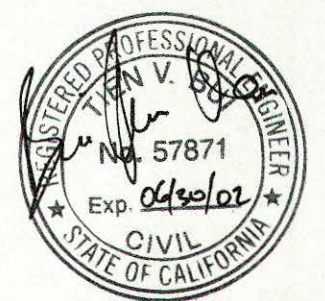

REV	DATE	BY	OMWD	DESCRIPTION

SCALE	WARNING
1" = 20'	IF THIS BAR DOES NOT MEASURE 1" THEN DRAWING IS NOT TO SCALE

DESIGNED	T BUI
DRAWN	T BUI
CHECKED	J MOUAWAD

SUBMITTED BY	PROJECT MANAGER	50602	12/13/01
COMPANY OFFICER	33699	12/13/01	DATE



**MONTGOMERY WATSON**  
Pasadena, California

APPROVED	George P. Bont	8.29.01
OLIVENHAIN MWD	DATE	DATE
APPROVED	FILANC CONSTRUCTION CO.	DATE

KELWOOD DEVELOPMENT COMPANY	45 RANCH SANITATION DISTRICT
WASTEWATER TREATMENT PLANT EXPANSION TO 2.0 MGD	NEIGHBORHOOD NO. 1 PUMP STATION
GRADING AND DRAINAGE PLAN	

SHEET	12C-2
OF SHEETS	




15:03

Plot Date: 05-NOV-2001

File: P:\Projects\45R\00\civil\45r\_nbps.c03.dwg

Job No: MW Job #

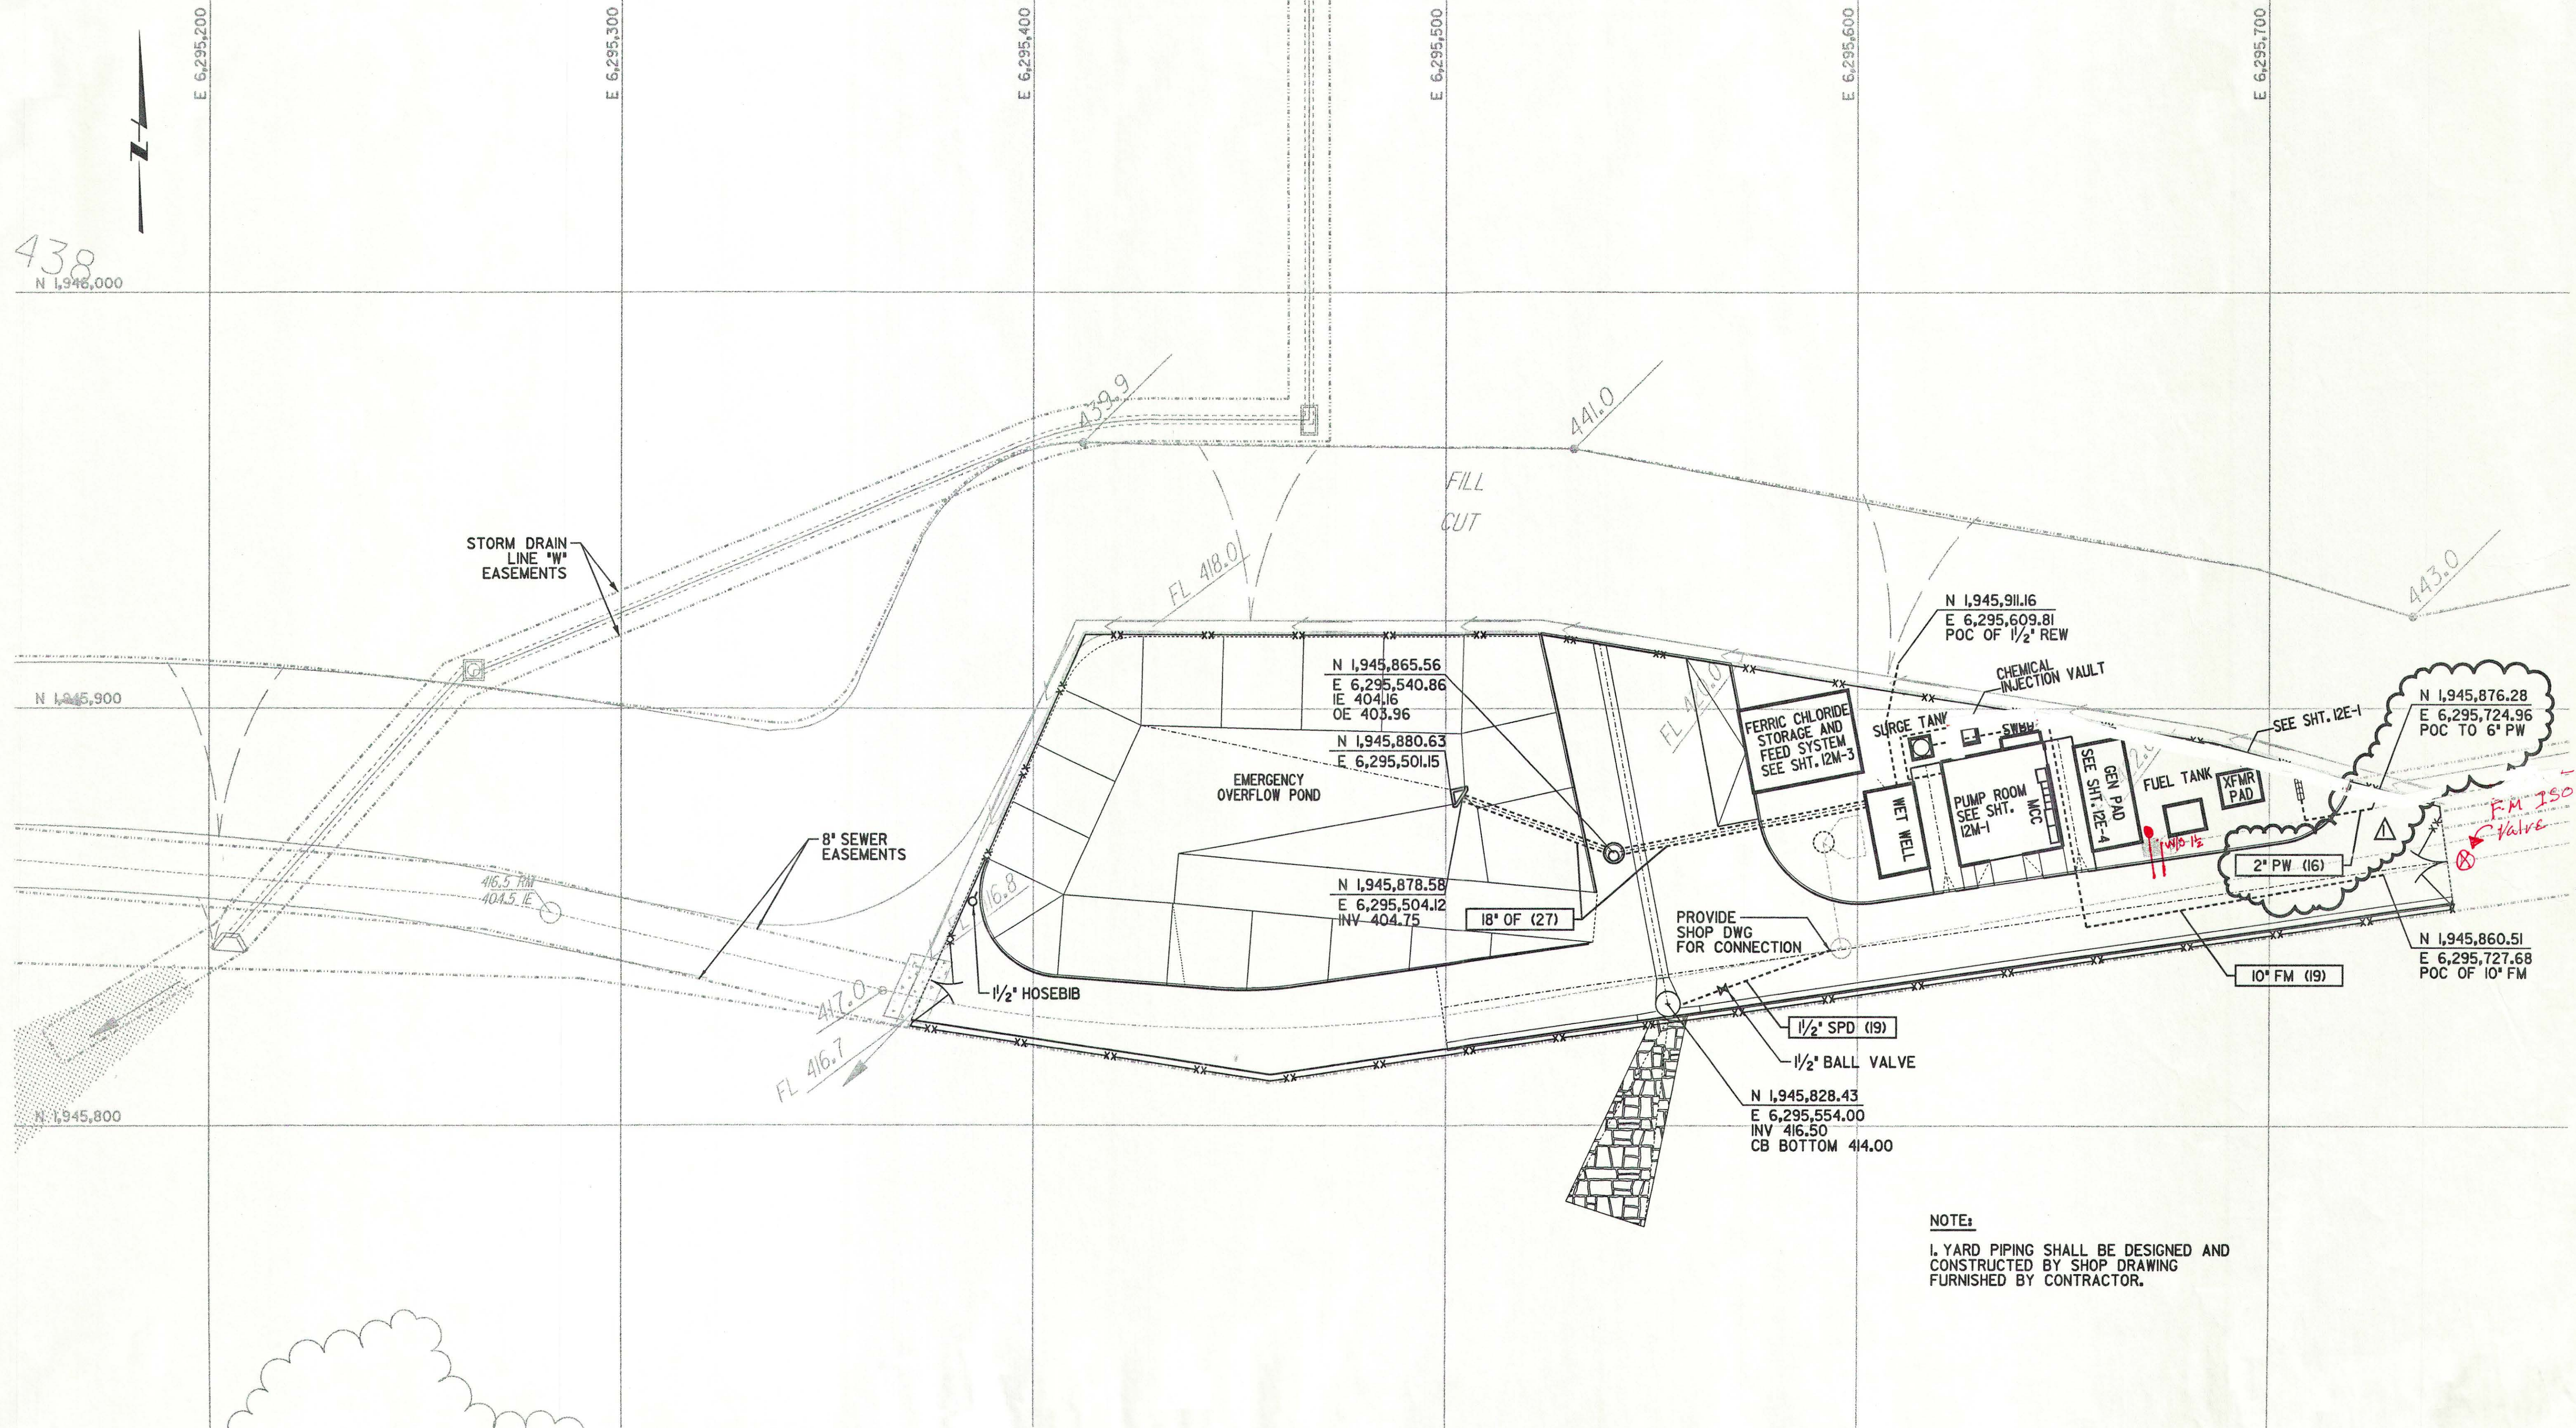

NOTE:  
1. YARD PIPING SHALL BE DESIGNED AND  
CONSTRUCTED BY SHOP DRAWING  
FURNISHED BY CONTRACTOR.

The limited review of this document by PBS & J on behalf of the Olivenhain Municipal Water District, is intended as a limited review only for general conformance with: (1) The approved Design/build documents, (2) Accepted standards of practice within the industry, and (3) The standards of the Olivenhain Municipal Water District. This limited review in no way is intended, nor shall it act, to relieve the Design/Build Team of any professional liability to the responsibility to provide a complete and functional facility that is compliant with all applicable specifications, standards, codes, and regulations.

PBS & J  
Date: 12/13/01 By: [Signature]



DESIGNED T. BUI		SUBMITTED BY [Signature]		APPROVED [Signature]		KELWOOD DEVELOPMENT COMPANY		SHEET	
DRAWN T. BUI		PROJECT MANAGER		OLIVENHAIN MWD		45 RANCH SANITATION DISTRICT		12C-3	
CHECKED J. MOUAWAD		COMPANY OFFICER		FILANC CONSTRUCTION CO.		WASTEWATER TREATMENT PLANT EXPANSION TO 2.0 MGD		OF SHEETS	
DATE		DATE		DATE		NEIGHBORHOOD NO. 1 PUMP STATION			
DESCRIPTION		DATE		DATE		YARD PIPING PLAN			

SCALE: 1" = 20'

WARNING: IF THIS BAR DOES NOT MEASURE 1" THEN DRAWING IS NOT TO SCALE

REV: 1/05/01 BY: PFW DESCRIPTION: DELETE FH PER FIRE DEPT PERMIT

DATE: 11/5/01

DATE: 11/5/01

DATE: 11/5/01

43137 LICENSE NO.

33699 LICENSE NO.

43137 LICENSE NO.

Pasadena, California

11/5/01

11/5/01



SEE SHEET 12C-1 FOR DRAWINGS


CURVE DATA				
NO.	R (FT)	L (FT)	Δ	T (FT)
①	20.00	23.58	67° 32' 26"	13.37
②	25.00	38.13	87° 23' 11"	23.88
③	NOT USED	*	*	*
④	90.00	19.76	12° 34' 35"	9.92
⑤	20.00	38.34	109° 50' 45"	28.48
⑥	NOT USED	*	*	*

CONSTRUCTION NOTES			
① CONSTRUCT CONCRETE SIDEWALK PER DETAIL	C-120	⑦ CONSTRUCT GRAVEL PAVEMENT PER DETAIL	C-144
② CONSTRUCT CONCRETE CURB & GUTTER PER DETAIL	C-123	⑧ CONSTRUCT BLACK VINYL-COATED CHAIN LINK FENCE SIMILAR TO DETAIL	C-101
③ CONSTRUCT CONCRETE CURB PER DETAIL	C-124	⑨ CONSTRUCT 22' BLACK VINYL-COATED DOUBLE SWING GATE SIMILAR TO DETAIL	C-102
④ CONSTRUCT CONCRETE CROSS GUTTER PER DETAIL	C-127	⑩ CONSTRUCT 6' DIA CATCH BASIN MANHOLE/ PUMP STATION/WITH GALV TRAFFIC RATED GRATING	C-501
⑤ CONSTRUCT REDWOOD HEADER PER DETAIL	C-134	⑪ CONSTRUCT CONC SLAB PER DETAIL	S-190
⑥ CONSTRUCT ASPHALTIC CONCRETE PAVEMENT PER DETAIL	C-142	⑫ CONSTRUCT INLET/OUTLET BOX SIMILAR TO DRAWING 7S-1	
		⑬ INSTALL HYDROMATIC SW25 (20 GPM @ 8-FT TDH) IN CATCH BASIN	
		⑭ CONSTRUCT SHOTCRETE PAVEMENT PER DETAIL	C-190

HORIZONTAL CONTROL			
NO.	DISCRIPTION	NORTHING	EASTING
①	ROAD CL	1,945,863.81	6,295,743.19
②	BEGIN CURB/CURB BC	1,945,883.07	6,295,720.20
③	CURB EC	1,945,868.18	6,295,703.69
④	PAD CORNER	1,945,886.13	6,295,697.12
⑤	PAD CORNER	1,945,884.25	6,295,687.30
⑥	FUEL TANK	1,945,871.52	6,295,684.65
⑦	FUEL TANK	1,945,869.82	6,295,675.81
⑧	GEN PAD CORNER	1,945,893.06	6,295,664.22
⑨	GEN PAD CORNER	1,945,890.79	6,295,652.44
⑩	PUMP ROOM CORNER	1,945,887.32	6,295,620.18
⑪	PUMP ROOM CORNER	1,945,862.44	6,295,624.96
⑫	WET WELL CORNER	1,945,880.04	6,295,601.72
⑬	WET WELL CORNER	1,945,859.91	6,295,605.58
⑭	BUILDING CORNER	1,945,904.69	6,295,597.50
⑮	BUILDING CORNER	1,945,899.60	6,295,570.98
⑯	FLOWLINE	1,945,892.75	6,295,648.50
⑰	FLOWLINE	1,945,861.06	6,295,654.58
⑱	SURGE TANK CENTER	1,945,890.82	6,295,615.44
⑲	FLOWLINE	1,945,886.61	6,295,616.50
⑳	FLOWLINE	1,945,856.38	6,295,622.30
㉑	CURB BC	1,945,853.74	6,295,604.08
㉒	CURB EC	1,945,873.77	6,295,575.94
㉓	END CURB	1,945,911.17	6,295,568.76
㉔	BEGIN CURB & GUTTER	1,945,916.26	6,295,537.24
㉕	BEGIN CURB	1,945,856.20	6,295,536.66
㉖	TOP OF RAMP	1,945,856.03	6,295,536.83
㉗	BEGIN CURB	1,945,843.68	6,295,534.72
㉘	TOP OF RAMP	1,945,844.08	6,295,535.72
㉙	ROAD CL	1,945,828.40	6,295,499.02
㉚	PI	1,945,812.28	6,295,457.51
㉛	PI	1,945,825.28	6,295,370.45
㉜	BC	1,945,833.39	6,295,463.69
㉝	EC	1,945,832.71	6,295,443.99
㉞	BC	1,945,835.62	6,295,405.56
㉟	EC, END CURB	1,945,863.75	6,295,388.82
㊱	PI	1,945,864.16	6,295,387.91
㊲	PI	1,945,918.59	6,295,412.33
㊳	END CURB	1,945,918.54	6,295,523.09
㊴	POND BOTTOM	1,945,894.02	6,295,503.87
㊵	POND BOTTOM	1,945,876.04	6,295,507.78
㊶	BOTTOM OF RAMP	1,945,853.51	6,295,434.15
㊷	POND BOTTOM	1,945,855.54	6,295,407.41
㊸	POND BOTTOM	1,945,895.97	6,295,426.16
㊹	C/L SEWER MH (NIC)	1,945,868.29	6,295,591.75

The limited review of this document by PBS & J on behalf of the Olivenhain Municipal Water District, is intended as a limited review only for general conformance with; (1) This approved Design/Build documents, (2) Accepted standards of practice within the industry, and (3) The standards of the Olivenhain Municipal Water District. This limited review in no way is intended, nor shall it act, to relieve the Design/Build Team of any professional liability to the responsibility to provide a complete and functional facility that is compliant with all applicable specifications, standards, codes, and regulations.

PBS & J  
Date: 8/23/01 By: [Signature]

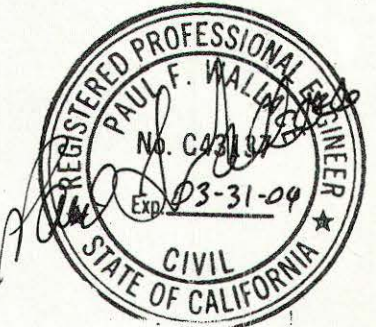

Job No: MW Job #: File: P:\Projects\45R\00\civ\4sr-nbps\_c04.dwg Plot Date: 12-DEC-2000 14:57

REV	DATE	BY	QMW	DESCRIPTION

SCALE  
NONE

WARNING  
0 1/2  
IF THIS BAR DOES NOT MEASURE 1" THEN DRAWING IS NOT TO SCALE

DESIGNED T BUI  
DRAWN P BOGDANOFF  
CHECKED J MOUAWAD

SUBMITTED BY  
PROJECT MANAGER  
COMPANY OFFICER

50802 12/13/00  
33699 12/13/00

LICENSE NO. DATE  
LICENSE NO. DATE









MONTGOMERY WATSON  
Pasadena, California

APPROVED  
George R. Bunt  
APPROVED  
FILANC CONSTRUCTION CO.  
DATE

KELWOOD DEVELOPMENT COMPANY  
45 RANCH SANITATION DISTRICT  
WASTEWATER TREATMENT PLANT EXPANSION TO 2.0 MGD  
NEIGHBORHOOD NO. 1 PUMP STATION  
HORIZONTAL CONTROL AND CALL-OUT DATA

SHEET  
12C-4  
OF 5 SHEETS



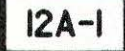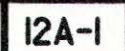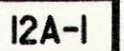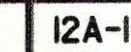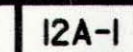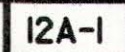


A circular professional engineer seal for the State of California. The outer ring contains the text "REGISTERED PROFESSIONAL ENGINEER" at the top and "STATE OF CALIFORNIA" at the bottom, separated by a star on the right. The center of the seal contains the name "PAUL F. WALLING", the license number "No. C43117", and the expiration date "Exp. 03-31-04". The word "CIVIL" is printed below the expiration date. The seal is heavily inked with handwritten signatures and scribbles.

SHEET  
GA-1  
• SHEETS





PBS & J  
Date 8/23/01 By J. [Signature]

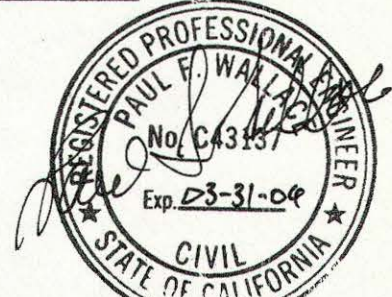


				SCALE		WARNING		DESIGNED <u>E CARBONNIER</u>		SUBMITTED BY <u>George J. J.</u>				APPROVED <u>George J. J.</u>		KELWOOD DEVELOPMENT COMPANY		SHEET	
				$\frac{1}{4}" = 1' - 0"$				DRAWN <u>C YOUNG</u>		PROJECT MANAGER <u>George J. J.</u>		50802 12/13/00		OLIVENHAIN MWD		4S RANCH SANITATION DISTRICT		12A-1	
				IF THIS BAR DOES NOT MEASURE 1' THEN DRAWING IS NOT TO SCALE				CHECKED <u>C Young</u>		COMPANY OFFICER <u>George J. J.</u>		33699 12/13/00		DATE		WASTEWATER TREATMENT PLANT EXPANSION TO 2.0 MGD		OF • SHEETS	
REV DATE BY OMWD DESCRIPTION																			








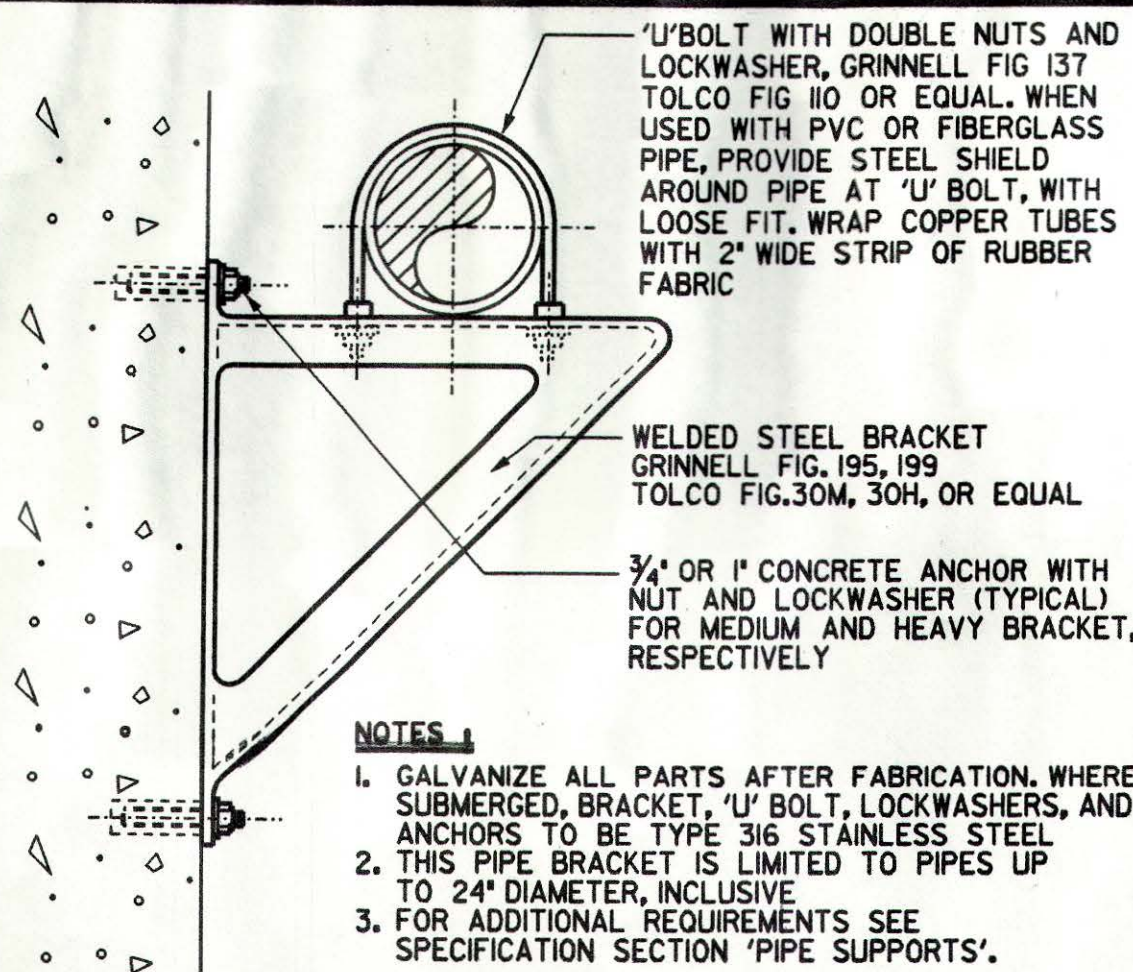

PIPE BRACKET

REV 010199

M-104

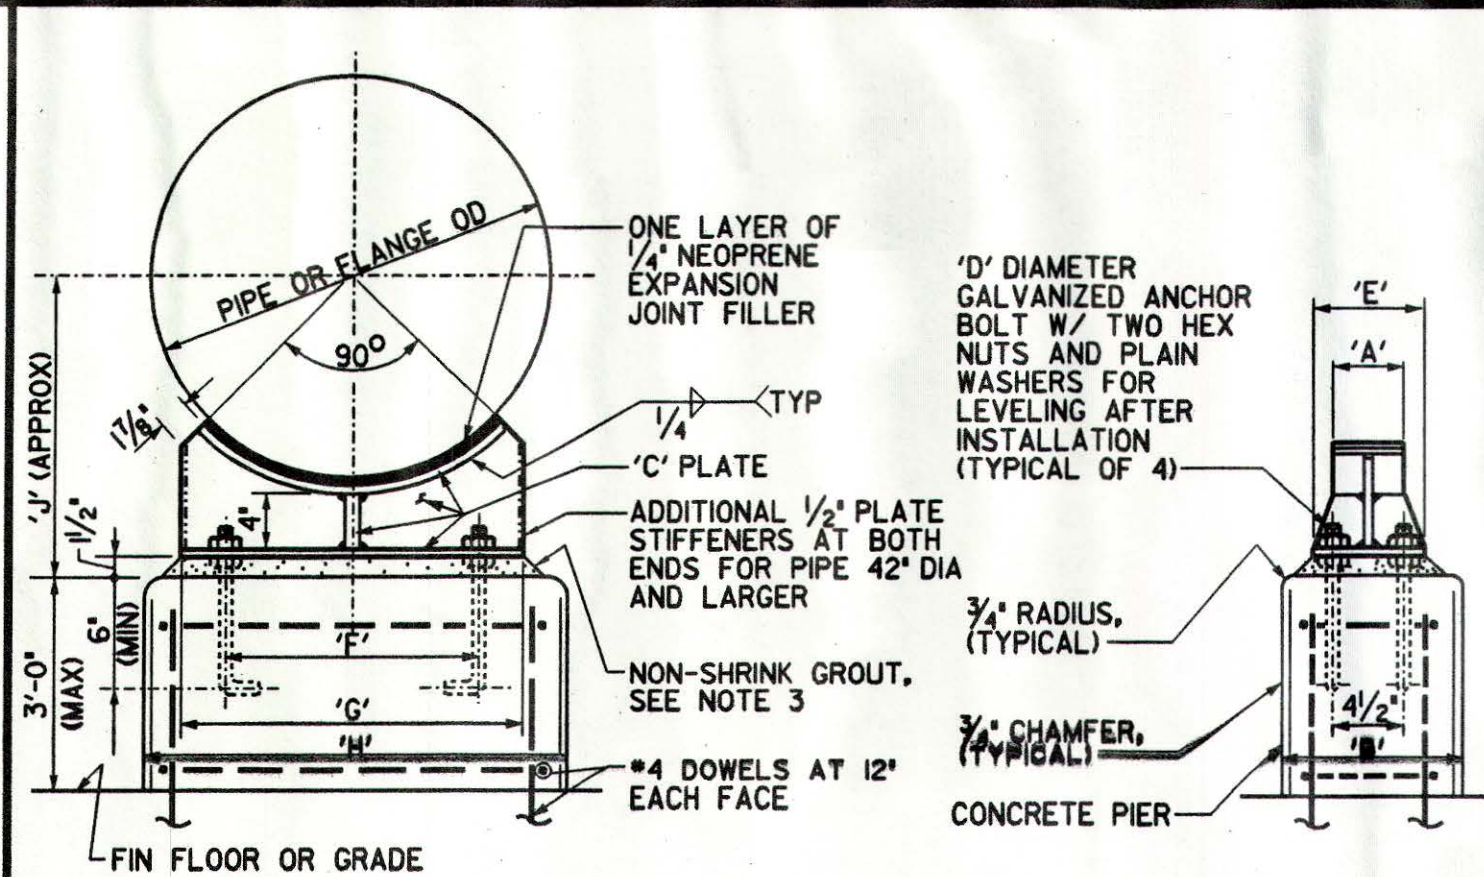


PIPE SUPPORT

REV 060299

M-109


NOMINAL PIPE SIZE	DIMENSIONS IN INCHES															
	PIPE								FLANGE							
	A	B	C	D	E	F	G	H	J	F	G	H	J			
6	4	12	3/8	5/8	6	4 1/2	6	12	10	6 1/2	9	16	13			
8	4	12	3/8	5/8	6	5	8	13	11	7 1/2	9	16	14			
10	4	12	3/8	5/8	6	6	9	15	12	9	13	18	15			
12	4	12	3/8	5/8	6	7	11	17	13	10	15	20	16			
14	4	12	3/8	5/8	6	8	12	17	14	11	16	21	17			
16	4	12	3/8	5/8	6	9	13	19	15	12	18	24	18			
18	4	12	3/8	5/8	6	10	14	20	16	13	19	24	19			
20	5	12	3/8	5/8	6	10	15	21	17	15	21	26	21			
22	5	12	3/8	5/8	6	12	18	24	18	16	23	28	22			
24	5	12	3/8	5/8	6	13	19	24	19	16	24	30	23			
26	5	12	3/8	5/8	6	14	21	27	20	18	26	32	24			
30	5	12	3/8	5/8	6	16	23	28	22	20	29	34	26			
34	5	15	3/8	5/8	6	18	26	32	24	22	33	39	29			
36	6	15	3/8	5/8	6	19	27	32	25	24	34	40	30			
42	6	18	1/2	1	8	24	36	42	31	27	39	45	33			
54	6	18	1/2	1	8	28	40	46	34	34	48	56	40			
60	6	18	1/2	1 1/8	8	32	45	52	37	36	54	60	44			
66	6	18	1/2	1 1/8	8	33	49	56	40	40	59	66	47			
72	6	18	1/2	1 1/8	8	36	53	60	43	44	63	70	50			

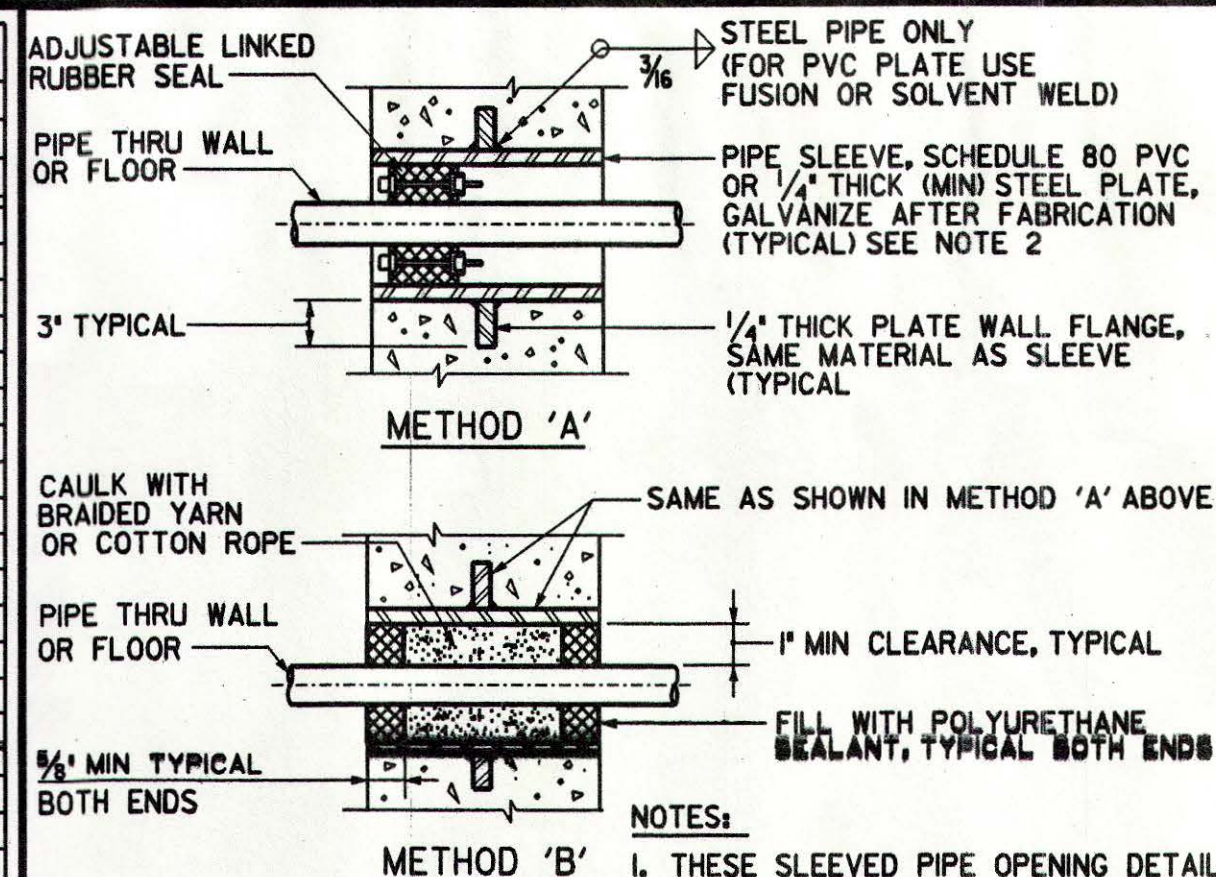

SLEEVED PIPE OPENING

REV 010199


M-111

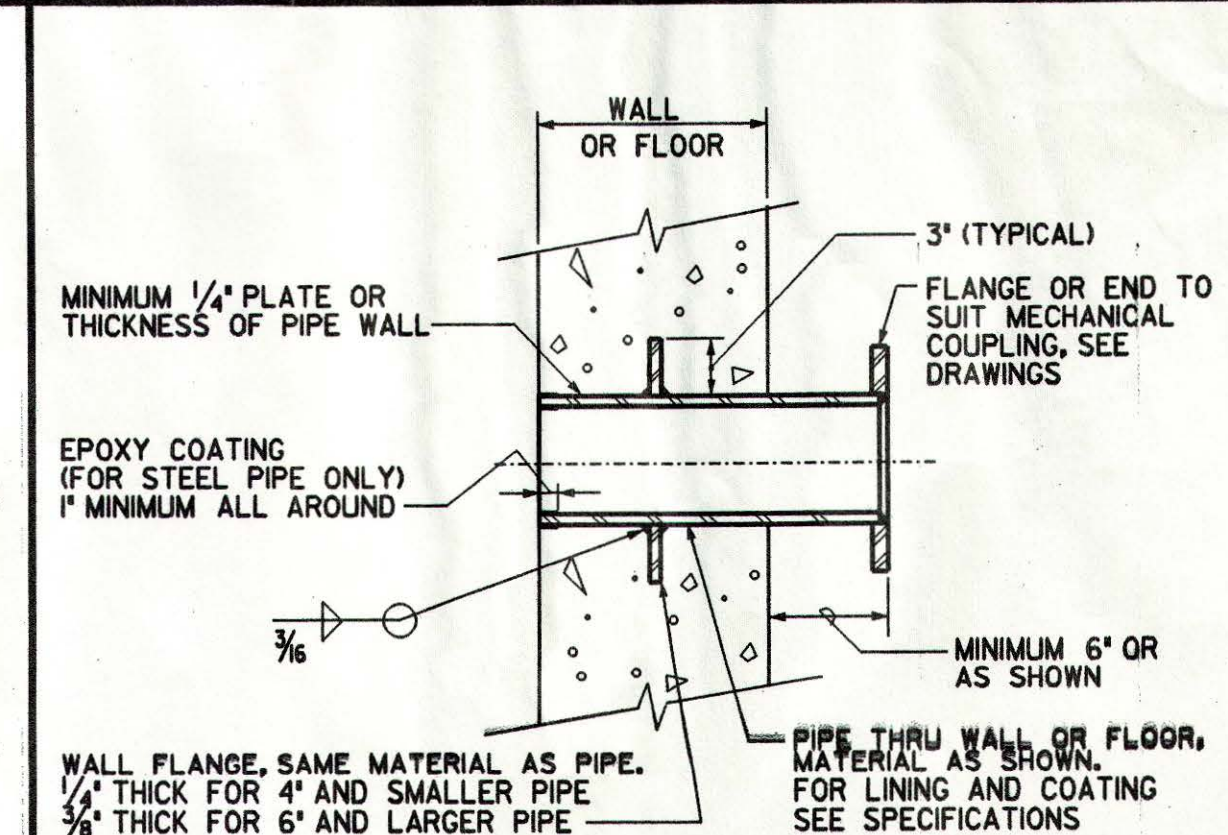

FABRICATED PIPE THIMBLE

REV 010199


M-112

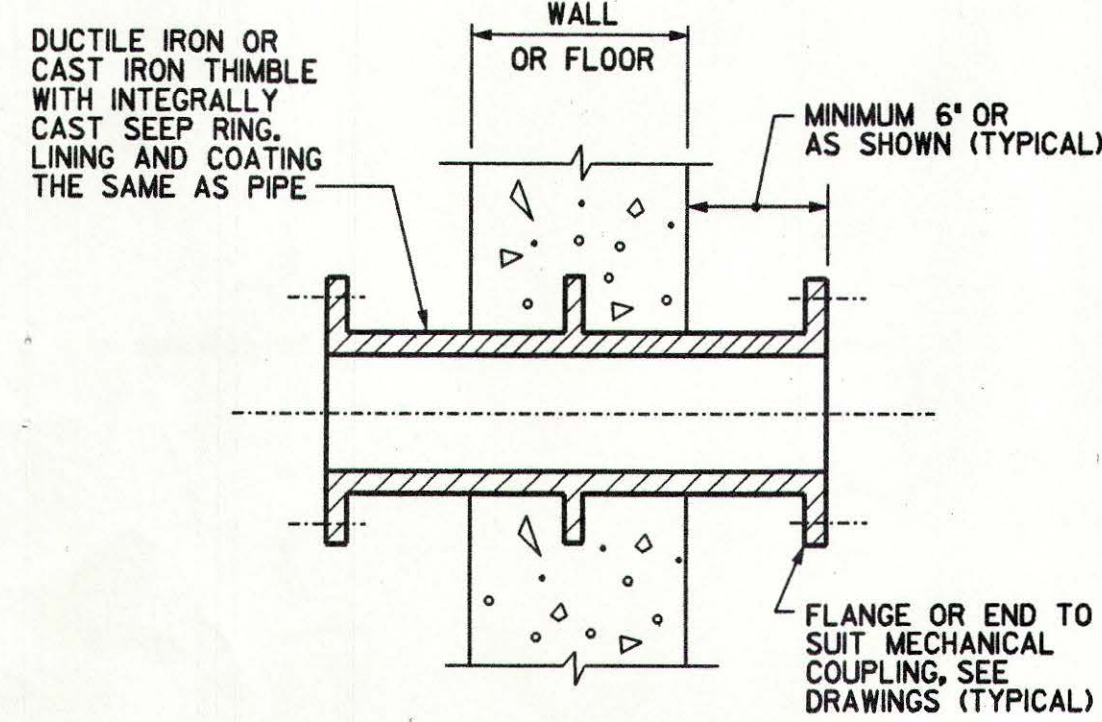

FLANGED OR GROOVED DUCTILE IRON OR CAST IRON PIPE THIMBLE

REV 010199


M-116

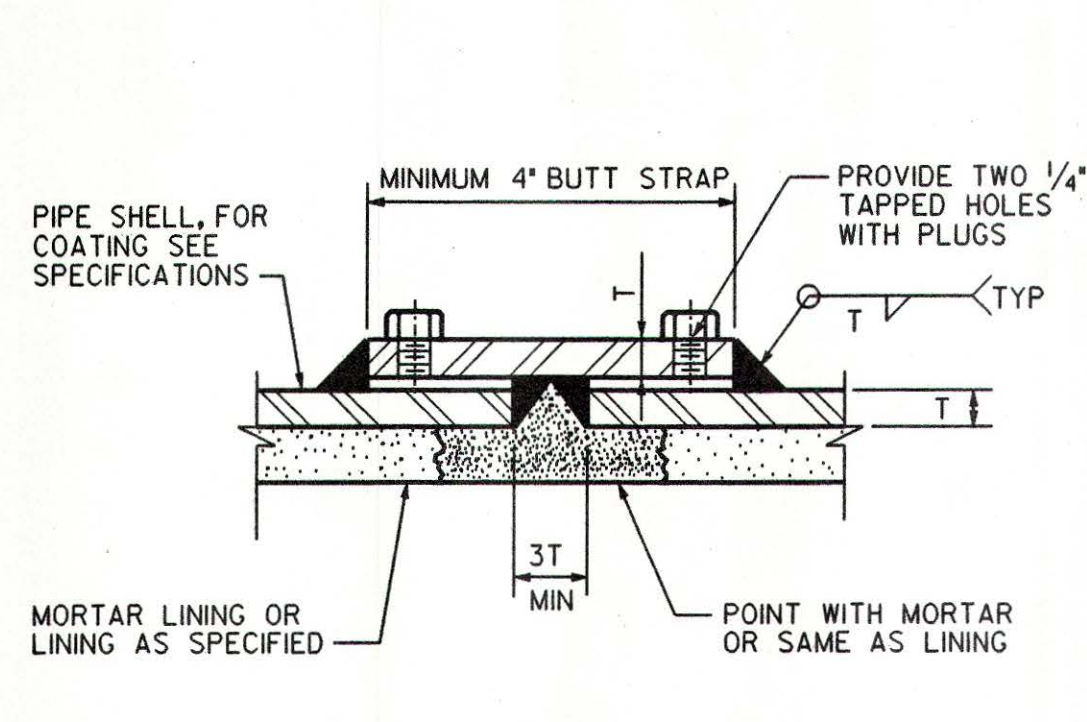

BUTT STRAP JOINT

REV 010199


M-118

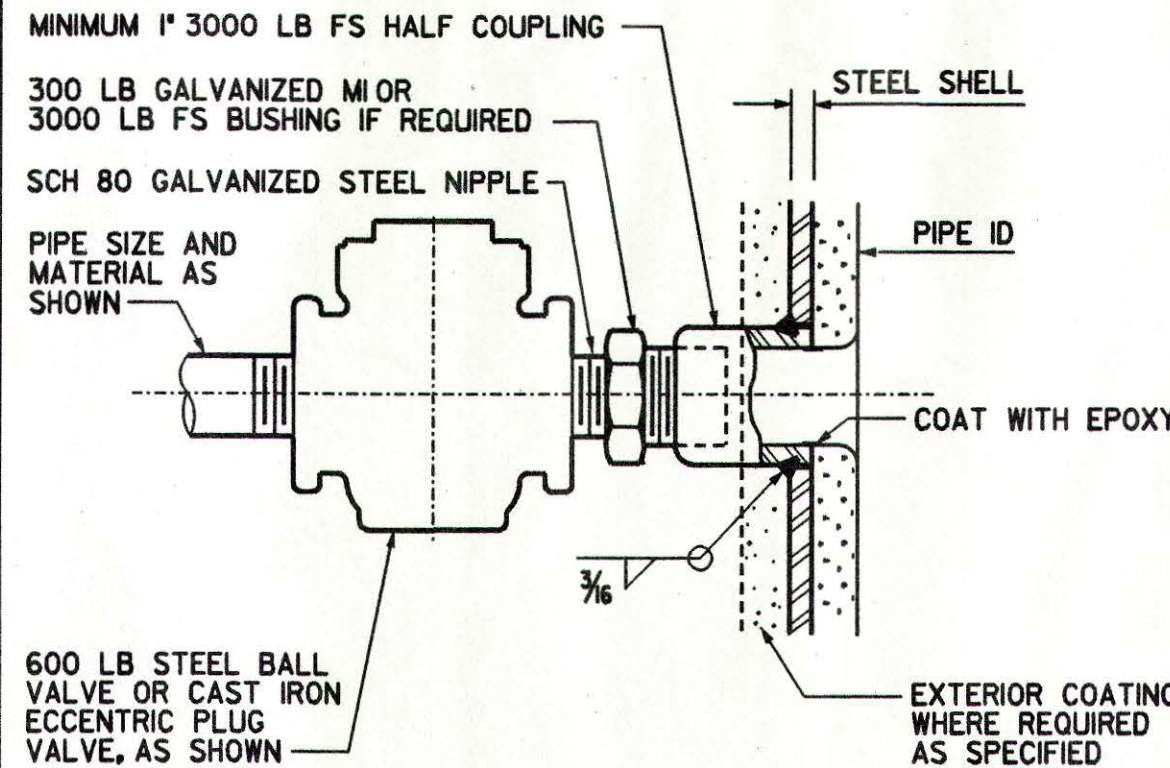

PIPE CONNECTION 2 1/2" AND SMALLER

REV 010199

M-120

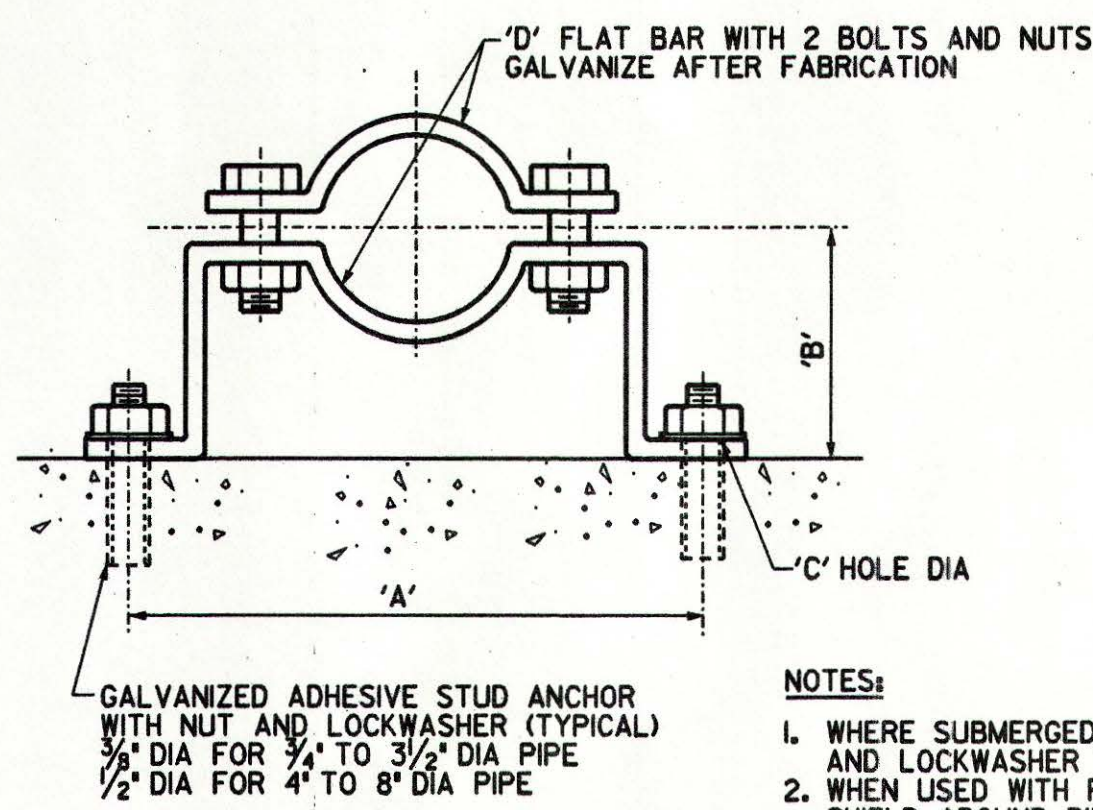


PIPE CLAMP FOR INDIVIDUAL PIPES

REV 010199

M-131

DIMENSIONS IN INCHES						LOAD RATING LBS*
PIPE DIA	'A'	'B' SEE NOTE 3 BELOW	'C' HOLE DIA	'D' FLAT BAR SIZE		
3/4	5-15/16	2-1/2	7/16	3/16 x 1-1/4		300
1	6-1/4	2-5/8	7/16	3/16 x 1-1/4		300
1-1/4	6-11/16	2-3/4	7/16	3/16 x 1-1/4		300
1-1/2	6-15/16	3	7/16	3/16 x 1-1/4		300
2	8-5/16	3-3/16	7/16	1/4 x 1-1/4		500
2-1/2	8-7/8	3-7/16	7/16	1/4 x 1-1/4		500
3	9-1/8	3-3/4	7/16	1/4 x 1-1/4		500
3-1/2	10-1/16	4	7/16	1/4 x 1-1/4		500
4	10-9/16	4-1/4	9/16	1/4 x 1-1/2		600
5	11-3/4	4-3/4	9/16	1/4 x 1-1/2		600
6	14-3/8	5-5/16	9/16	3/8 x 1-1/2		850
8	16-5/8	6-5/16	9/16	3/8 x 1-1/2		850


\*SAFETY FACTOR OF 5

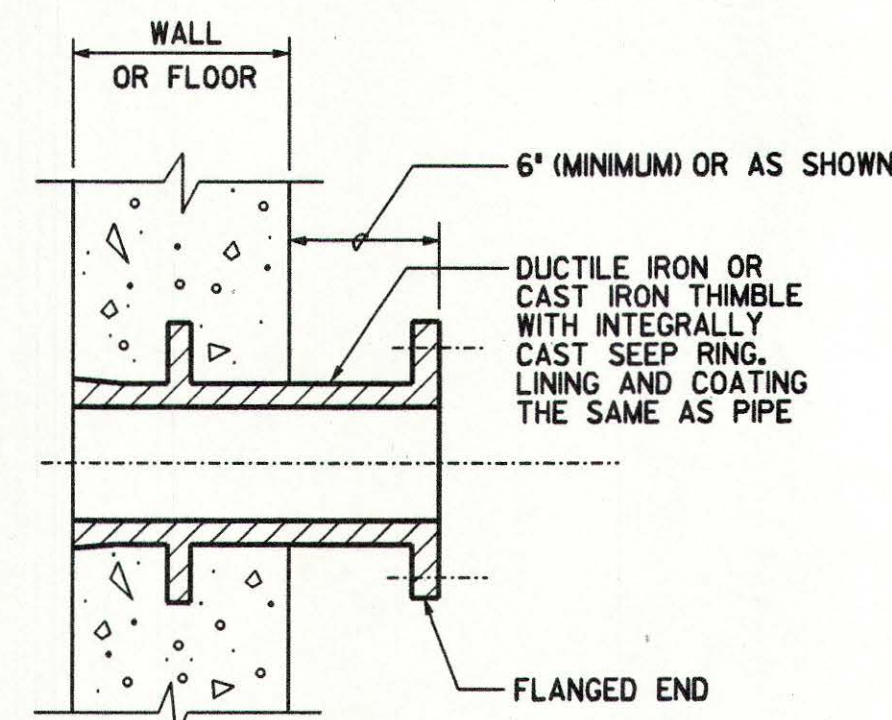

FLANGED AND SPIGOT DUCTILE IRON OR CAST IRON PIPE THIMBLE

REV 022299


M-122

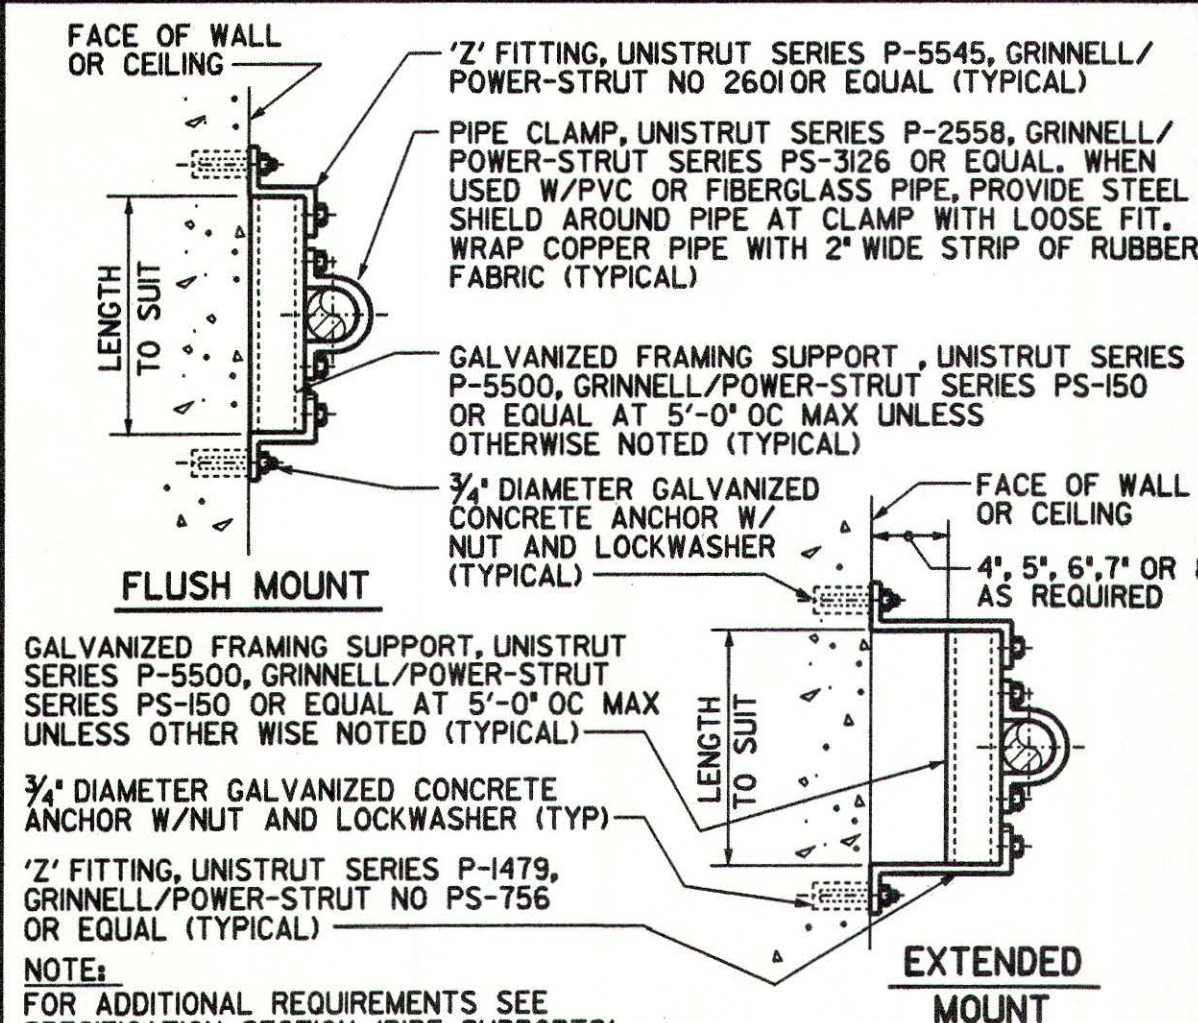

PIPE SUPPORT FOR INDIVIDUAL PIPES

REV 010199


M-139

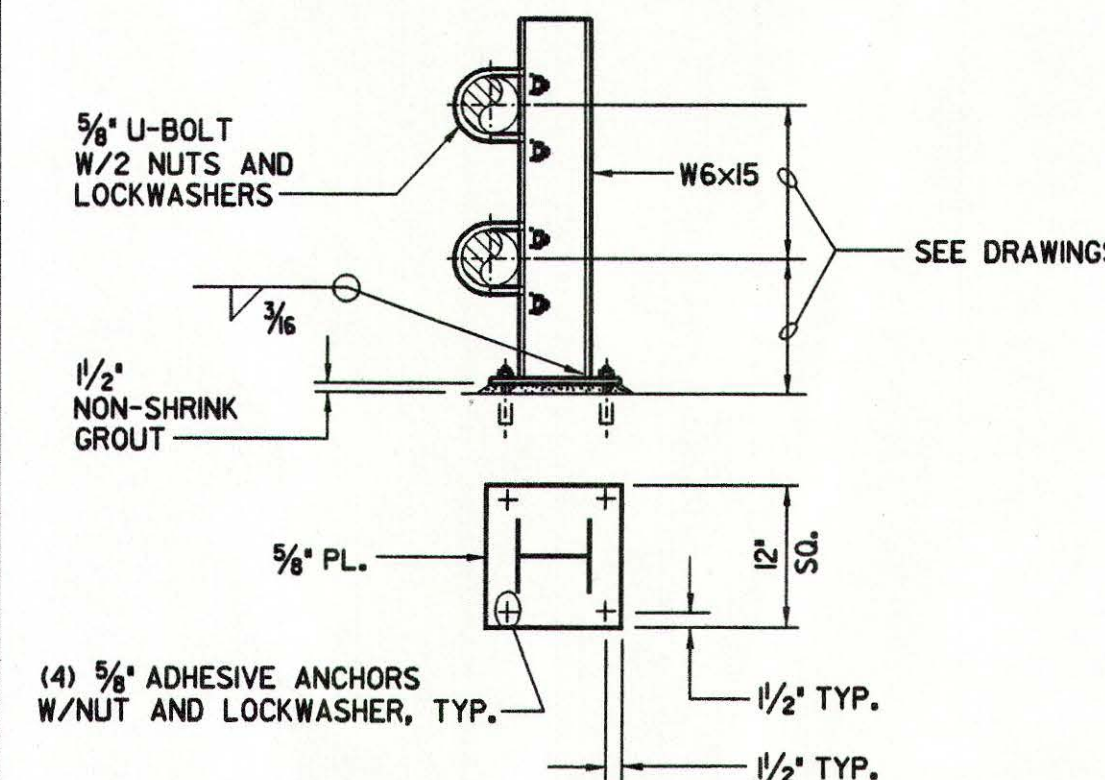

PIPE SUPPORT

REV. 062097

M-151

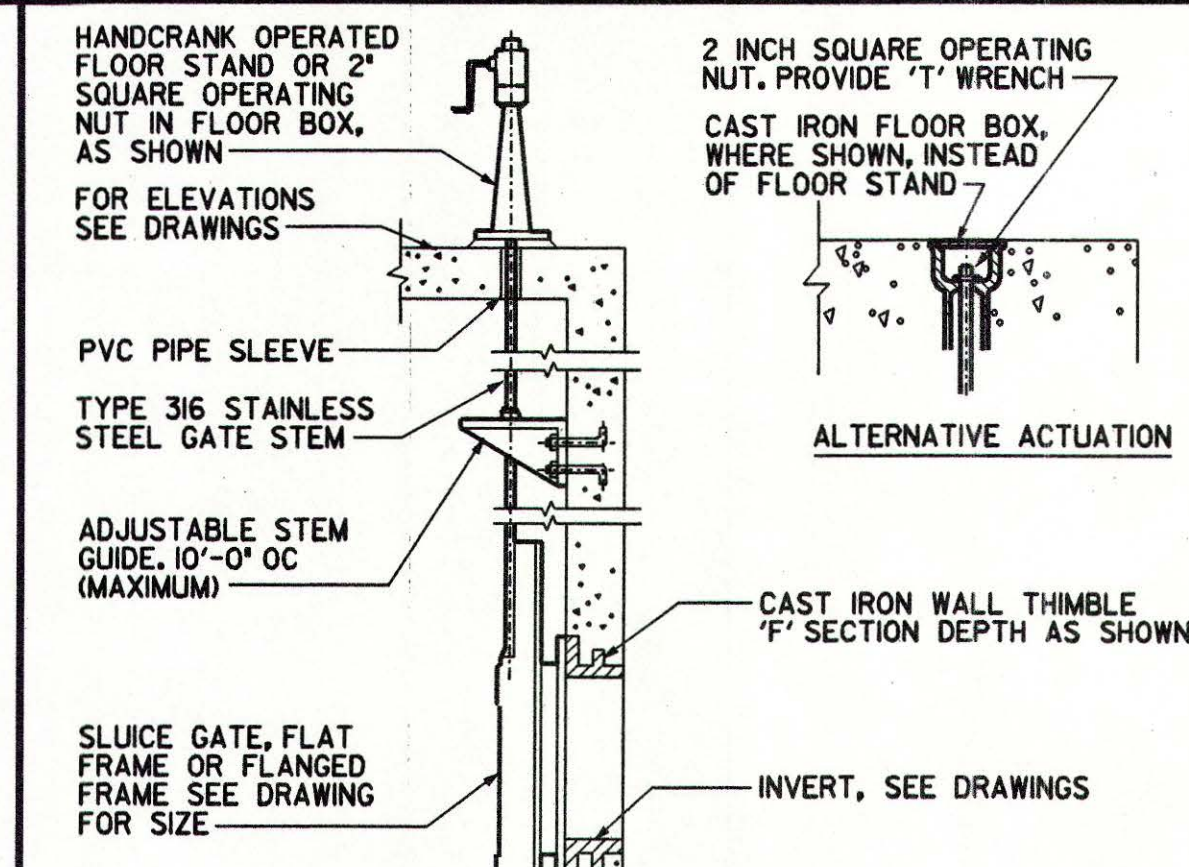

DESCRIPTION:

WALL MOUNTED FLAT FRAME OR FLANGED FRAME SLUICE GATE, WITH FLOOR STAND OR 2" SQUARE NUT IN FLOOR BOX, DOWNWARD CLOSING.

SLUICE GATE

REV 010199

M-210

The limited review of this document by PBS & J on behalf of the Olivenhain Municipal Water District, is intended as a limited review only for general conformance with: (1) This approved Design/Build documents, (2) Accepted standards of practice within the industry, and (3) The standards of the Olivenhain Municipal Water District. This limited review in no way is intended, nor shall it act to relieve the Design/Build Team of any professional liability to the responsibility to provide a complete and functional facility that is compliant with all applicable specifications, standards, codes, and regulations.

PBS & J  
Date: 8/29/01 By: J. S. J.



**MONTGOMERY WATSON**  
Pasadena, California

APPROVED  
George R. Bunt  
OLIVENHAIN MWD  
APPROVED  
FILANC CONSTRUCTION CO.  
DATE

8.29.01  
DATE


KELWOOD DEVELOPMENT COMPANY  
45 RANCH SANITATION DISTRICT  
WASTEWATER TREATMENT PLANT EXPANSION TO 2.0 MGD  
MECHANICAL STANDARD DETAILS - I

SHEET


GM-2

OF 5 SHEETS




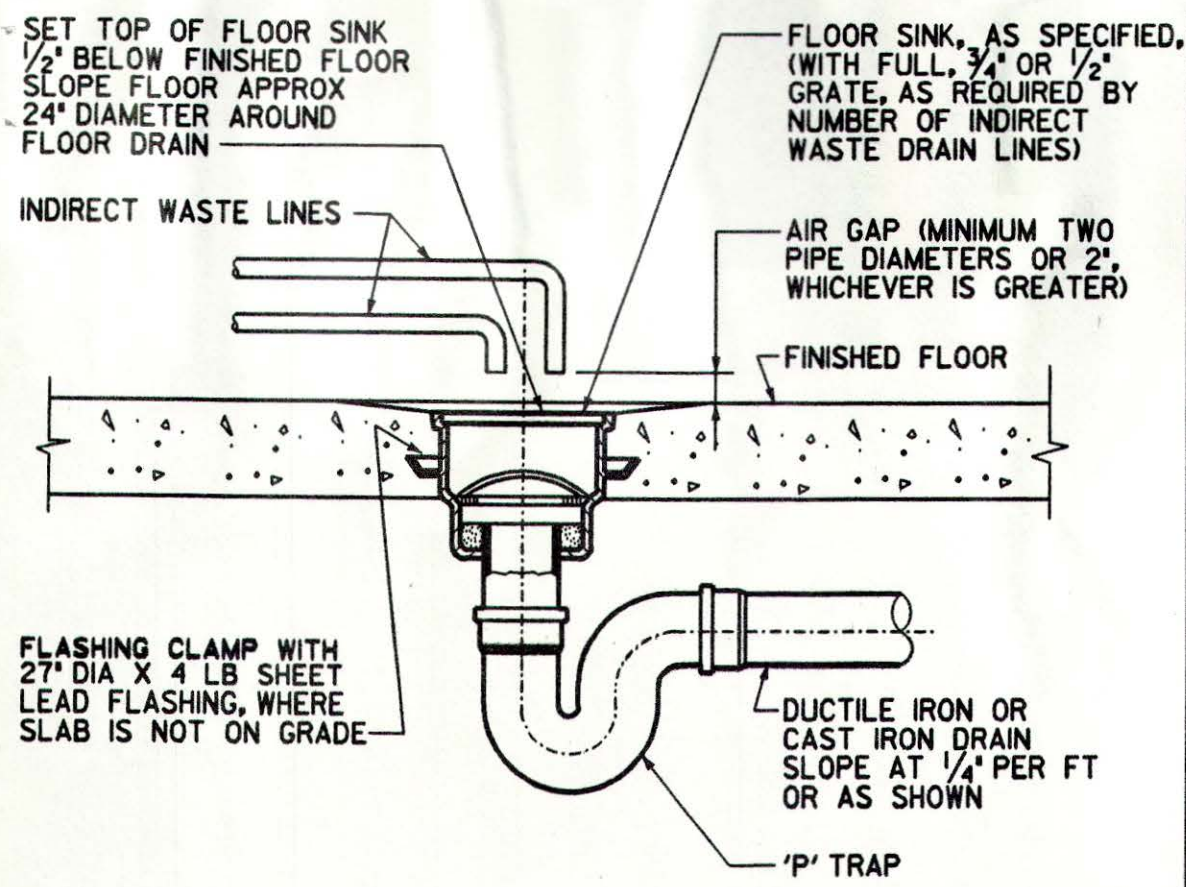

FLOOR SINK REV 010199 M-301

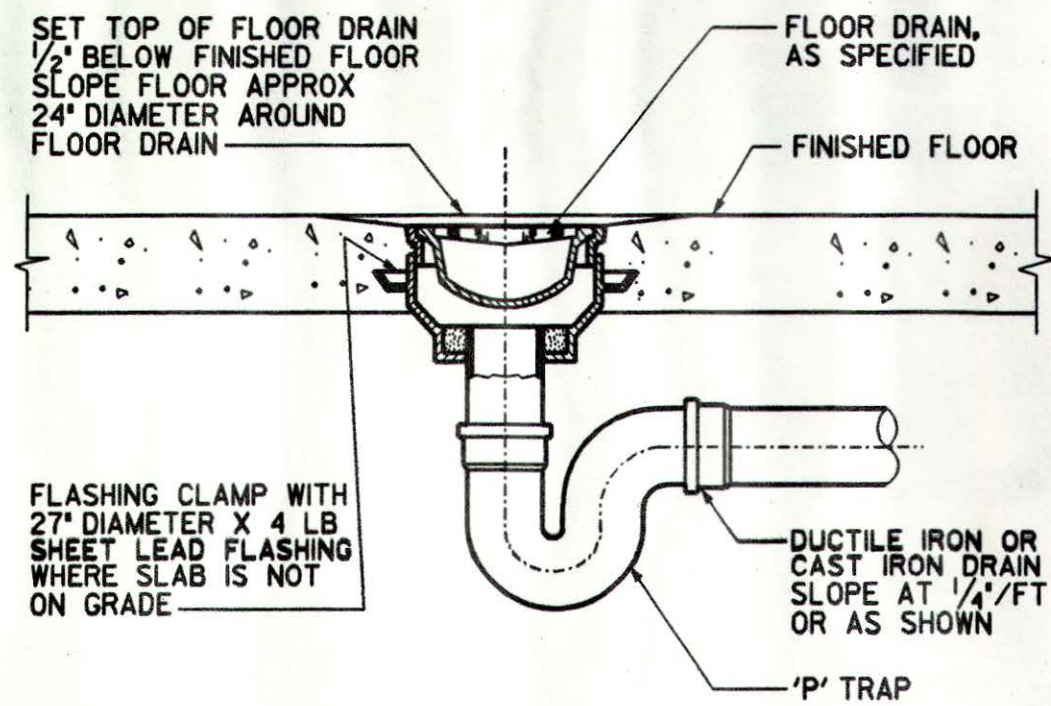


FLOOR DRAIN REV 010199 M-302

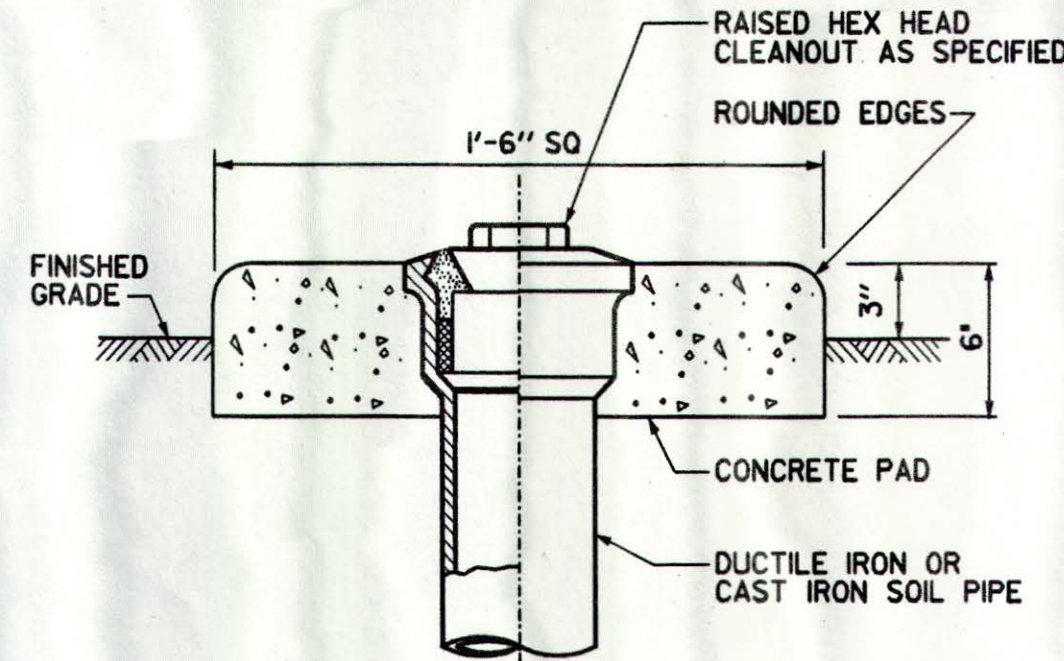


NOTE:  
IN TRAFFIC AREAS PROVIDE FLUSH FINISH WITH 10" ID CAST IRON COVER AND FRAME AS SPECIFIED.


CLEANOUT TO GRADE REV 010199 M-306

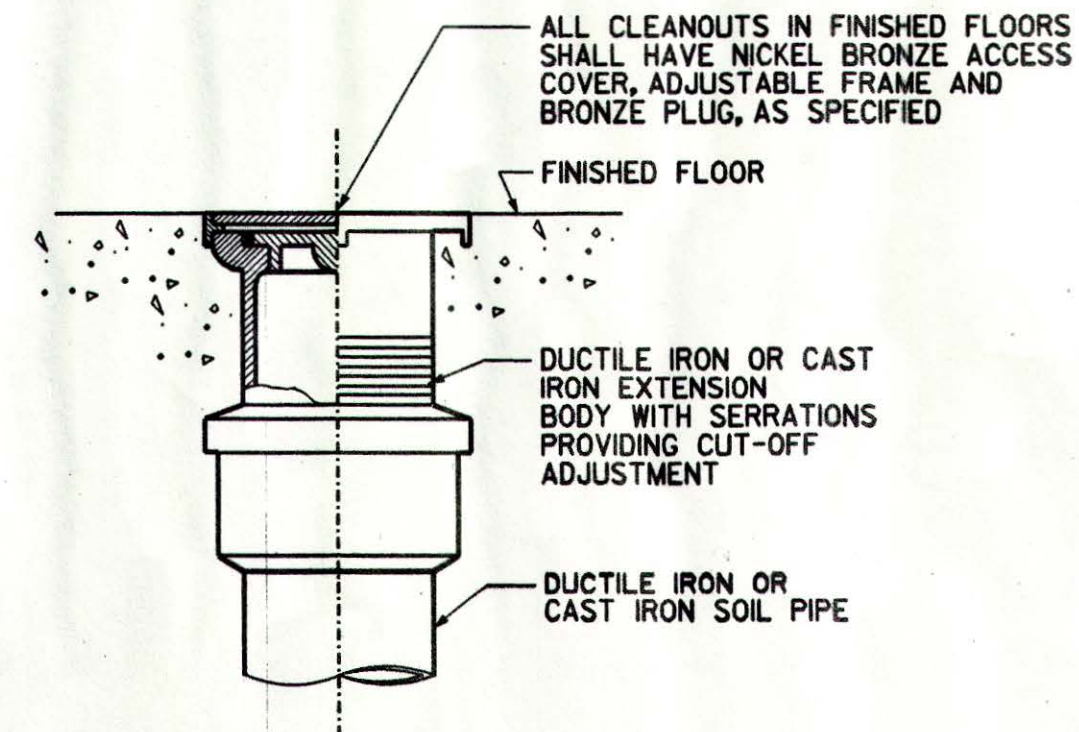

CLEANOUT IN FINISHED FLOOR REV 010199 M-307

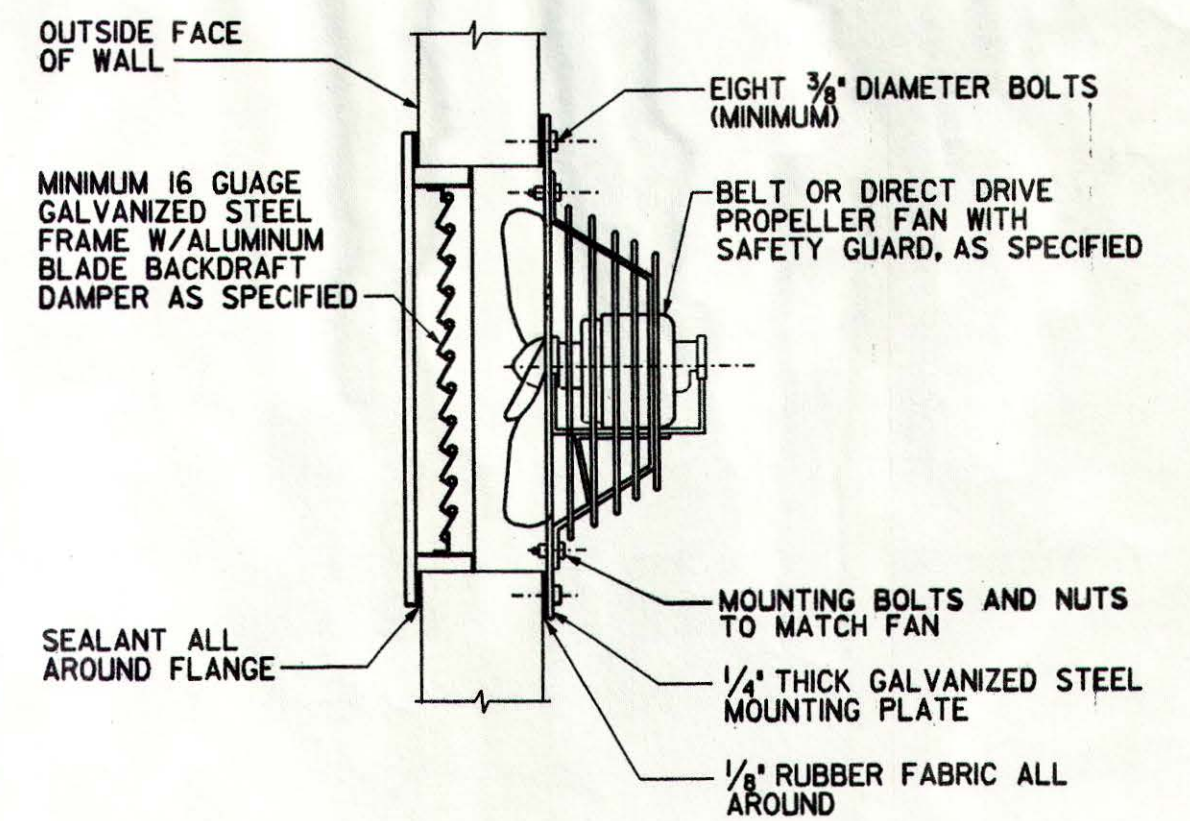


FAN WITH BACKDRAFT DAMPER REV 010199 M-506

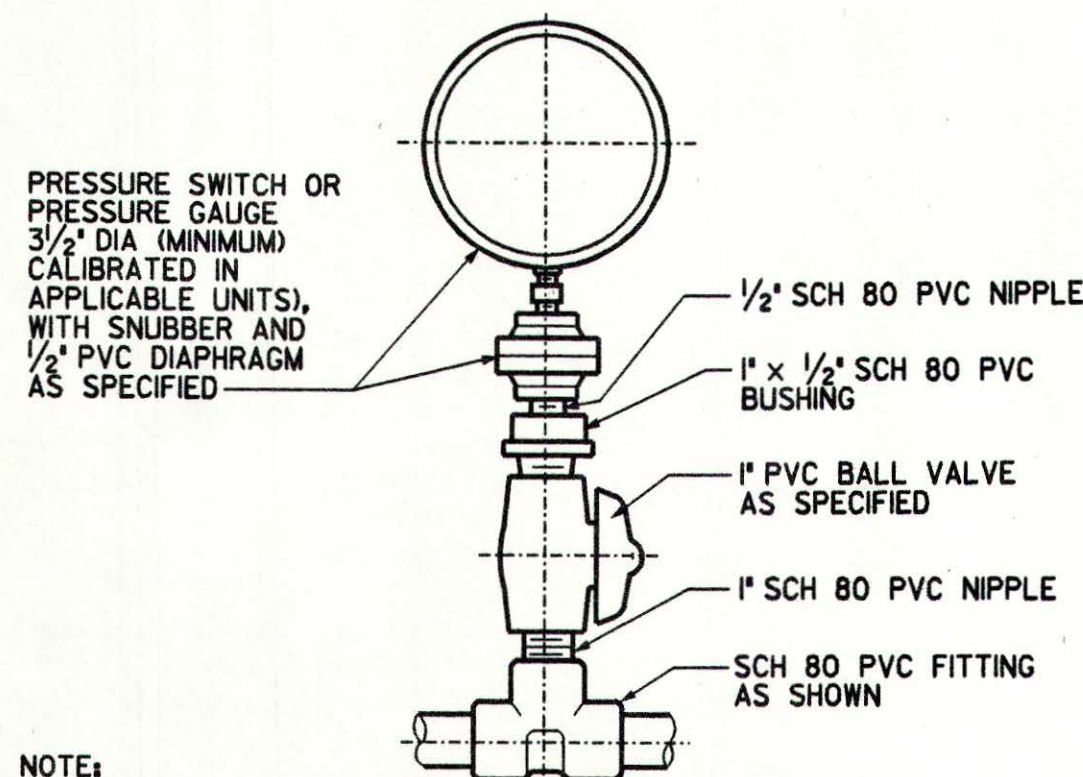


NOTE:  
DO NOT USE FOR CHLORINE OR SULFUR DIOXIDE LINES UNDER PRESSURE.


PRESSURE GAUGE OR PRESSURE SWITCH WITH PVC DIAPHRAGM SEAL REV 010199 M-612

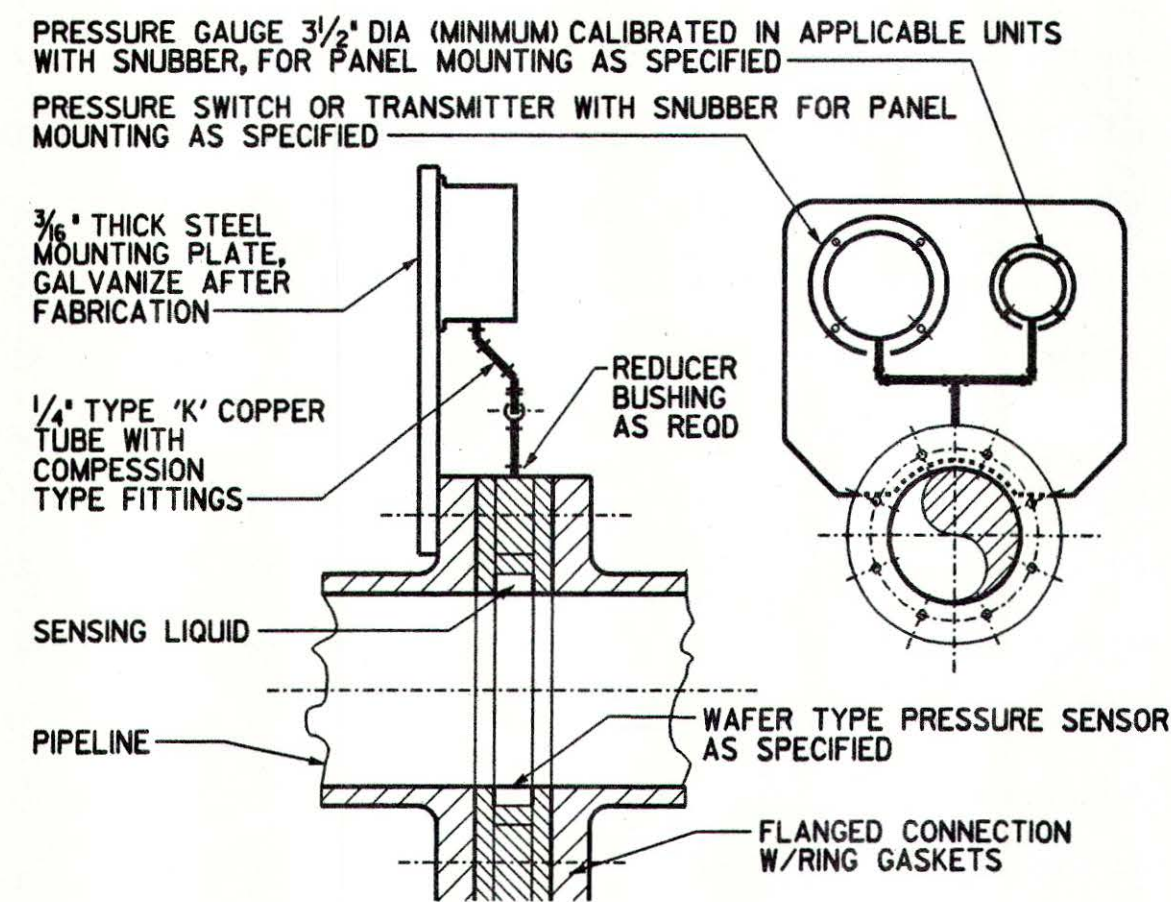

PRESSURE GAUGE, SWITCH OR TRANSMITTER WITH PRESSURE SENSOR REV 010199 M-613

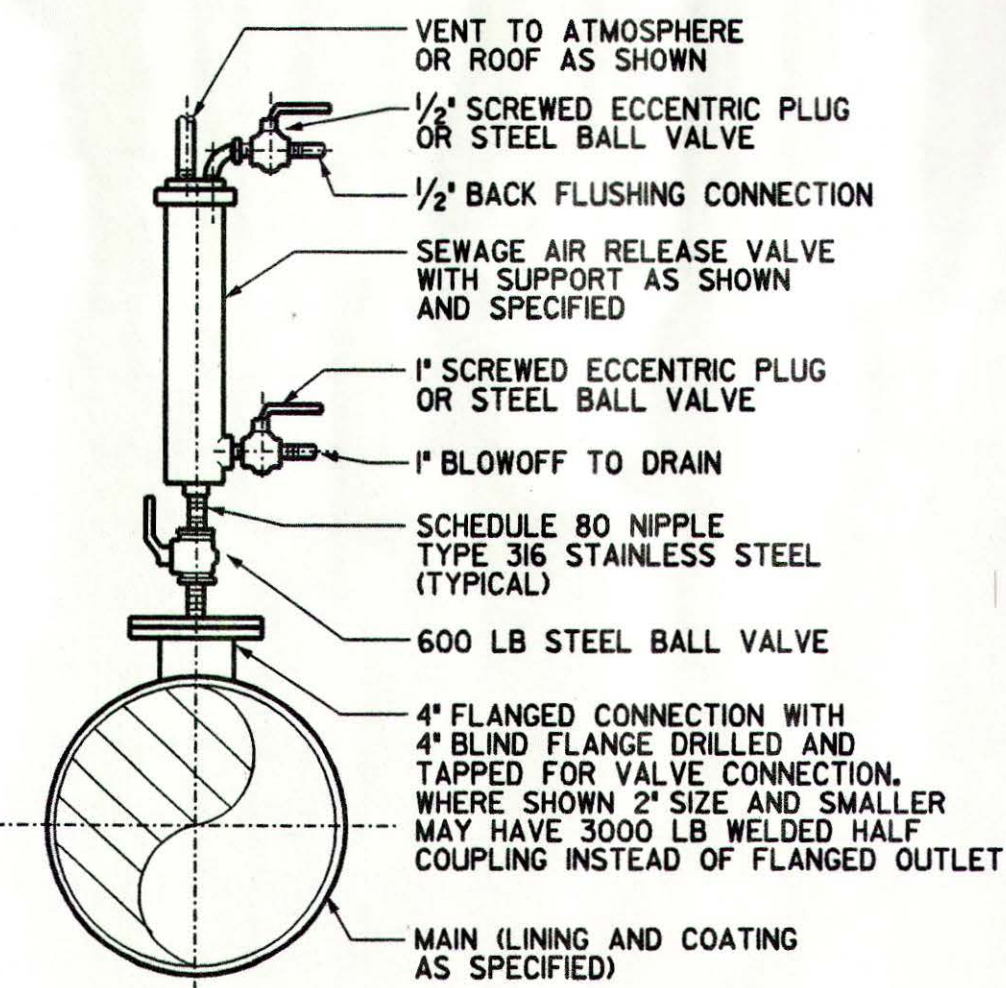


SEWAGE AIR RELEASE VALVE REV 010199 M-806

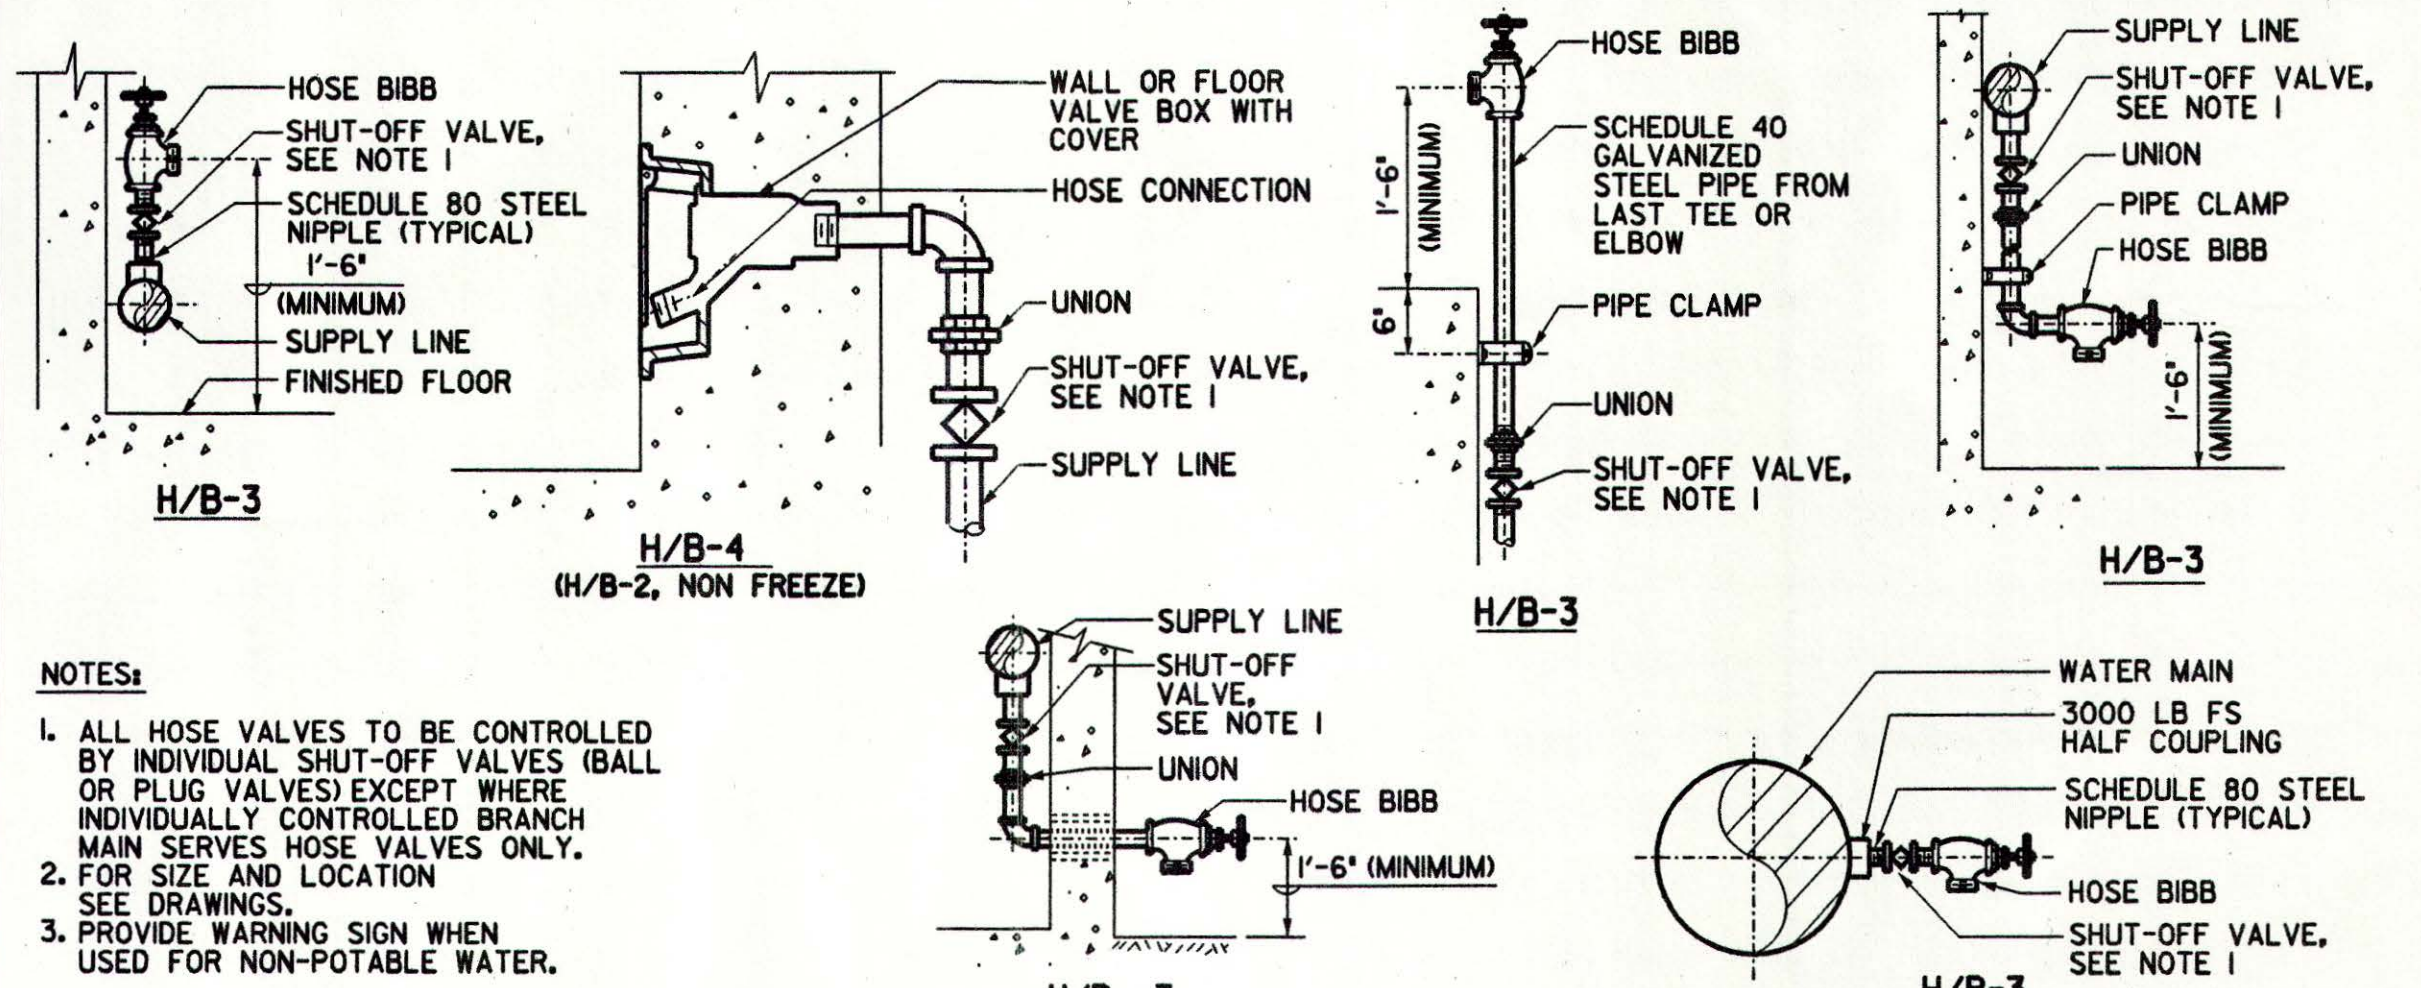


NOTES:  
1. ALL HOSE VALVES TO BE CONTROLLED BY INDIVIDUAL SHUT-OFF VALVES (BALL OR PLUG VALVES) EXCEPT WHERE INDIVIDUALLY CONTROLLED BRANCH MAIN SERVES HOSE VALVES ONLY.  
2. FOR SIZE AND LOCATION SEE DRAWINGS.  
3. PROVIDE WARNING SIGN WHEN USED FOR NON-POTABLE WATER.

HOSE BIBBS REV 010199 M-904

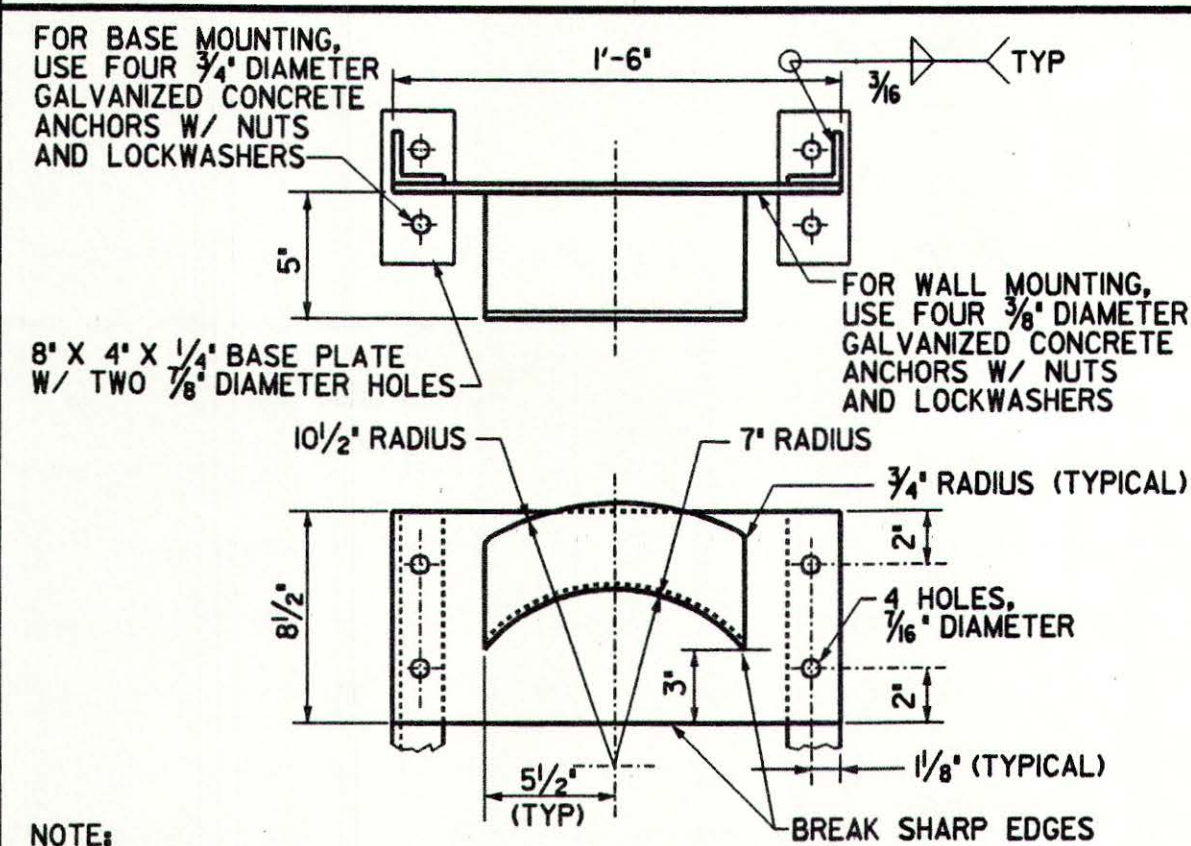


NOTE:  
1. WHERE HOSE RACK IS FREE-STANDING, PROVIDE TWO STEEL ANGLES 2 X 2 X 1/4" W/BASE PLATES (OMIT BASE PLATES WHERE ANGLES CAN BE SET IN CONCRETE).  
2. ALL WELDED CONSTRUCTION, 8 GAUGE STEEL SHEET GALVANIZED AFTER FABRICATION.

HOSE RACK REV 010199 M-905

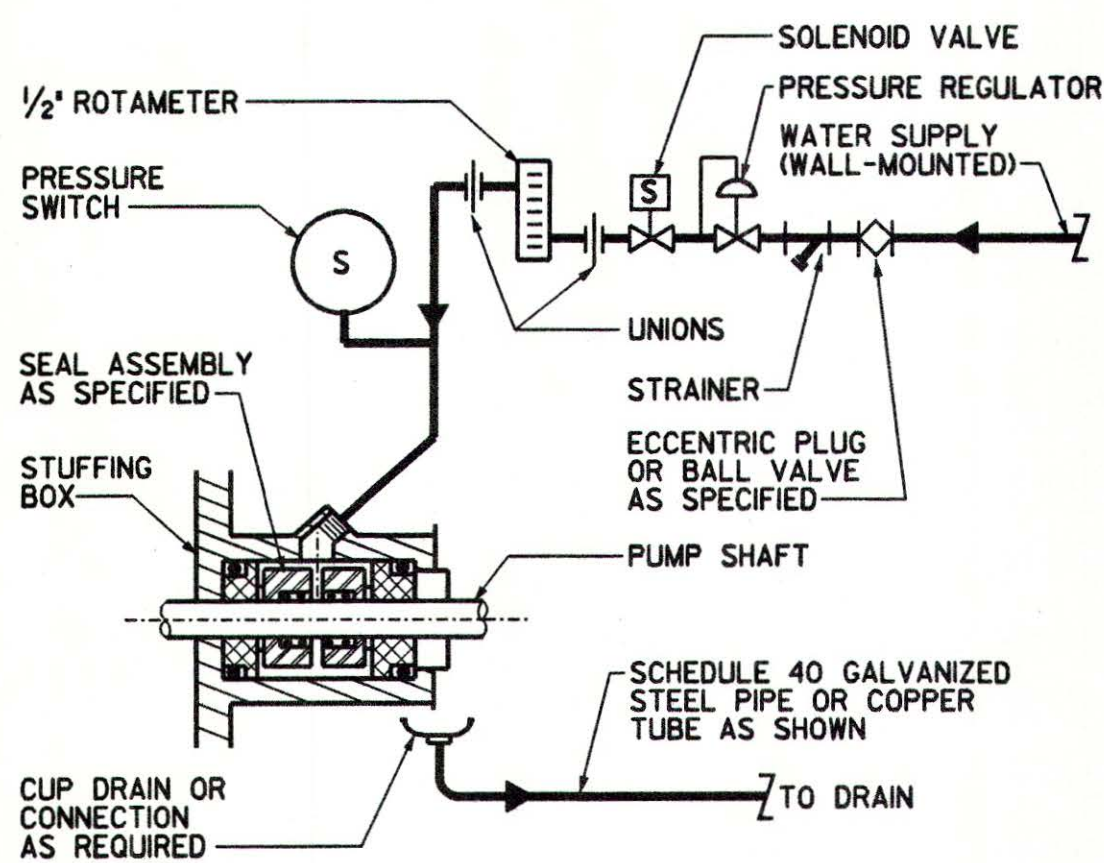


WATER FLUSHED PUMP SEAL REV 010199 M-906

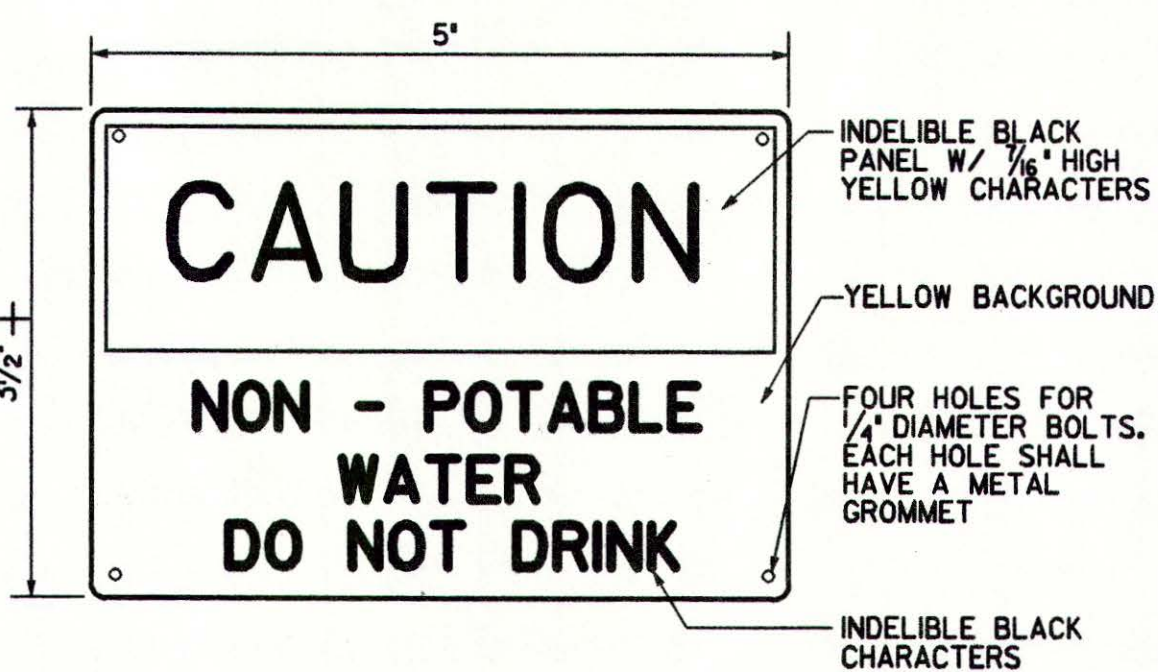

NOTES:  
1. MATERIAL TO BE SEMI-RIGID BUTYRATE OR EQUAL.  
2. COLORS AND LETTER SIZE TO BE PER OSHA STANDARDS FOR CAUTION SIGNS.  
3. PROVIDE THIS SIGN AT ALL HOSE BIBB LOCATIONS WHERE WATER IS NON-POTABLE.

WARNING SIGN FOR NON-POTABLE WATER REV 010199 M-912

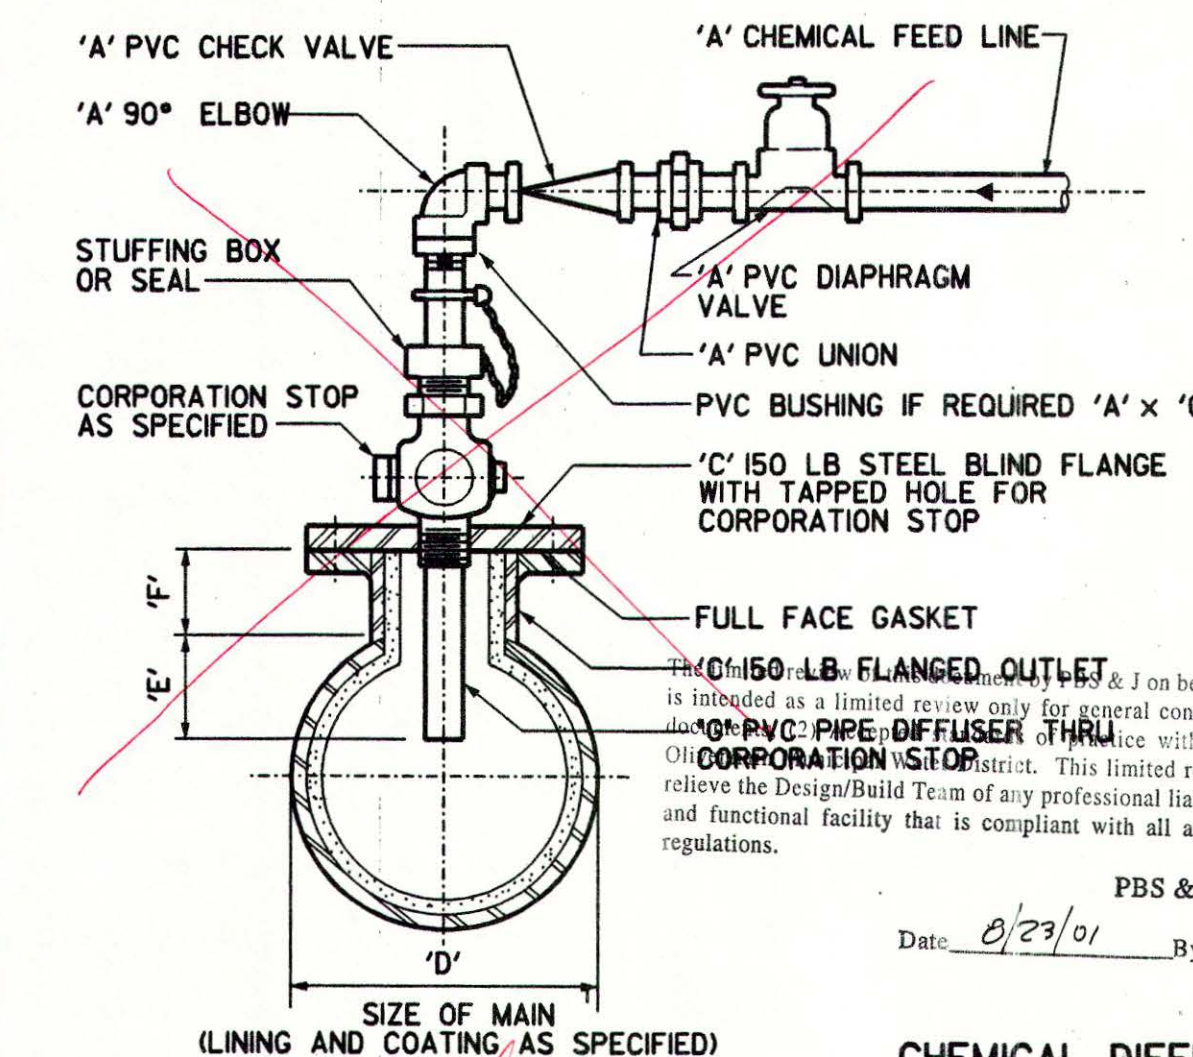

IDENTIFICATION MARK	CHEMICAL	GPM	DIMENSIONS IN INCHES						
			'A'	'B'	'C'	'D'	'E'	'F'	'G'
MK 1	FC	--	1	--	4	10	2.5	6	1

PBS & J  
Date: 8/23/01 By: J. J. J.

CHEMICAL DIFFUSER REV 010199 M-707




MONTGOMERY WATSON  
Pasadena, California

APPROVED  
George R. Bunt  
OLIVENHAIN MWD  
APPROVED  
FILANC CONSTRUCTION CO.  
DATE: 8.29.01

KELWOOD DEVELOPMENT COMPANY  
45 RANCH SANITATION DISTRICT  
WASTEWATER TREATMENT PLANT EXPANSION TO 2.0 MGD  
MECHANICAL STANDARD DETAILS - 2

SHEET  
GM-3  
OF 5 SHEETS



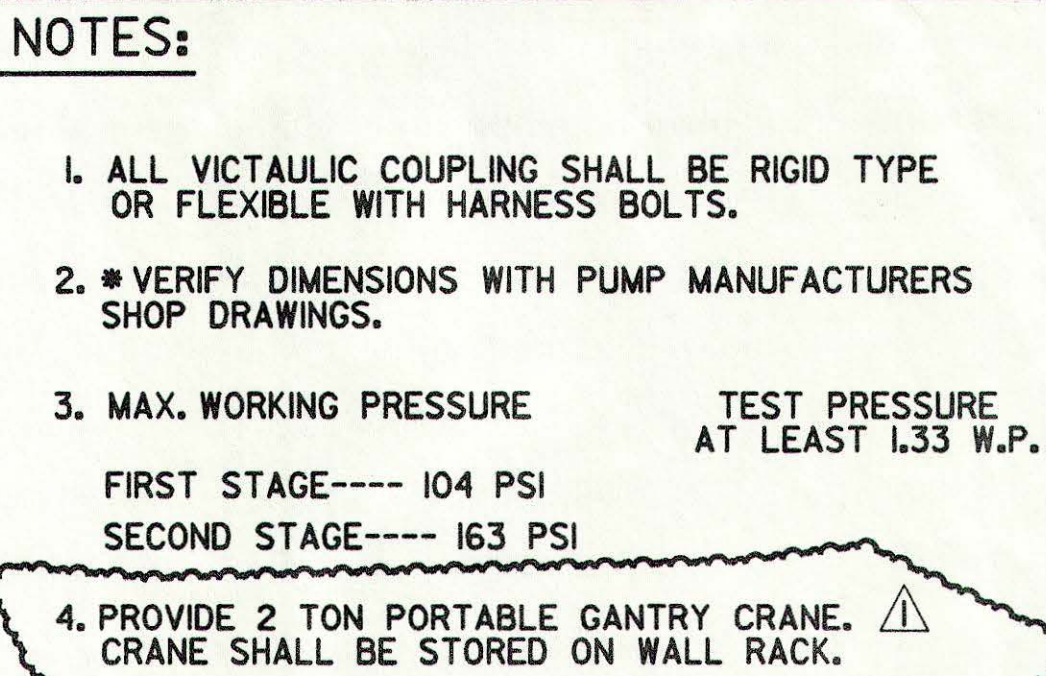


SHEET  
12M-1  
OF • SHEETS



Plot Date: 05-NOV-2001 15:05

File: d:\Projects\45R\12\mec\4sr\2m02.dwg

Job No: MW Job #

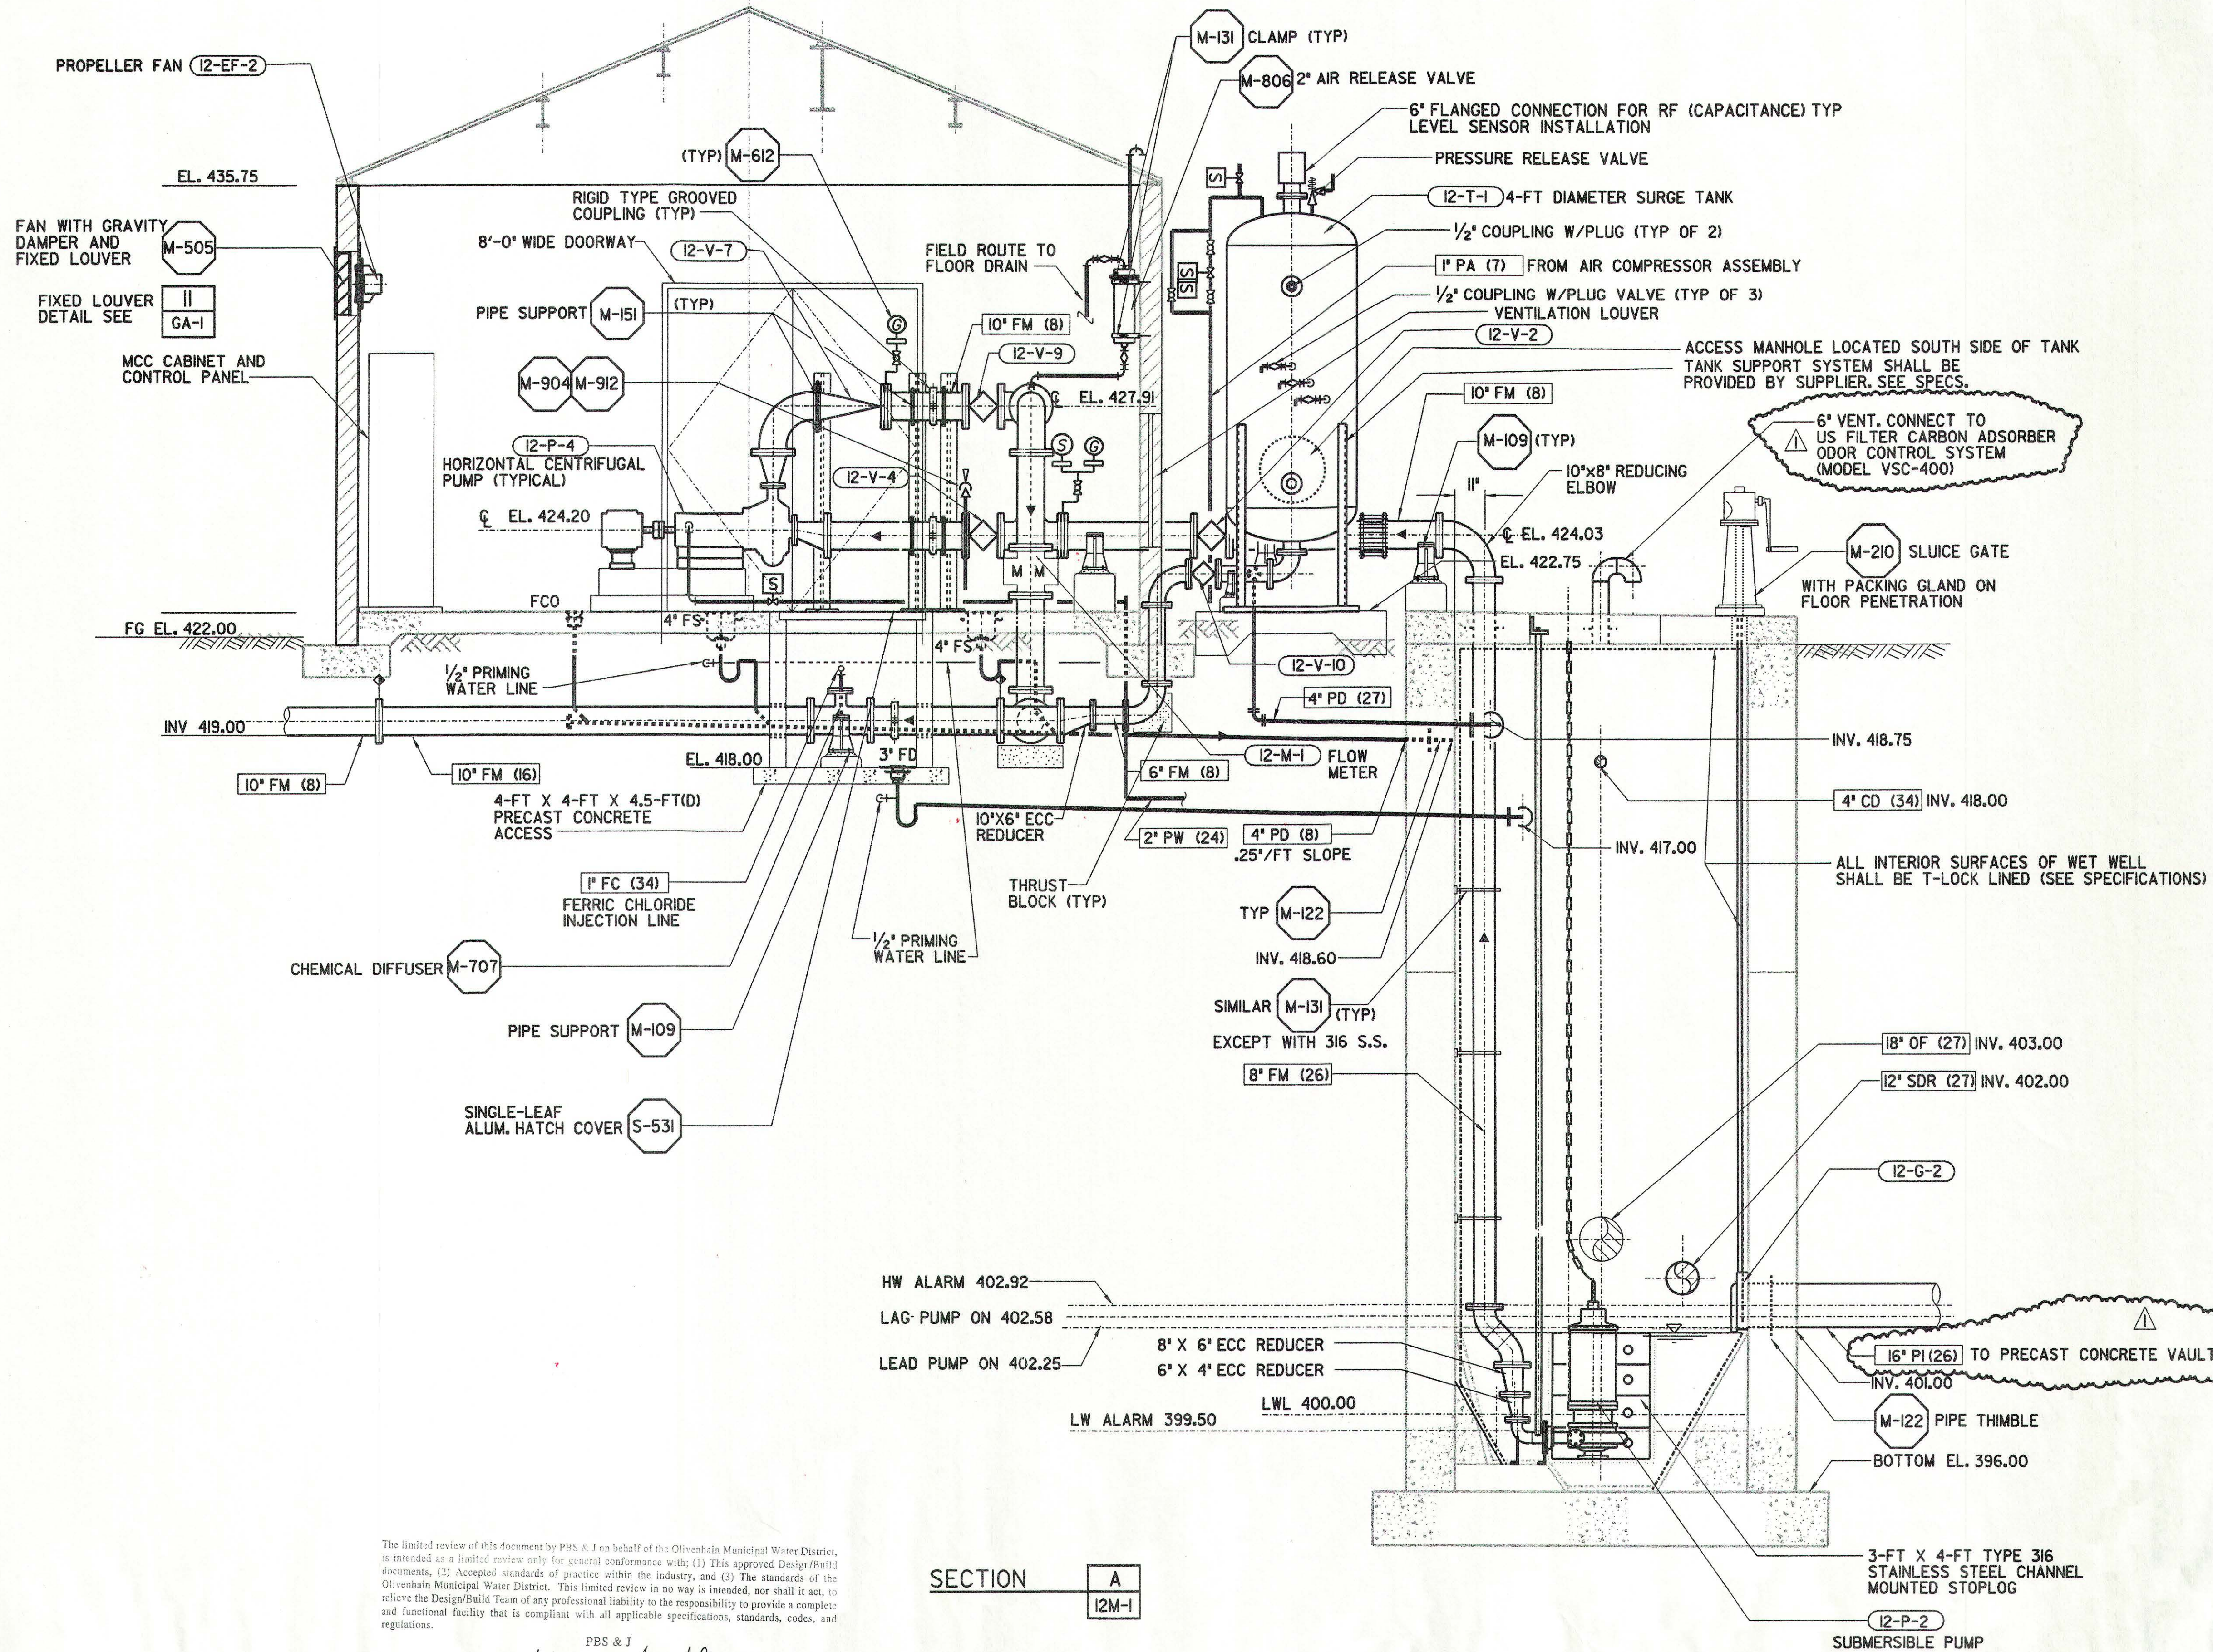

The limited review of this document by PBS & J on behalf of the Olivenhain Municipal Water District, is intended as a limited review only for general conformance with: (1) This approved Design/Build documents, (2) Accepted standards of practice within the industry, and (3) The standards of the Olivenhain Municipal Water District. This limited review in no way is intended, nor shall it act, to relieve the Design/Build Team of any professional liability to the responsibility to provide a complete and functional facility that is compliant with all applicable specifications, standards, codes, and regulations.

PBS & J  
Date: 12/12/01 By: [Signature]

SECTION A  
12M-1

REV	DATE	BY	OMWD	DESCRIPTION
1	11/5/01	PFW		REVISION OF PIPE TYPE

SCALE	WARNING
3/8" = 1'-0"	IF THIS BAR DOES NOT MEASURE 1" THEN DRAWING IS NOT TO SCALE

DESIGNED	S.P.H.
DRAWN	T.S.L.
CHECKED	P.F.W.

SUBMITTED BY	PROJECT MANAGER	43137	11/5/01
DATE	LICENSE NO.	33699	11/5/01
DATE	LICENSE NO.		



MONTGOMERY WATSON  
Pasadena, California


APPROVED	11/2/02
DATE	
APPROVED	
DATE	

KELWOOD DEVELOPMENT COMPANY	4S RANCH SANITATION DISTRICT
WASTEWATER TREATMENT PLANT EXPANSION TO 2.0 MGD	NEIGHBORHOOD NO. 1 PUMP STATION SECTION


SHEET  
12M-2  
OF 4 SHEETS





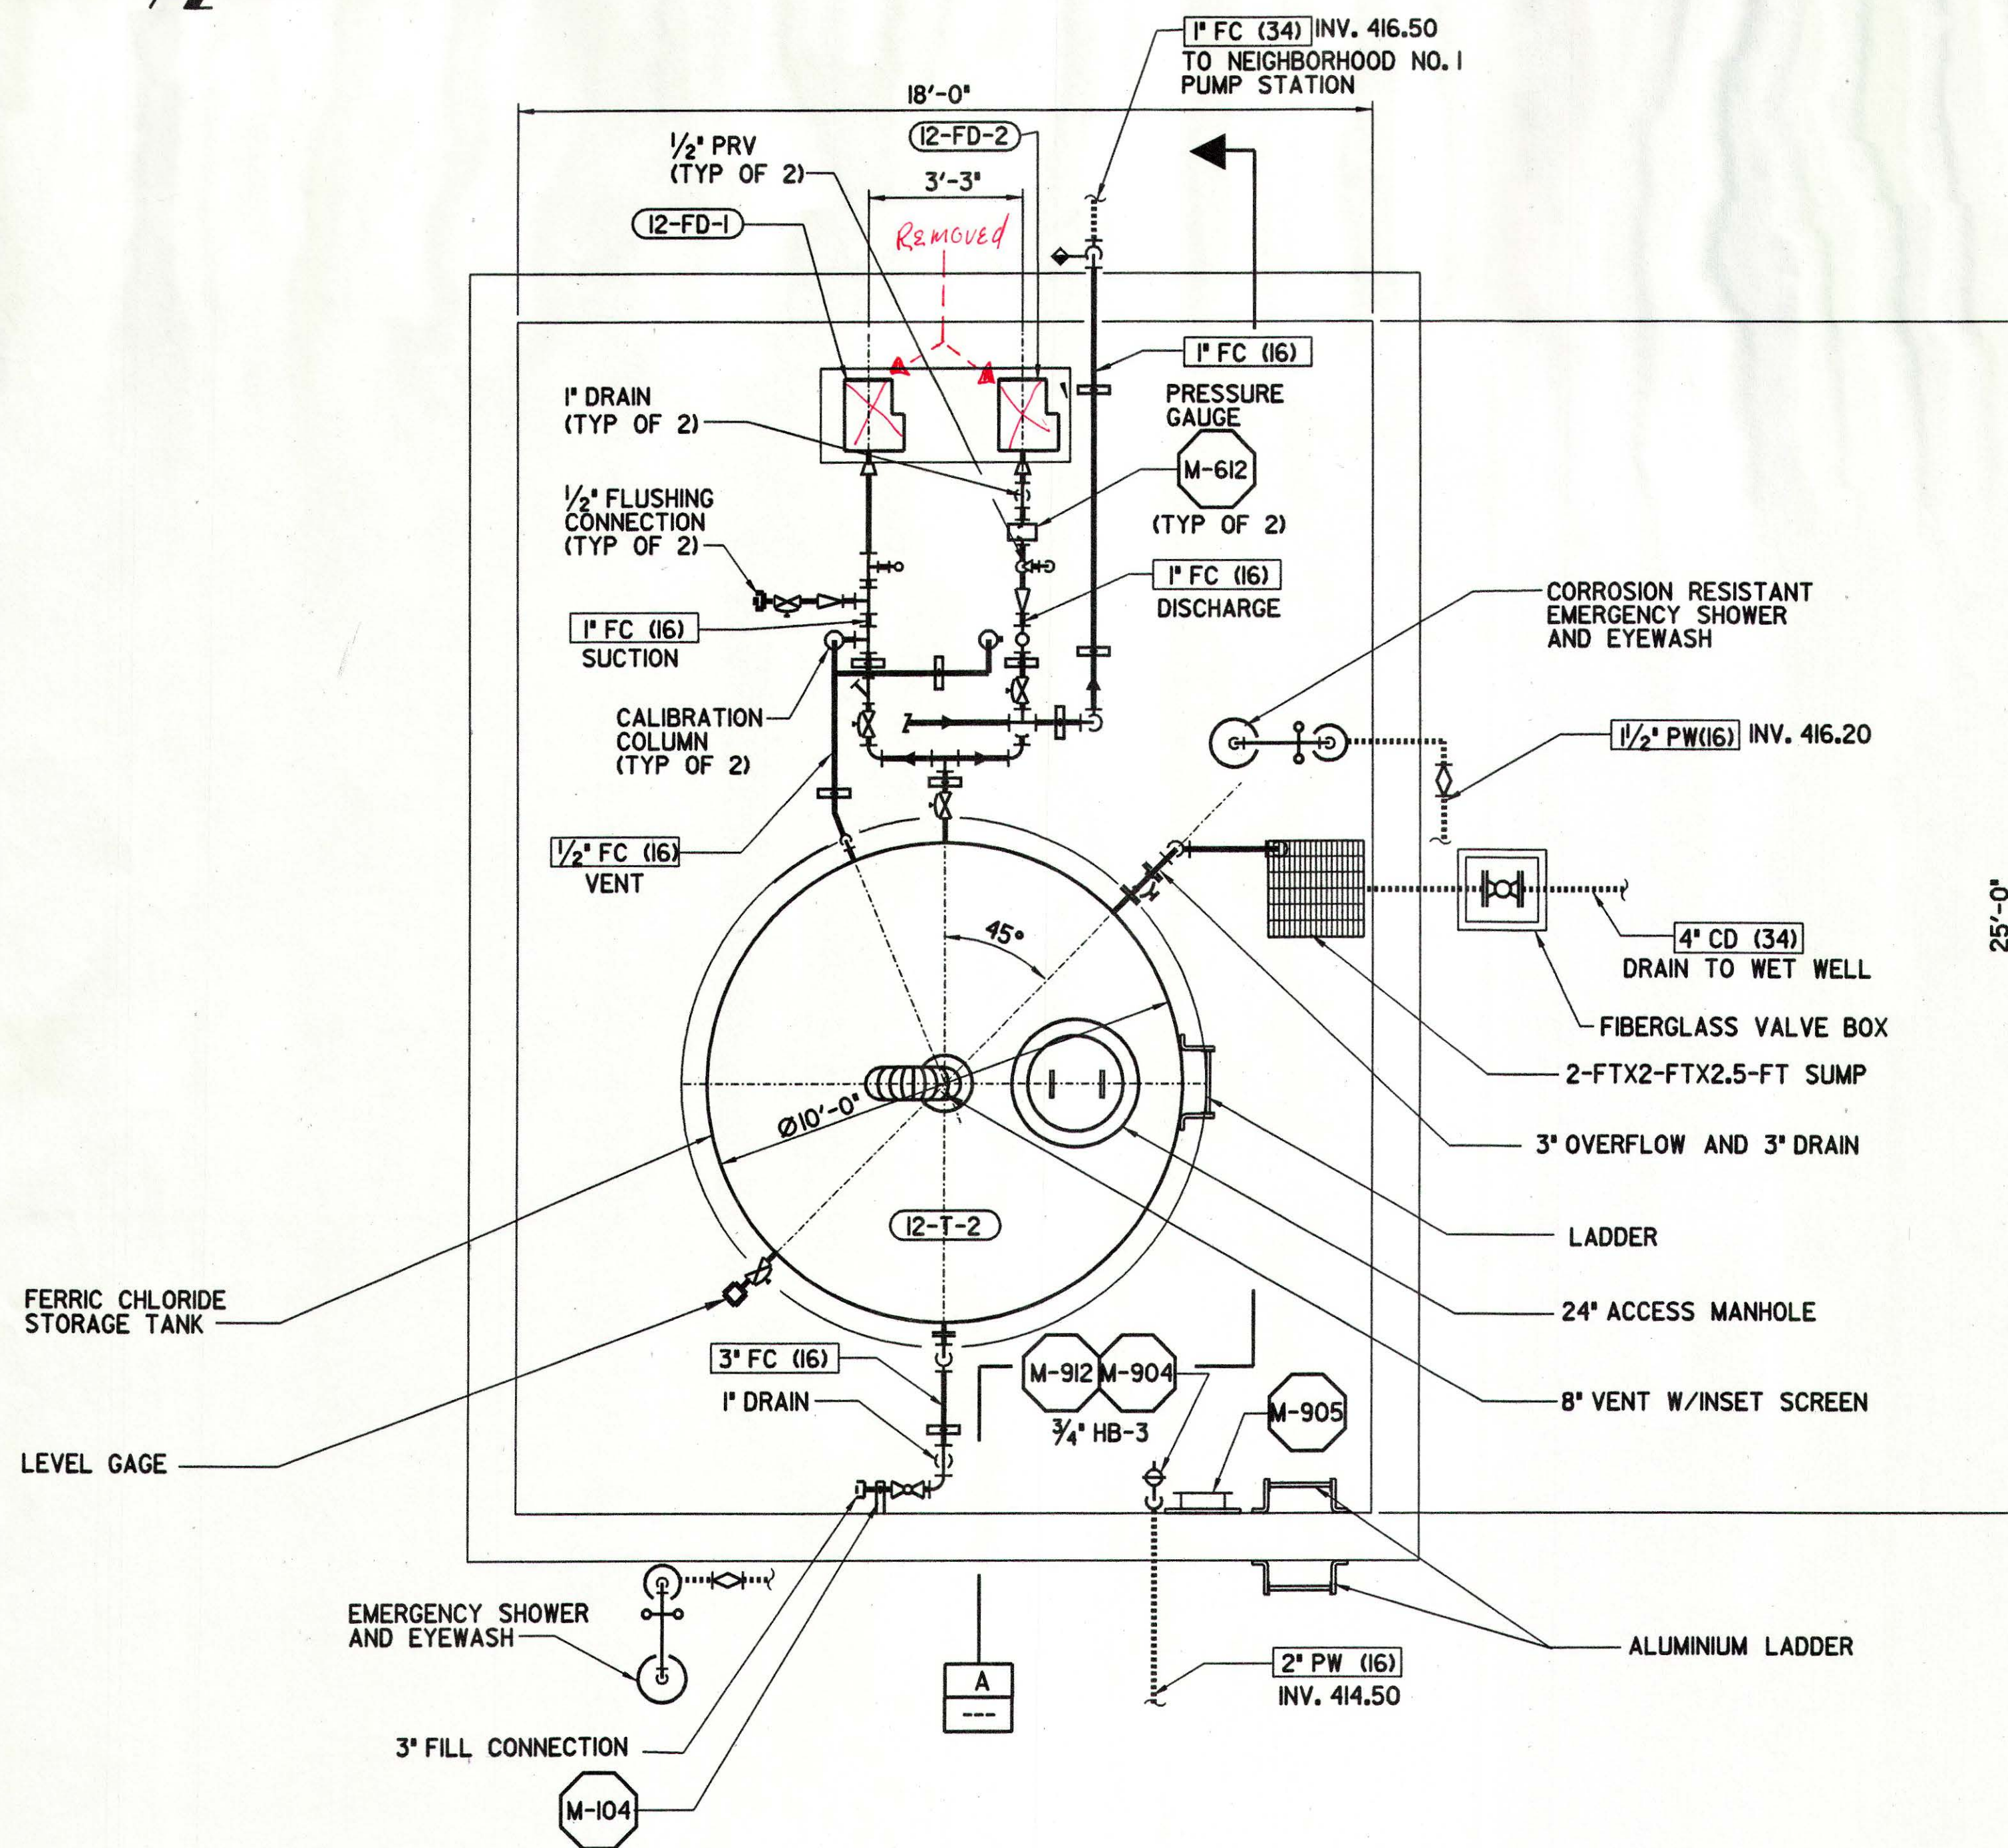

FERRIC CHLORIDE FEED AND STORAGE FACILITY  
PLAN

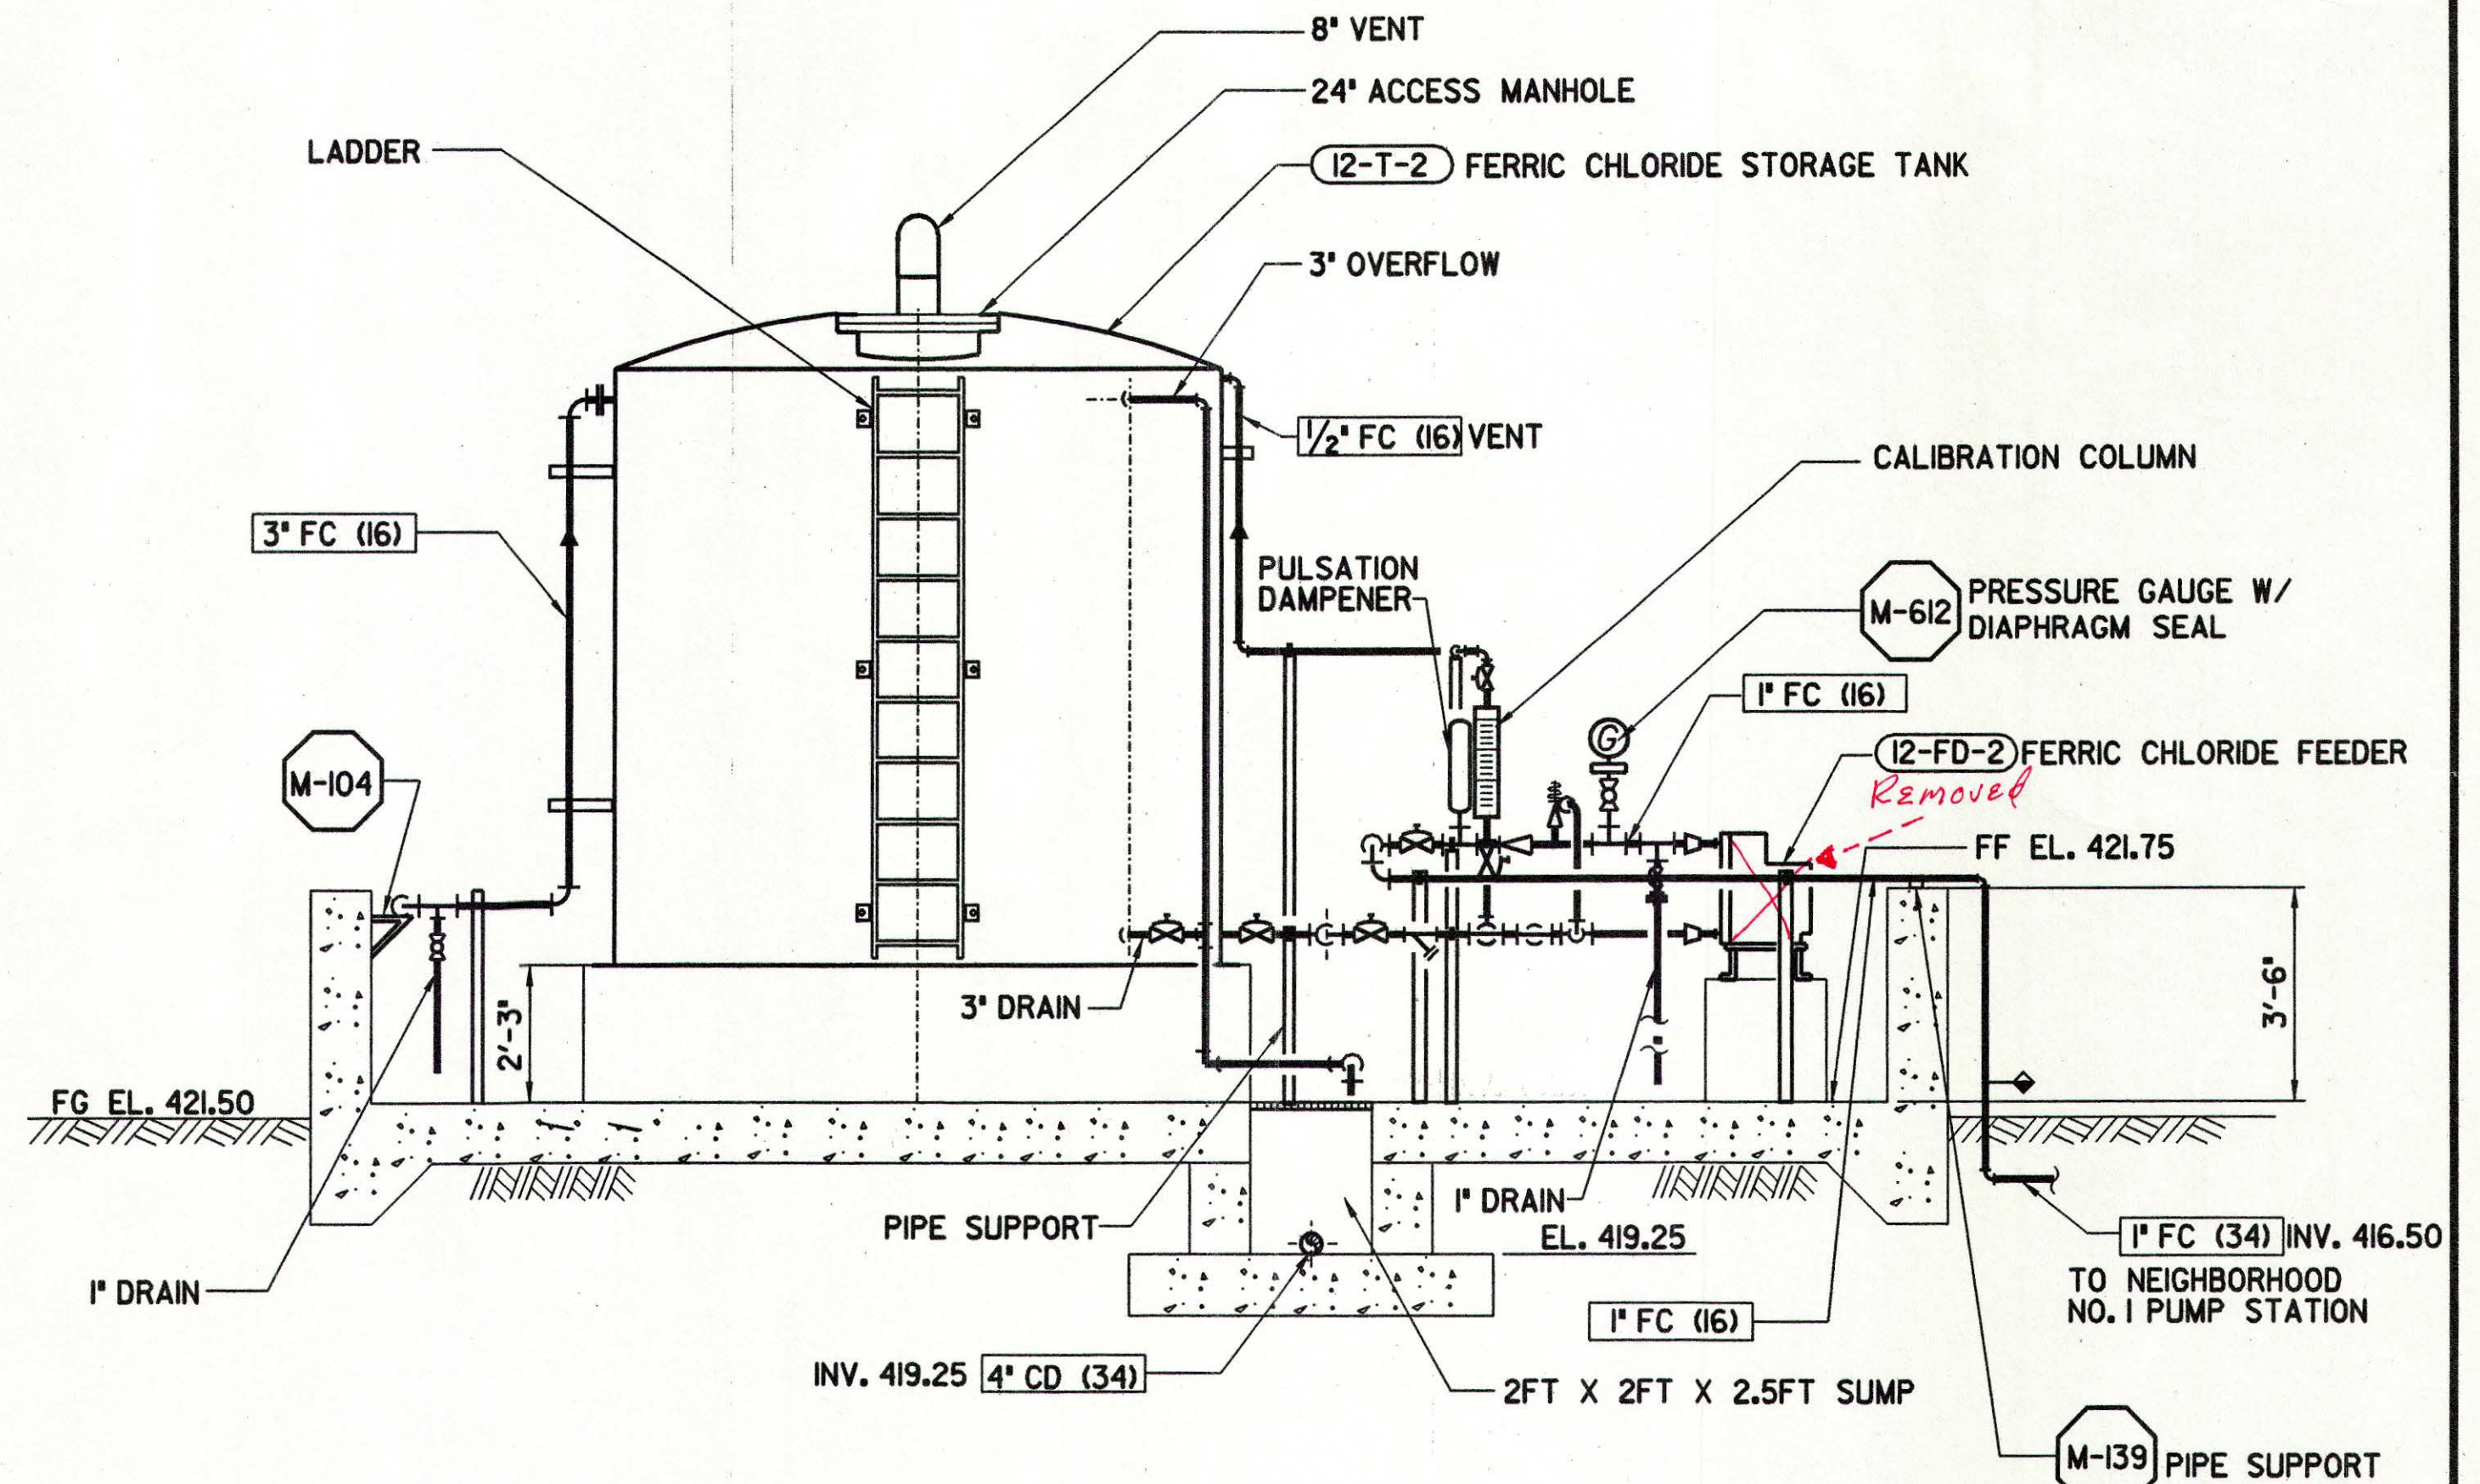


SECTION

A

The limited review of this document by PBS & J on behalf of the Olivenhain Municipal Water District, is intended as a limited review only for general conformance with: (1) This approved Design/Build documents, (2) Accepted standards of practice within the industry, and (3) The standards of the Olivenhain Municipal Water District. This limited review is in no way intended, nor shall it act, to relieve the Design/Build Team of any professional liability to the responsibility to provide a complete and functional facility that is compliant with all applicable specifications, standards, codes, and regulations.

PBS & J  
Date: 8/23/01 By: [Signature]

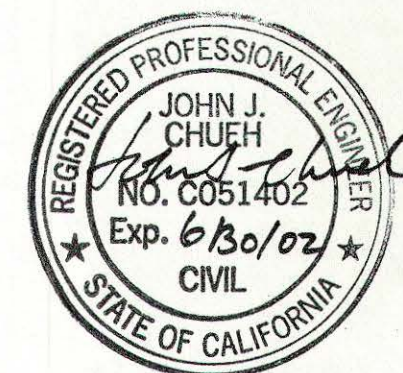

REV	DATE	BY	OMWD	DESCRIPTION

SCALE 3/8" = 1'-0"	WARNING 0 1/2 1 IF THIS BAR DOES NOT MEASURE 1" THEN DRAWING IS NOT TO SCALE
DESIGNED S.P.H.	DRAWN T.S.L.
CHECKED P.F.W.	

SUBMITTED BY	PROJECT MANAGER	LICENSE NO.	DATE
	[Signature]	33699	12/13/00
COMPANY OFFICER		LICENSE NO.	DATE



**MONTGOMERY WATSON**  
Pasadena, California

APPROVED [Signature] OLIVENHAIN MWD APPROVED	DATE 8.29.01
FILANC CONSTRUCTION CO.	DATE

KELWOOD DEVELOPMENT COMPANY 45 RANCH SANITATION DISTRICT WASTEWATER TREATMENT PLANT EXPANSION TO 2.0 MGD NEIGHBORHOOD NO. 1 PUMP STATION FERRIC CHLORIDE FEED AND STORAGE FACILITY
--


SHEET  
**12M-3**  
OF 4 SHEETS



Plot Date: 05-NOV-2001 15:05

File: D:\Projects\45R\12\mec\4sr\2m04.dwg

Job No: MW Job #

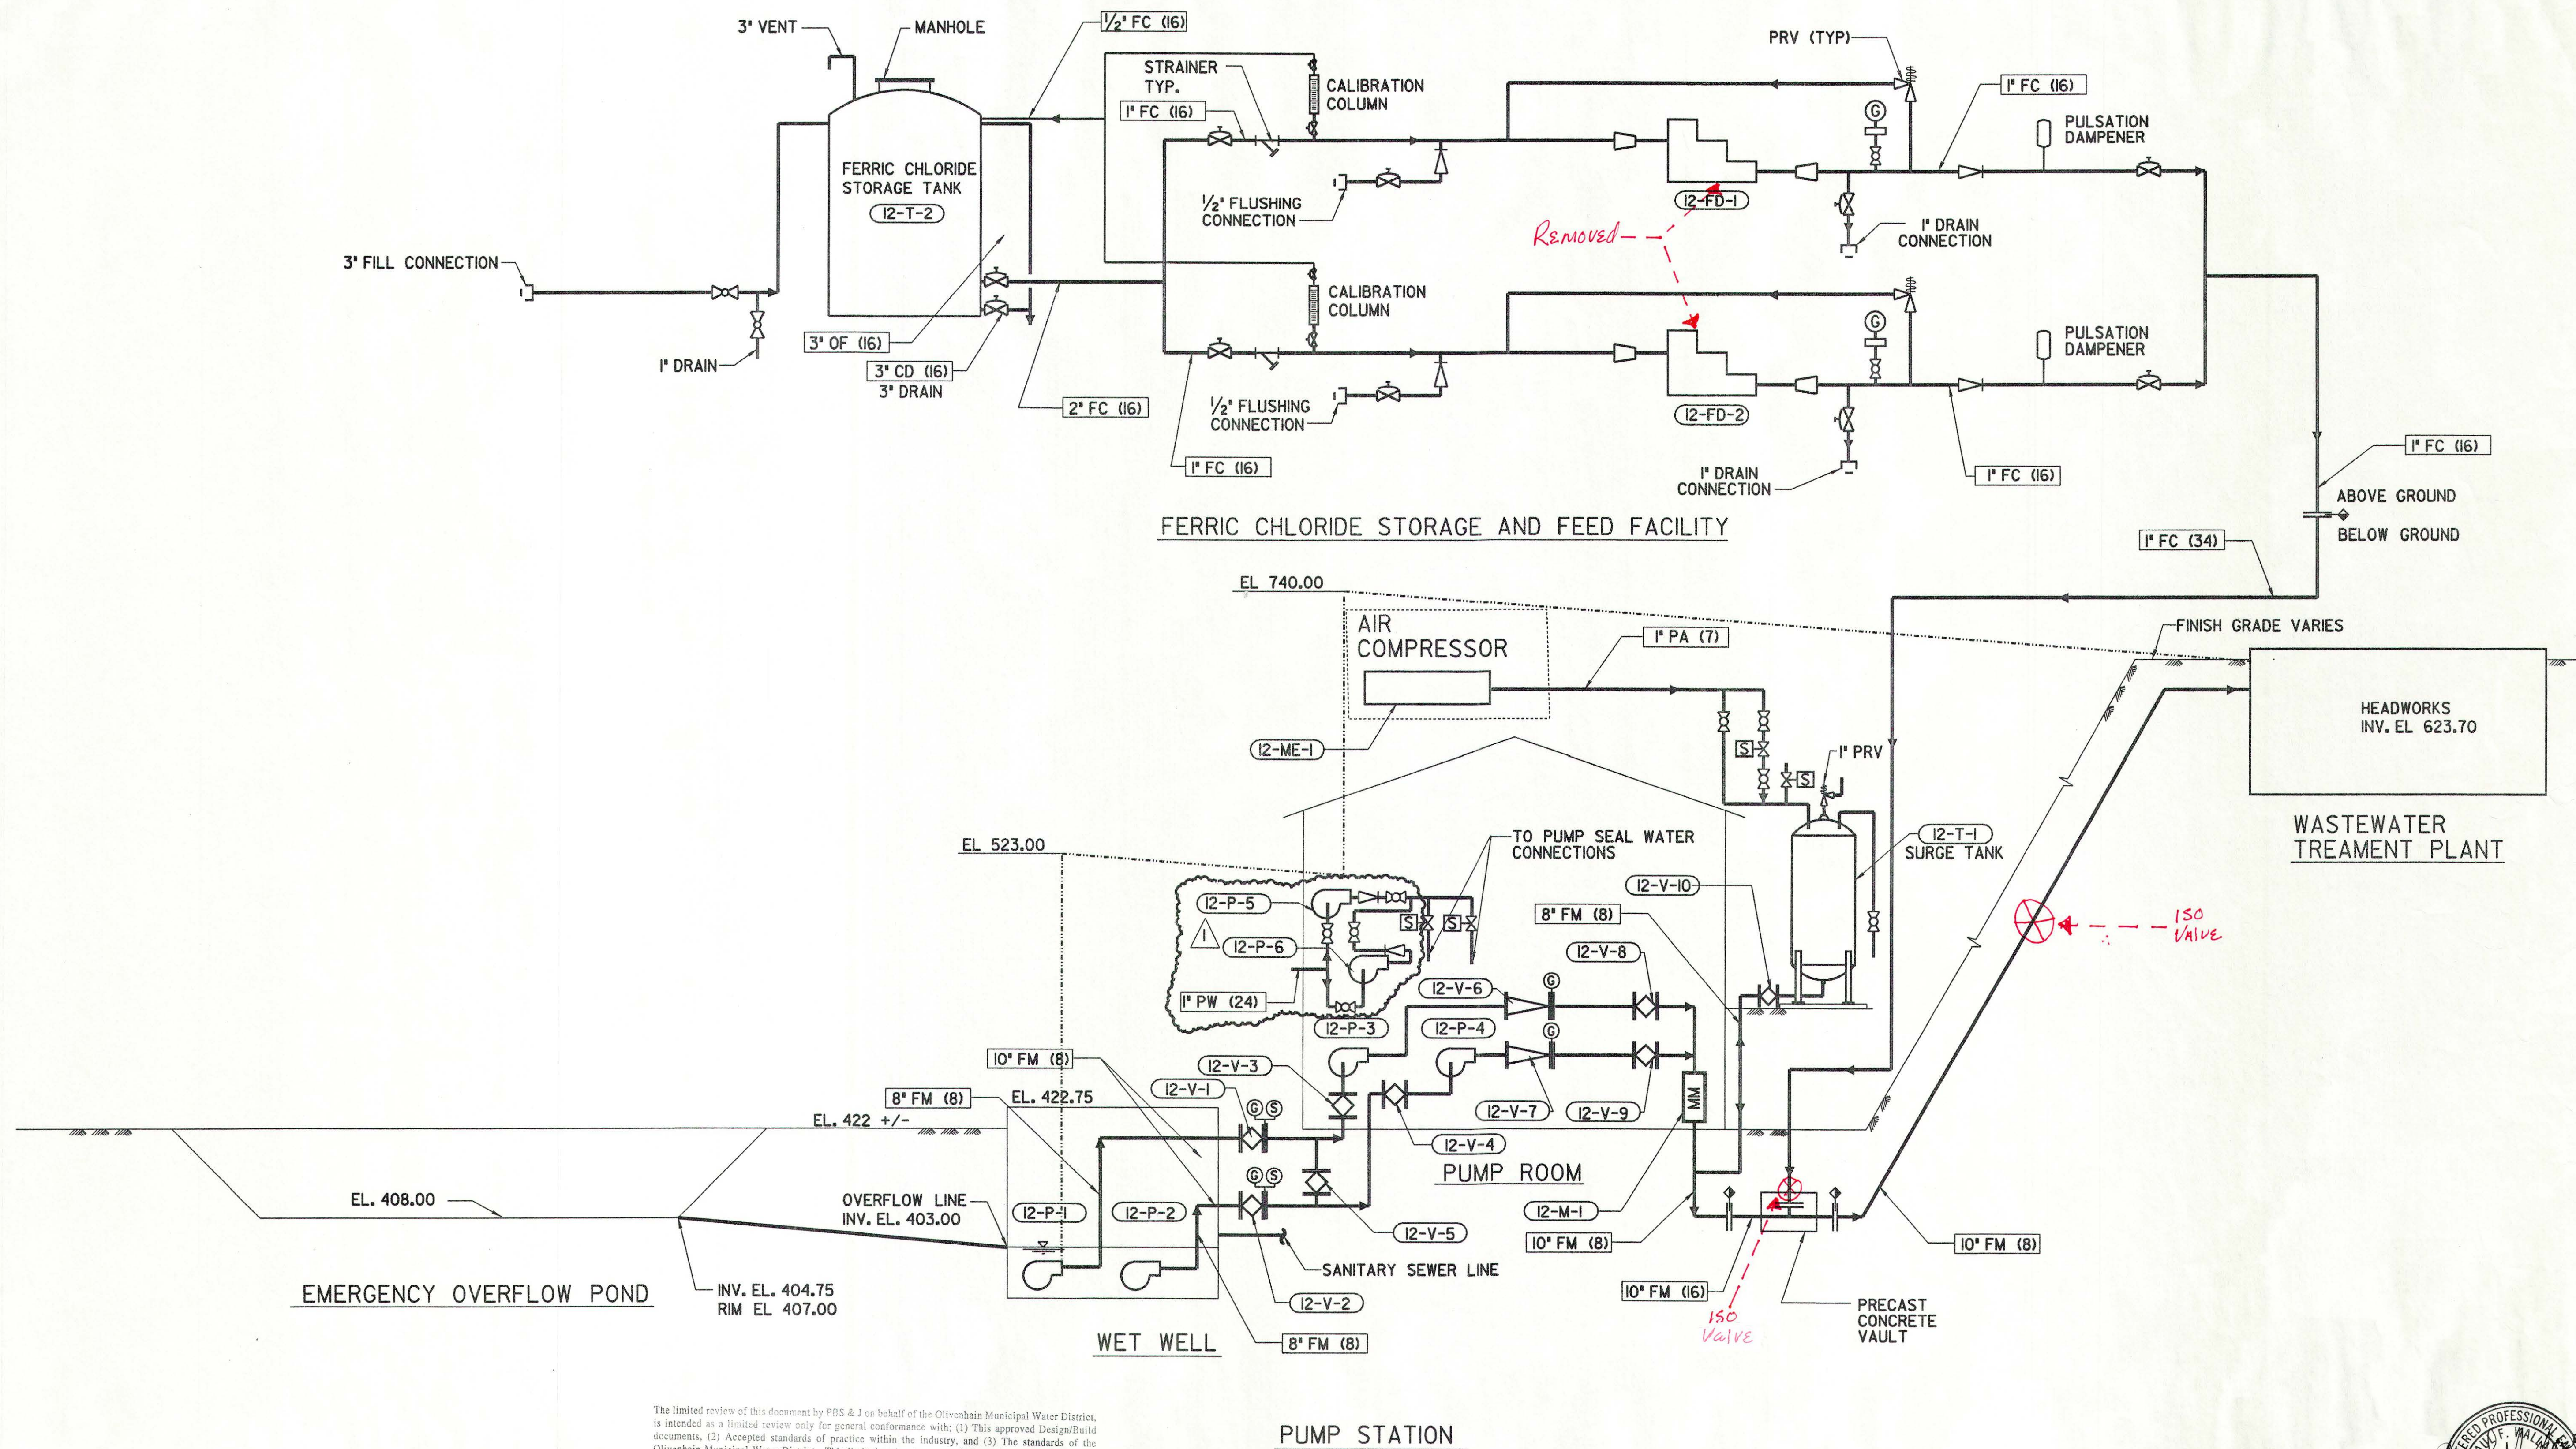

The limited review of this document by PBS & J on behalf of the Olivenhain Municipal Water District, is intended as a limited review only for general conformance with: (1) This approved Design/Build documents, (2) Accepted standards of practice within the industry, and (3) The standards of the Olivenhain Municipal Water District. This limited review in no way is intended, nor shall it act, to relieve the Design/Build Team of any professional liability to the responsibility to provide a complete and functional facility that is compliant with all applicable specifications, standards, codes, and regulations.

PBS & J

Date 12/19/01 By [Signature]

REV	DATE	BY	OMWD	DESCRIPTION
1	11/5/01	PFW		ADD 2ND SEAL WATER BOOSTER PUMP

SCALE  
NONE

WARNING  
0 1/2 1  
IF THIS BAR DOES NOT MEASURE 1" THEN DRAWING IS NOT TO SCALE

DESIGNED S.P.H.  
DRAWN T.S.L.  
CHECKED P.F.W.

SUBMITTED BY [Signature]  
PROJECT MANAGER  
[Signature]  
COMPANY OFFICER

43137  
11/5/01  
DATE  
33699  
11/5/01  
LICENSE NO.  
DATE



**MONTGOMERY WATSON**  
Pasadena, California

APPROVED [Signature]  
OLIVENHAIN MWD  
APPROVED  
FILANC CONSTRUCTION CO.  
DATE

KELWOOD DEVELOPMENT COMPANY  
4S RANCH SANITATION DISTRICT  
WASTEWATER TREATMENT PLANT EXPANSION TO 2.0 MGD  
NEIGHBORHOOD NO. 1 PUMP STATION  
PROCESS SCHEMATIC


SHEET

12M-4


OF 4 SHEETS






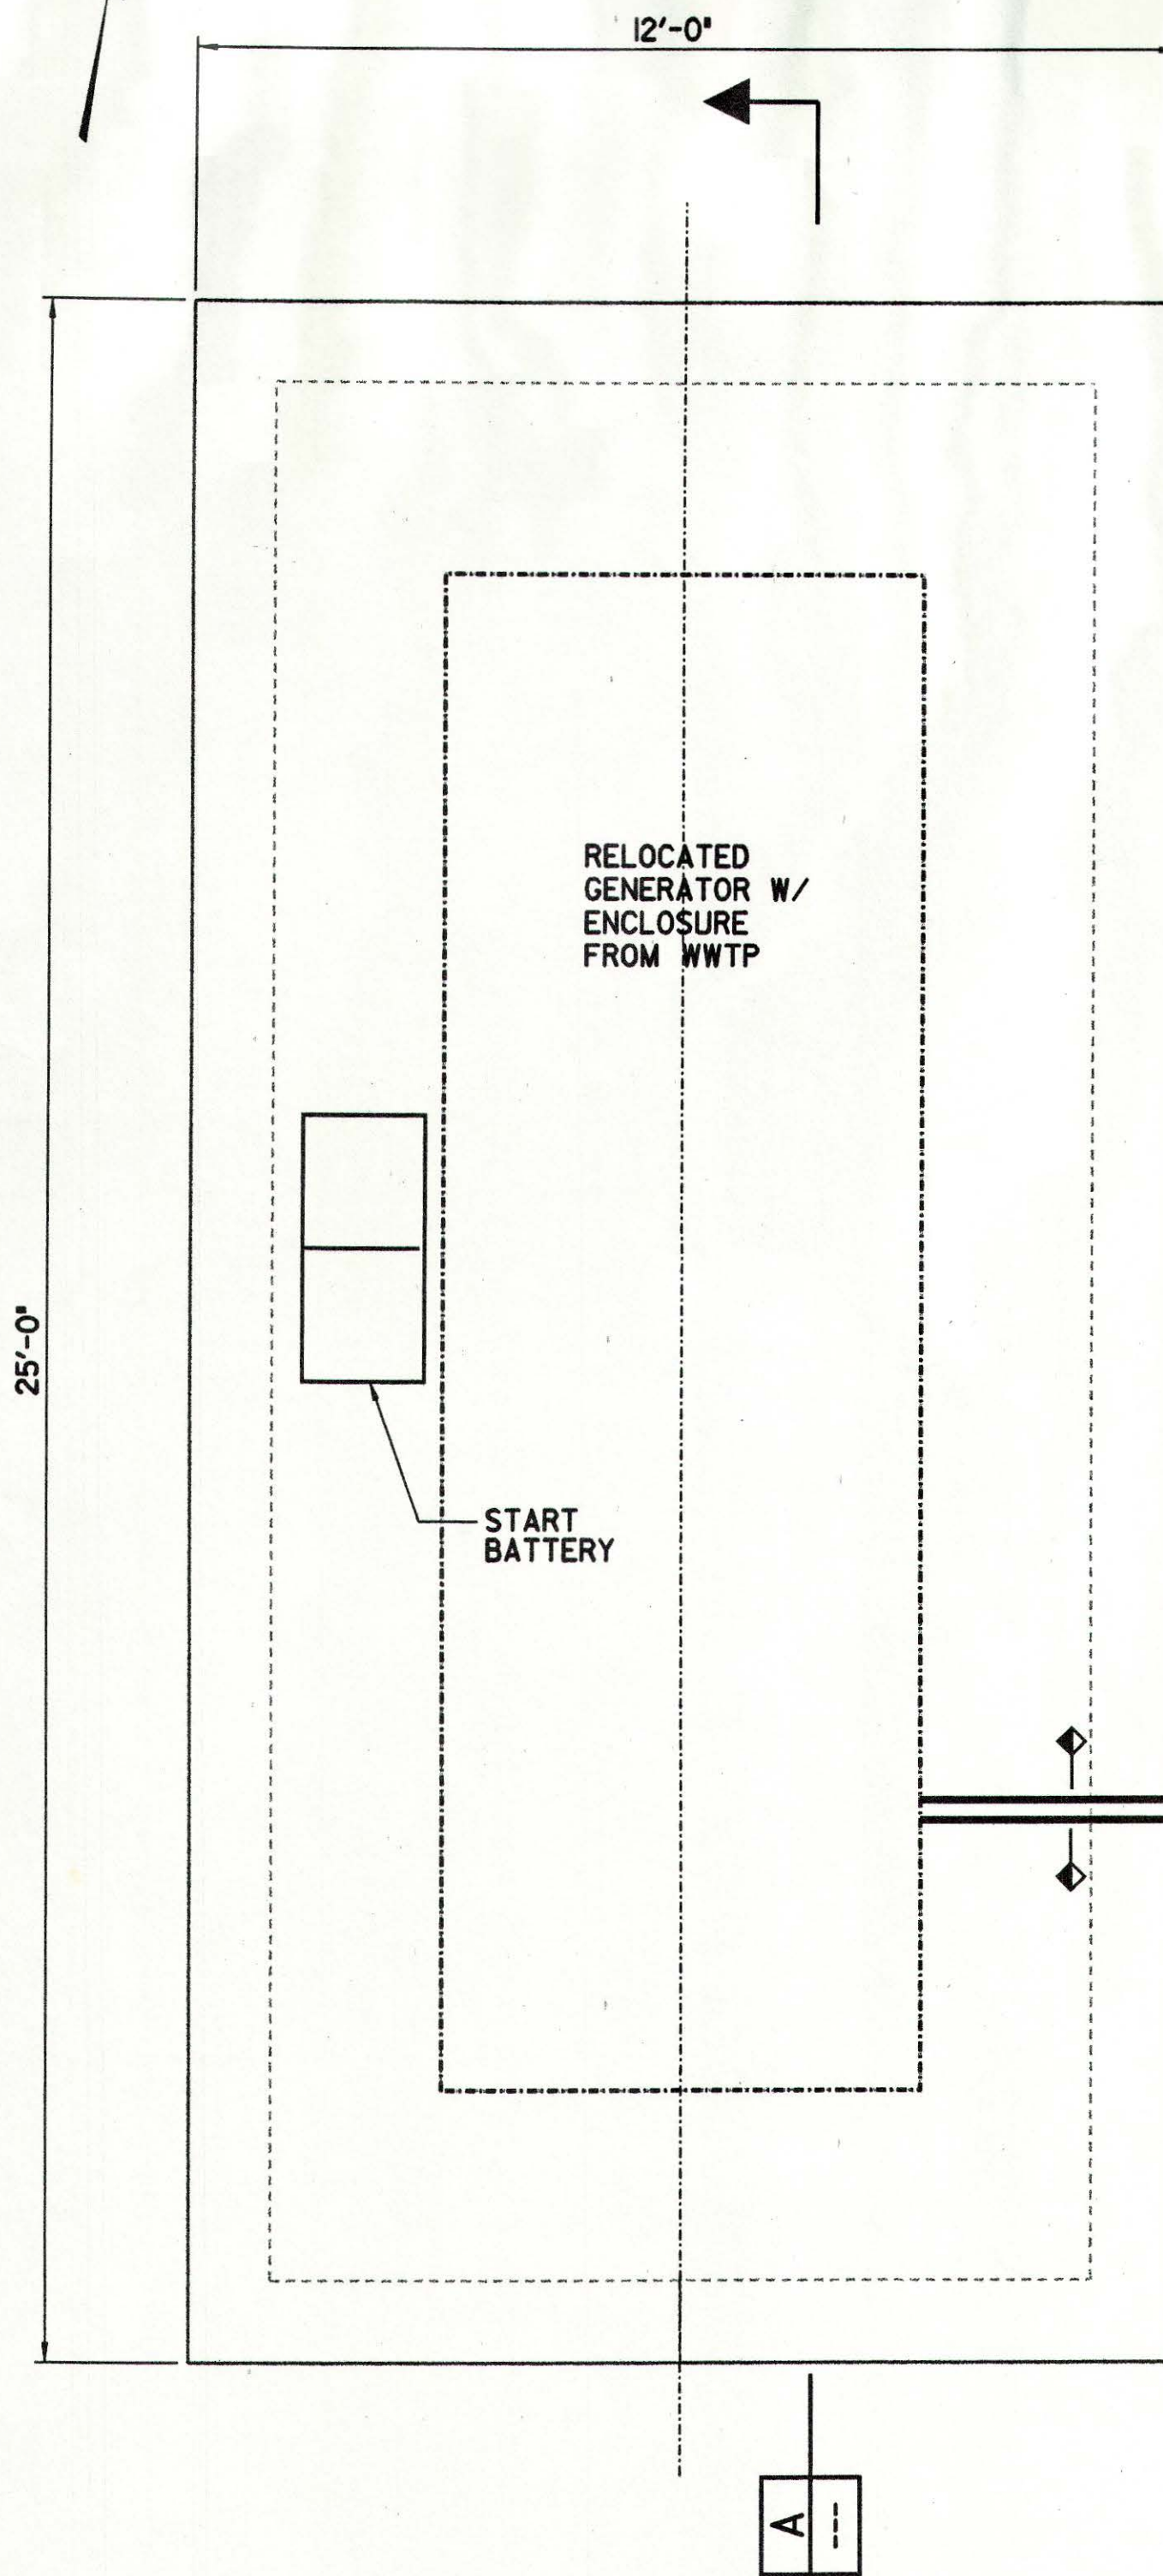


RELOCATED GENERATOR PLAN

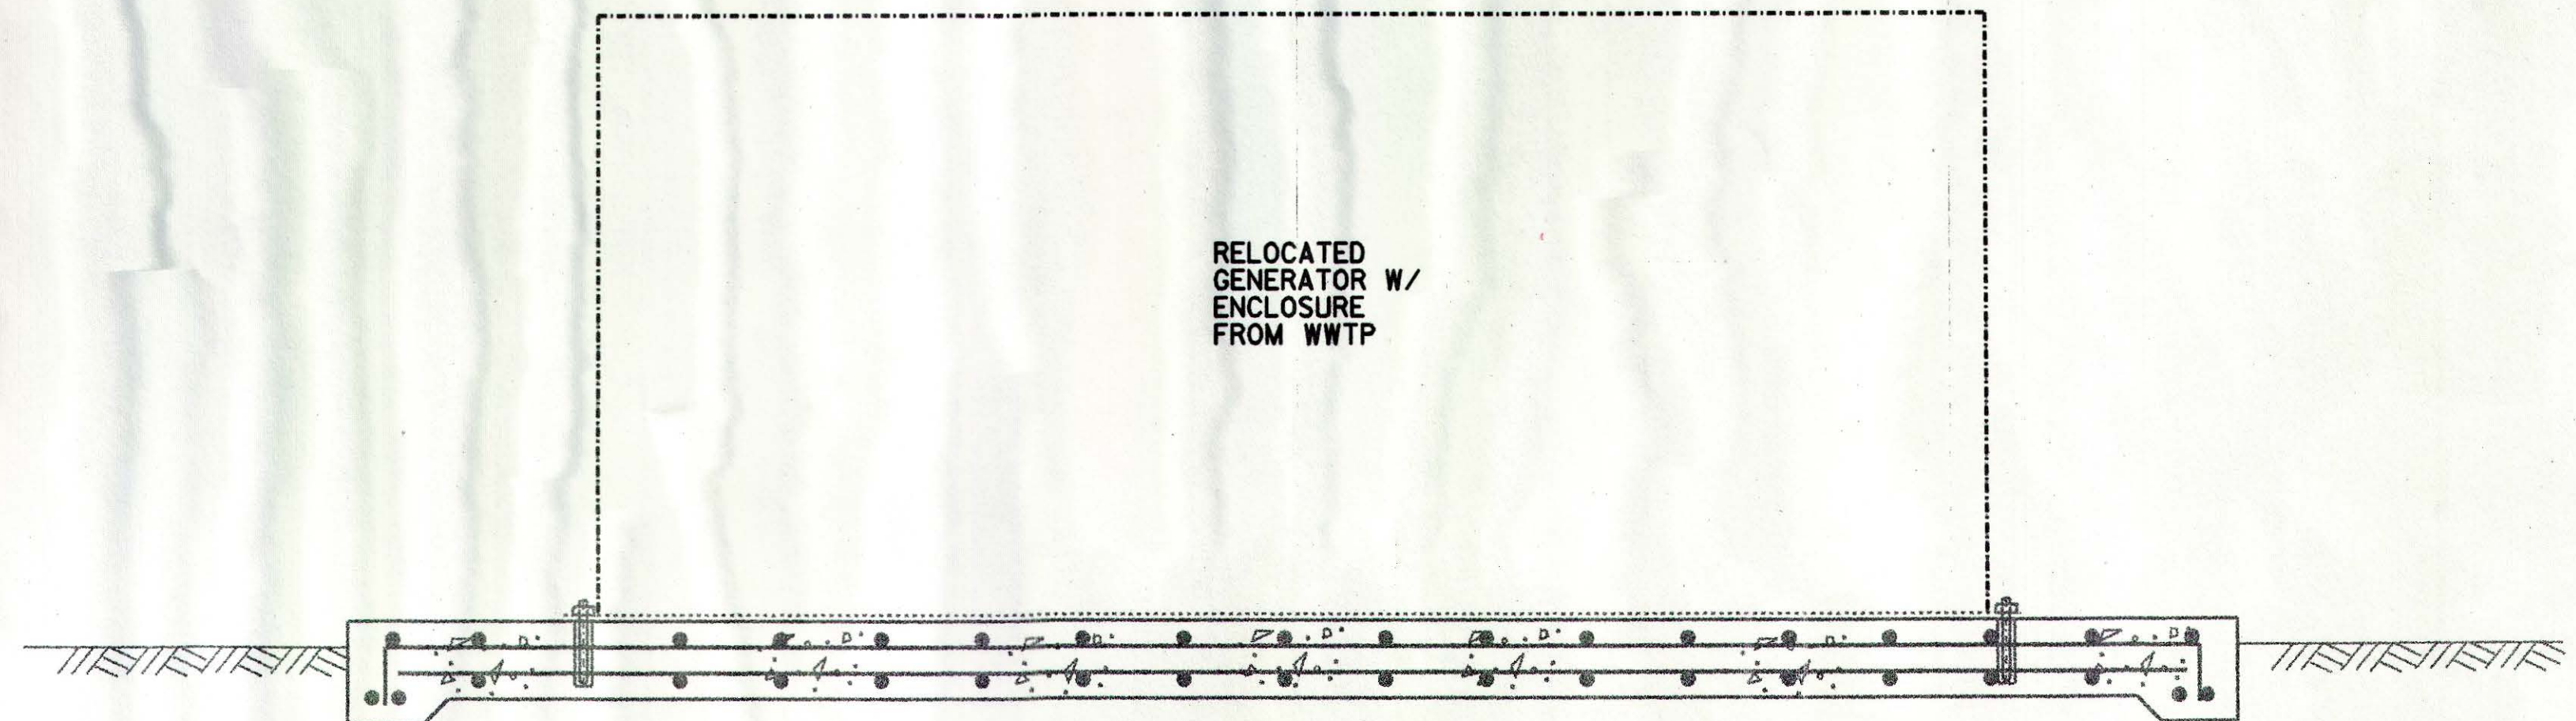

SECTION A  
SCALE: •

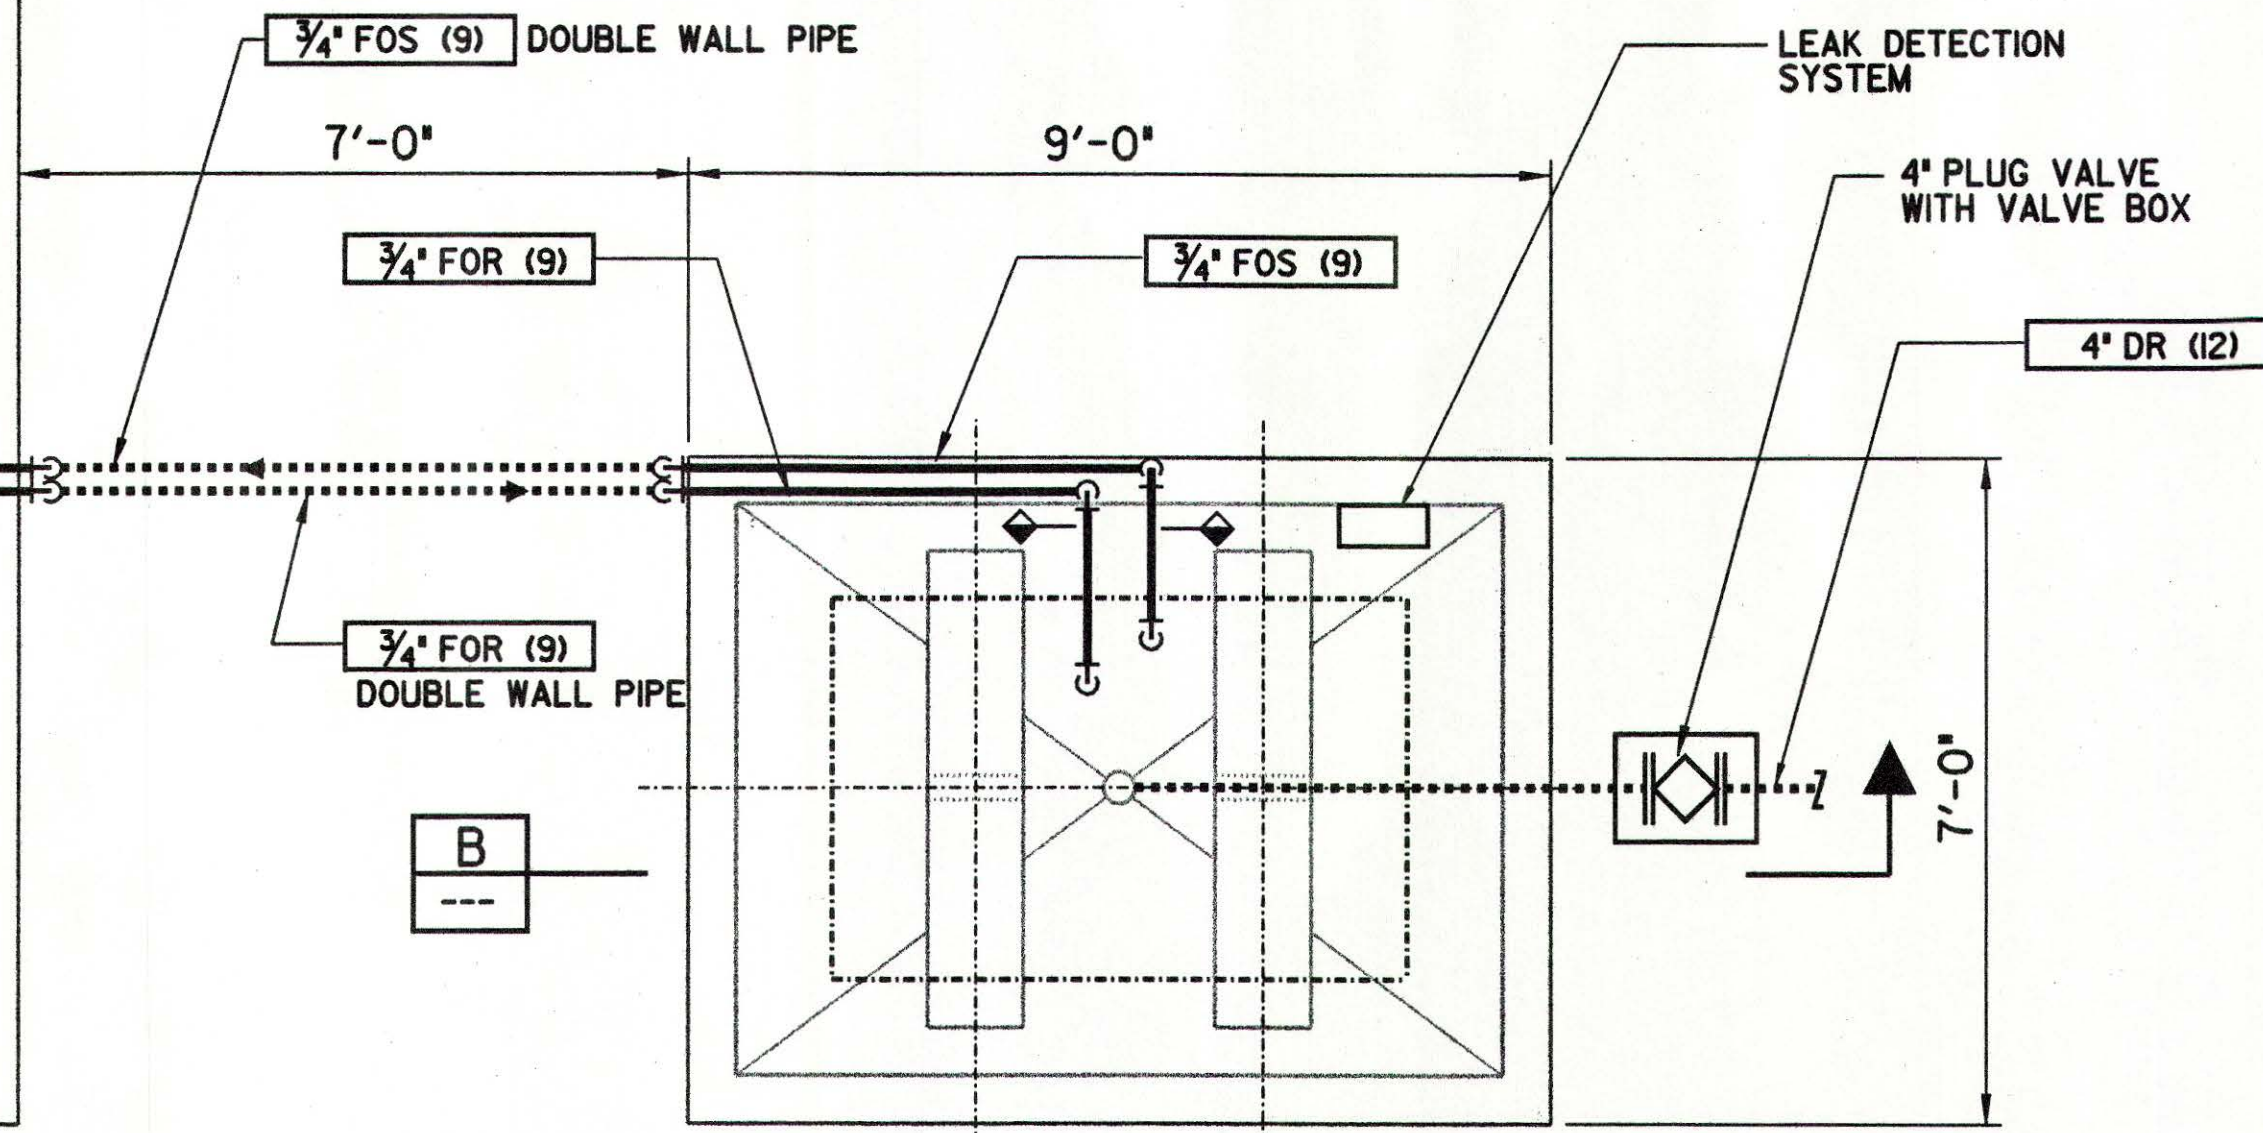

RELOCATED FUEL TANK PLAN

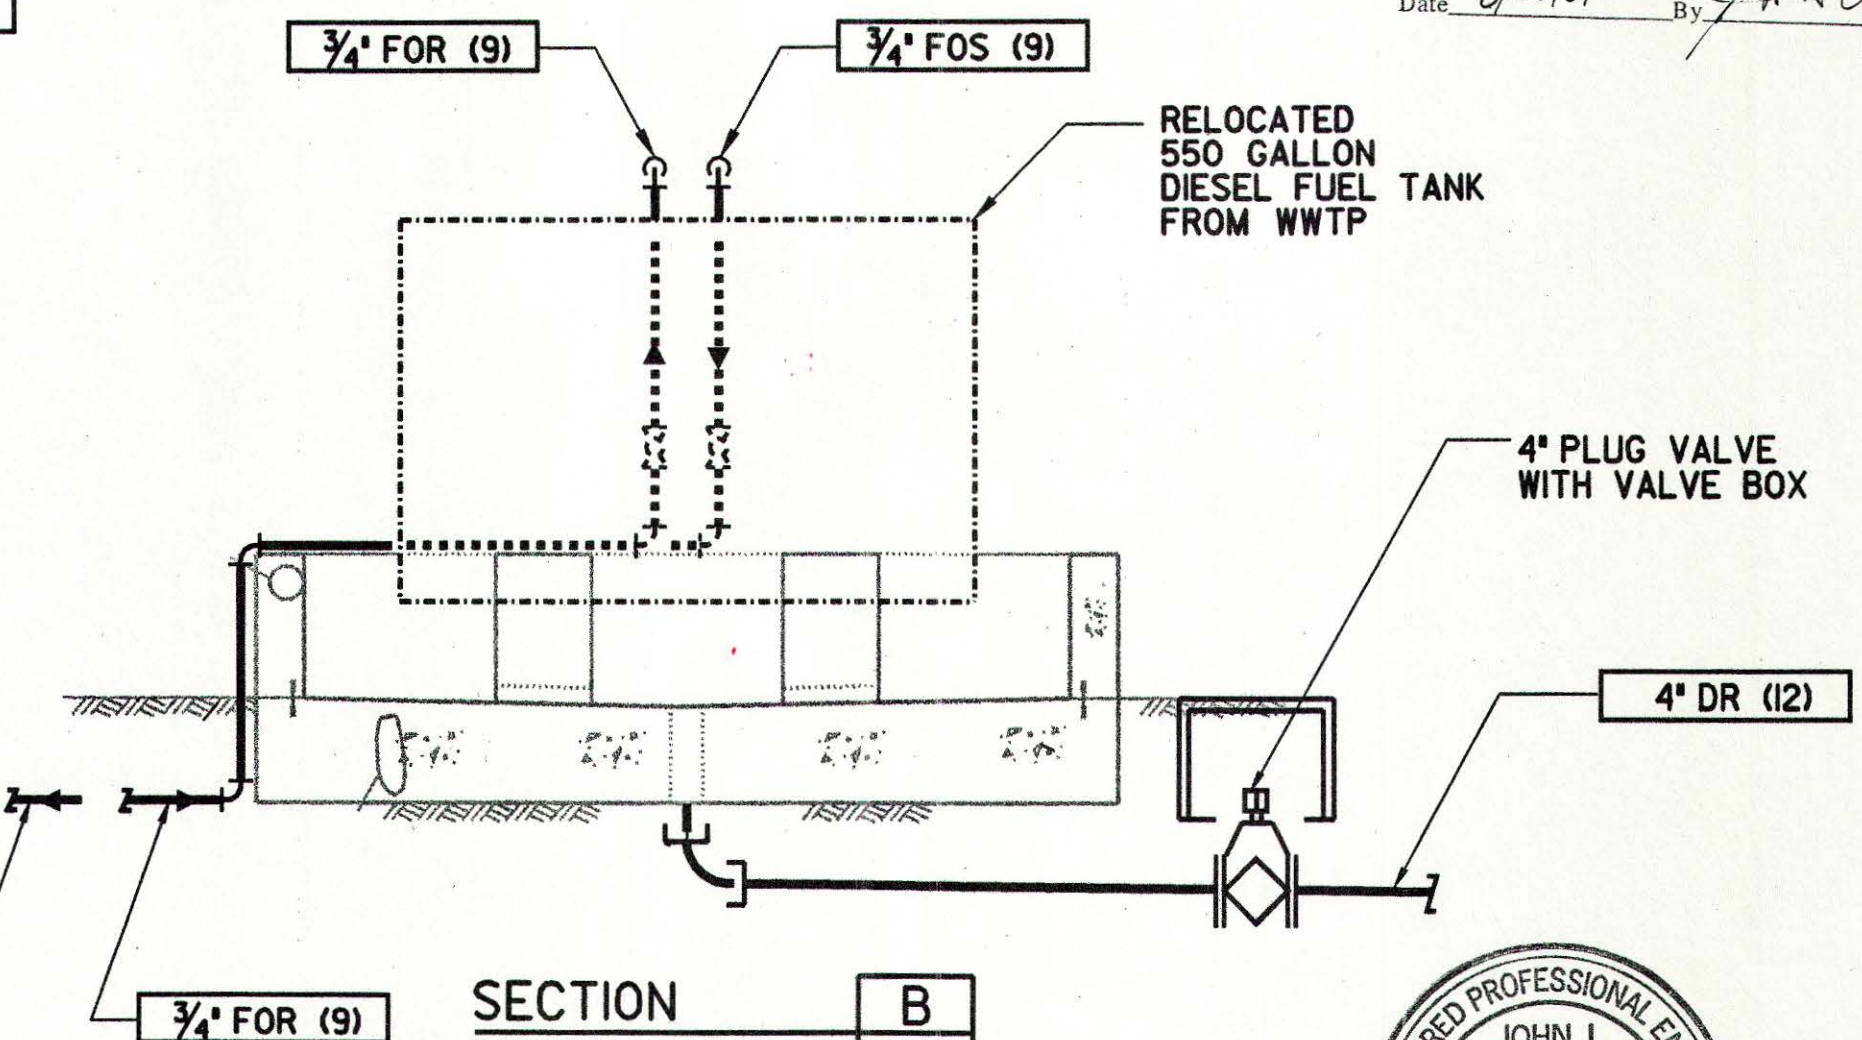

SECTION B  
SCALE: •

The limited review of this document by PBS & J on behalf of the Olivenhain Municipal Water District, is intended as a limited review only for general conformance with: (1) This approved Design/Build documents, (2) Accepted standards of practice within the industry, and (3) The standards of the Olivenhain Municipal Water District. This limited review in no way is intended, nor shall it act, to relieve the Design/Build Team of any professional liability to the responsibility to provide a complete and functional facility that is compliant with all applicable specifications, standards, codes, and regulations.

PBS & J  
Date: 8/23/01 By: [Signature]



REV	DATE	BY	OMWD	DESCRIPTION

SCALE 1/2" = 1'-0"	WARNING 0 1/2 1 IF THIS BAR DOES NOT MEASURE 1" THEN DRAWING IS NOT TO SCALE
-----------------------	--

DESIGNED S.P.H.	SUBMITTED BY [Signature]
DRAWN T.S.L.	PROJECT MANAGER [Signature]
CHECKED P.F.W.	COMPANY OFFICER [Signature]

LICENSE NO. 50802	DATE 12/13/01
LICENSE NO. 33689	DATE 12/13/00




**MONTGOMERY WATSON**  
Pasadena, California

APPROVED [Signature]	DATE 8.29.01
OLIVENHAIN MWD	DATE
FILANC CONSTRUCTION CO.	DATE

KELWOOD DEVELOPMENT COMPANY	45 RANCH SANITATION DISTRICT
WASTEWATER TREATMENT PLANT EXPANSION TO 2.0 MGD	NEIGHBORHOOD NO. 1 PUMP STATION
GENERATOR PAD AND FUEL TANK	




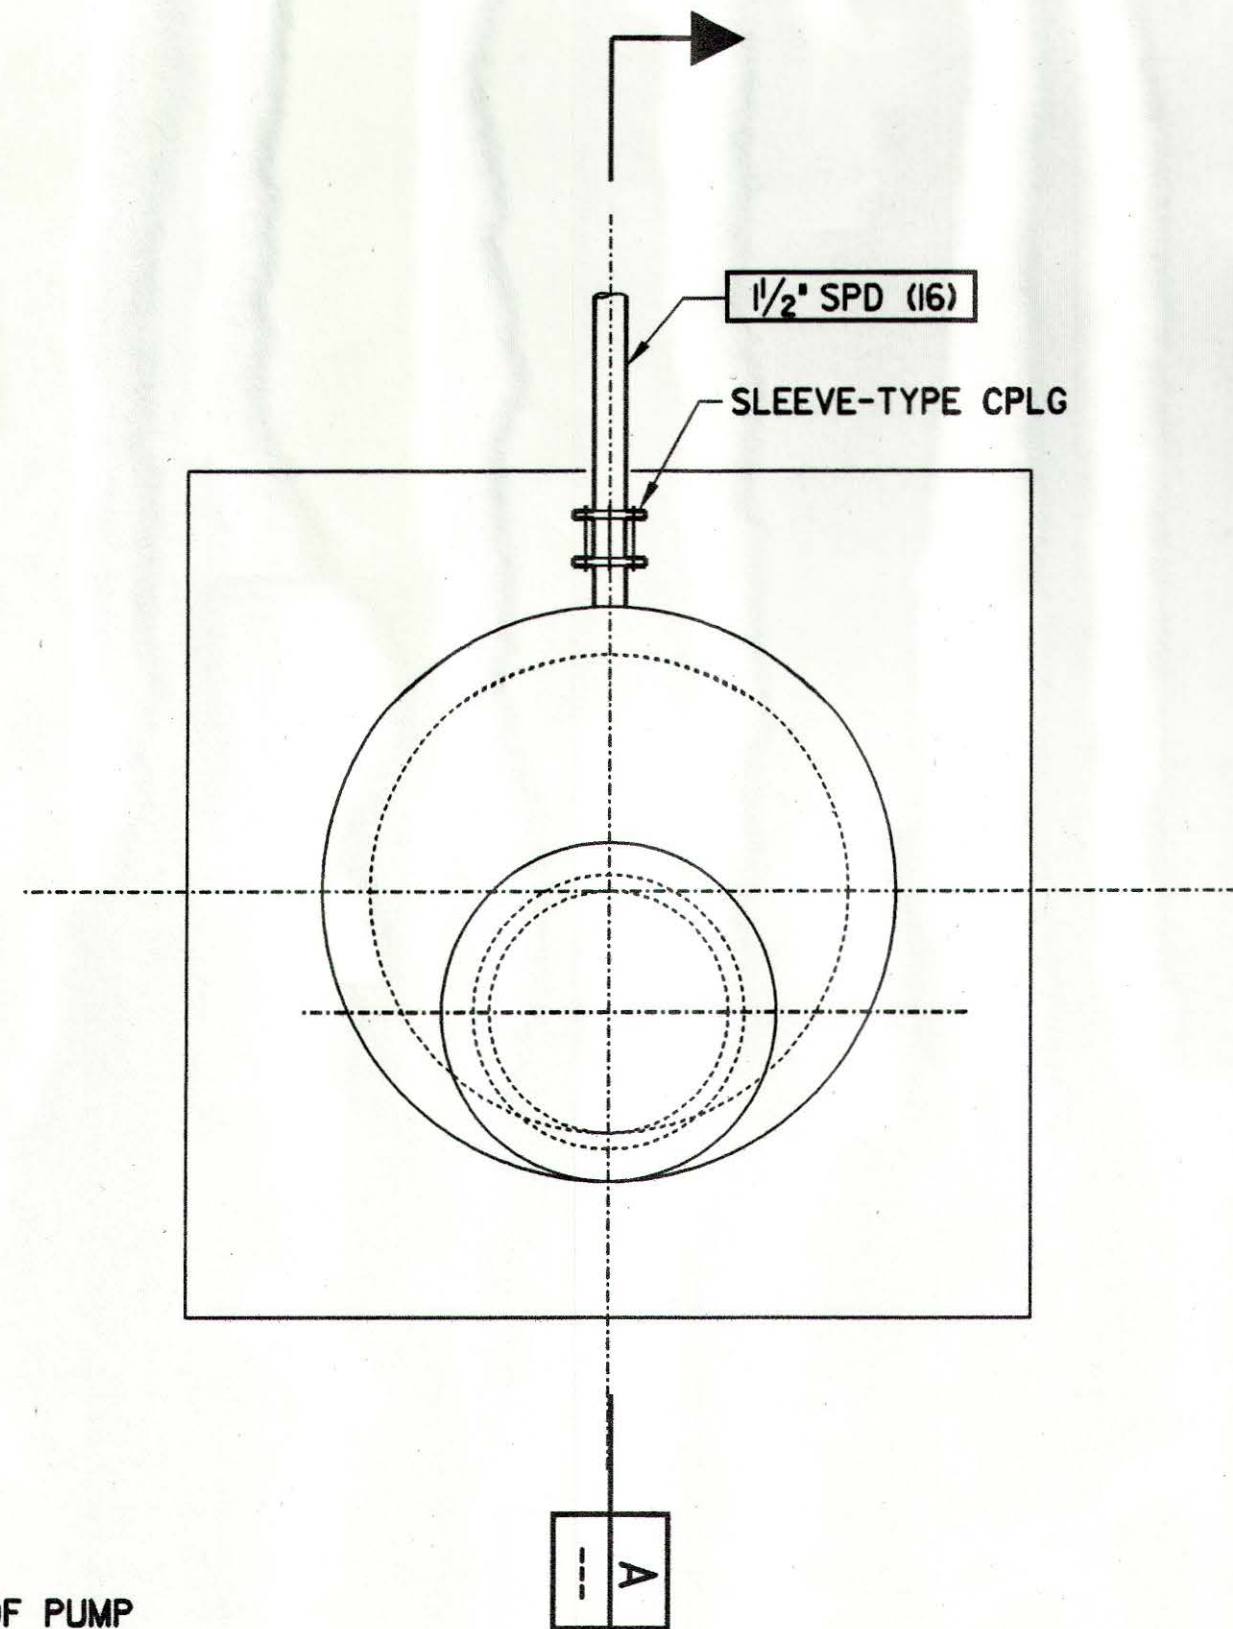

NOTES :

1. FOR LOCATION OF STORM WATER PUMP STATION SEE CIVIL SHEET 12C-3
2. 1/2" REINFORCED NEOPRENE PRESSURE HOSE. LENGTH OF HOSE SHALL ALLOW FOR REMOVAL OF PUMP THROUGH GRATING COVER. PROVIDE QUICK CONNECT FITTING AT PUMP.


PLAN - STORM WATER PUMP STATION  
SCALE: 1/2" = 1'-0"

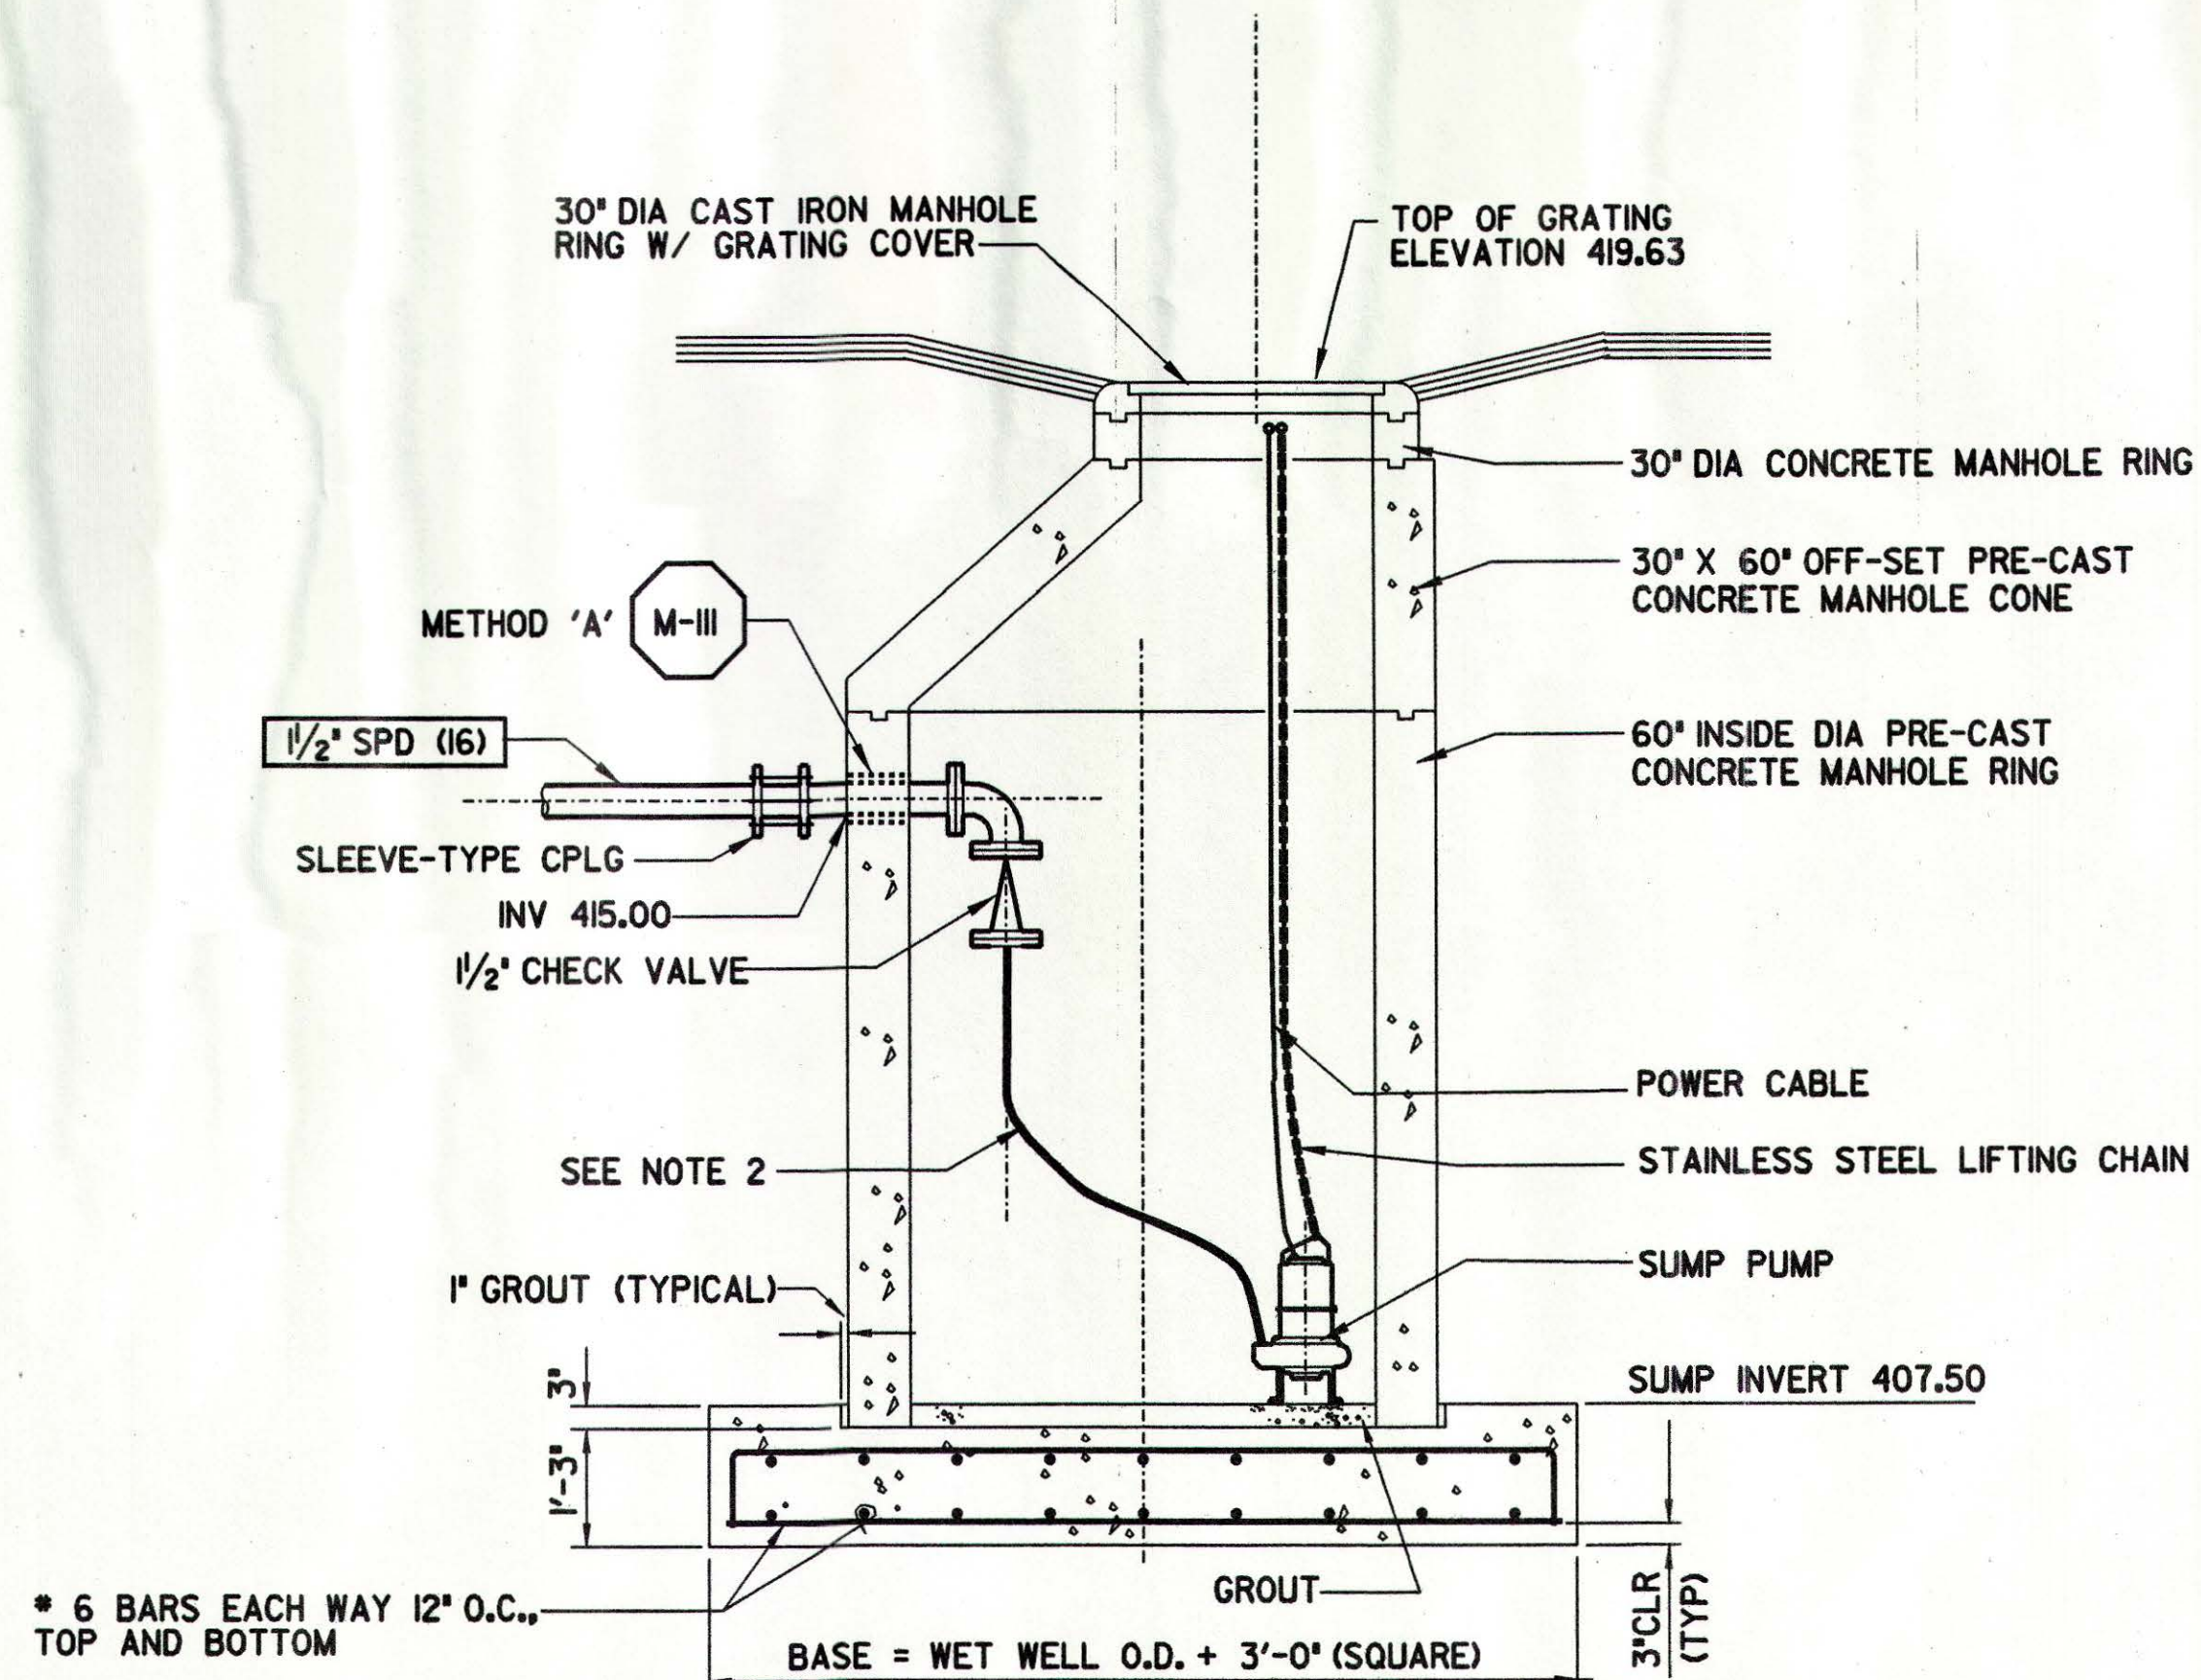

SECTION  
SCALE: 1/2" = 1'-0"

The limited review of this document by PBS & J on behalf of the Olivenhain Municipal Water District, is intended as a limited review only for general conformance with: (1) This approved Design/Build documents, (2) Accepted standards of practice within the industry, and (3) The standards of the Olivenhain Municipal Water District. This limited review in no way is intended, nor shall it act, to relieve the Design/Build Team of any professional liability to the responsibility to provide a complete and functional facility that is compliant with all applicable specifications, standards, codes, and regulations.

PBS & J  
Date: 8/23/01 By: J. J. J.

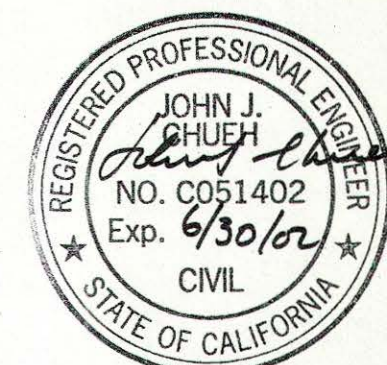

REV	DATE	BY	OMWD	DESCRIPTION

SCALE	WARNING
1/2" = 1'-0"	IF THIS BAR DOES NOT MEASURE 1" THEN DRAWING IS NOT TO SCALE

DESIGNED	J.G.
DRAWN	L.R.M.
CHECKED	P.F.W.

SUBMITTED BY	PROJECT MANAGER	50802	12/13/00
		LICENSE NO.	DATE
	COMPANY OFFICER	33699	12/13/00
		LICENSE NO.	DATE



**MONTGOMERY WATSON**  
Pasadena, California

APPROVED	8-29-01
OLIVENHAIN MWD	DATE
APPROVED	DATE
FILANC CONSTRUCTION CO.	DATE

KELWOOD DEVELOPMENT COMPANY
4S RANCH SANITATION DISTRICT
WASTEWATER TREATMENT PLANT EXPANSION TO 2.0 MGD
NEIGHBORHOOD NO.1 PUMP STATION
STORM WATER P.S. PLAN AND SECTION

SHEET  
12M-6  
OF 6 SHEETS



# GENERAL NOTES


## GENERAL

STRUCTURAL DIMENSIONS CONTROLLED BY OR RELATED TO MECHANICAL OR ELECTRICAL EQUIPMENT SHALL BE COORDINATED BY THE CONTRACTOR PRIOR TO CONSTRUCTION.

MECHANICAL AND ELECTRICAL EQUIPMENT SUPPORTS, ANCHORAGES, OPENINGS, RECESSES AND REVEALS NOT SHOWN ON THE STRUCTURAL DRAWINGS BUT REQUIRED BY OTHER CONTRACT DRAWINGS, SHALL BE PROVIDED FOR PRIOR TO PLACING CONCRETE.

STRUCTURAL DRAWINGS SHALL BE USED IN COORDINATION WITH MECHANICAL, ELECTRICAL, ARCHITECTURAL, CIVIL DRAWINGS AND SHOP DRAWINGS PROVIDED BY MANUFACTURES OF EQUIPMENT.

STRUCTURES HAVE BEEN DESIGNED FOR OPERATIONAL LOADS ON THE COMPLETED STRUCTURES. DURING CONSTRUCTION, THE STRUCTURES SHALL BE PROTECTED BY BRACING AND BALANCING WHEREVER EXCESSIVE CONSTRUCTION LOADS MAY OCCUR.

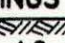UNLESS OTHERWISE SHOWN ON ALL STRUCTURAL DRAWINGS THE FINISH GRADE AROUND STRUCTURES IS SHOWN THUS  INDICATING EITHER GROUND SURFACE, TOP OF CONCRETE SLAB OR AC PAVEMENT. FOR DETAILS OF FINISH SURFACES SEE CIVIL AND ARCHITECTURAL DRAWINGS.

## STRUCTURAL

DESIGN IN ACCORDANCE WITH THE 1994 EDITION OF THE UNIFORM BUILDING CODE, EXCEPT WHERE OTHER APPLICABLE CODES OR THE FOLLOWING NOTES ARE MORE RESTRICTIVE.

LOCATION OF ALL CONSTRUCTION JOINTS SHALL BE AS SHOWN ON THE DRAWINGS OR APPROVED BY THE ENGINEER. ALL CONSTRUCTION JOINTS LOCATED ON THE DRAWINGS OR REQUIRED FOR CONSTRUCTION, BUT NOT SHOWN ON THE DRAWINGS, SHALL HAVE A 6" FLATSTRIP WATERSTOP, IF IN MEMBERS IN CONTACT WITH WATER. IN ADDITION, JOINTS IN ALL SLABS COVERED WITH WATER, SHALL HAVE BOTH A 6" FLATSTRIP WATERSTOP AND A SEALANT GROOVE.

## STRUCTURAL STEEL

STEEL CONSTRUCTION SHALL CONFORM TO THE SPECIFICATIONS AND STANDARDS AS CONTAINED IN THE LATEST EDITION OF THE AISC STEEL CONSTRUCTION MANUAL.

ALL STRUCTURAL SHAPES, BARS, PLATES AND SHEETS SHALL BE OF STEEL MEETING ASTM A-36 SPECIFICATIONS.

ALL WELDING SHALL BE BY THE SHIELDED ARC METHOD AND SHALL CONFORM TO AWS CODE FOR ARC AND GAS WELDING IN BUILDING CONSTRUCTION. QUALIFICATIONS OF WELDERS SHALL BE IN ACCORDANCE WITH THE SPECIFICATIONS FOR STANDARD QUALIFICATION PROCEDURE OF THE AWS.

## CONCRETE (EXCEPT PRECAST CONCRETE)

UNLESS OTHERWISE NOTED OR SPECIFIED, ALL STRUCTURAL CONCRETE SHALL DEVELOP A MINIMUM COMPRESSIVE STRENGTH OF 4000 PSI IN 28 DAYS.

REINFORCEMENT STEEL SHALL BE DEFORMED BARS CONFORMING IN QUALITY TO THE REQUIREMENTS OF ASTM A-615, "SPECIFICATIONS FOR DEFORMED BILLET-STEEL BARS FOR CONCRETE REINFORCEMENT", GRADE 60.

COLUMN SPIRALS SHALL CONFORM TO ASTM A-82, "SPECIFICATION FOR COLD-DRAWN STEEL WIRE FOR CONCRETE REINFORCEMENT".

ALL DETAILING, FABRICATION AND PLACING OF REINFORCING BARS, UNLESS OTHERWISE INDICATED, SHALL BE IN ACCORDANCE WITH ACI-315, "MANUAL OF STANDARD PRACTICE FOR DETAILING REINFORCED CONCRETE STRUCTURES", LATEST EDITION.

TOLERANCES IN PLACING REINFORCEMENT SHALL BE:

- ± 3/8 INCH FOR MEMBERS WITH D < 8 INCHES
- ± 1/2 INCH FOR MEMBERS WITH D > 8 INCHES

ALL KEYWAYS IN CONSTRUCTION JOINTS, WHERE SHOWN, SHALL BE ROUGH AND THOROUGHLY CLEANED FOR BOND.

DOWELS, PIPE, WATERSTOPS AND OTHER INSTALLED MATERIALS AND ACCESSORIES SHALL BE HELD SECURELY IN POSITION WHILE CONCRETE IS BEING PLACED.

UNLESS OTHERWISE INDICATED, ASIDE FROM NORMAL ACCESSORIES USED TO HOLD REINFORCING BARS FIRMLY IN POSITION, THE FOLLOWING SHALL BE ADDED:

- IN SLABS #5 RISER BARS AT 36 INCHES OC MAXIMUM TO SUPPORT TOP REINFORCING BARS.
- IN WALLS WITH 2 CURTAINS #3 U OR Z SHAPE SPACERS AT 6 FEET OC EACH WAY.

METAL CLIPS OR SUPPORTS SHALL NOT BE PLACED IN CONTACT WITH THE FORMS OR THE SUBGRADE CONCRETE BLOCKS (OR DOBIES). SUPPORTING BARS ON SUBGRADE SHALL BE IN SUFFICIENT NUMBERS TO SUPPORT THE BARS WITHOUT SETTLEMENT, BUT IN NO CASE SHALL SUCH SUPPORT BE CONTINUOUS.

DOWELS SHALL BE WIRED OR OTHERWISE HELD IN POSITION. THEY SHALL NOT BE SHOVED INTO FRESHLY PLACED CONCRETE.

UNLESS OTHERWISE INDICATED ON THE DRAWINGS, LAPS OF REINFORCEMENT SHALL BE AS SHOWN ON DETAIL S-143.

LOCATE TWO 3/4 INCH GALVANIZED RICHMOND ROCKET INSERTS, HOHMANN & BARNARD OR EQUAL, STRADDLING CENTERLINE OF EQUIPMENT OVER ALL PUMPS, METERS OR OTHER MECHANICAL UNITS OF MORE THAN 100 LBS, FOR INSERTING LIFTING EYES IF NOT OTHERWISE INDICATED.

REINFORCING BARS AND ACCESSORIES SHALL NOT BE IN CONTACT WITH AND PIPE, PIPE FLANGE OR METAL PARTS EMBEDDED IN CONCRETE. A MINIMUM OF 2 INCHES CLEARANCE SHALL BE PROVIDED AT ALL TIMES.

UNLESS OTHERWISE SHOWN ON THE DRAWINGS CONCRETE COVER FOR REINFORCING BARS SHALL BE AS FOLLOWS:

- FOR CONCRETE PLACED AGAINST EARTH 3"
- FOR SURFACES IN CONTACT WITH WATER OR WEATHER AND FORMED SURFACES IN CONTACT WITH EARTH 2"
- FOR CONCRETE NOT EXPOSED TO WEATHER, OR IN CONTACT WITH WATER OR EARTH 1 1/2"

UNLESS OTHERWISE NOTED, WALLS AND SLABS SHOWN WITH A SINGLE LAYER OF REINFORCEMENT SHALL HAVE THAT REINFORCEMENT CENTERED

SLABS WITH SLOPING SURFACES SHALL HAVE THE INDICATED SLAB THICKNESS MAINTAINED AS THE MINIMUM. SLAB BOTTOMS MAY EITHER SLOPE WITH THE TOP SURFACE OR BE LEVEL. REINFORCING IN SLABS WITH SLOPING SURFACES SHALL BE PLACED AT THE REQUIRED CLEARANCE FROM THE SLAB SURFACES.

## MASONRY

CONCRETE BLOCK MASONRY SHALL BE MEDIUM HOLLOW UNITS CONFORMING TO ASTM C 90, GRADE N. SIZE OF UNITS, COLOR AND TEXTURE SHALL BE PER THE SPECIFICATIONS.

GROUT ALL CELLS OF CONCRETE BLOCK MASONRY UNLESS OTHERWISE NOTED ON DRAWINGS.

BAR LAPS SHALL BE 72 BAR DIAMETERS UNLESS OTHERWISE NOTED.

MORTAR SHALL BE IN ACCORDANCE WITH TABLE 21-A OF UBC TYPE M AND SHALL HAVE A MINIMUM COMPRESSIVE STRENGTH AT 28 DAYS OF 2000 PSI.

GROUT SHALL BE IN ACCORDANCE WITH PARAGRAPH 2103 OF THE UBC AND AS MODIFIED BY SPECIFICATION AND SHALL HAVE A MINIMUM COMPRESSIVE STRENGTH OF 2500 PSI.

UNLESS OTHERWISE SPECIFIED, SPECIAL INSPECTION SHALL BE PROVIDED FOR ALL MASONRY WORK.

THE COMBINED MASONRY ASSEMBLAGE COMPRESSIVE STRENGTH AT 28 DAYS SHALL BE A MINIMUM OF f'm = 2000 PSI.

REINFORCEMENT SHALL BE TIED OR OTHERWISE SECURED IN POSITION PRIOR TO GROUTING.

## ALUMINUM

ALUMINUM CONSTRUCTION SHALL BE IN ACCORDANCE WITH AMERICAN SOCIETY OF CIVIL ENGINEERS SPECIFICATIONS FOR STRUCTURES OF ALUMINUM ALLOY 6061-T6. ALUMINUM SURFACES SHALL BE PREVENTED FROM COMING IN DIRECT CONTACT WITH CONCRETE OR WITH METALS NOT COMPATIBLE WITH ALUMINUM, USING METHODS DESCRIBED IN THE SPECIFICATIONS.

## TESTING HYDRAULIC STRUCTURES

WHEN FILLING THE STRUCTURES WITH WATER FOR THE TEST REQUIRED IN THE SPECIFICATIONS, ALL VARIOUS BASINS LOCATED IN THE SAME STRUCTURE SHALL BE FILLED SIMULTANEOUSLY AT THE SAME RATE IN ORDER TO KEEP THE SAME LEVEL IN EACH BASIN.

## STRUCTURAL STANDARD DETAILS

DETAILS ON SHEETS S-1 THRU S-7 ARE PART OF MONTGOMERY WATSON'S STRUCTURAL STANDARD DETAILS.

THESE DETAILS ARE TO BE USED WHEN REFERRED TO OR WHEN NO OTHER MORE RESTRICTIVE OR DIFFERENT DETAILS ARE SHOWN ON THE DRAWINGS.

DETAILS NOT PERTAINING TO THE PROJECT ARE MARKED THUS 





## STRUCTURAL STANDARD DETAIL CALL-OUT

### INSPECTION

SPECIAL INSPECTION SHALL BE PROVIDED FOR THE FOLLOWING IN ACCORDANCE WITH CHAPTER 17 OF THE 1994 UBC:

TAKING OF TEST SPECIMENS; AND PLACING OF REINFORCING AND ANCHOR BOLTS FOR CONCRETE FOUNDATIONS; ALL STRUCTURAL WELDING EXCEPT BY AN APPROVED FABRICATOR; INSTALLATION OF ALL HIGH STRENGTH BOLTING; ALL STRUCTURAL MASONRY; AND PLACING OF PRE-ENGINEERED WOOD TRUSSES.

## DETAIL

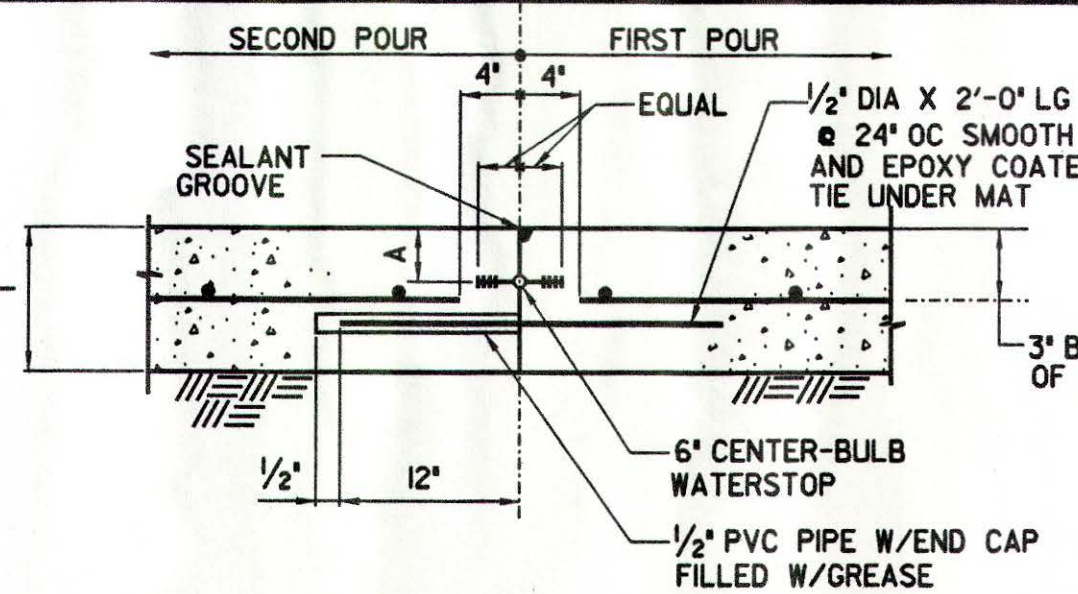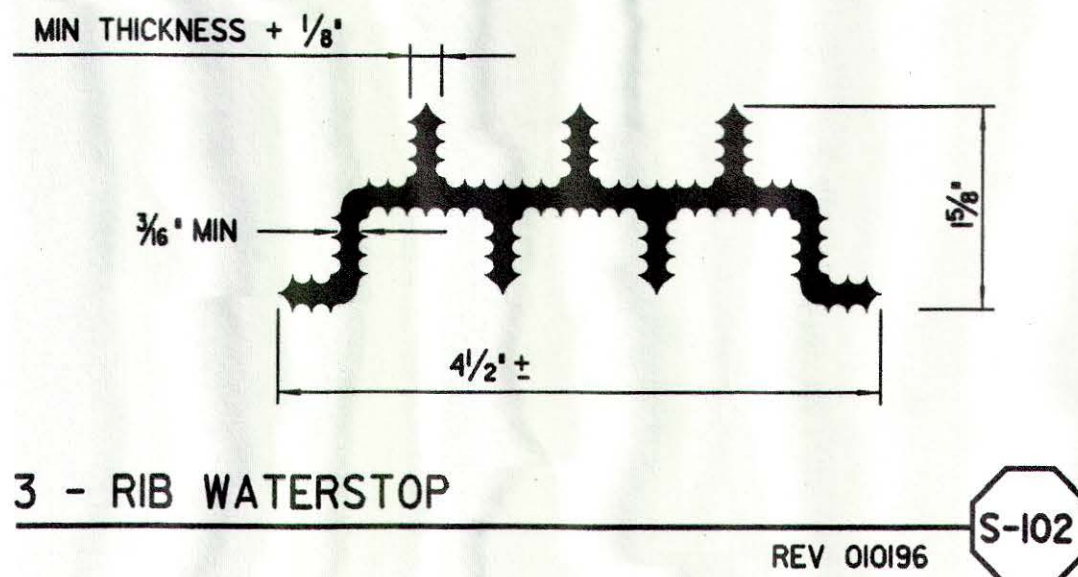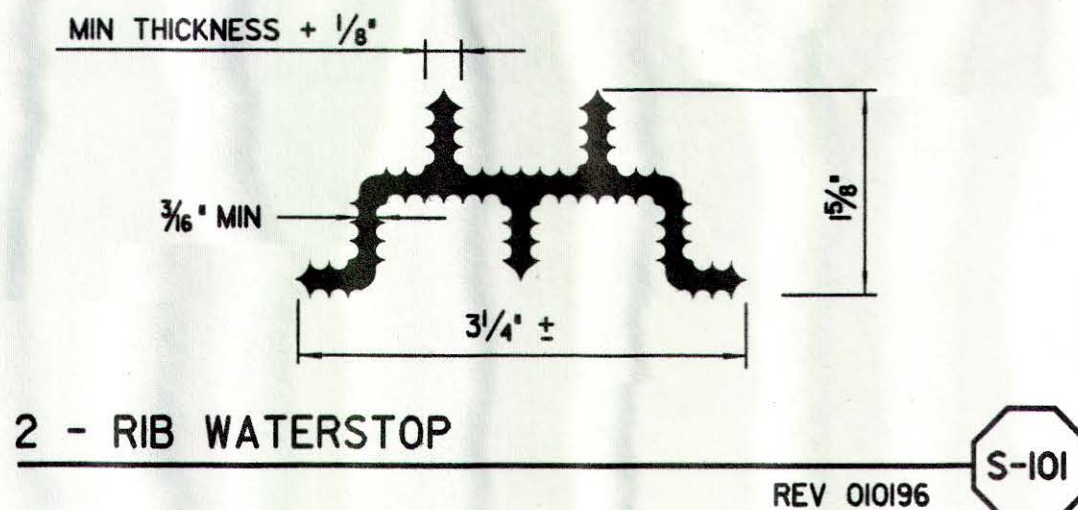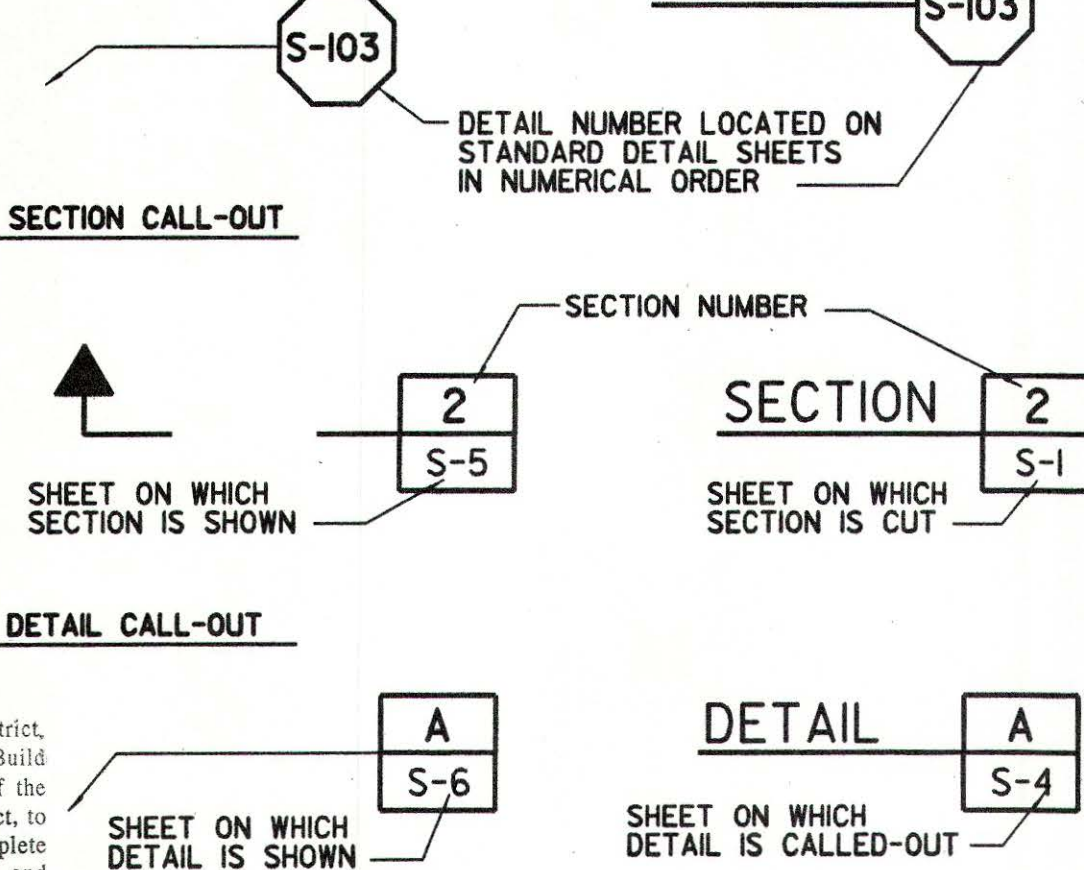

(TYP CONSTRUCTION JOINT UNLESS OTHERWISE NOTED)


WITH WATERSTOP AND SEALANT GROOVE S-110

NO WATERSTOP OR SEALANT GROOVE S-111




T	A
6"	2"
7"	2 1/2"
8"	2 1/2"

## NOTES

- IN ALL CONSTRUCTION JOINTS WITH WATERSTOPS, APPLY 2 COATS OF BOND BREAKER TO FACE OF JOINT, AVOID COATING WATERSTOP (AND SEALANT GROOVE WHERE USED)

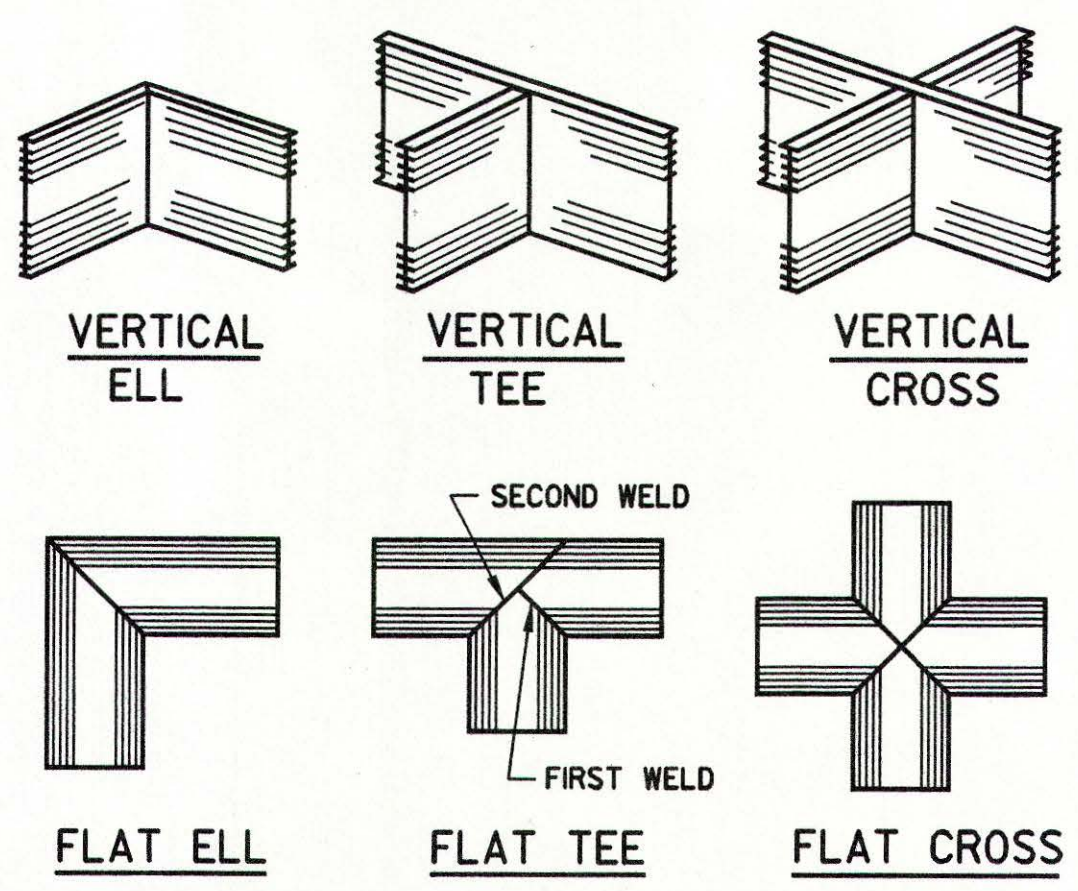

PREFABRICATED WATERSTOPS JOINTS S-108

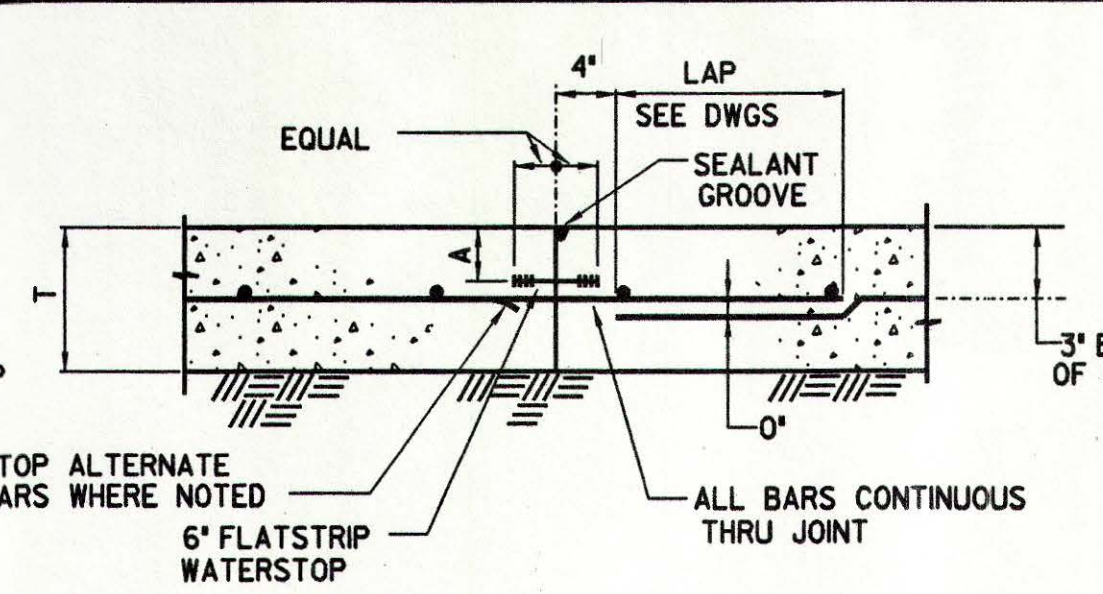
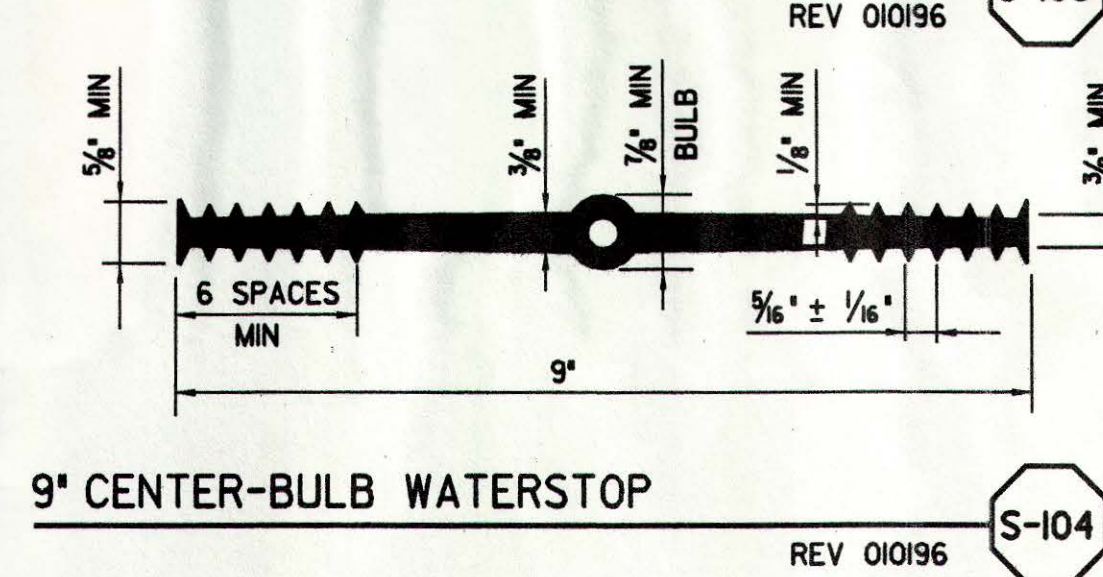
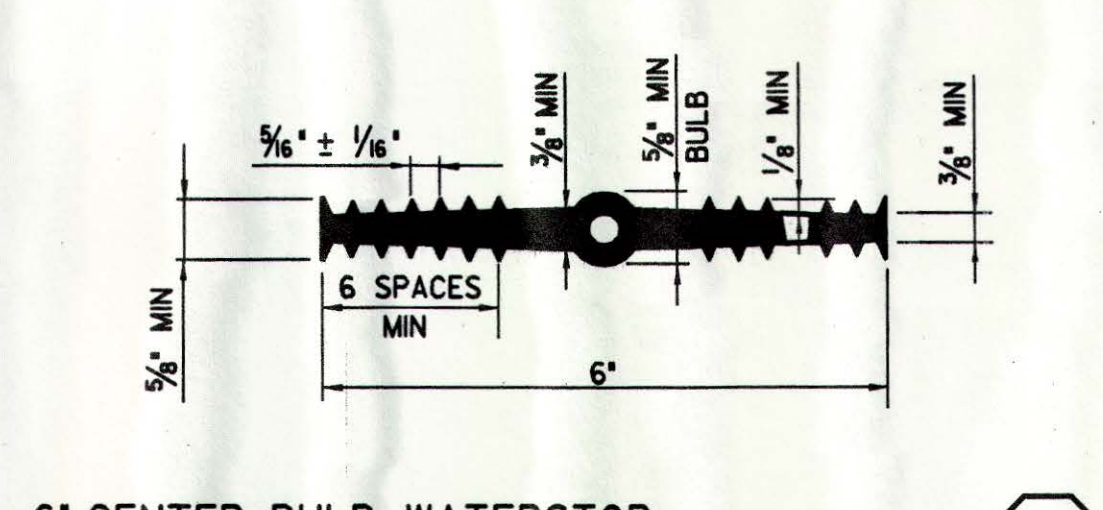


(ONLY WHEN SPECIFIED ON DRAWINGS)

WITH WATERSTOP AND SEALANT GROOVE S-112

NO WATERSTOP OR SEALANT GROOVE S-113

- WATERSTOPS AND SEALANT GROOVES TO BE PROVIDED IN ALL WATER RETAINING SLABS, SEE DRAWINGS, FOR OTHER LOCATIONS WHERE THEY MAY BE REQUIRED
- STAGGER SPLICES UNLESS NOTED OTHERWISE

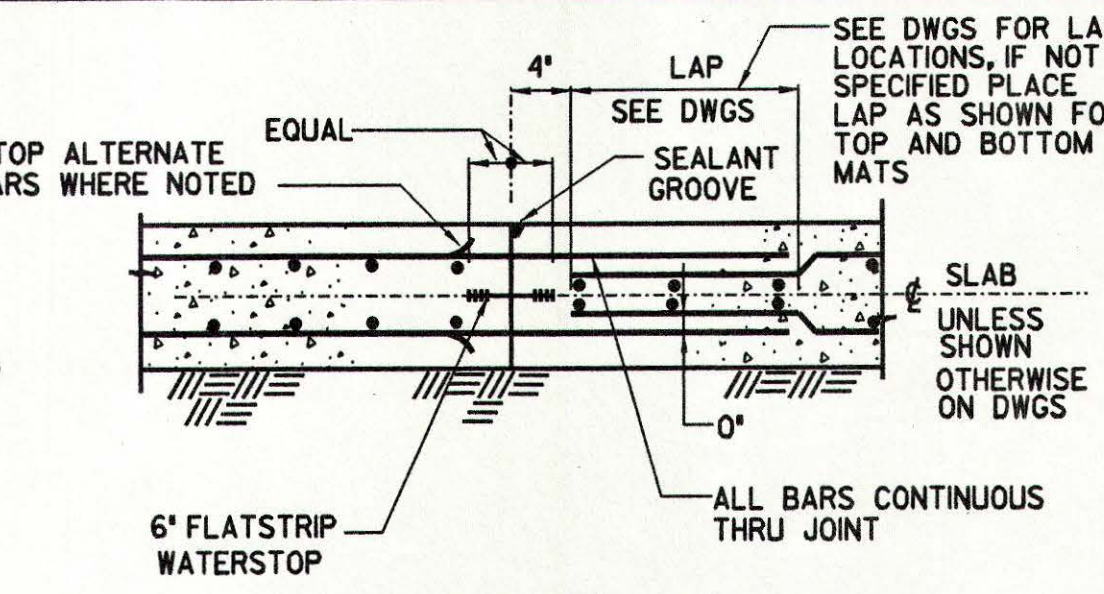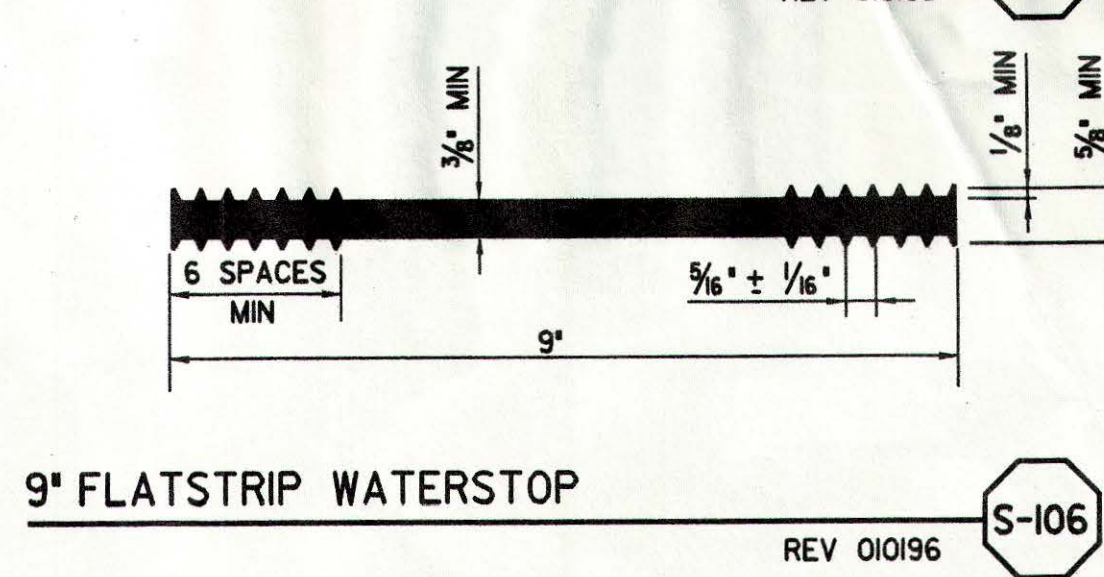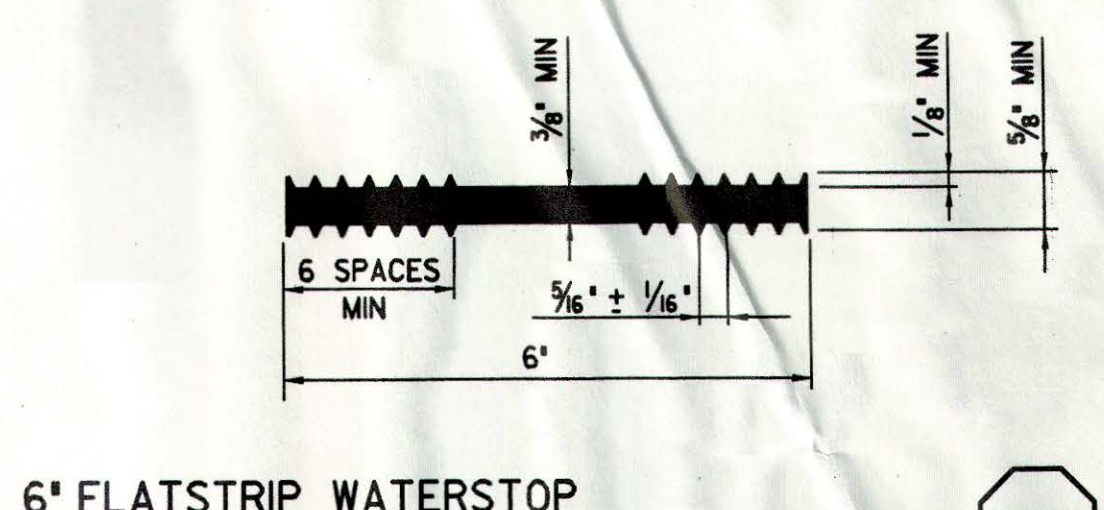


WITH WATERSTOP AND SEALANT GROOVE S-114


NO WATERSTOP OR SEALANT GROOVE S-115

## SLAB-ON-GRADE CONSTRUCTION JOINTS


REV 01/96

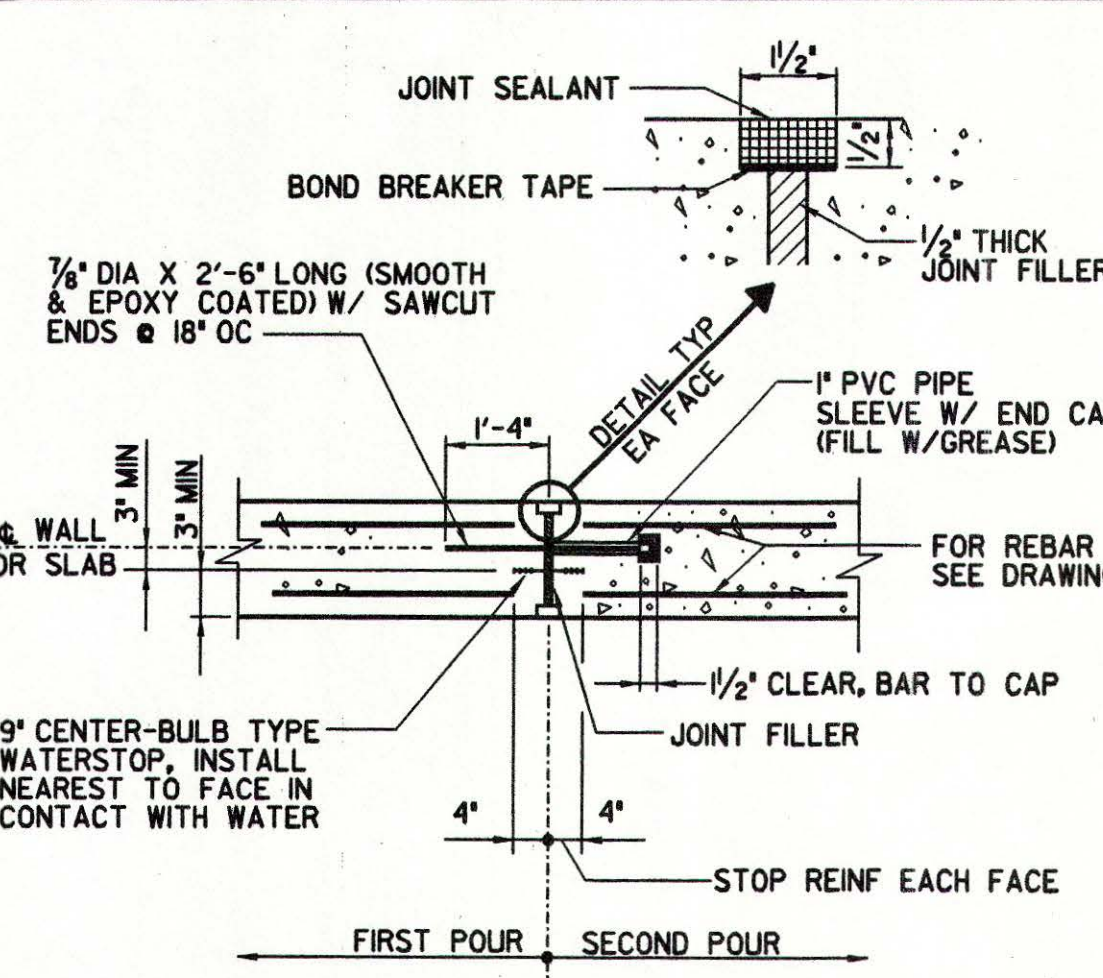



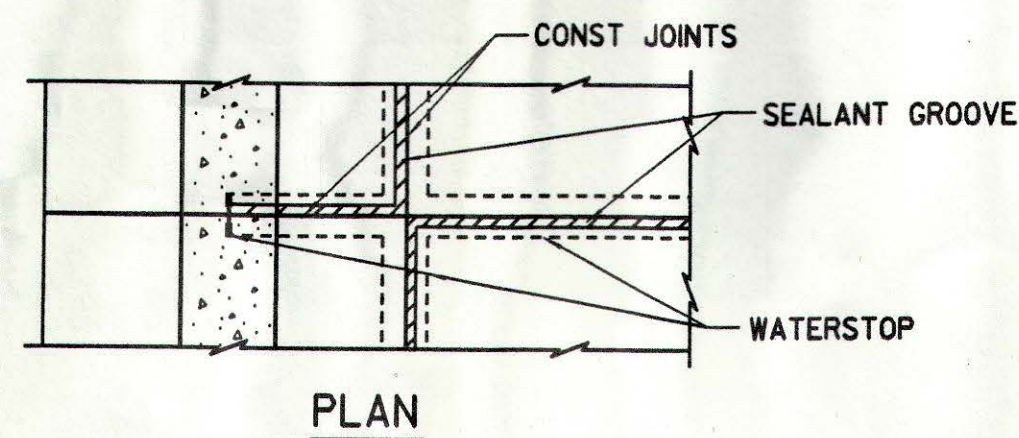


PLAN

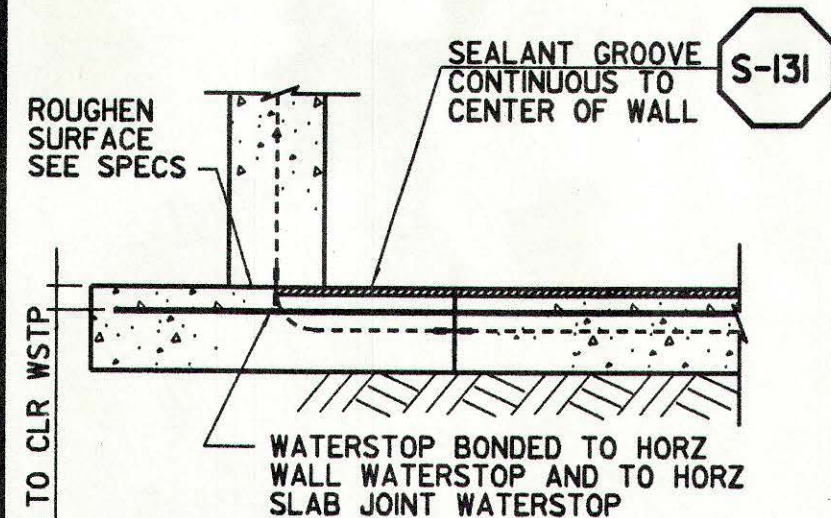

SECTION

NOTES:


1. SEALANT GROOVE SHALL BE CONTINUED UNDER WALL & SEALANT SHALL BOND WITH WALL WATERSTOP IN ALL CASES WHERE SUCH WATERSTOP OCCURS
2. SEALANT UNDER WALL SHALL BE IN PLACE PRIOR TO PLACEMENT OF CONCRETE FOR WALL
3. CONSTRUCTION JOINTS PASSING THROUGH VARIOUS MEMBERS OF A WATER RETAINING STRUCTURE SHALL BE SEALED WITH WATERSTOPS BONDED TOGETHER, SO AS TO PROVIDE A CONTINUOUS WATERTIGHT JOINT

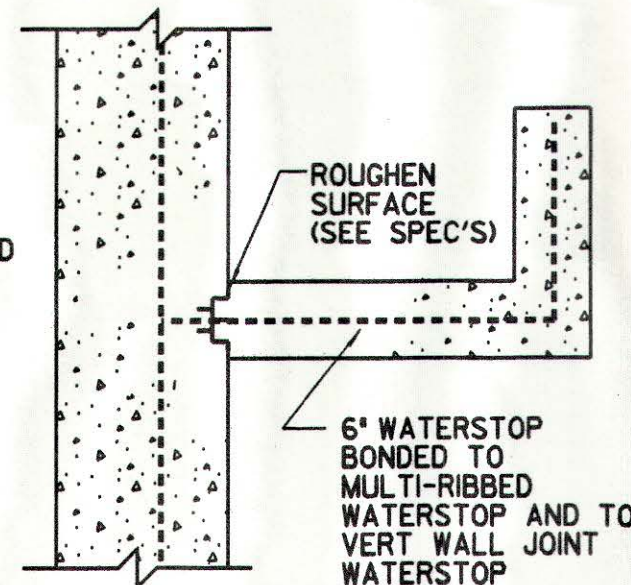

LAUNDER JOINT


CONSTRUCTION JOINT DETAILS  
WALL TO SLAB

REV 010196

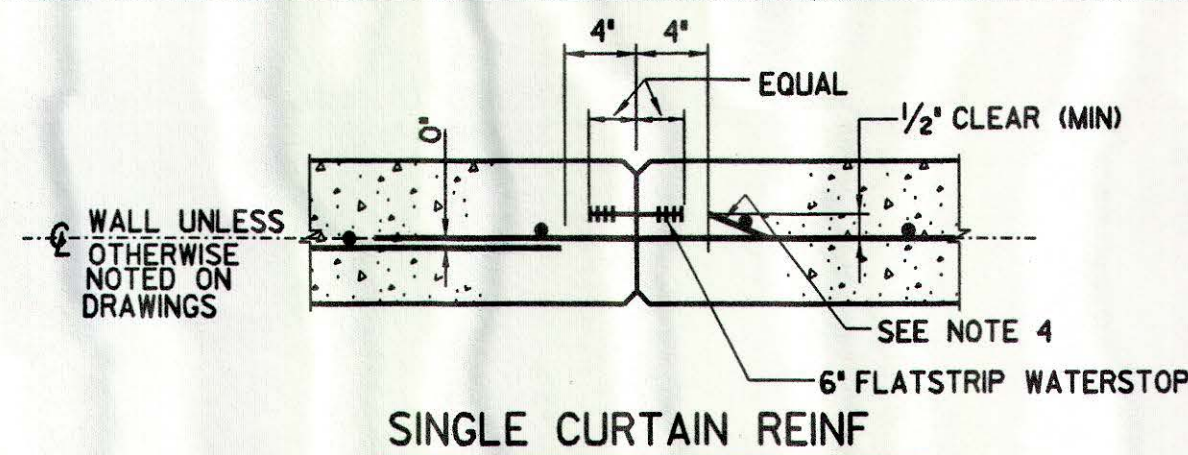


WITH WATERSTOP S-121

NO WATERSTOP S-122

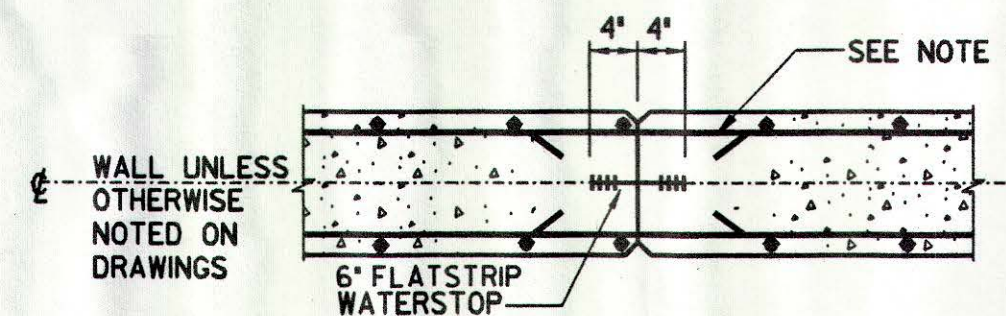

WITH WATERSTOP S-123

NO WATERSTOP S-124

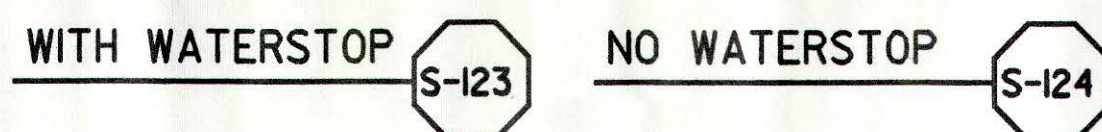

NOTES:

1. IN ALL WALL CONSTRUCTION JOINTS WITH WATERSTOPS APPLY 2 COATS OF BOND BREAKER TO FACE OF JOINT AVOID COATING WATERSTOP
2. WHERE WATERSTOP IS REQUIRED IN SINGLE CURTAIN WALL REINFORCEMENT PLACE WATERSTOP ON WATER SIDE OF WALL
3. UNLESS OTHERWISE NOTED 3/4\"/>


The limited review of this document by PBS & J on behalf of the Olivenhain Municipal Water District, is intended as a limited review only for general conformance with: (1) This approved Design/Build documents, (2) Accepted standards of practice within the industry, and (3) The standards of the Olivenhain Municipal Water District. This limited review in no way is intended, nor shall it act, to relieve the Design/Build Team of any professional liability to the responsibility to provide a complete and functional facility that is compliant with all applicable specifications, standards, codes, and regulations.

PBS & J


Date: 8/23/01 By: [Signature]

VERTICAL WALL CONSTRUCTION JOINT DETAILS

REV 010196

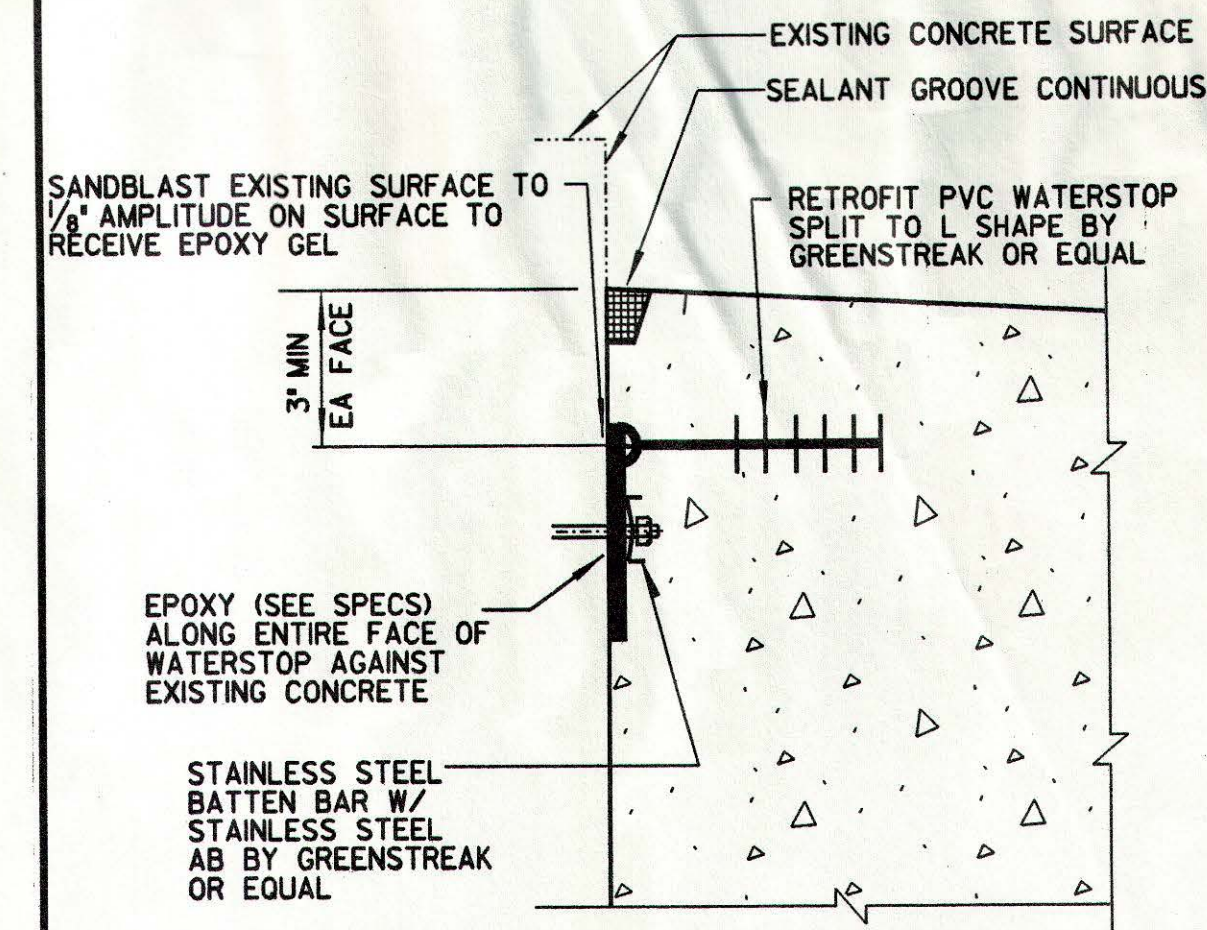


WATERSTOP AT EXISTING SURFACE

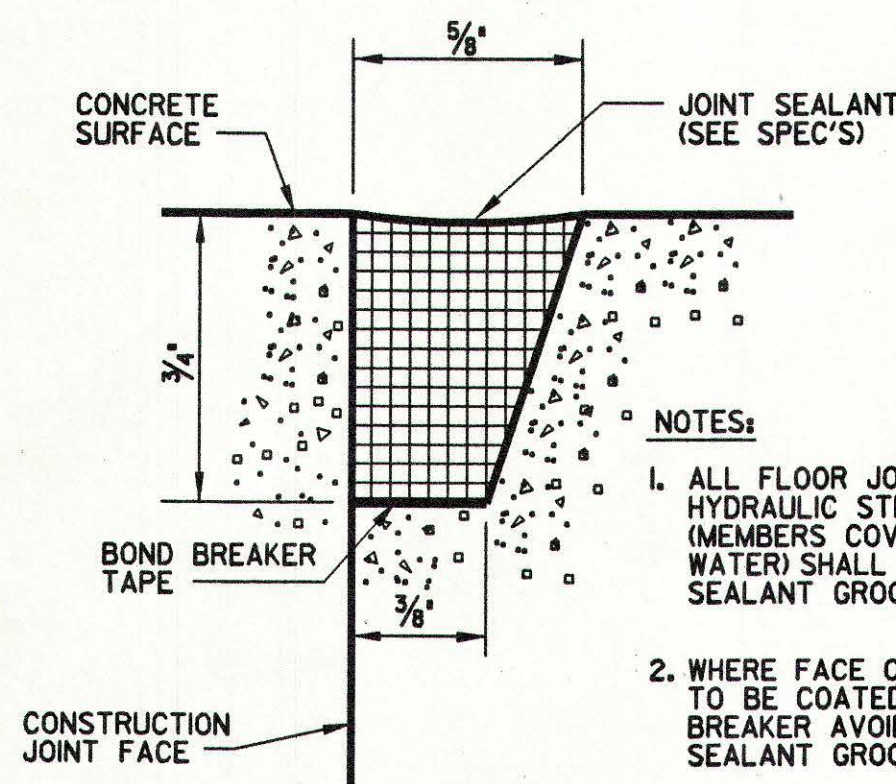


SEALANT GROOVE

REV 010196

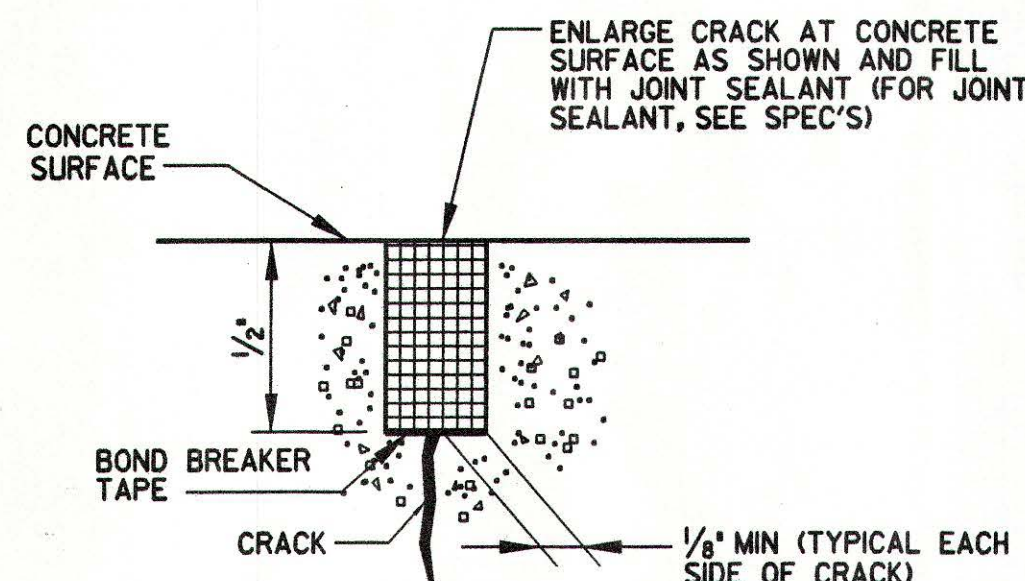


CONCRETE CRACK REPAIR

REV 010196

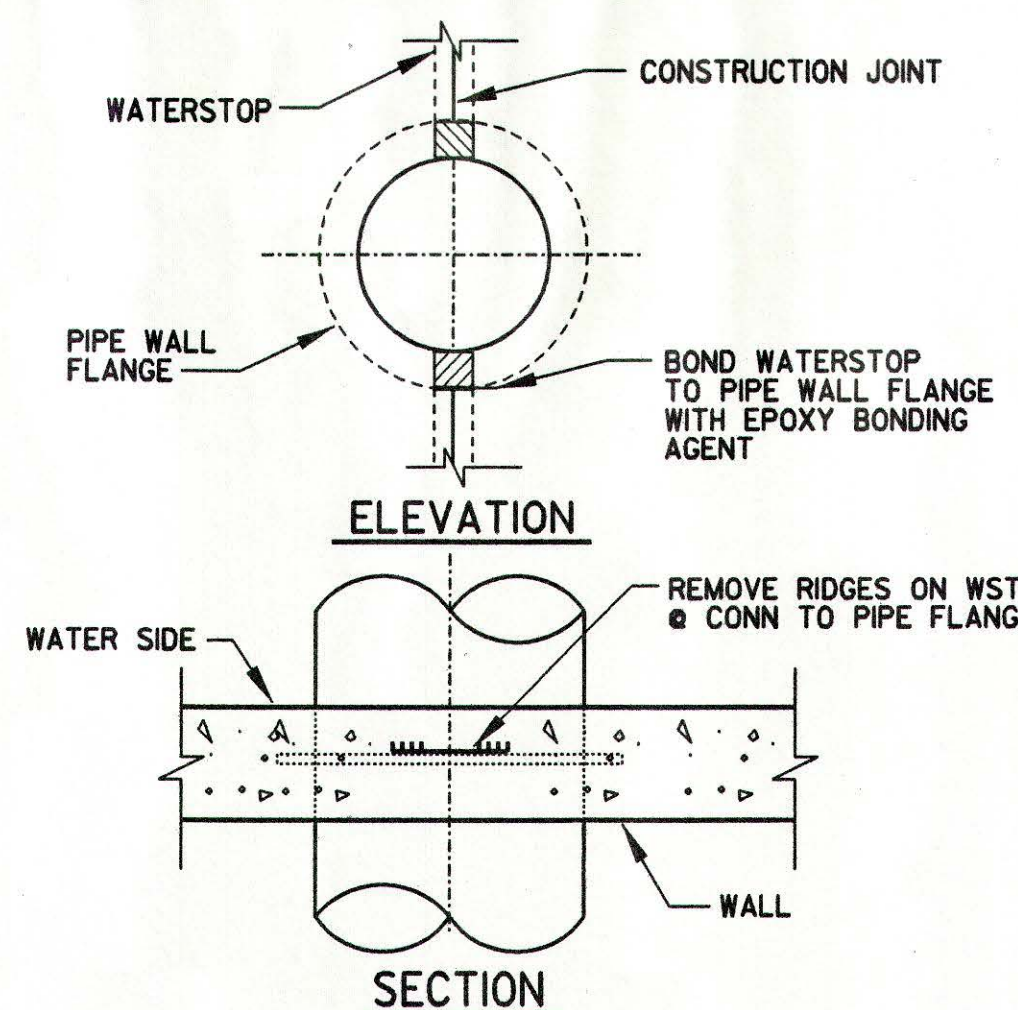


CONSTRUCTION JOINT DETAILS AT  
PIPE OPENINGS

REV 010196

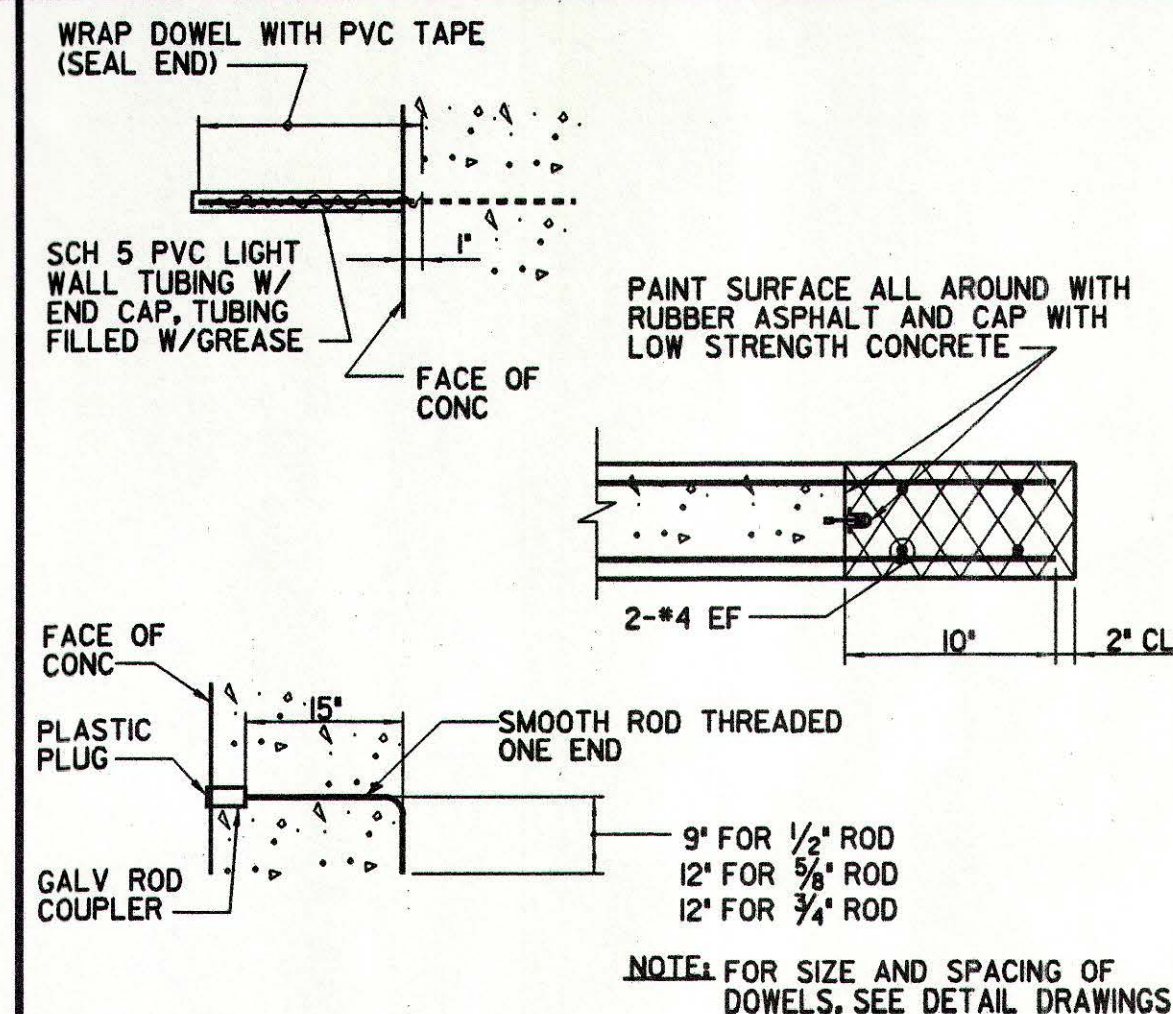


PROTECTION FOR EXPOSED DOWELS AND  
FUTURE BAR CONNECTIONS

REV 010196

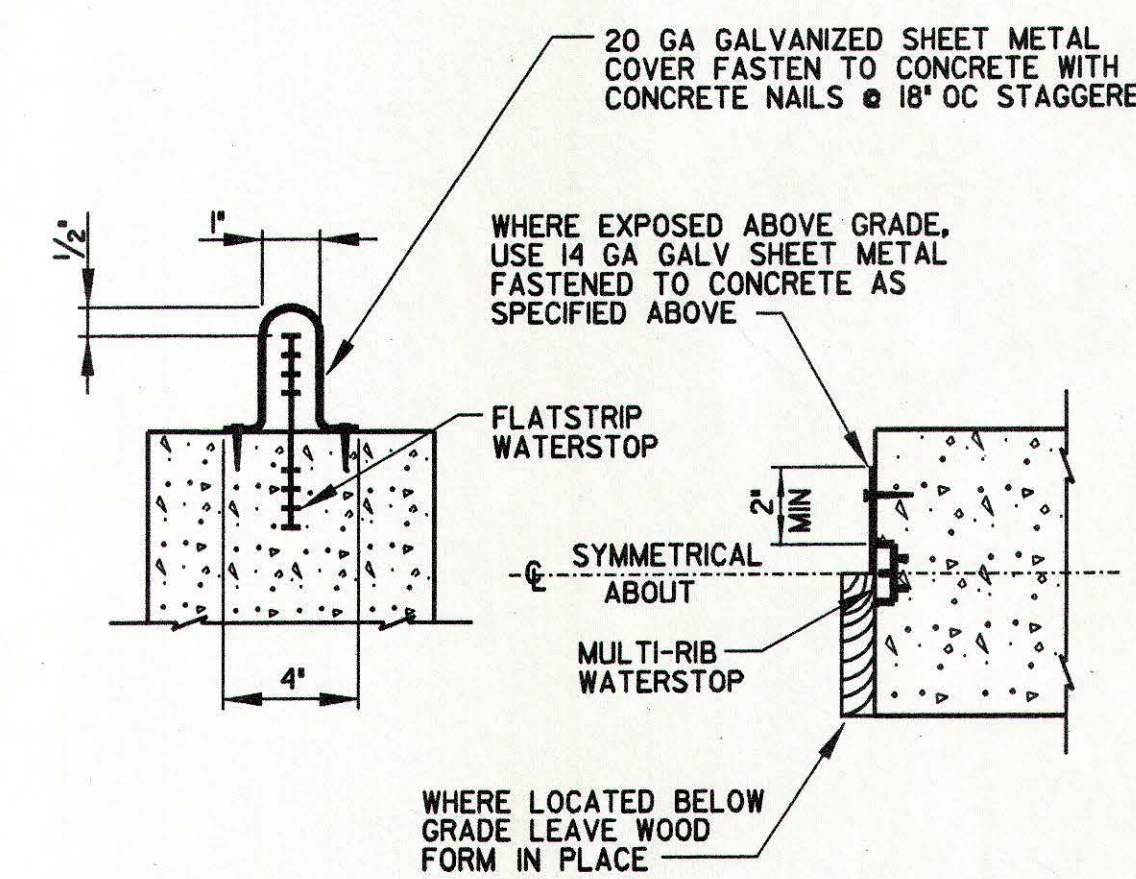


PROTECTIVE COVERS FOR EXPOSED  
WATERSTOPS

REV 010196

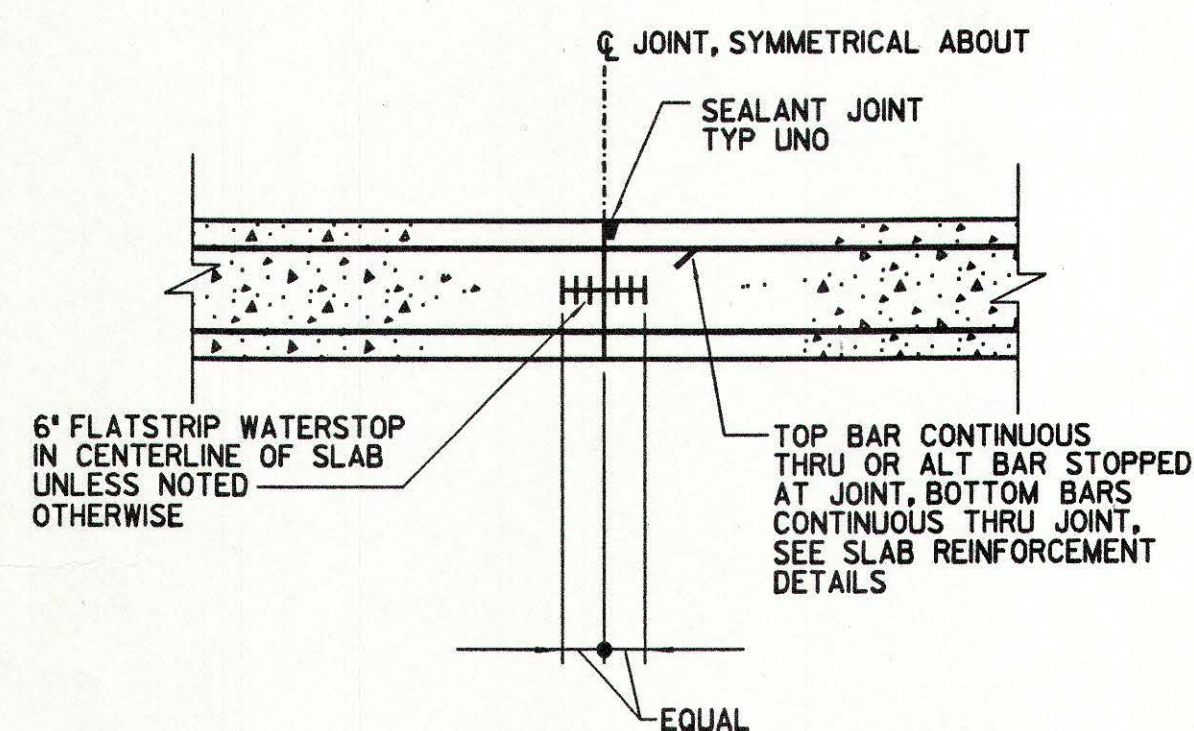



SUSPENDED SLAB CONSTRUCTION  
JOINT DETAIL

REV 010196

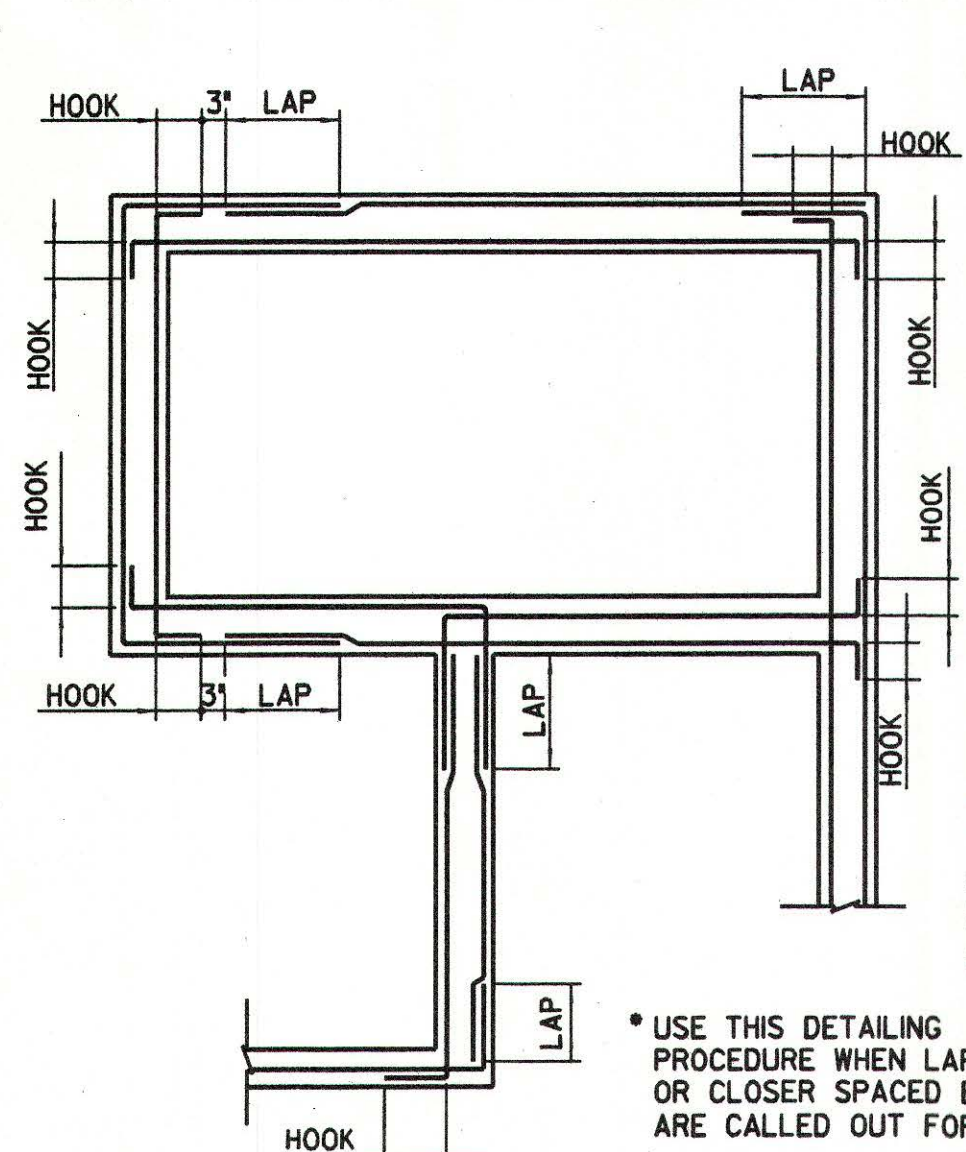

HORIZONTAL REINFORCEMENT AT  
WALL INTERSECTIONS

REV 010196

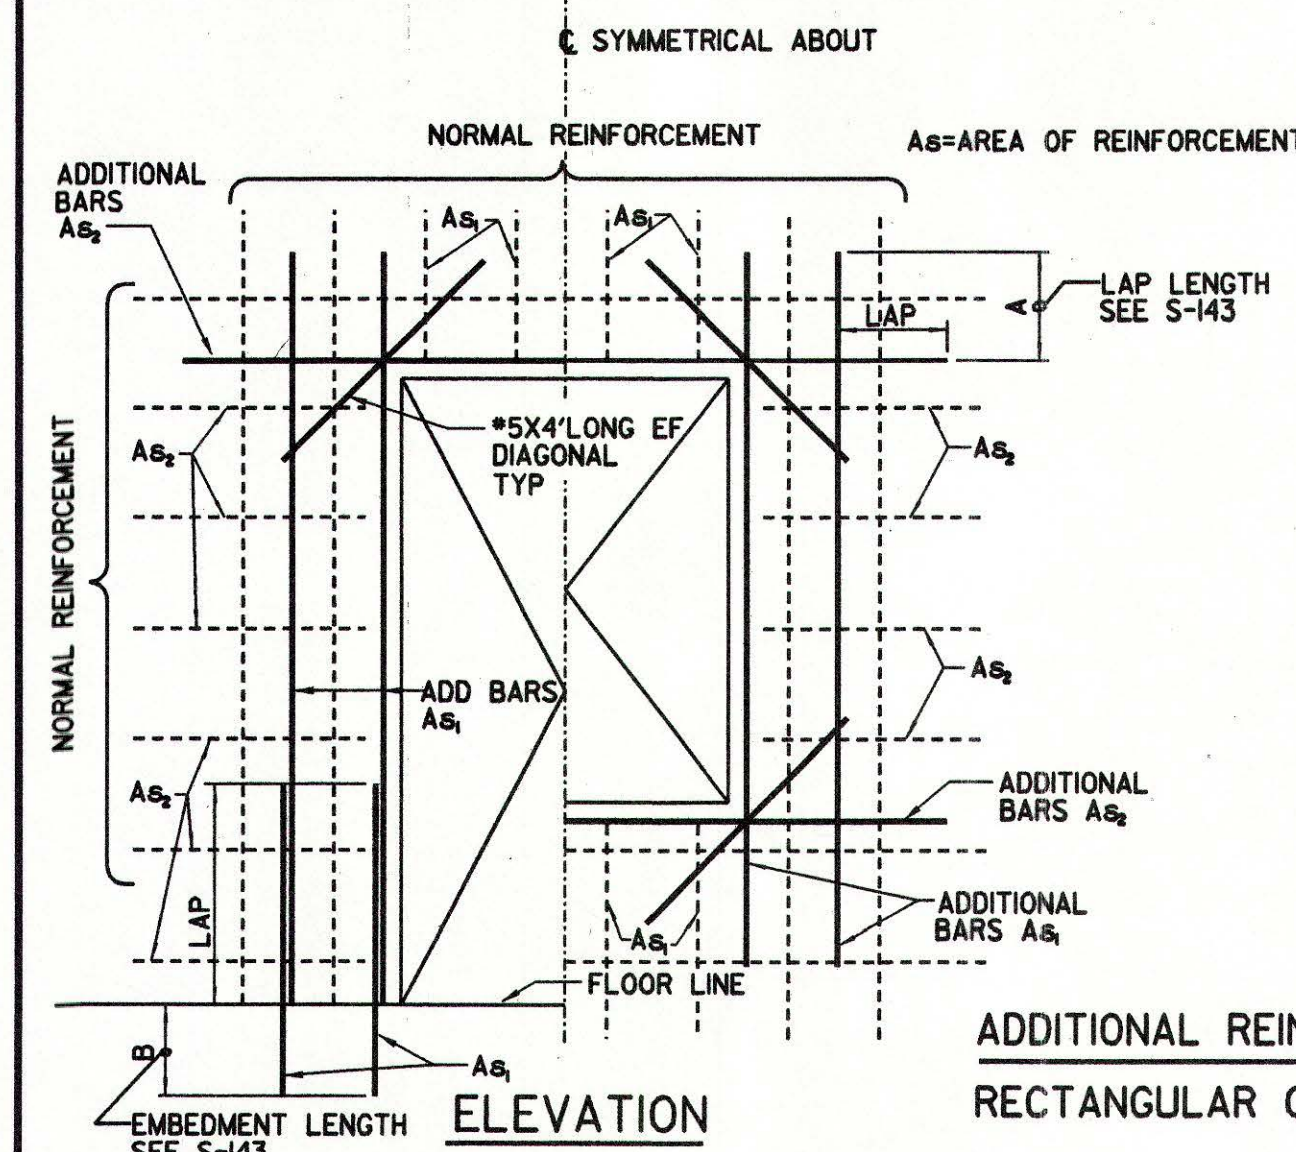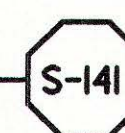



ADDITIONAL REINFORCEMENT AROUND  
RECTANGULAR OPENINGS

REV 010196



NOTES:

1. CUT NORMAL REINFORCEMENT AT OPENING:  
 $A_{s1}$  AND  $A_{s2}$  = 1/2 AREA OF CUT BARS TO BE ADDED ON EACH SIDE OF OPENING
2. ADDITIONAL BARS  $A_{s1}$  AND  $A_{s2}$  TO BE PLACED:  
A) AT CENTERLINE OF WALLS OR SLABS WHERE ONE LAYER OF REINFORCEMENT IS PROVIDED  
B) AT EACH FACE OF WALLS OR SLABS WHERE TWO LAYERS OF REINFORCEMENT ARE PROVIDED
3. INCREASE SIZE OF ADDITIONAL BARS AS NEEDED TO FIT WITHIN A DISTANCE OF 2 X WALL/SLAB THICKNESS FROM OPENING. PROVIDE 2\"/>

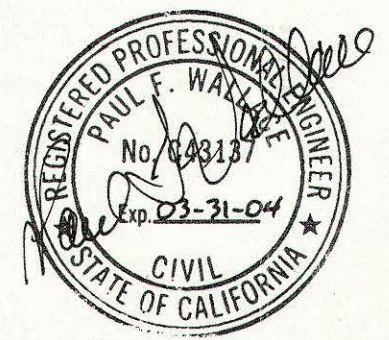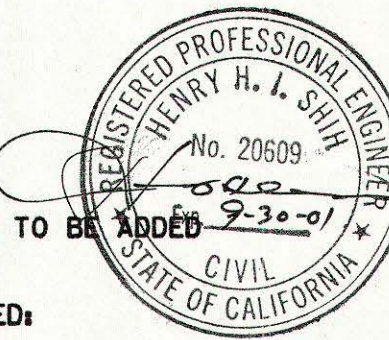

**MONTGOMERY WATSON**  
Pasadena, California

APPROVED  
[Signature]  
OLIVENHAIN MWD  
APPROVED  
FILANC CONSTRUCTION CO.

8.29.01  
DATE

KELWOOD DEVELOPMENT COMPANY  
45 RANCH SANITATION DISTRICT  
WASTEWATER TREATMENT PLANT EXPANSION TO 2.0 MGD


STANDARD DETAILS - I

SHEET

GS-2


OF 5 SHEETS



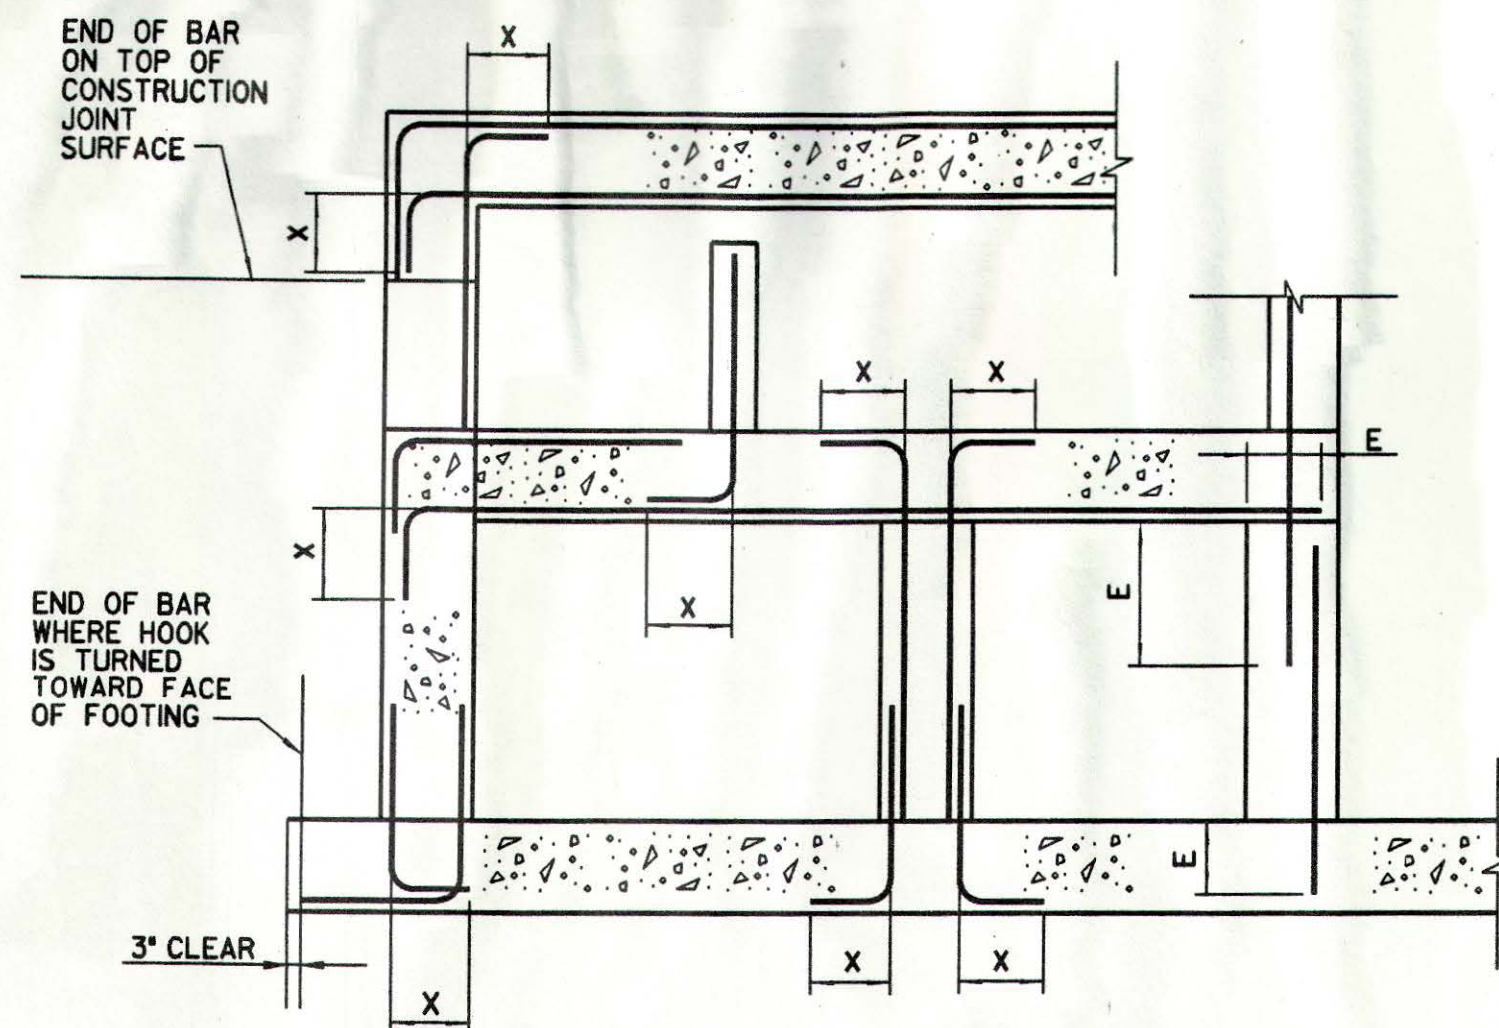

SECTION

LENGTH (INCHES)			
BAR SIZE	HOOK X	LAP	EMBEDMENT E
#3	6"	18"	12"
#4	8"	18"	14"
#5	10"	23"	18"
#6	12"	28"	22"
#7	14"	33"	25"
#8	16"	SEE TABLE BELOW	SEE TABLE BELOW
#9	19"		
#10	22"		
#11	24"		

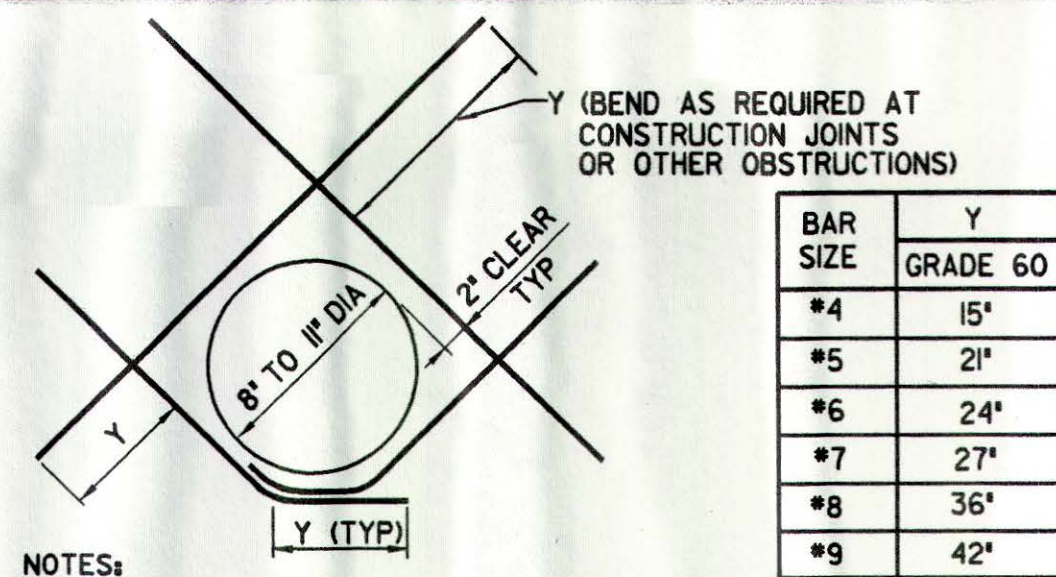



NOTES:

- CUT NORMAL REINFORCEMENT 2' CLEAR OF OPENING
- DIAGONAL BARS TO BE PLACED:
  - AT CENTERLINE OF WALL OR SLAB WHERE ONE LAYER OF REINFORCEMENT IS PROVIDED
  - AT EACH FACE OF WALL OR SLAB WHERE TWO LAYERS OF REINFORCEMENT ARE PROVIDED
- UNLESS OTHERWISE NOTED, SIZE OF DIAGONAL BARS SHALL BE THE SIZE OF THE LARGEST NORMAL REINFORCING BAR CUT
- THIS DETAIL TO BE USED ONLY WHEN CALLED FOR ON THE DRAWINGS OR WHEN NO OTHER DETAIL IS SPECIFIED

DIAGONAL REINFORCEMENT AT CIRCULAR

OPENINGS (8" - 11" DIA)

REV 010196

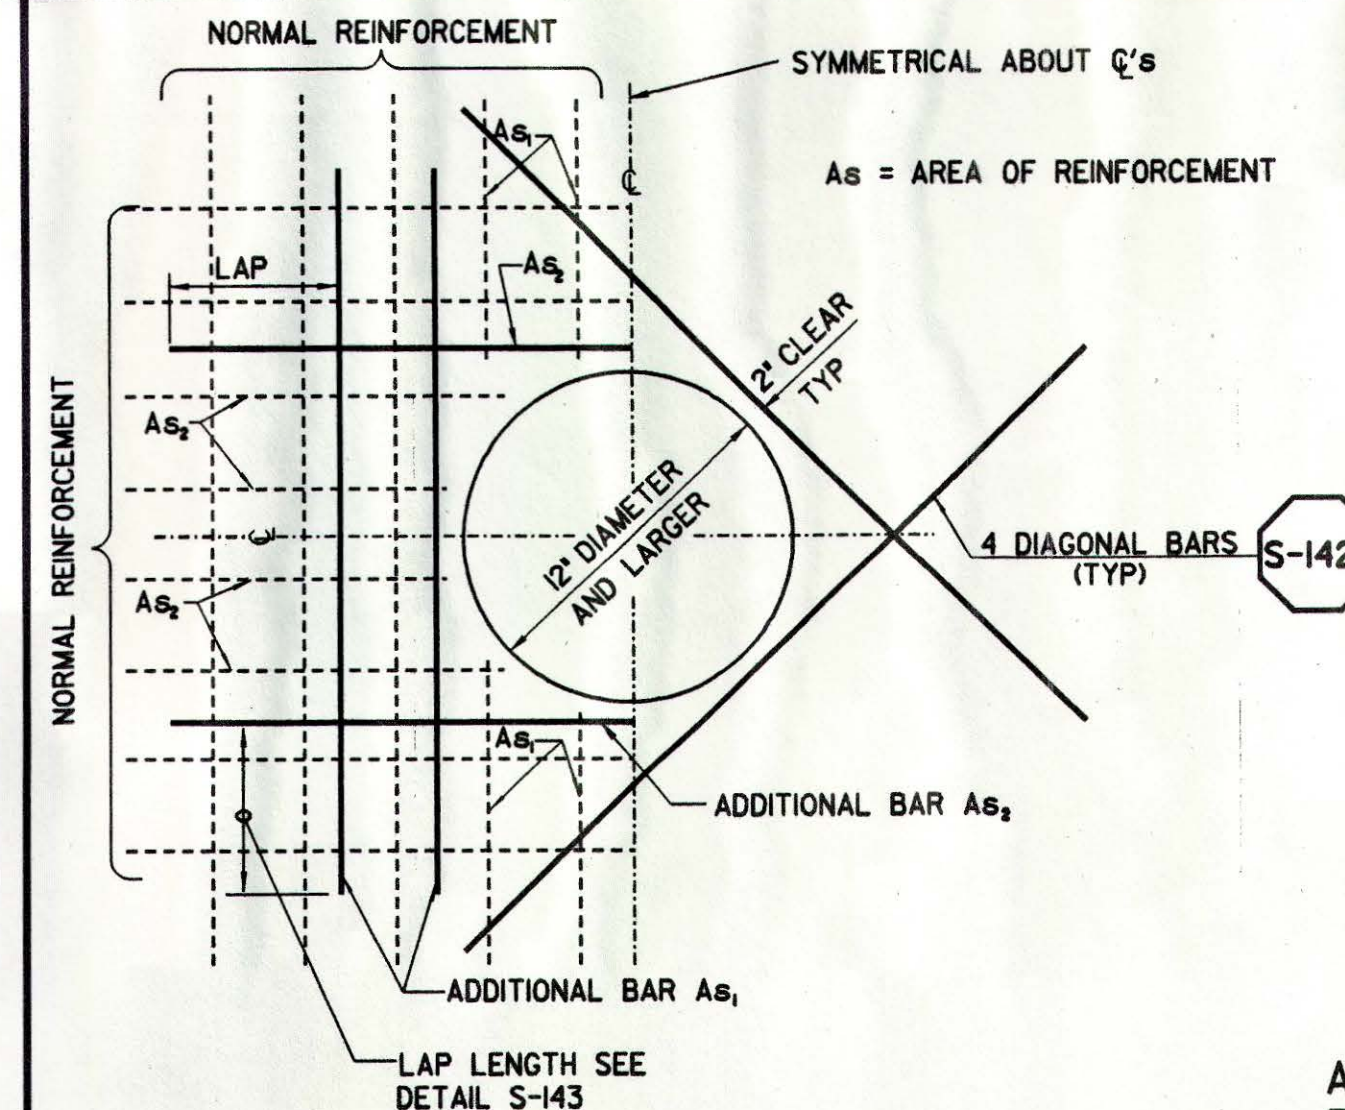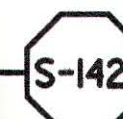


NOTES:

- CUT NORMAL REINFORCEMENT AT OPENINGS:  
 $AS_1$  AND  $AS_2 = \frac{1}{2}$  AREA OF CUT BARS TO BE ADDED ON EACH SIDE OF OPENING
- ADDITIONAL BARS  $AS_1$  AND  $AS_2$  TO BE PLACED:
  - AT CENTERLINE OF WALLS OR SLABS WHERE ONE LAYER OF REINFORCEMENT IS PROVIDED
  - AT EACH FACE OF WALLS OR SLABS WHERE TWO LAYERS OF REINFORCEMENT ARE PROVIDED
- INCREASE SIZE OF ADDITIONAL BARS AS NEEDED TO FIT WITHIN A DISTANCE OF 2 X WALL/SLAB THICKNESS FROM OPENING, PROVIDE 2" MIN CLEAR BETWEEN BARS
- THIS DETAIL TO BE USED ONLY WHEN NO OTHER DETAIL IS INDICATED ON THE DRAWINGS
- WHERE A SLAB OR INTERSECTING WALL CONNECTS WITHIN ONE WALL THICKNESS OF THE OPENING, ADDITIONAL BARS ON THAT SIDE MAY BE OMITTED

ADDITIONAL REINFORCEMENT AT CIRCULAR

OPENINGS (12" DIA OR LARGER)

REV 010196

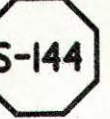

LENGTH (INCHES)					
REBAR SIZE	FOR 1" TO < 2" CONCRETE COVER REBAR SPACING (CENTER TO CENTER)		FOR 2" TO < 3" CONCRETE COVER REBAR SPACING (CENTER TO CENTER)		FOR 3" AND LARGER CONCRETE COVER REBAR SPACING (CENTER TO CENTER)
	< 8"	≥ 8"	< 8"	≥ 8"	< 8"
LAP					
#8	62"	62"	37"	37"	37"
#9	99"	79"	69"	55"	49"
#10	125"	100"	88"	70"	63"
#11	154"	123"	108"	86"	77"
EMBEDMENT E					
#8	48"	48"	29"	29"	29"
#9	77"	61"	54"	43"	38"
#10	97"	77"	68"	54"	49"
#11	119"	95"	84"	67"	60"



NOTES:

- USE LAP LENGTHS AS DETERMINED FROM THESE TABLES UNLESS SHOWN OTHERWISE
- THE TABLES SHOWN ARE FOR  $f'c=4000$  PSI AND  $f_y=60,000$  PSI
- MULTIPLY THE LAP & E SHOWN IN THESE TABLES BY 1.3 FOR WALL HORIZONTAL REBARS AND SLAB BARS WITH 12" OR MORE FRESH CONCRETE UNDERNEATH
- WHEN BARS OF DIFFERENT SIZE ARE LAP SPICED, LAP LENGTH SHALL BE THE LARGER OF:  
EMBEDMENT LENGTH OF LARGER BAR  
LAP LENGTH OF SMALLER BAR
- UNLESS NOTED OTHERWISE USE REBAR COUPLERS FOR SPLICES OF #11 AND LARGER BARS
- ALL DOWEL BARS SHALL EXTEND AN EMBEDMENT LENGTH E INTO ANOTHER MEMBER OR ACROSS A CONSTRUCTION JOINT UNLESS SHOWN TO SPLICE WITH OTHER BARS OR TO EXTEND TO THE FAR FACE OF THE MEMBER AND END WITH A STANDARD HOOK

STANDARD 90° BAR HOOKS, EMBEDMENT

LENGTHS AND LAP LENGTHS



REV 010196

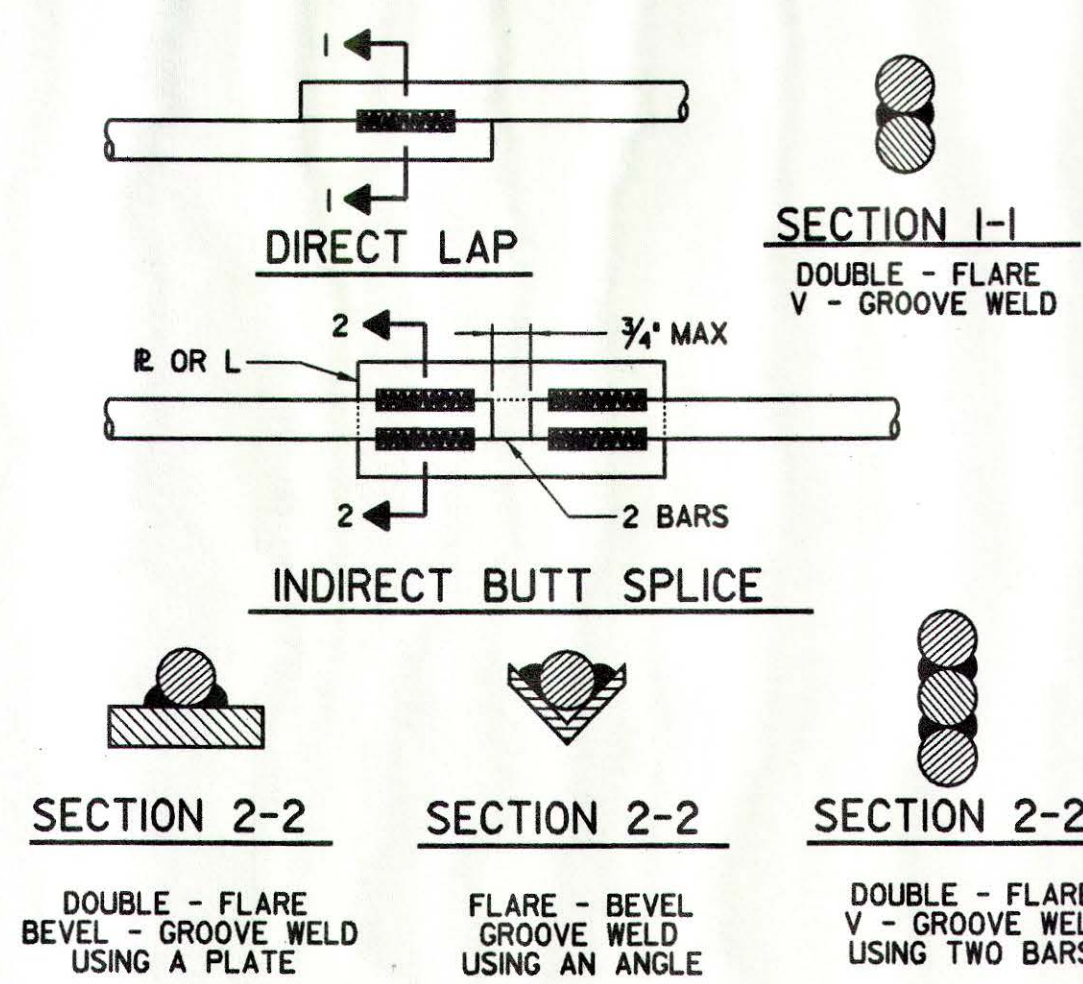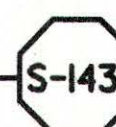

WELDED SPLICES FOR REINFORCING BARS

(\*6 AND SMALLER)

REV 010196

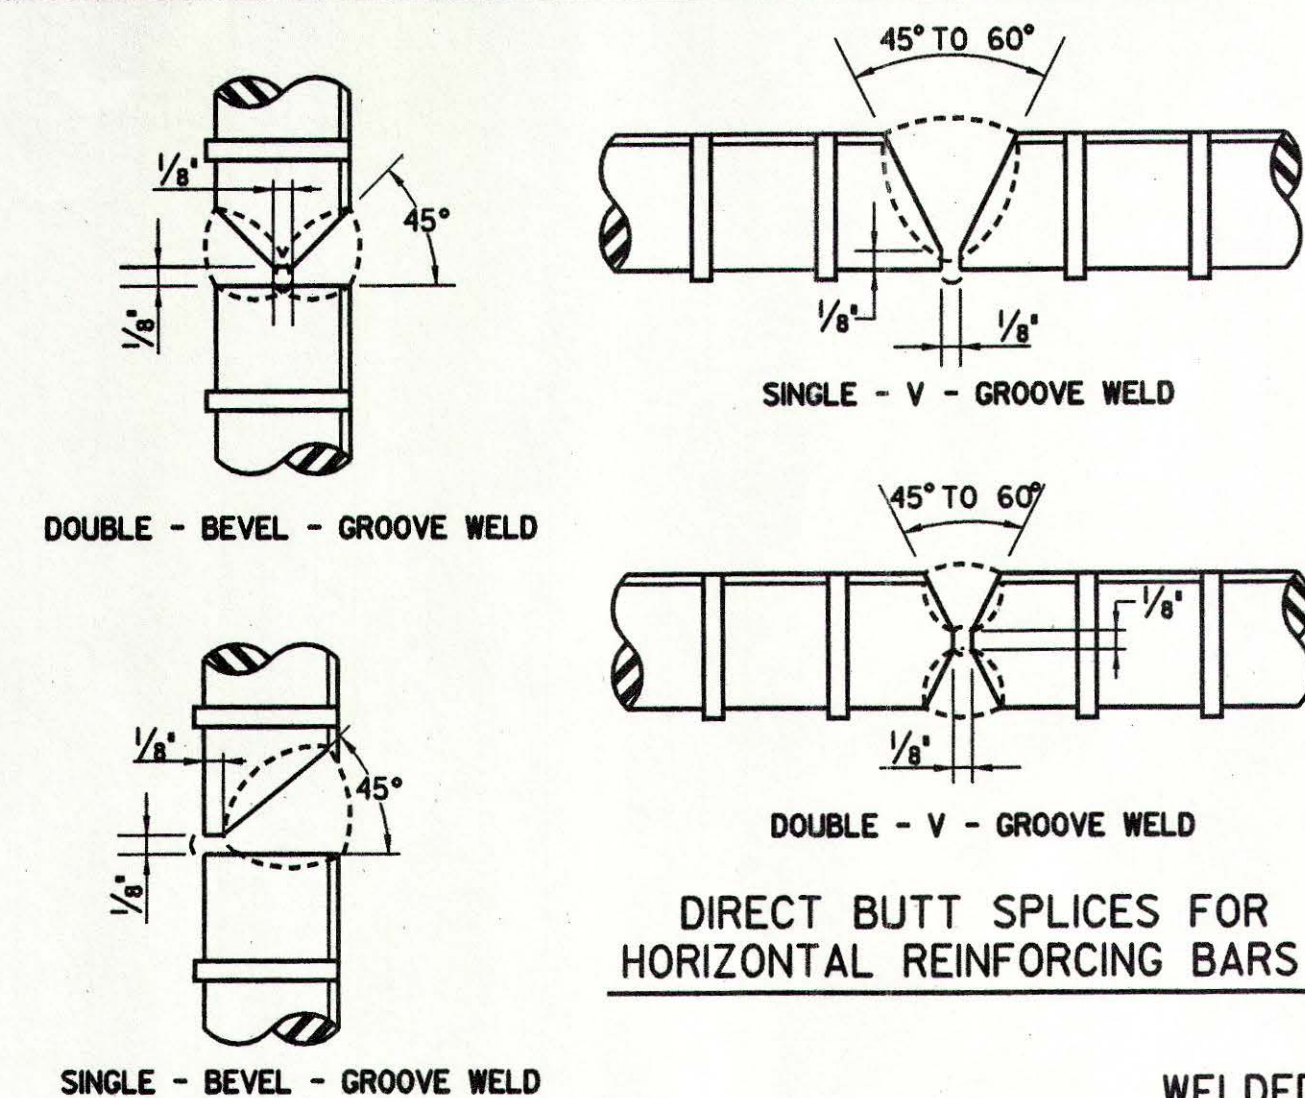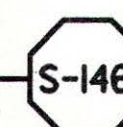


NOTES:

- SPLICES SHALL BE WELDED PER UBC STD. NO. 19-2, AWS D1.4 AND MEET THE REQUIREMENTS OF ACI 308 SECTION 12.4.3.
- SURFACES DO NOT HAVE TO BE SQUARE CUT. BEVELS CAN BE CUT WITH A TORCH.
- CHIP OR GRIND ROOT TO SOUND METAL BEFORE WELDING SECOND SIDE.
- BARS MUST BE PLUMB AND PRECISELY LOCATED IN ORDER TO BE PROPERLY WELDED.
- WRAP BARS WITH INSULATING MATERIAL AFTER WELDING IS COMPLETED TO ALLOW SLOW COOLING.
- BACKING IS REQUIRED FOR SINGLE - V - GROOVE AND SINGLE - BEVEL - GROOVE WELDS FOR #8 AND #7 BARS.

WELDED SPLICES FOR REINFORCING BARS



(\*7 AND LARGER)

REV 010196

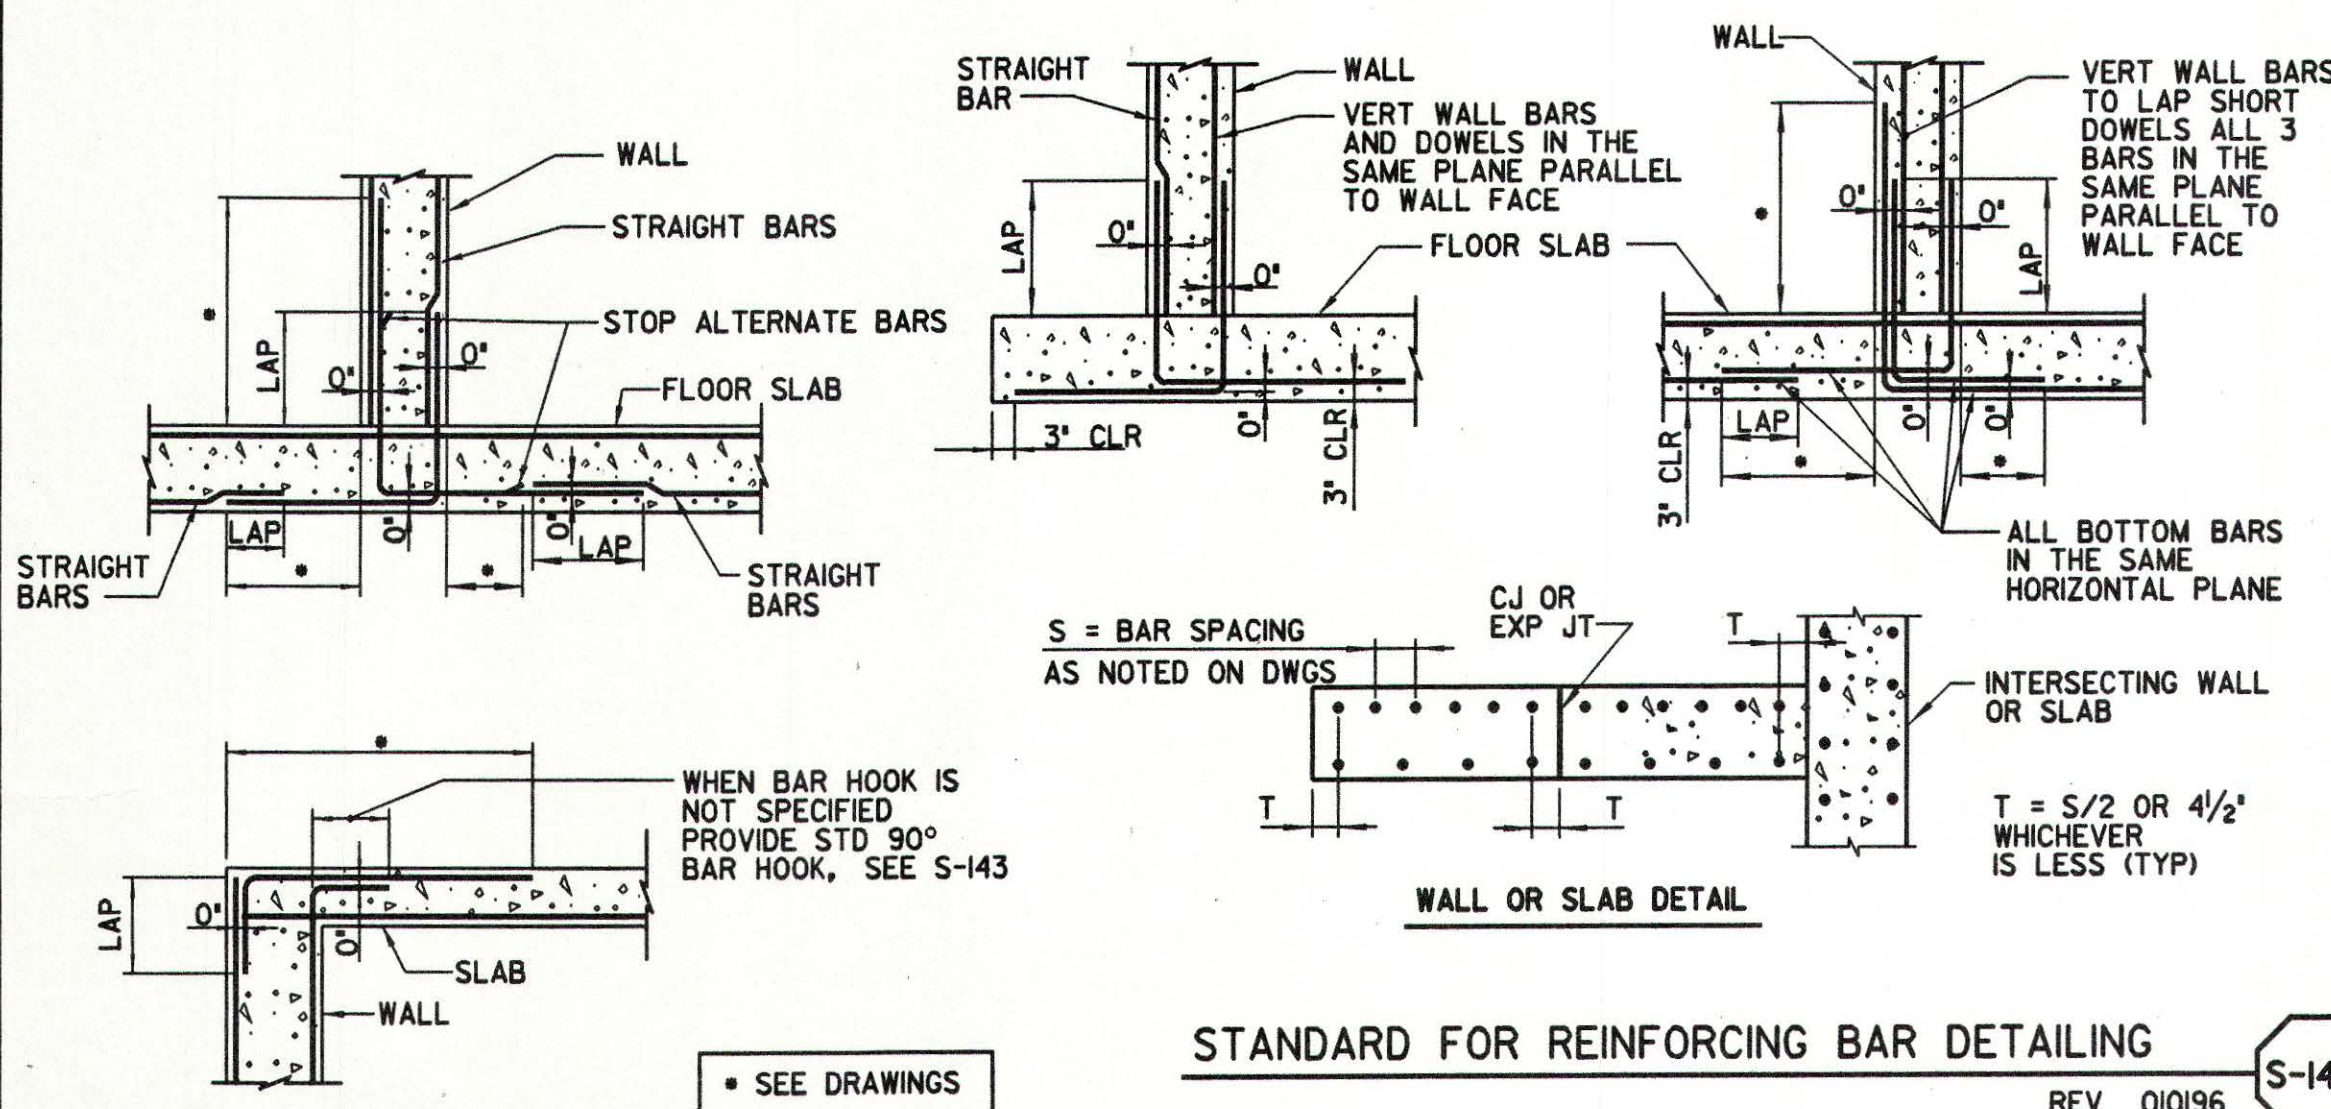

STANDARD FOR REINFORCING BAR DETAILING

REV 010196

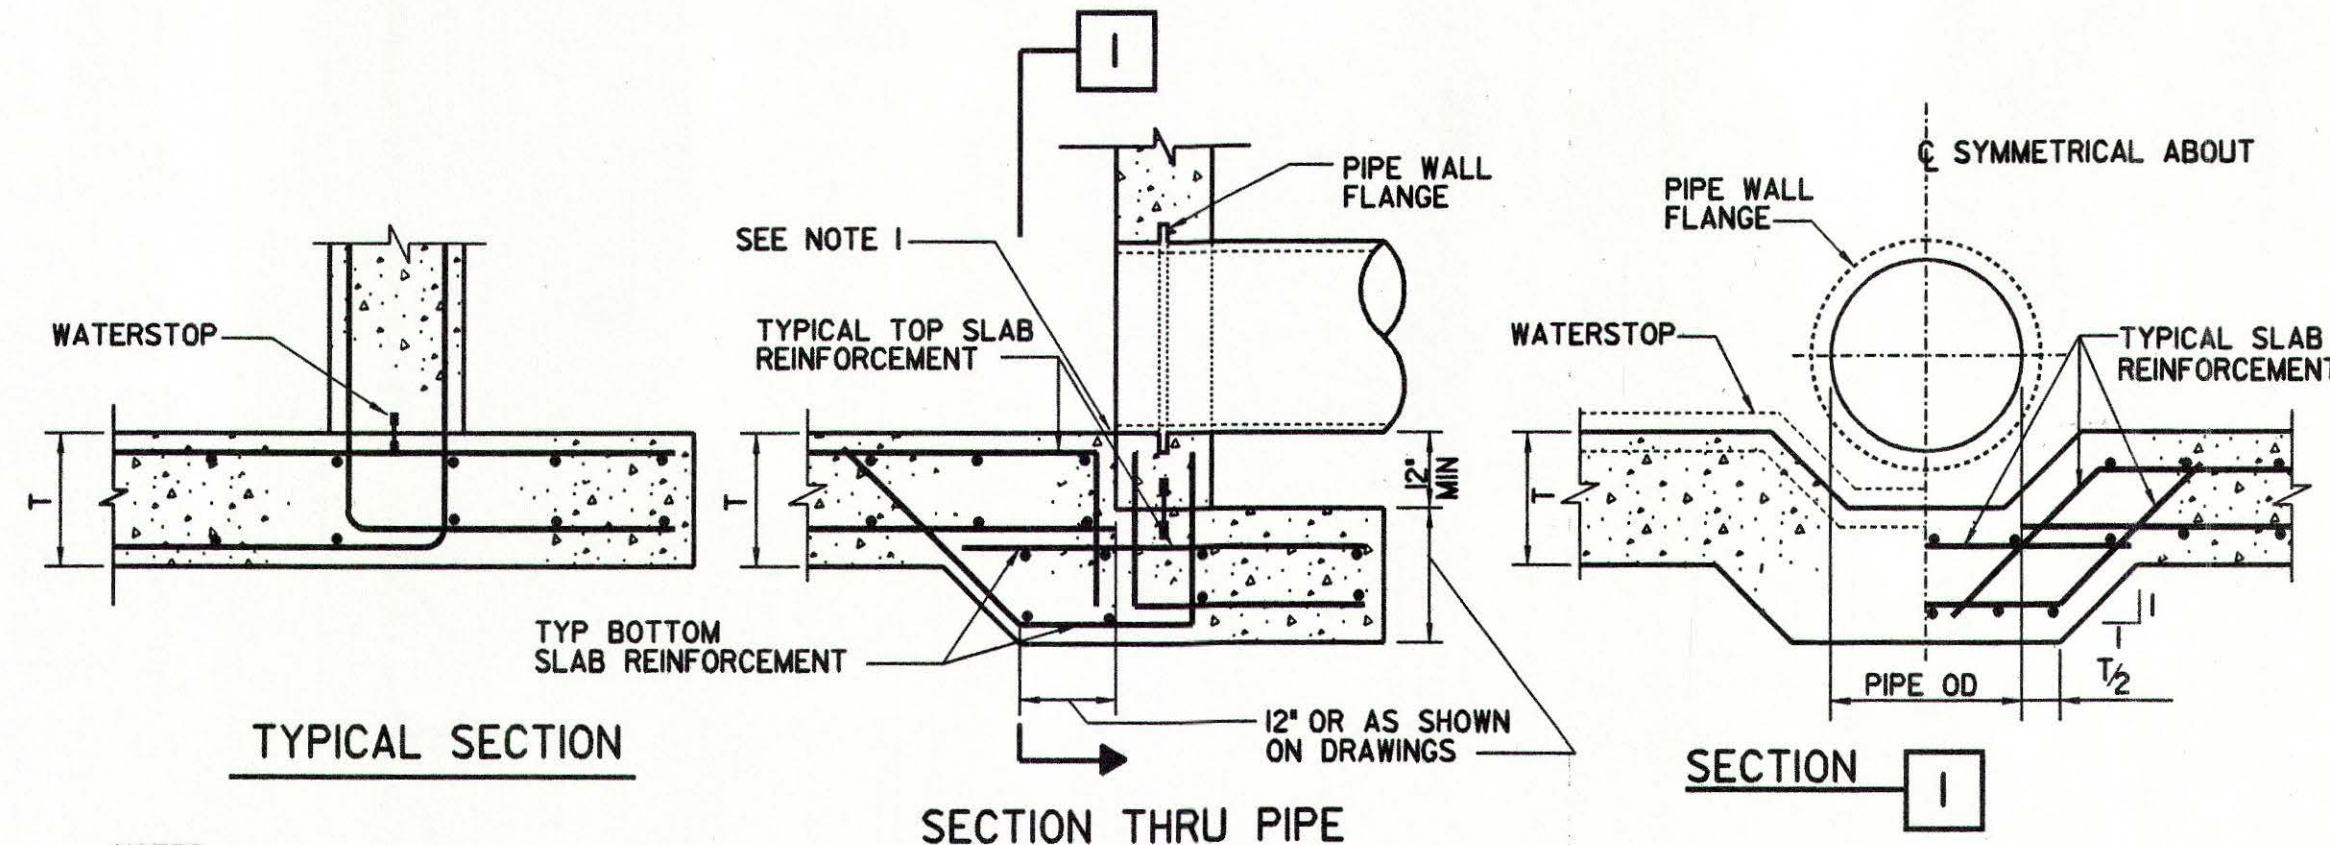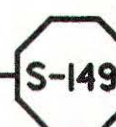


NOTES:

- SET PIPE INVERT FLUSH WITH SLAB
- DETAIL IS SIMILAR FOR RCP

FOOTING DETAIL AT WALL  
PIPE CONNECTION

REV 010196

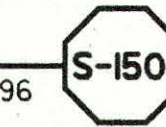

The limited review of this document by PBS & J on behalf of the Olivenhain Municipal Water District, is intended as a limited review only for general conformance with: (1) This approved Design/Build documents, (2) Accepted standards of practice within the industry, and (3) The standards of the Olivenhain Municipal Water District. This limited review in no way is intended, nor shall it act, to relieve the Design/Build Team of any professional liability to the responsibility to provide a complete and functional facility that is compliant with all applicable specifications, standards, codes, and regulations.

PBS & J

Date: 8/23/01 By: [Signature]



**MONTGOMERY WATSON**  
Pasadena, California

APPROVED  
George R. Bunt  
OLIVENHAIN MWD  
APPROVED  
FILANC CONSTRUCTION CO.  
DATE

8.29.01

DATE

KELWOOD DEVELOPMENT COMPANY  
45 RANCH SANITATION DISTRICT  
WASTEWATER TREATMENT PLANT EXPANSION TO 2.0 MGD


STANDARD DETAILS - II

SHEET

GS-3


OF • SHEETS



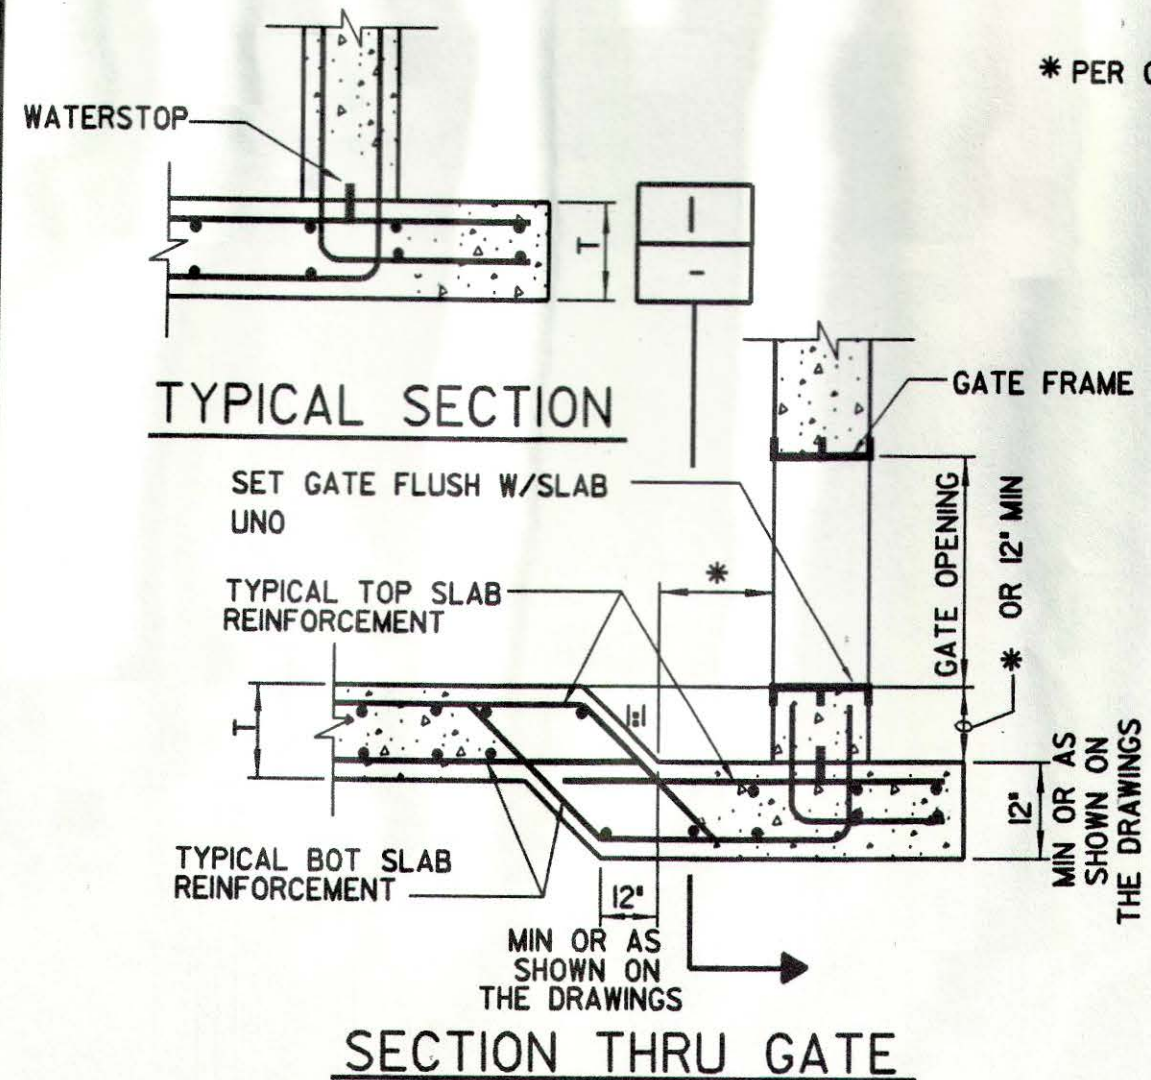

\* PER GATE REQUIREMENTS


SYMMETRICAL ABOUT

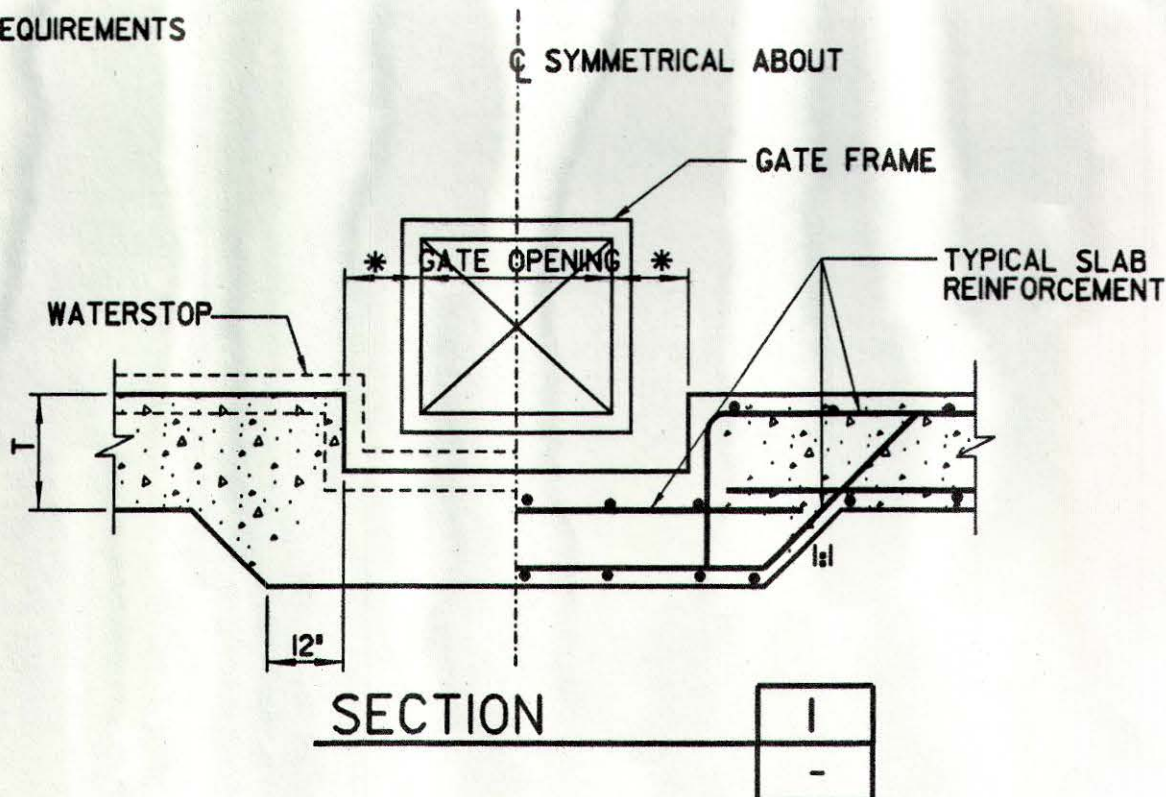

FLOOR SLAB POCKET FOR SLUICE GATE INSTALLATION

REV 010196


S-151

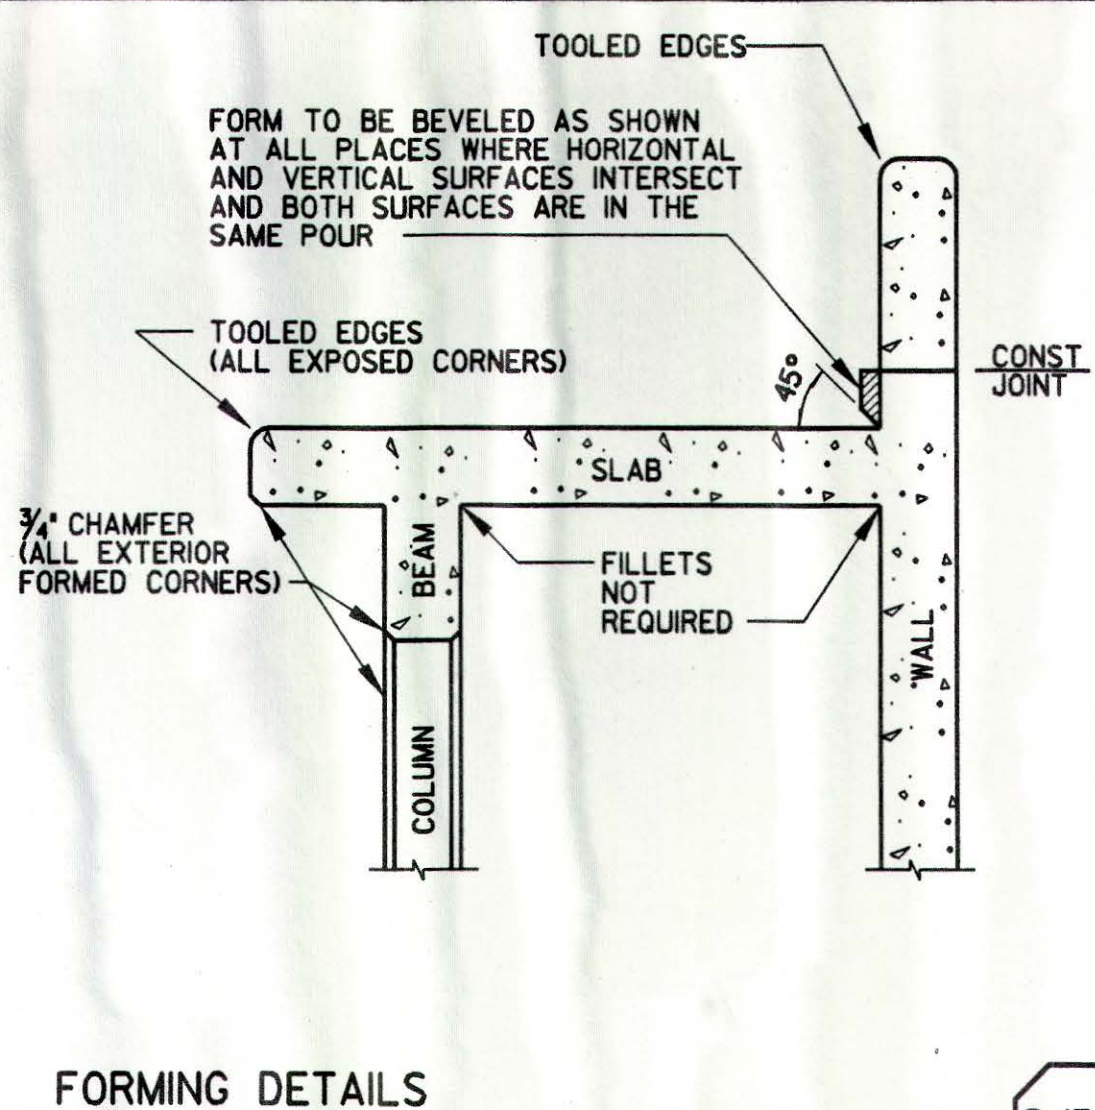

FORMING DETAILS

REV 010196


S-152

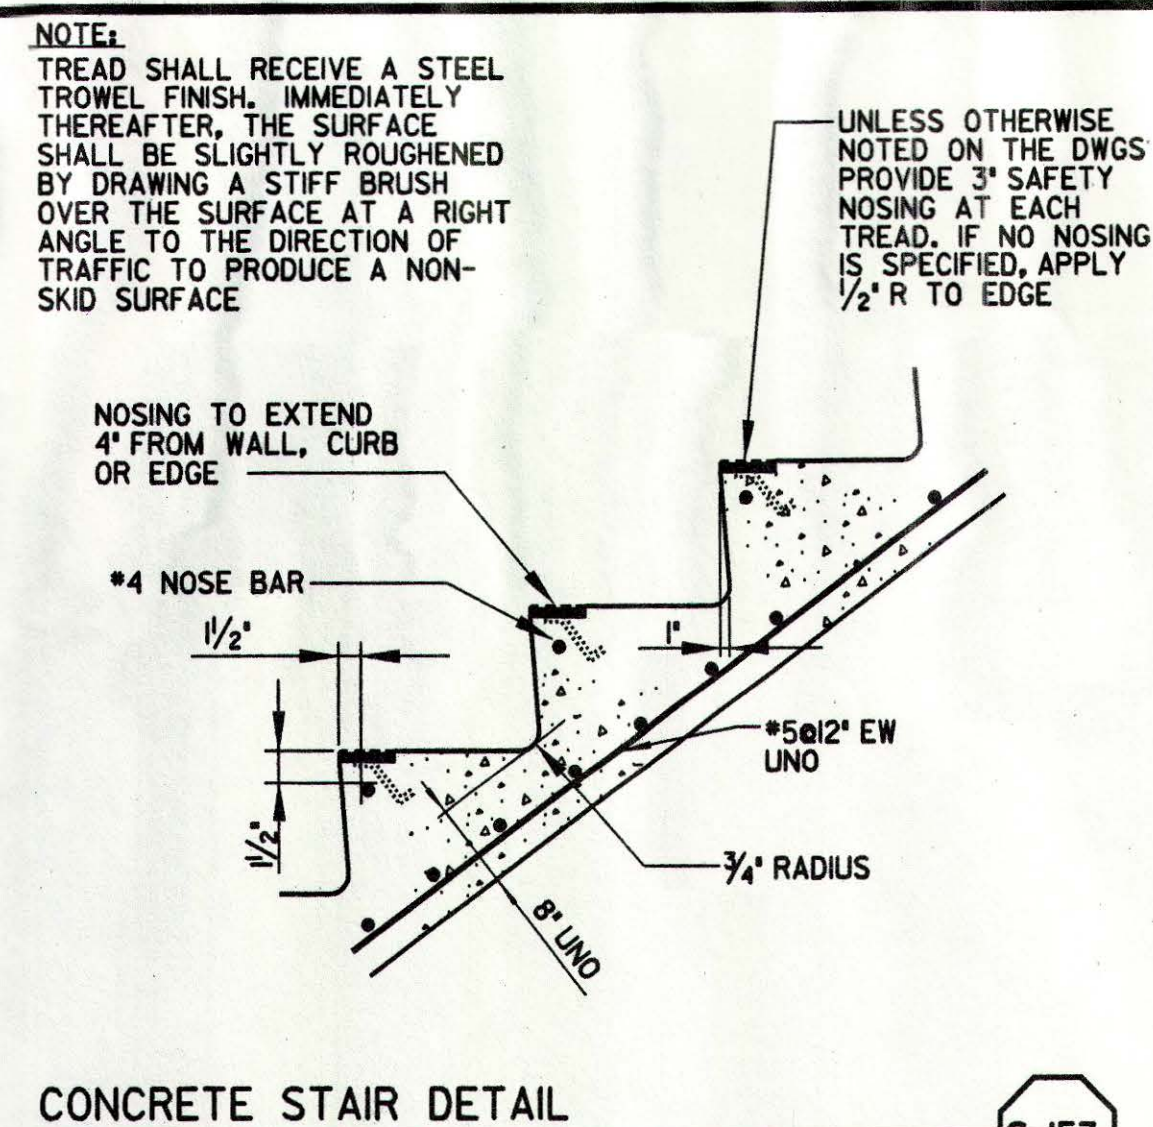

CONCRETE STAIR DETAIL

REV 010196


S-153

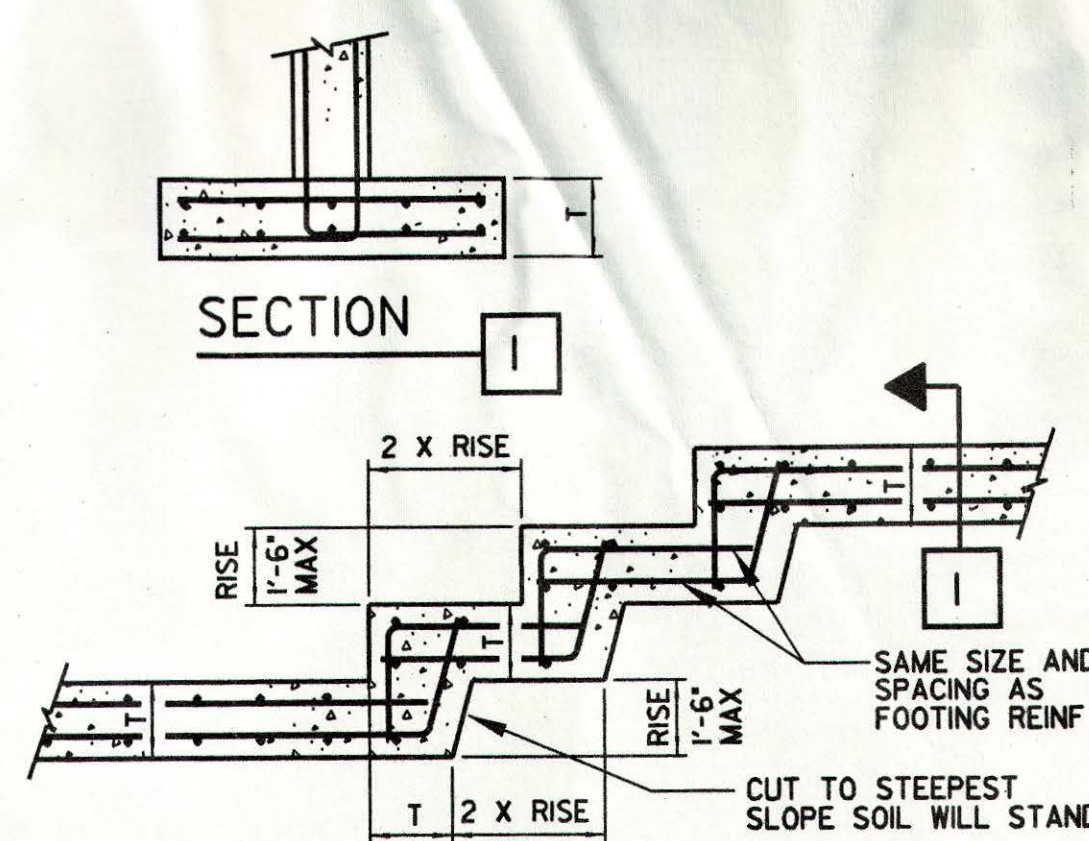

STEPPED FOOTING DETAIL

REV 010196


S-155

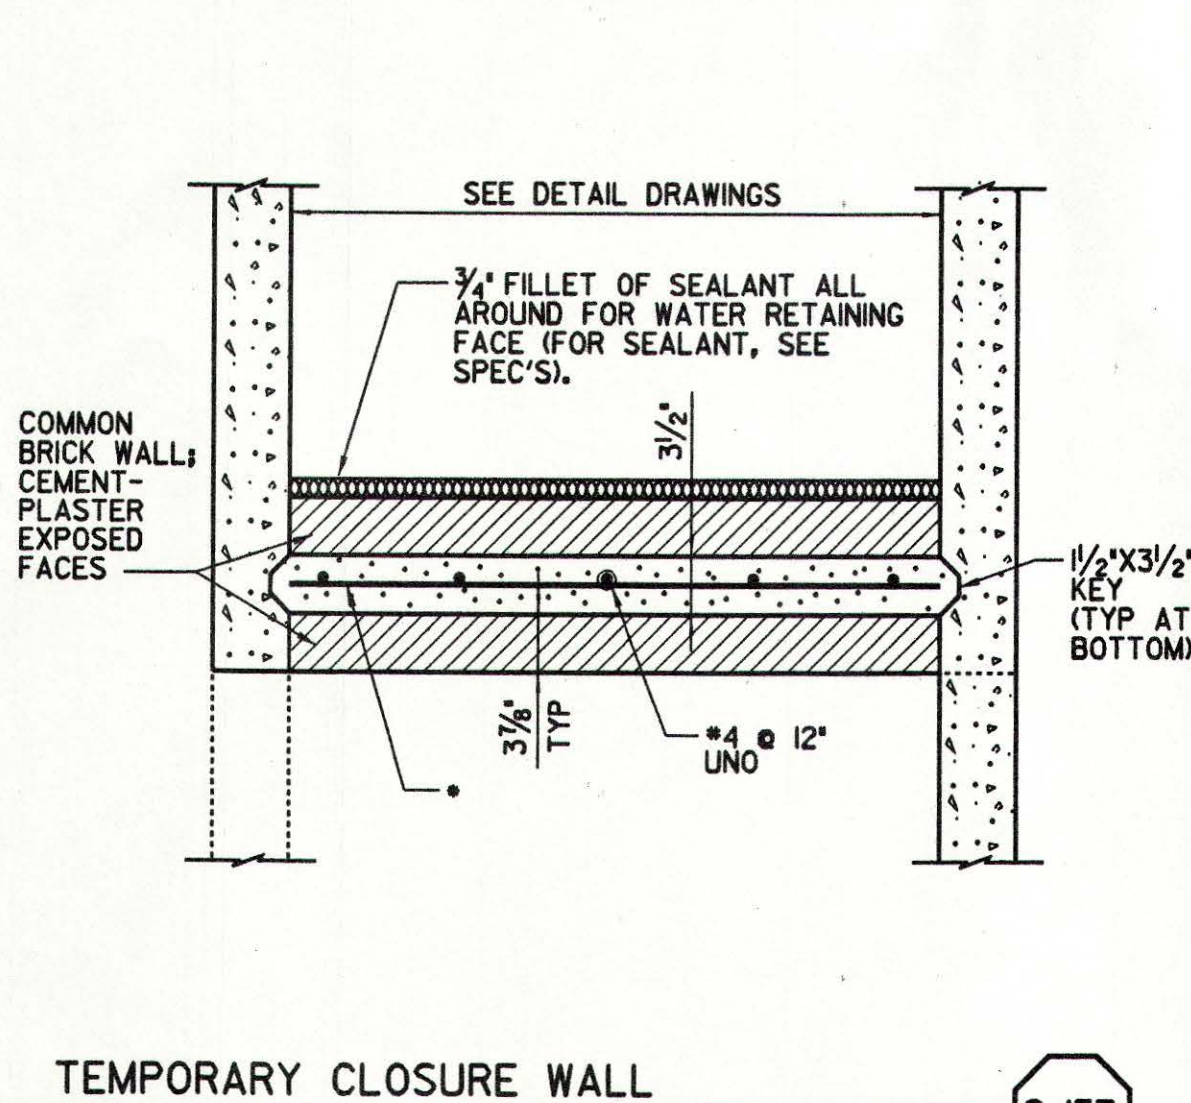

TEMPORARY CLOSURE WALL

REV 010196


S-157

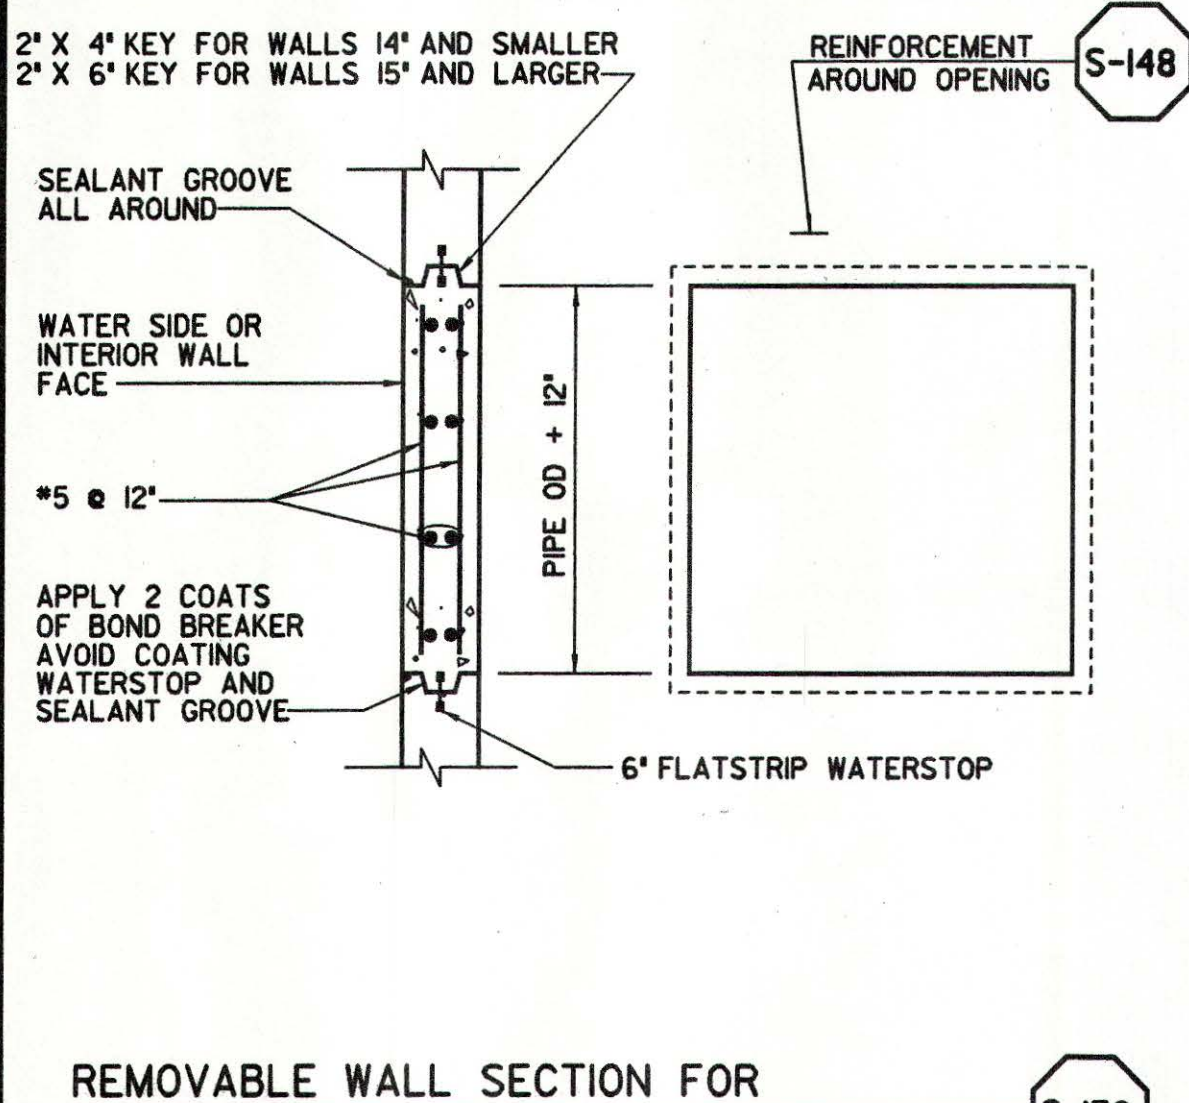

REMOVABLE WALL SECTION FOR FUTURE PIPING

REV 010196


S-159

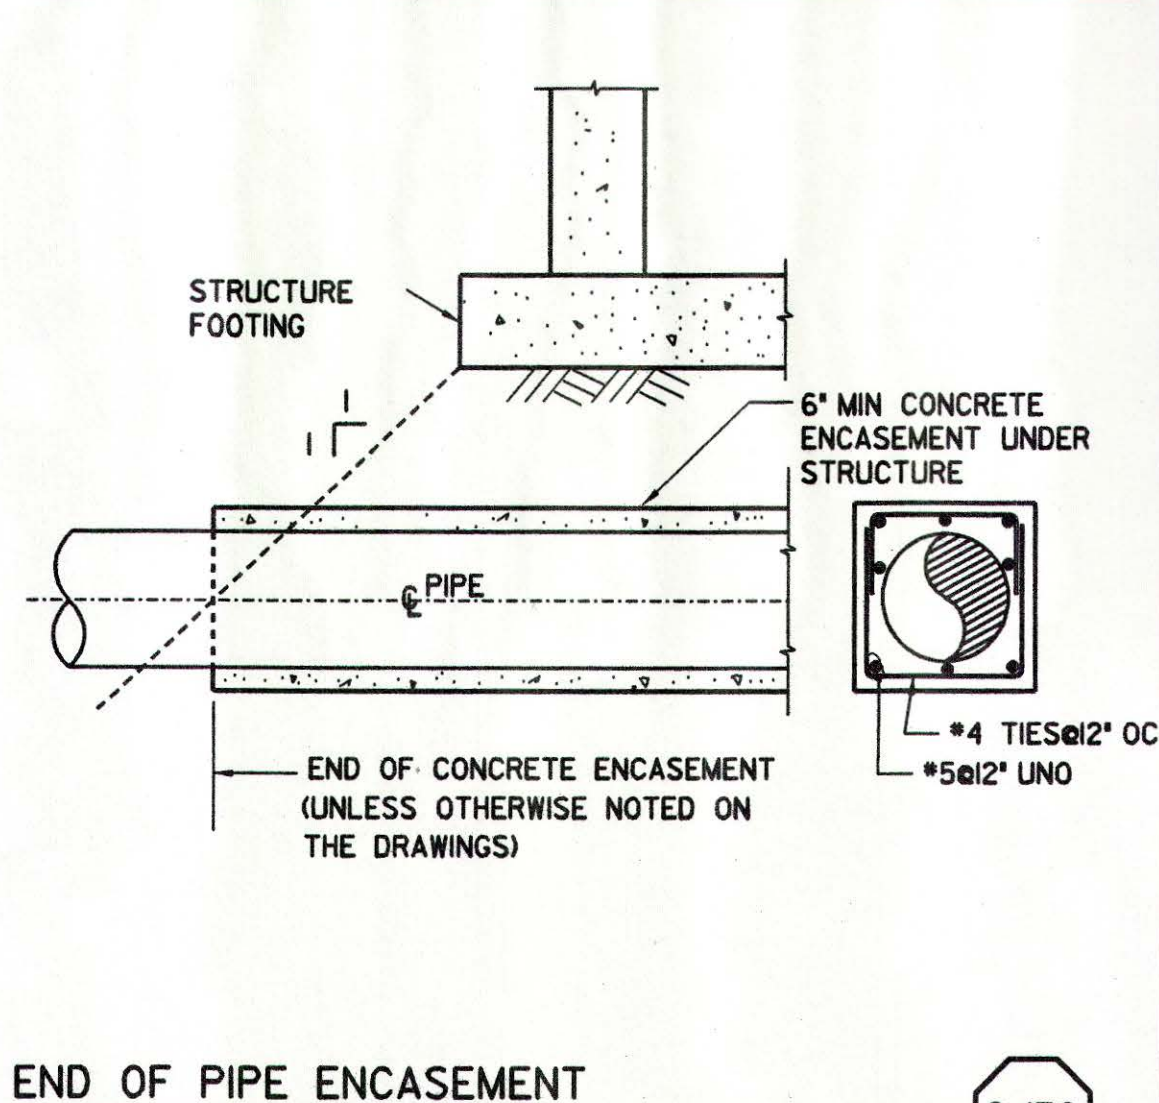

END OF PIPE ENCASEMENT UNDER STRUCTURES

REV 010196


S-170

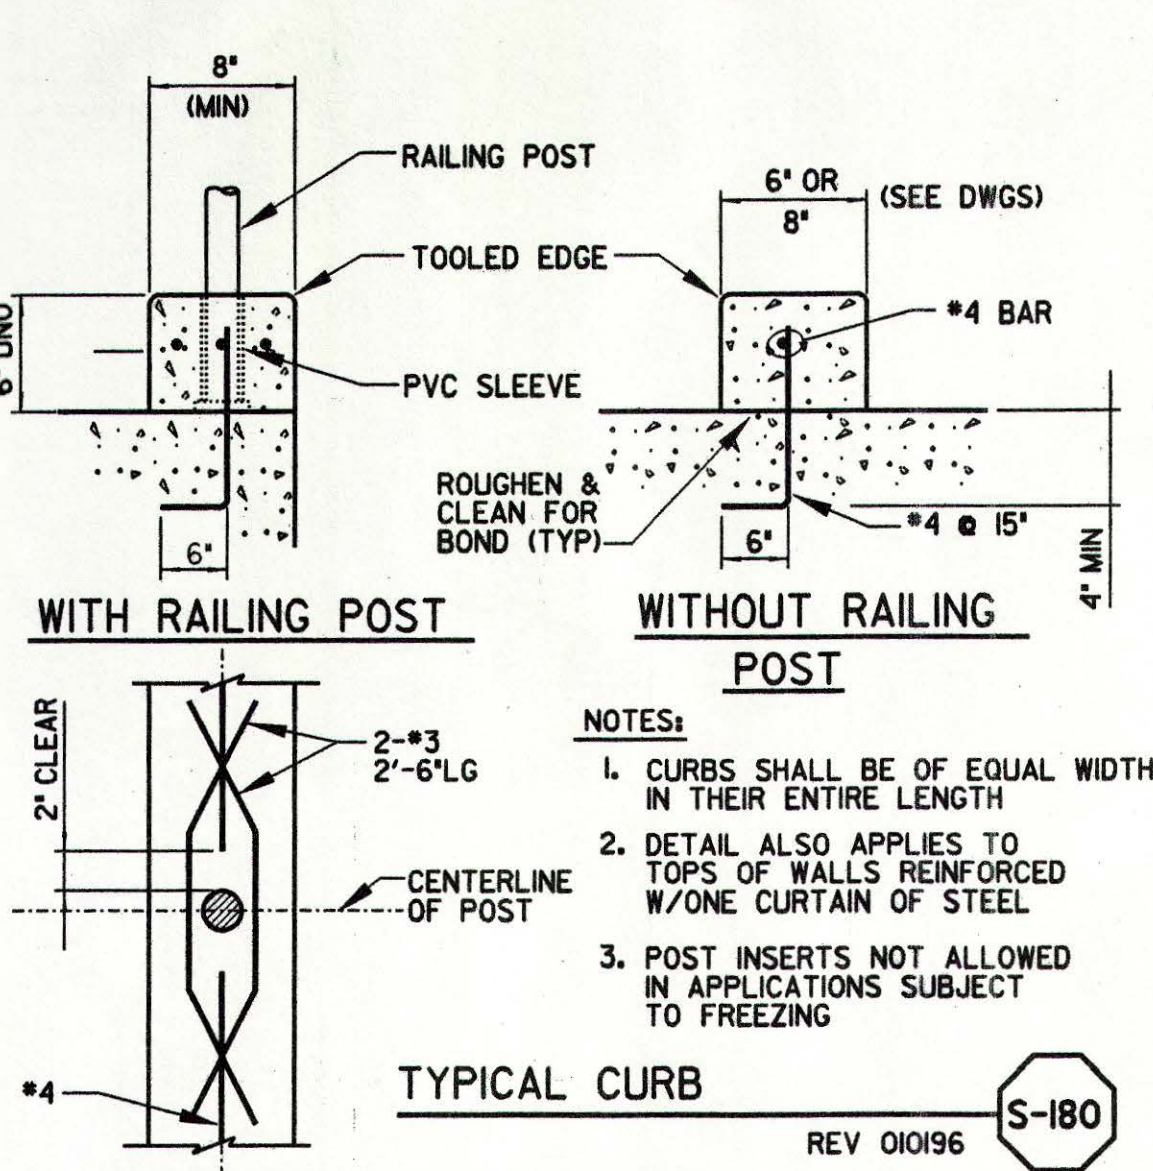

TYPICAL CURB

REV 010196


S-180

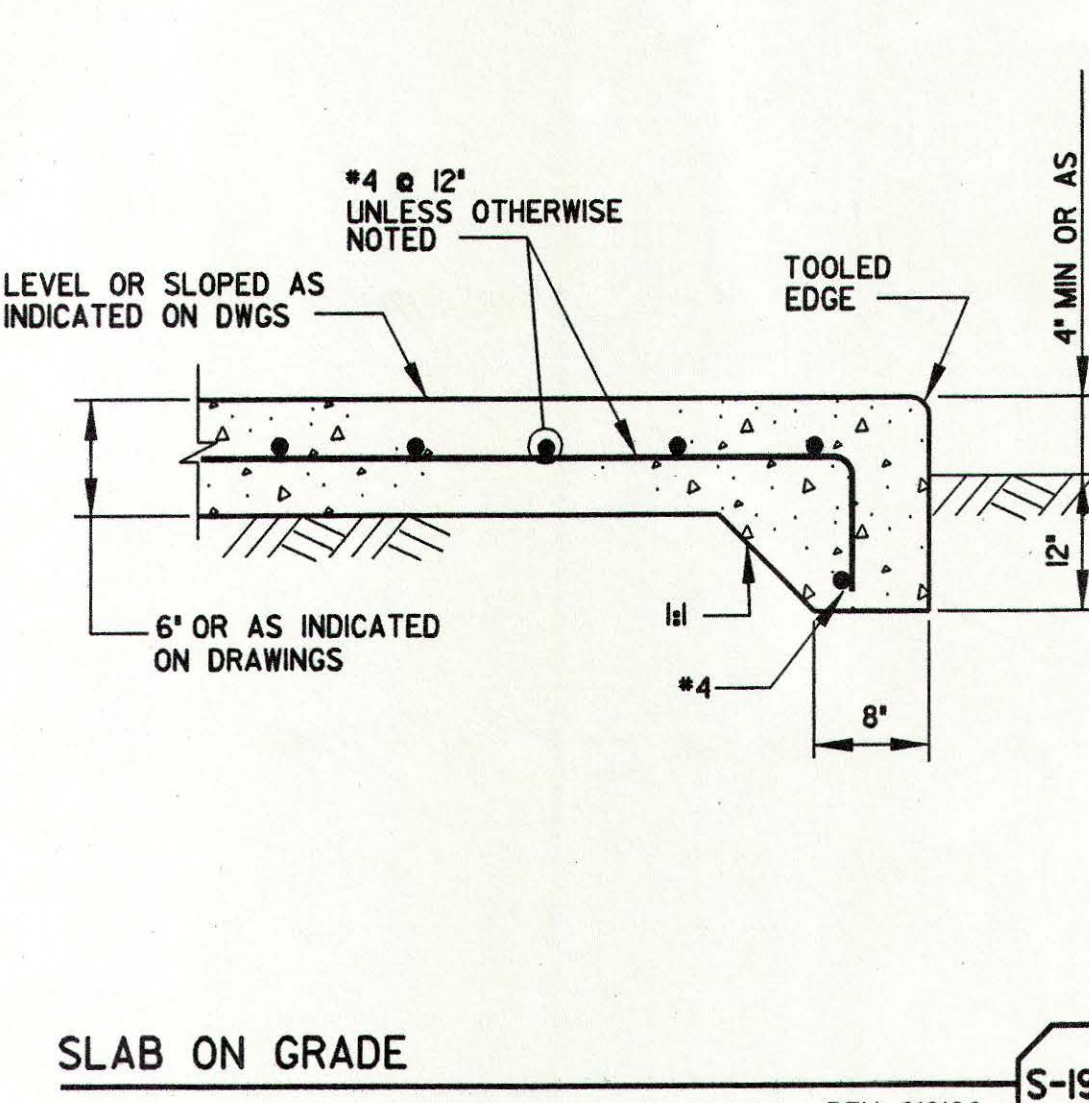

SLAB ON GRADE

REV 010196


S-190

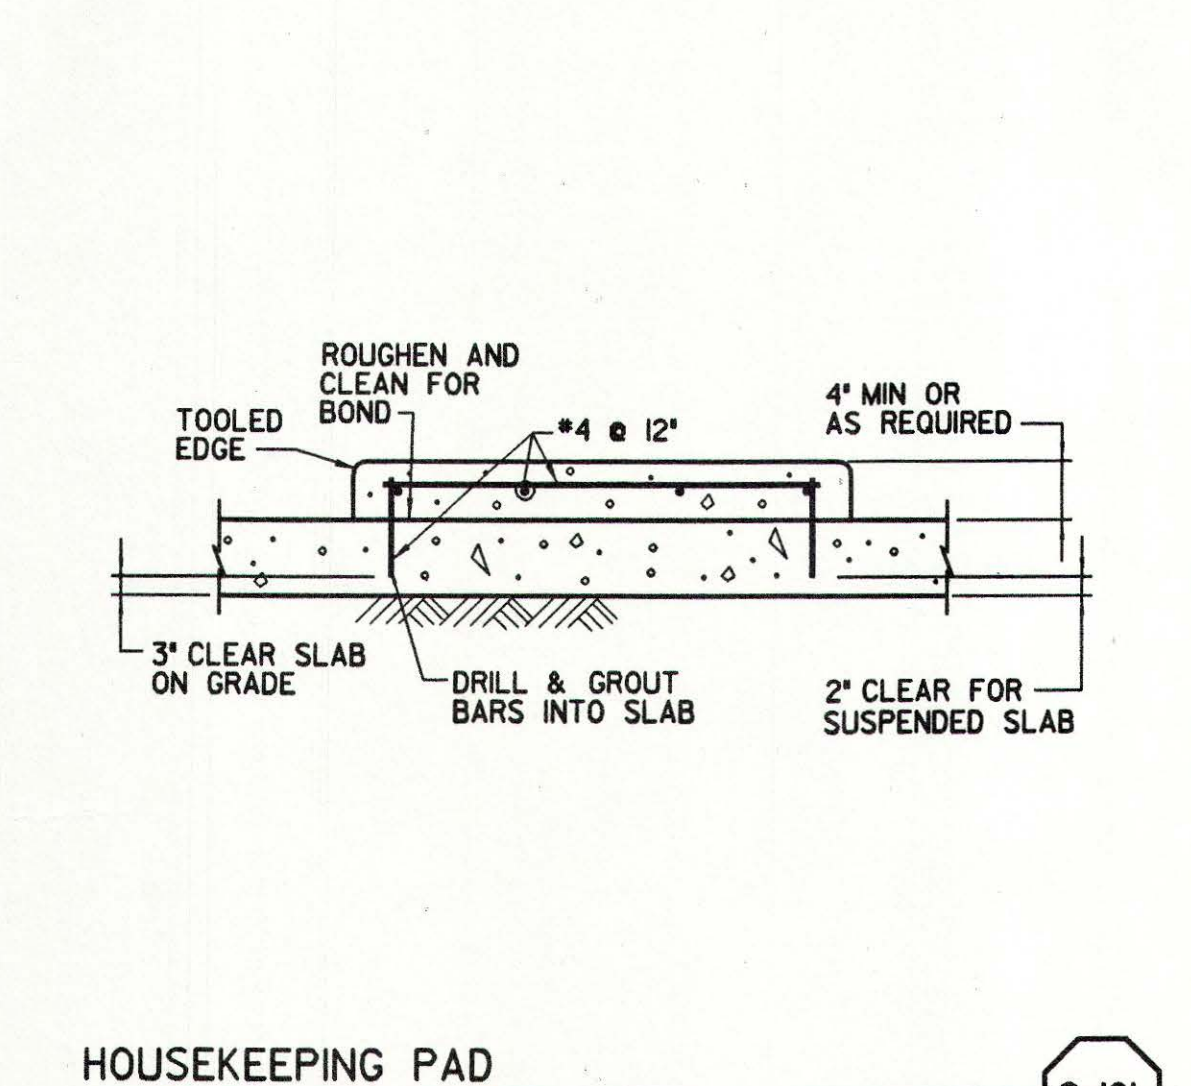

HOUSEKEEPING PAD


REV 010196

S-191

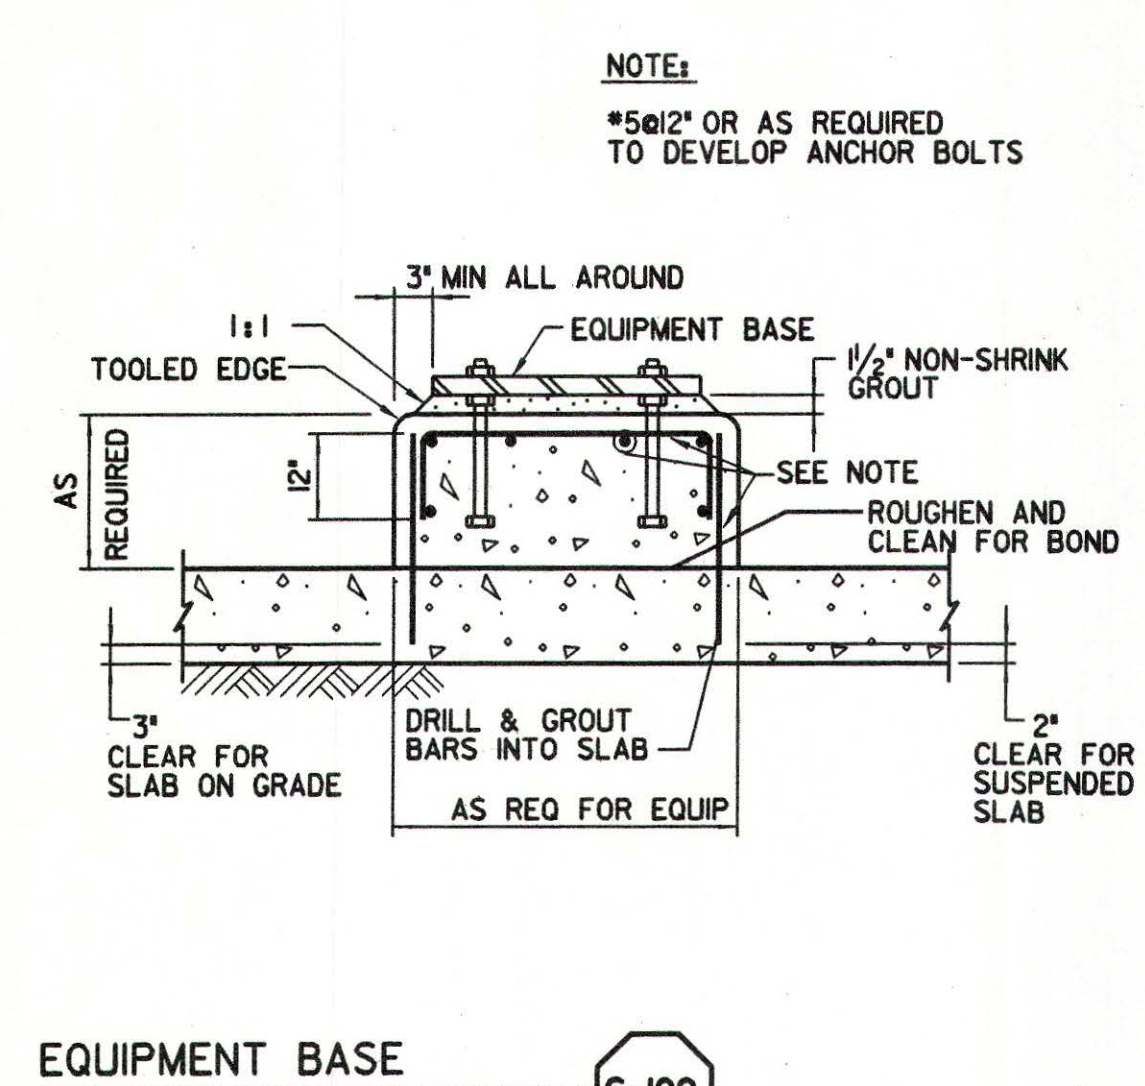

EQUIPMENT BASE

S-192

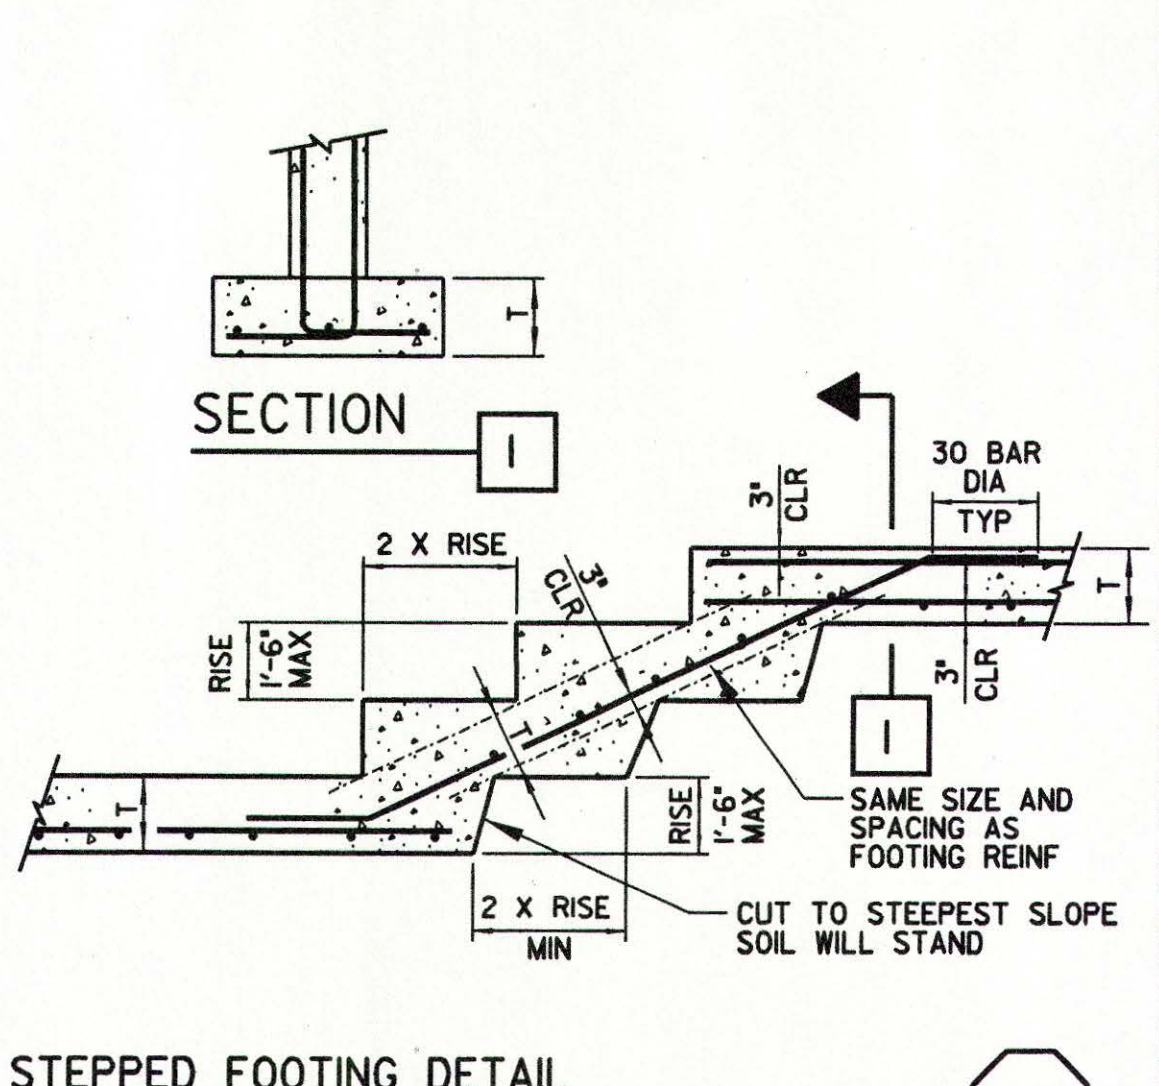

STEPPED FOOTING DETAIL

REV 010196

S-156

The limited review of this document by PBS & J on behalf of the Olivenhain Municipal Water District is intended as a limited review only for general conformance with: (1) This approved Design/ documents, (2) Accepted standards of practice within the industry, and (3) The standards of Olivenhain Municipal Water District. This limited review in no way is intended, nor shall it relieve the Design/Build Team of any professional liability to the responsibility to provide a complete and functional facility that is compliant with all applicable specifications, standards, codes, regulations.

PBS & J  
Date: 8/23/01 By: [Signature]



**MONTGOMERY WATSON**  
Pasadena, California

APPROVED  
George R. Bunt  
OLIVENHAIN MWD  
APPROVED  
FILANC CONSTRUCTION CO.

8.29.01  
DATE

KELWOOD DEVELOPMENT COMPANY  
4S RANCH SANITATION DISTRICT  
WASTEWATER TREATMENT PLANT EXPANSION TO 2.0 MGD


STANDARD DETAILS - III

SHEET  
GS-4  
OF 5 SHEET



NOTE:


WHERE NO DIMENSION IS INDICATED ON THE DRAWINGS, BASE DEPTH SHALL BE SET SO THAT THE BASE WEIGHS AT LEAST TWICE THE WEIGHT OF THE EQUIPMENT SUPPORTED

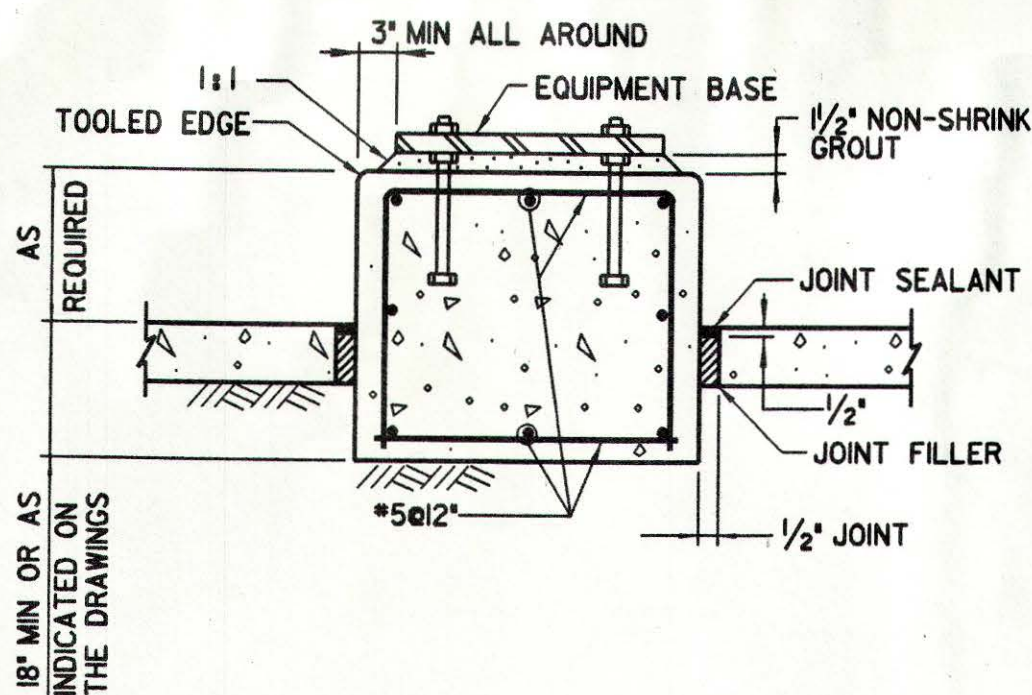

EQUIPMENT BASE ON GRADE WITH SEPARATING JOINT

REV 010196

S-193

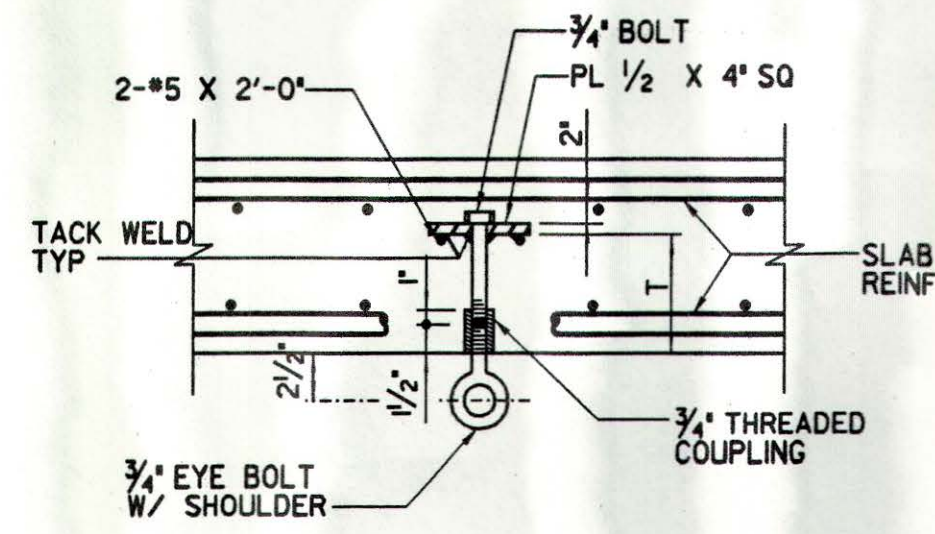

NOTES:

- ALL METAL PARTS SHALL BE GALVANIZED STEEL
- A CLEARANCE OF 2" MIN SHALL BE MAINTAINED BETWEEN THE LIFTING EYE ASSEMBLY AND THE REINFORCING STEEL
- LOAD CAPACITY
 

T = 4'	2000*
T = 5'	3000*
T = 6'	4000*

LIFTING EYE

REV 010196

S-195

UNLESS OTHERWISE SHOWN ON THE DRAWINGS CONCRETE COVER FOR REINFORCING BARS SHALL BE AS FOLLOWS:

- FOR CONCRETE PLACED AGAINST EARTH ----- 3"
- FOR SURFACES ON CONTACT WITH WATER AND FORMED SURFACES IN CONTACT WITH EARTH ----- 2"
- FOR UNDERSIDE OF SLABS OVER WATER IN ENCLOSED CONDUITS, BEAMS AND COLUMNS NOT IN CONTACT WITH EARTH OR WATER ----- 1 1/2"
- FOR SURFACES EXPOSED TO WEATHER AND INTERIOR SURFACES (EXCEPT BEAMS AND COLUMNS) NOT IN CONTACT WITH EARTH OR WATER ----- 1"


UNLESS OTHERWISE NOTED, WALLS AND SLABS SHOWN WITH A SINGLE LAYER OF REINFORCEMENT SHALL HAVE THAT REINFORCEMENT CENTERED.

CONCRETE PROTECTION FOR REINFORCEMENT

REV 051893

S-199

(CAST-IN-PLACE CONCRETE)

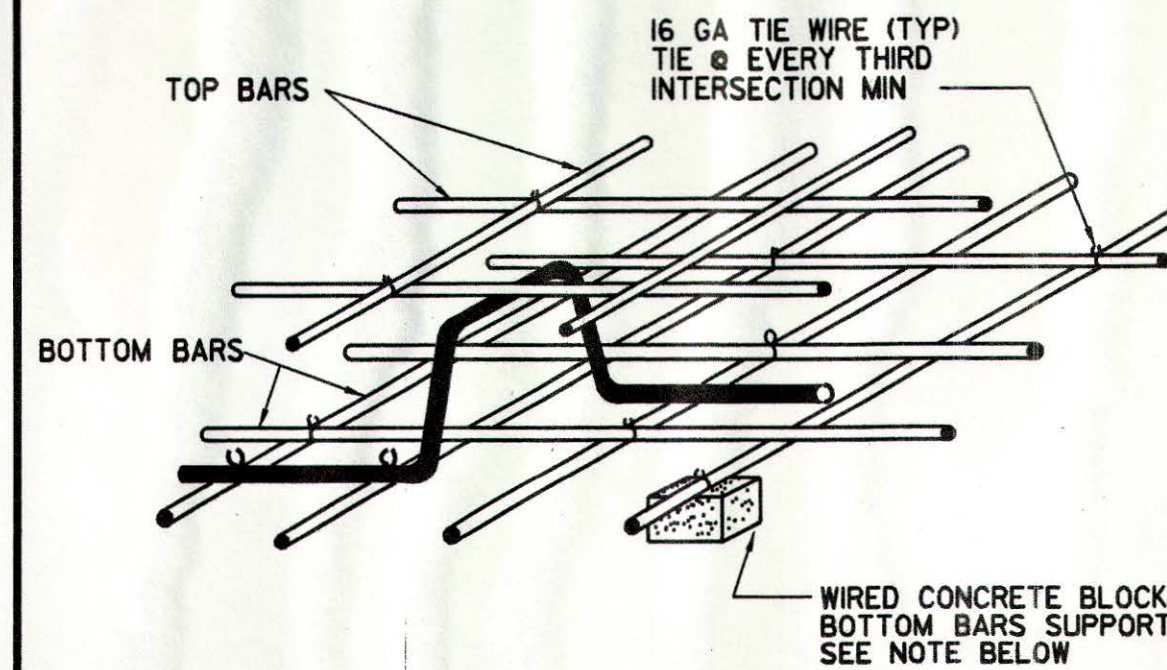


NOTE: METAL BAR SUPPORTS, IF USED IN SLABS NOT ON GROUND, SHALL NOT MAKE CONTACT WITH FORMS

REINFORCEMENT SUPPORT

REV 010196

S-204

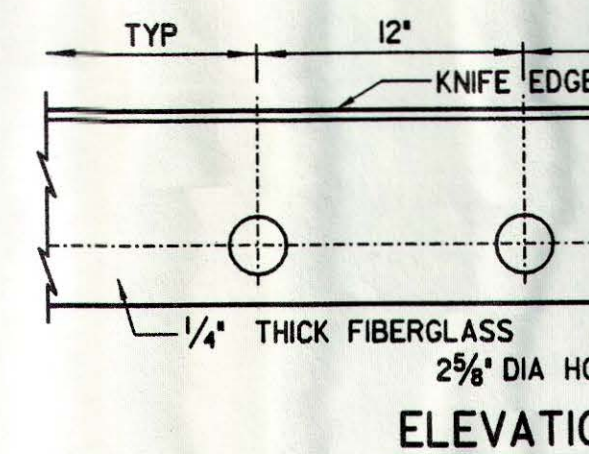

1/4" THICK FIBERGLASS PLATE  
ADHESIVE ANCHORS 1/2" DIA WITH NUTS AND 5" OD FIBERGLASS REINFORCED POLYESTER FLAT WASHERS. (UNLESS OTHERWISE SHOWN OR NOTED ON DRAWINGS, SPACING TO BE 12" OC)


1/8" THICK NEOPRENE FOAM GASKET WITH BOLT HOLES PUNCHED

TYPICAL WEIR DETAIL

NOTES:

- ALL CUT EDGES SHALL BE SEALED WITH RESIN
- ALL GRATING SHALL BE SECURED IN PLACE WITH REMOVABLE FASTENERS, SIMILAR TO DETAIL S-517
- BONDING: USE EPOXY ADHESIVE BONDING AGENT
- WEIGHT OF EACH SECTION OF GRATING SHALL NOT EXCEED 80 POUNDS
- ALL FRAME COMPONENTS SHALL BE FIBERGLASS
- T TO BE DETERMINED BY GRATING MFR & APPROVED BY ENGINEER


FIBERGLASS PULTRUDED EMBEDDED FRAME W/ CONTINUOUS ANCHOR SIZED FOR GRATING

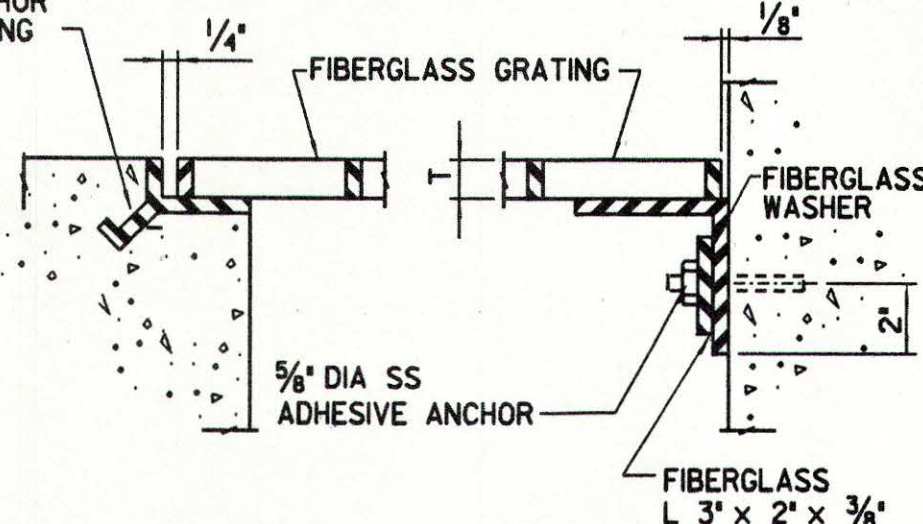

FIBERGLASS GRATING DETAILS

REV 010196


S-320

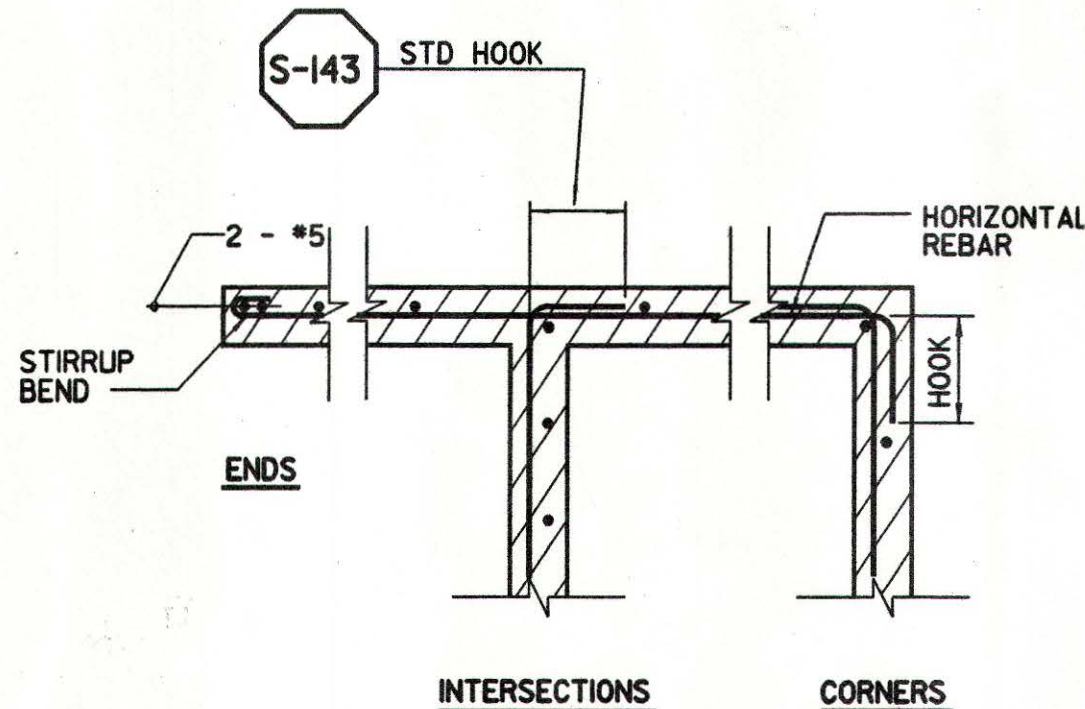

TYPICAL 8" & 10" BLOCK WALL SECTIONS

REV 010196

S-401

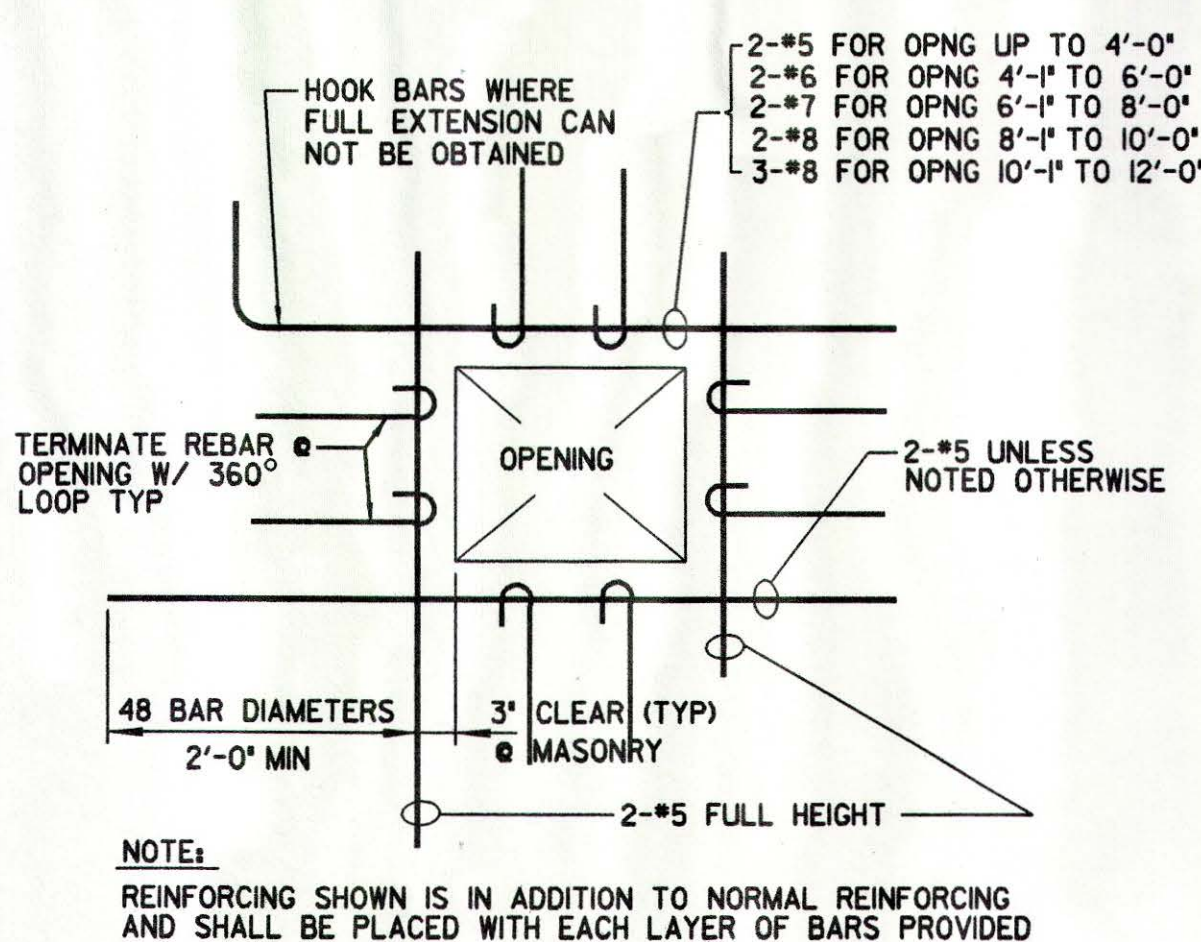


NOTE: REINFORCING SHOWN IS IN ADDITION TO NORMAL REINFORCING AND SHALL BE PLACED WITH EACH LAYER OF BARS PROVIDED

TYPICAL REINFORCEMENT AT MASONRY WALL OPENING

REV 010196


S-410

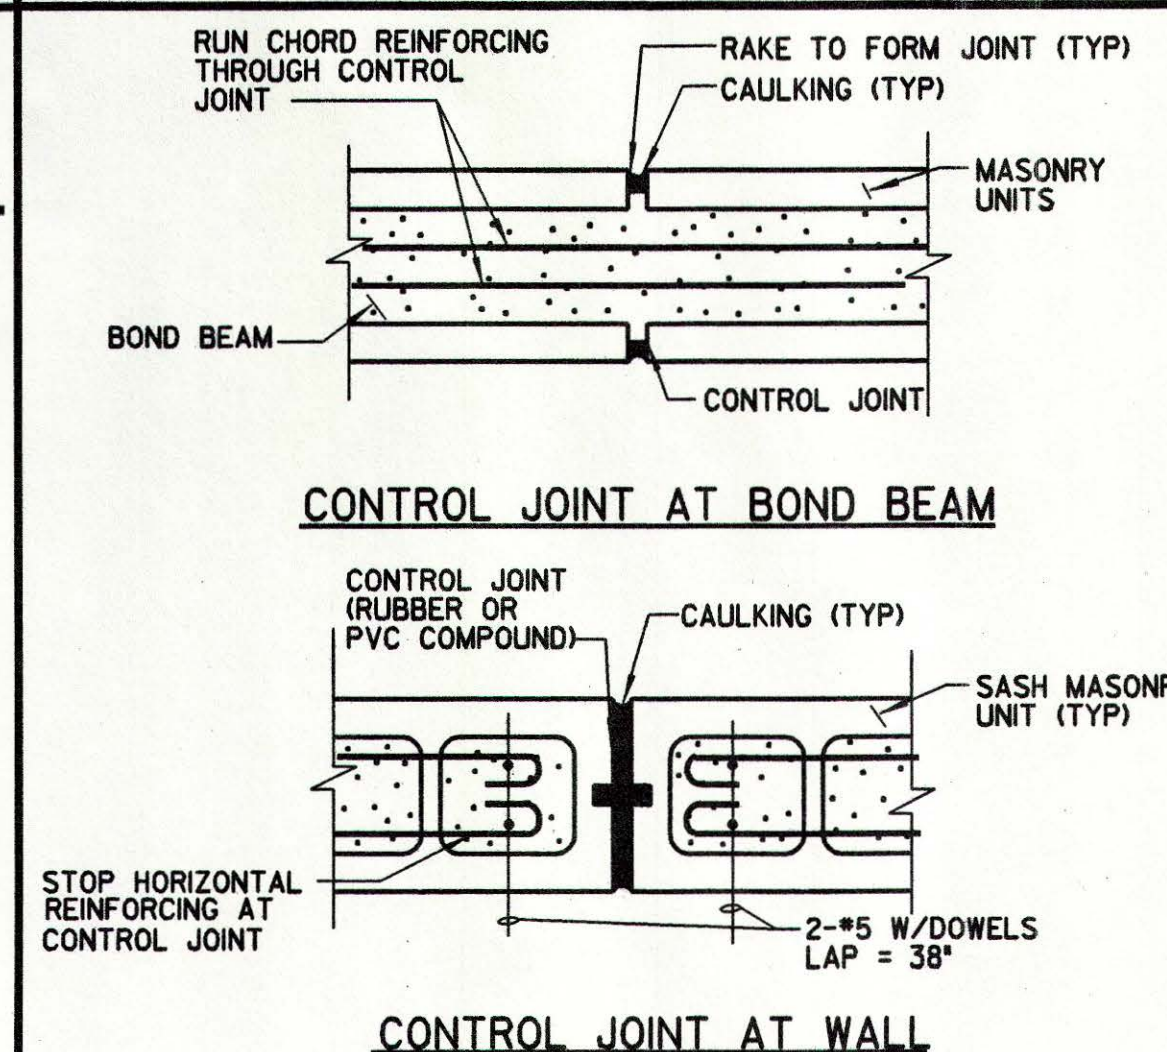


CONTROL JOINTS

REV 010196

S-430

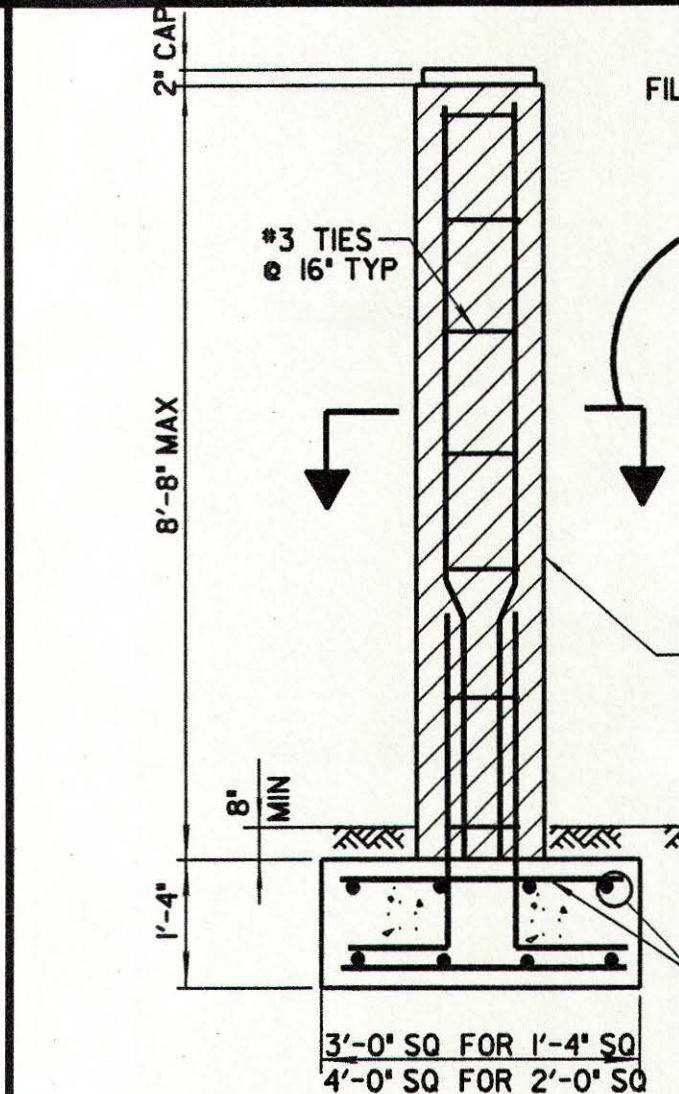


TYP FENCE PILASTER ELEVATION

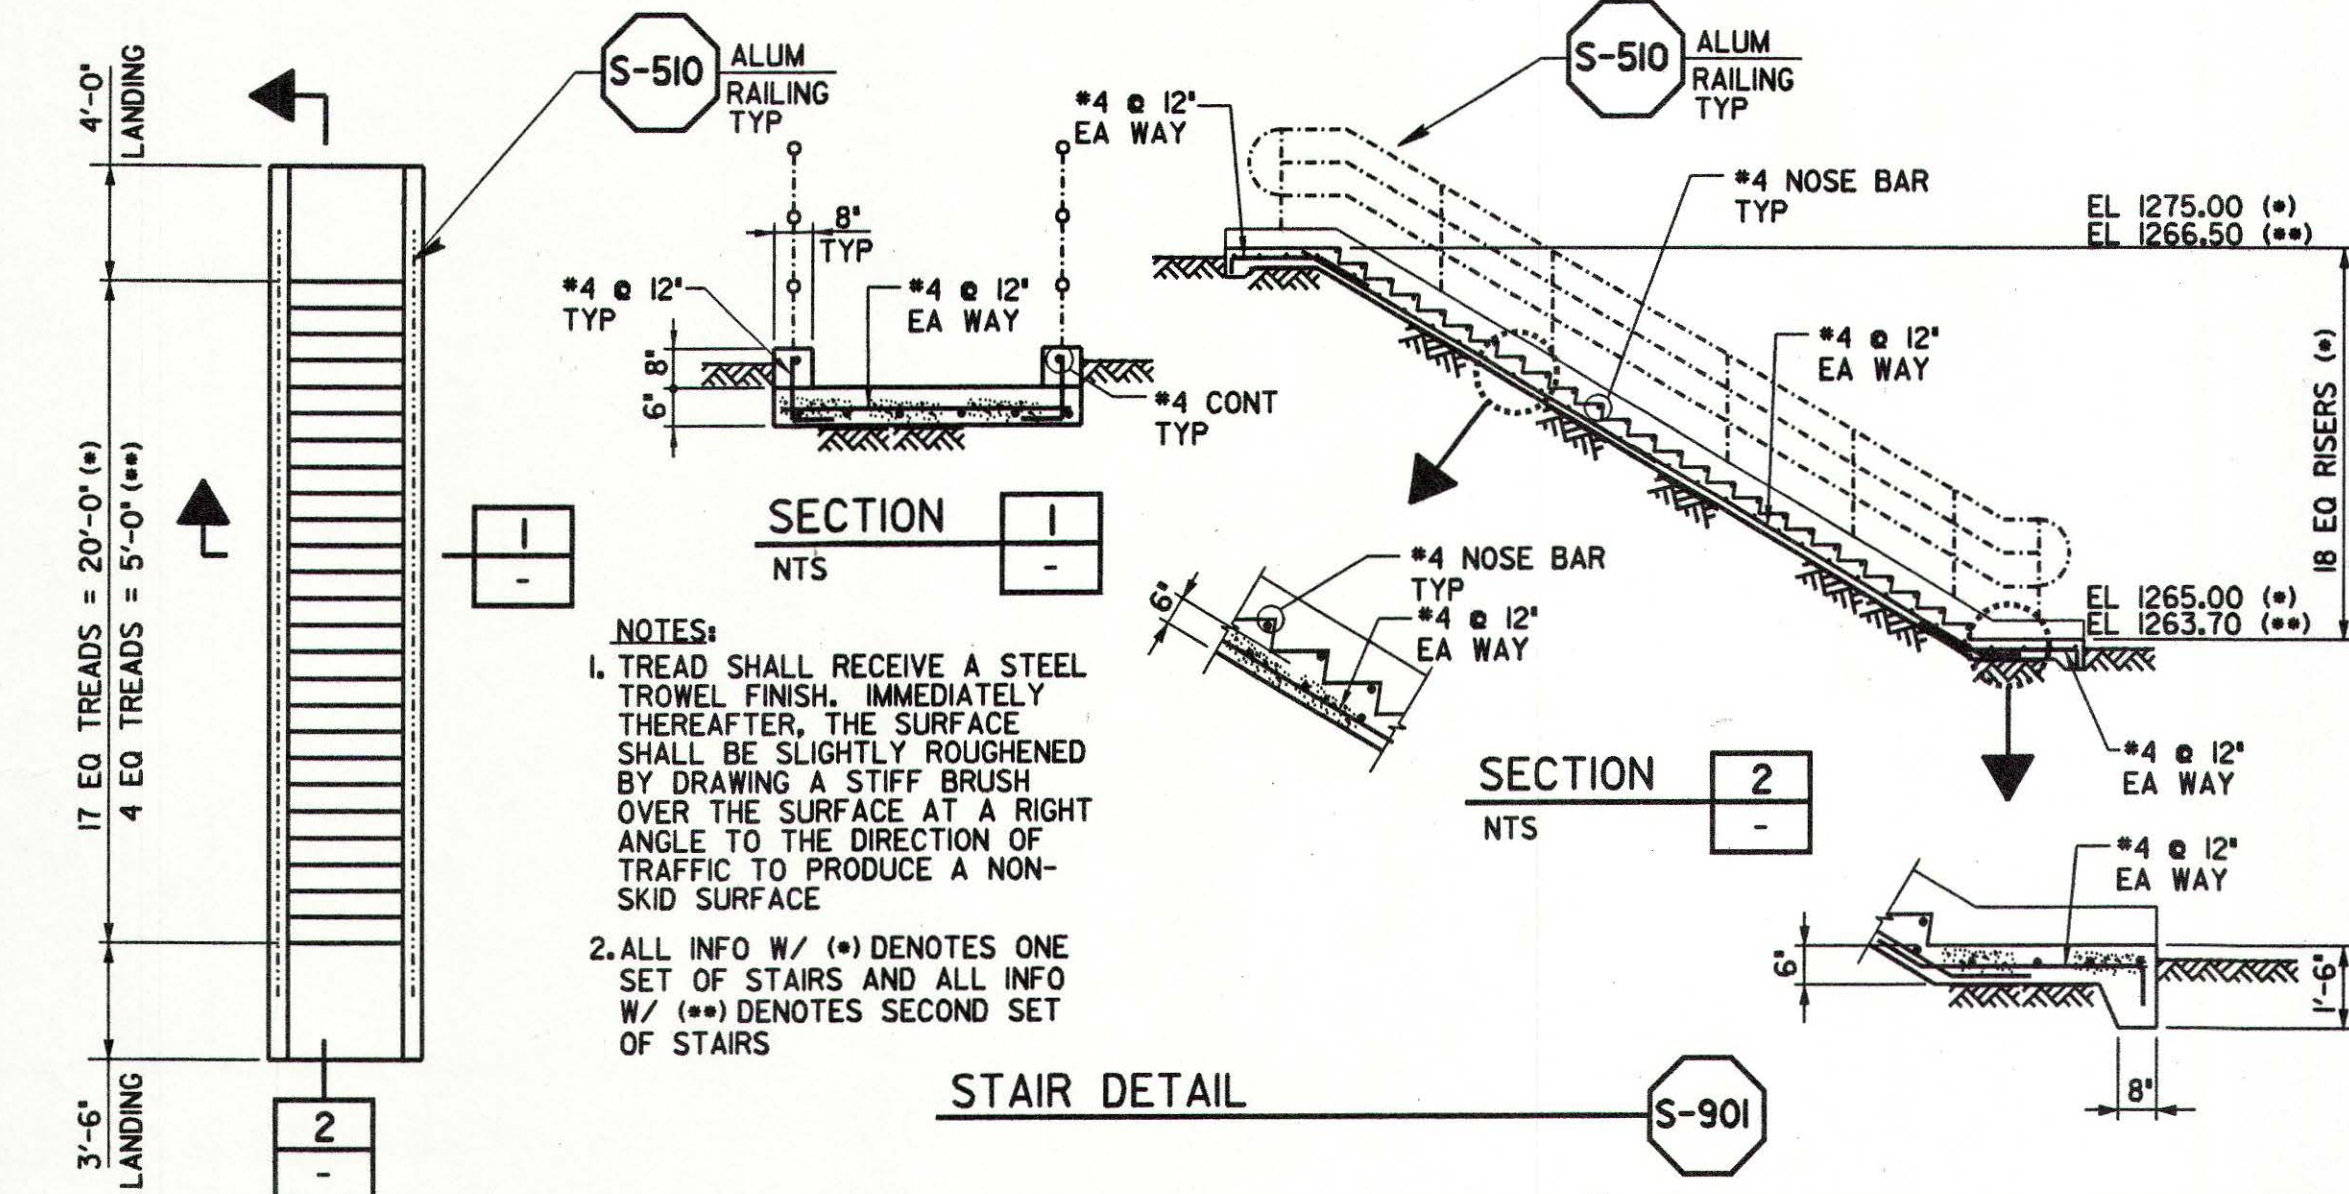


STAIR DETAIL

S-901

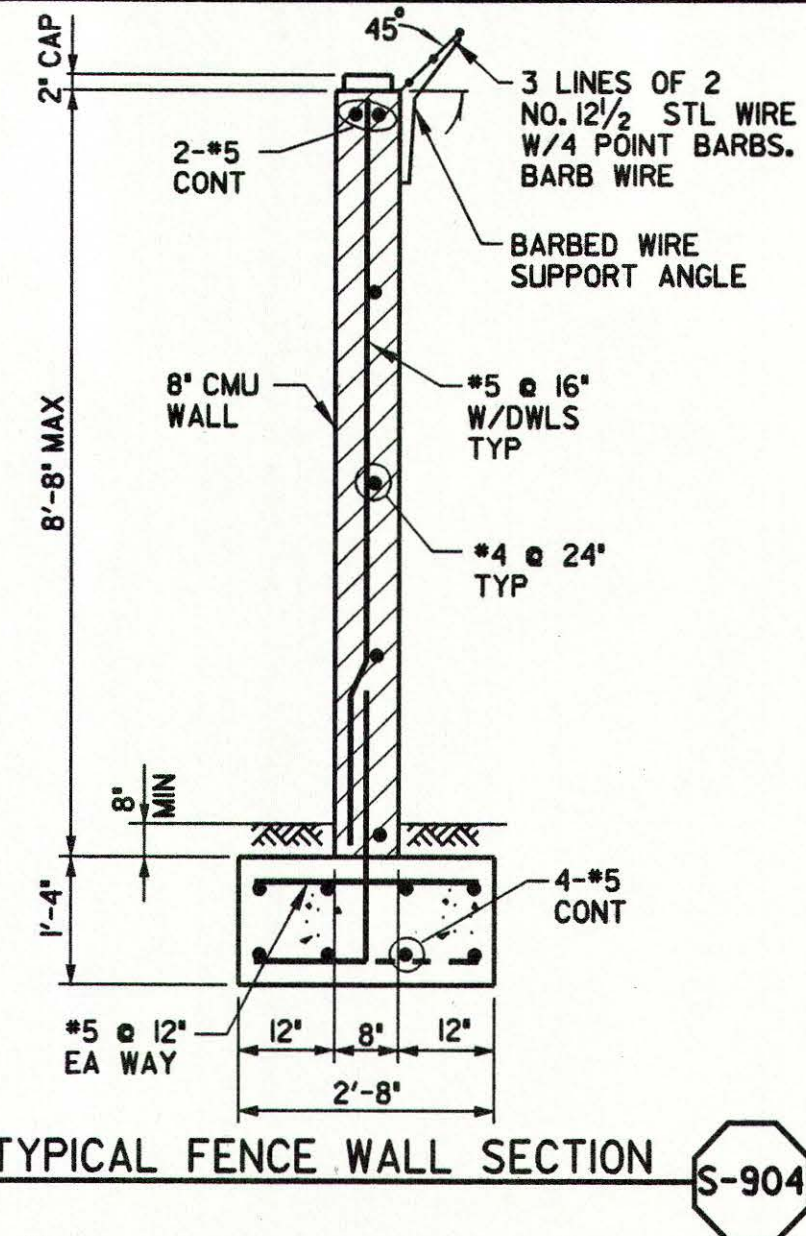

TYPICAL FENCE WALL SECTION

S-904

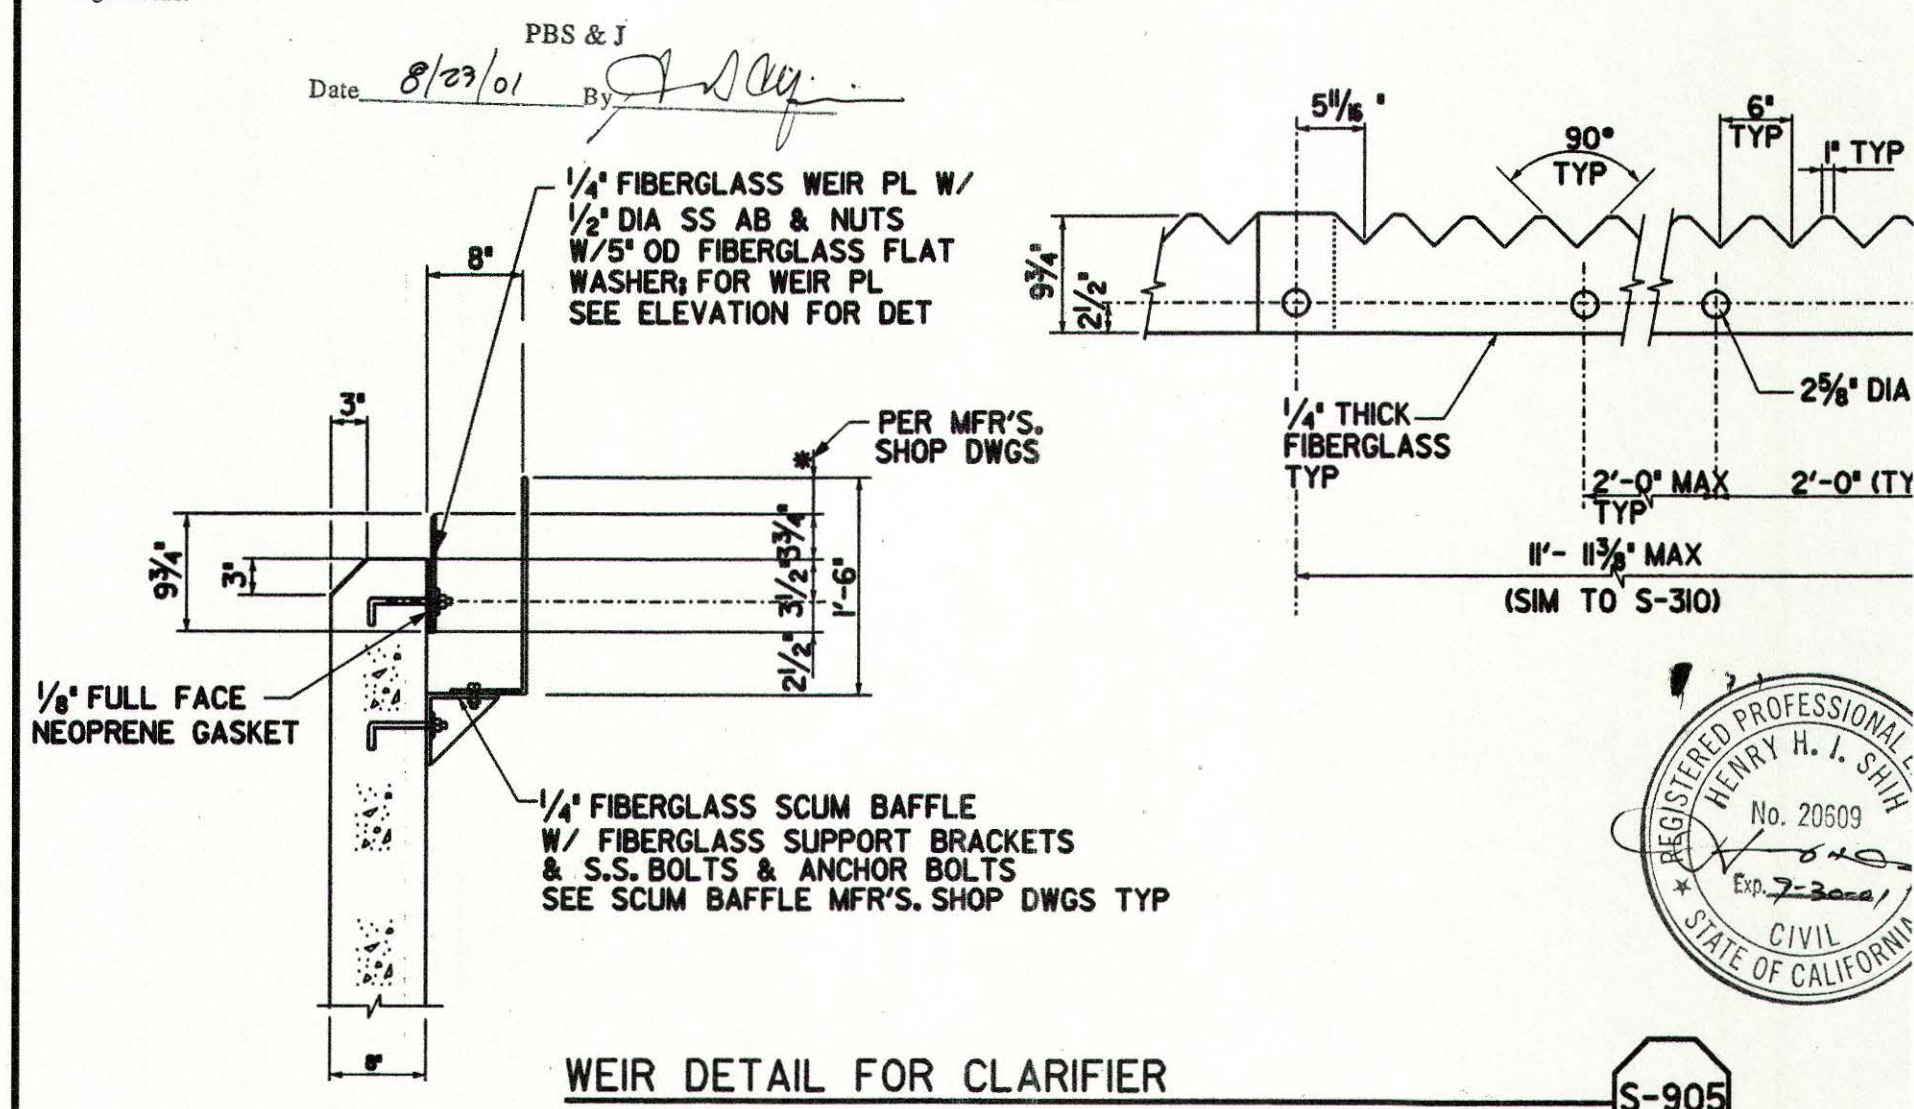

WEIR DETAIL FOR CLARIFIER

S-905

REV	DATE	BY	OMWD	DESCRIPTION

SCALE	WARNING
NO SCALE	IF THIS BAR DOES NOT MEASURE 1\"/>

DESIGNED	MW
DRAWN	MW
CHECKED	C. LEE

SUBMITTED BY	PROJECT MANAGER	50802	12/13/00
		LICENSE NO.	DATE
		33699	12/13/00
		LICENSE NO.	DATE

**MONTGOMERY WATSON**  
Pasadena, California


APPROVED  
*George R. Bunt*  
OLIVENHAIN (MW)  
APPROVED  
FILANC CONSTRUCTION CO.  
DATE

KELWOOD DEVELOPMENT COMPANY  
4S RANCH SANITATION DISTRICT  
WASTEWATER TREATMENT PLANT EXPANSION TO  
STANDARD DETAILS - IV







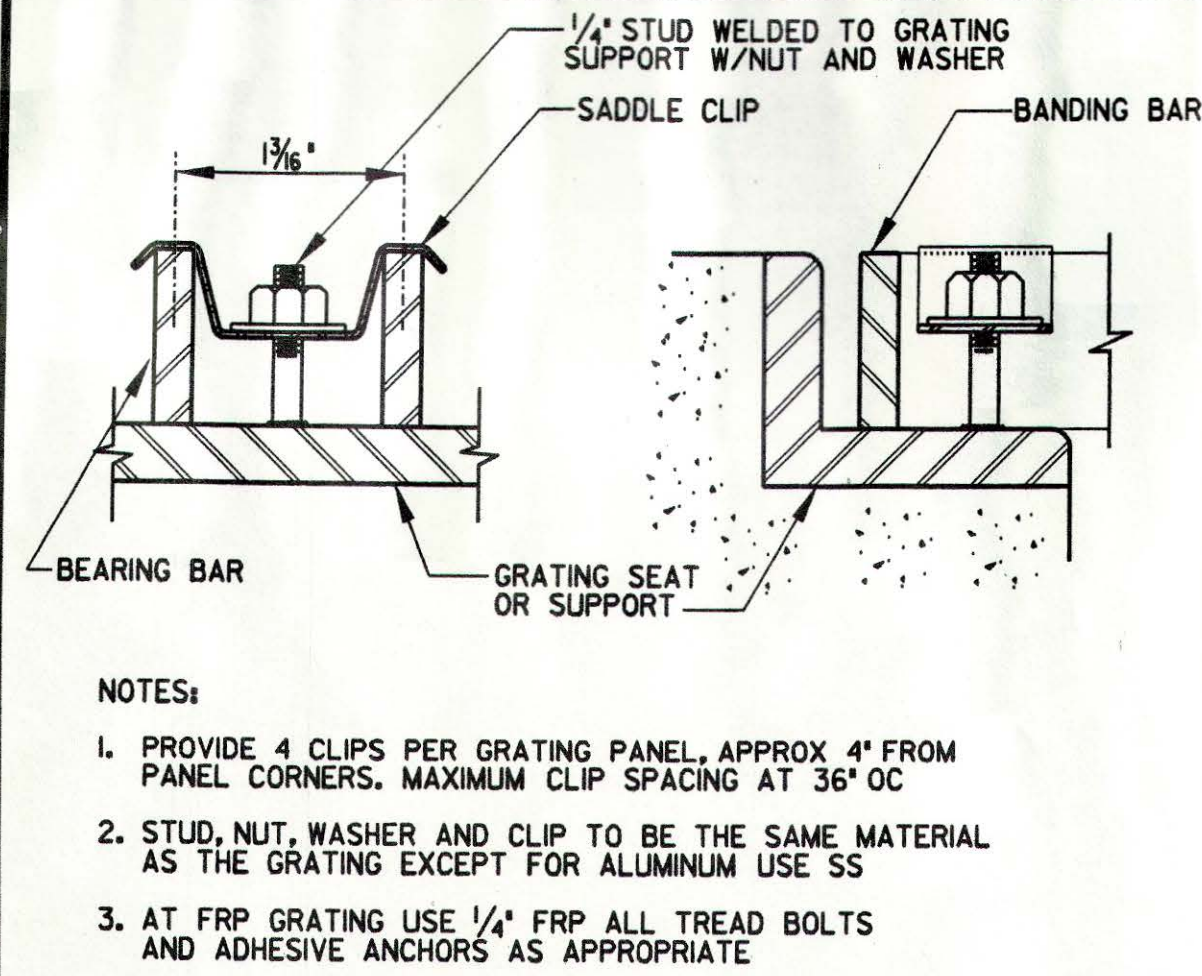


- NOTES:
1. PROVIDE 4 CLIPS PER GRATING PANEL, APPROX 4" FROM PANEL CORNERS. MAXIMUM CLIP SPACING AT 36" OC
  2. STUD, NUT, WASHER AND CLIP TO BE THE SAME MATERIAL AS THE GRATING EXCEPT FOR ALUMINUM USE SS
  3. AT FRP GRATING USE 1/4" FRP ALL TREAD BOLTS AND ADHESIVE ANCHORS AS APPROPRIATE

GRATING ANCHOR DETAIL

REV 010196

S-517

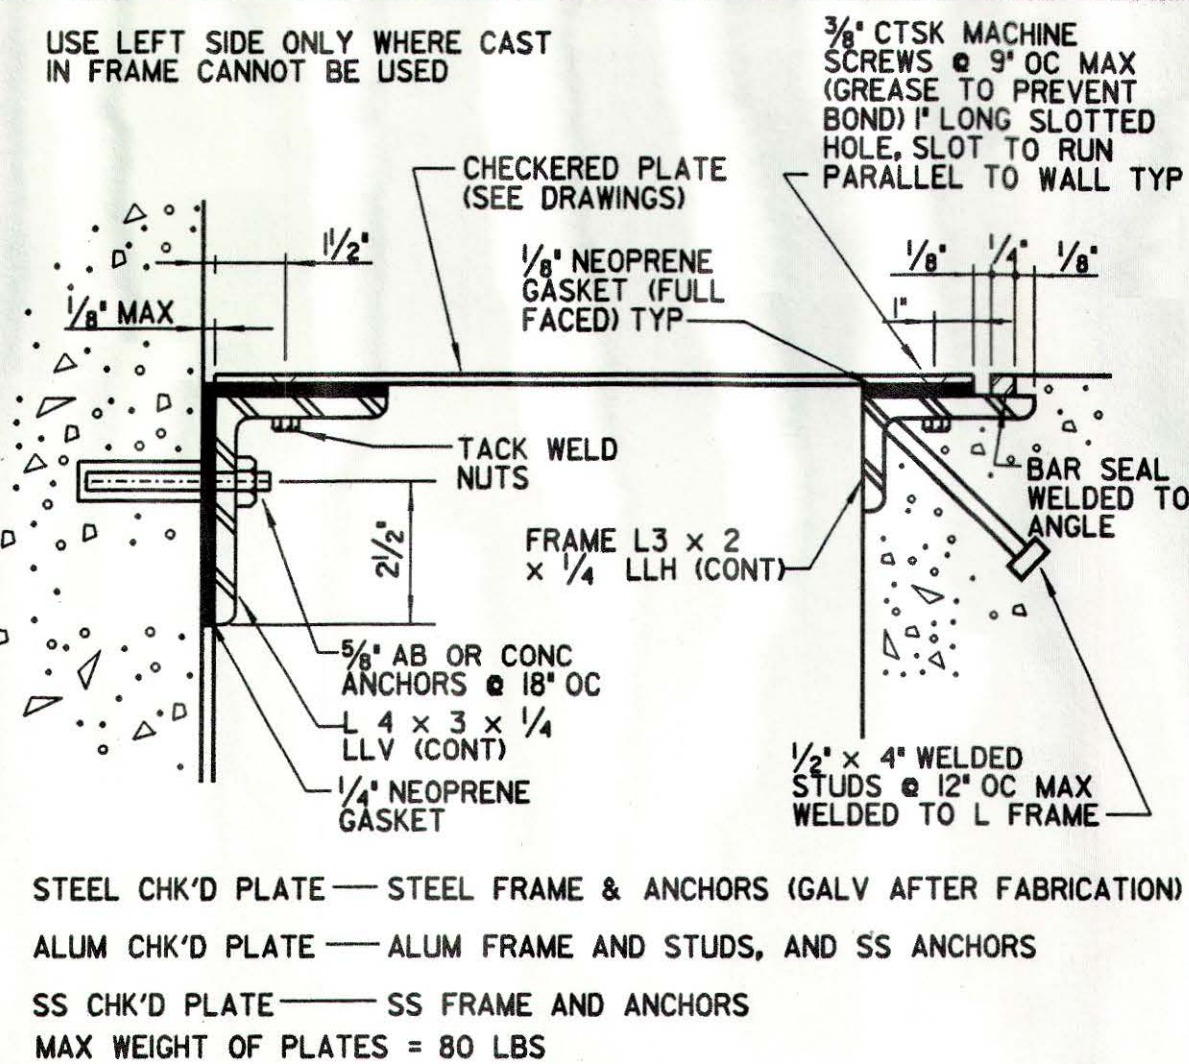


STEEL CHK'D PLATE — STEEL FRAME & ANCHORS (GALV AFTER FABRICATION)  
ALUM CHK'D PLATE — ALUM FRAME AND STUDS, AND SS ANCHORS  
SS CHK'D PLATE — SS FRAME AND ANCHORS  
MAX WEIGHT OF PLATES = 80 LBS

TYPICAL PLATE COVERED OPENING

REV 010196


S-518

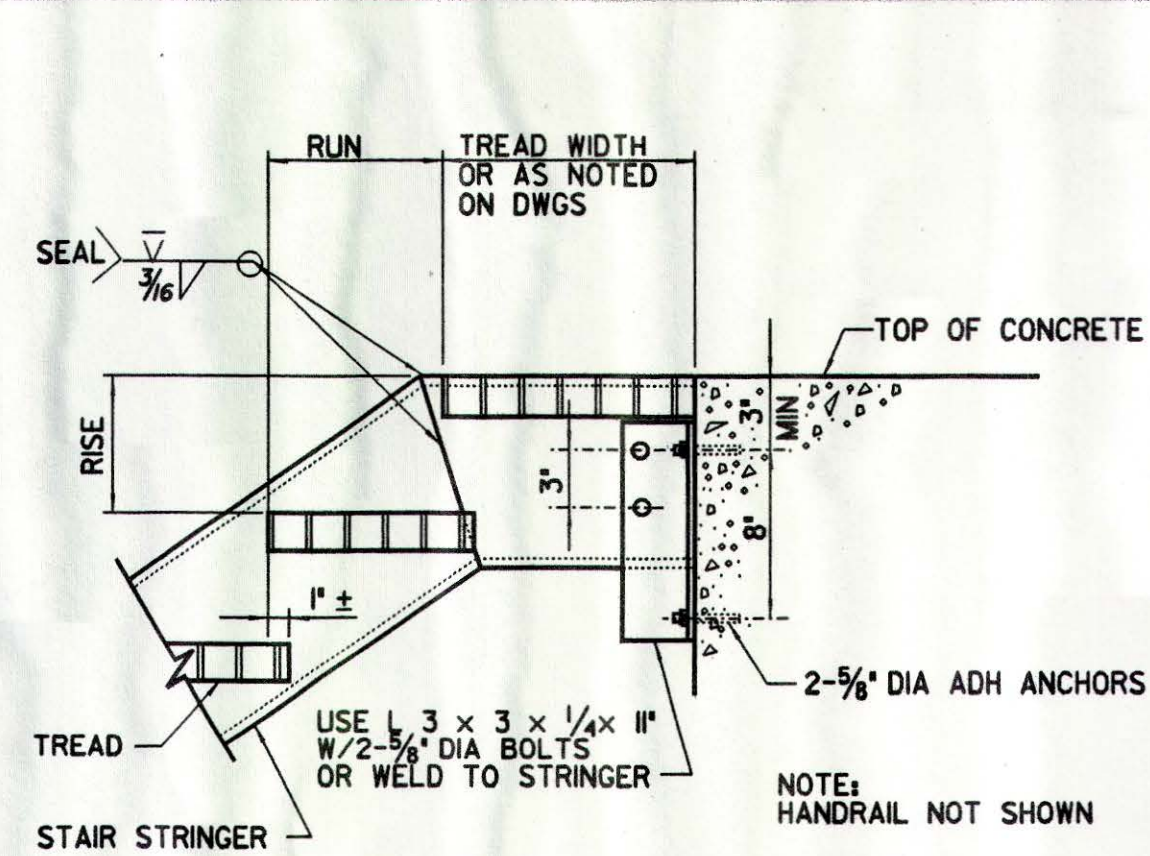

STAIR TOP CONNECTION TO CONCRETE

REV 010196


S-525

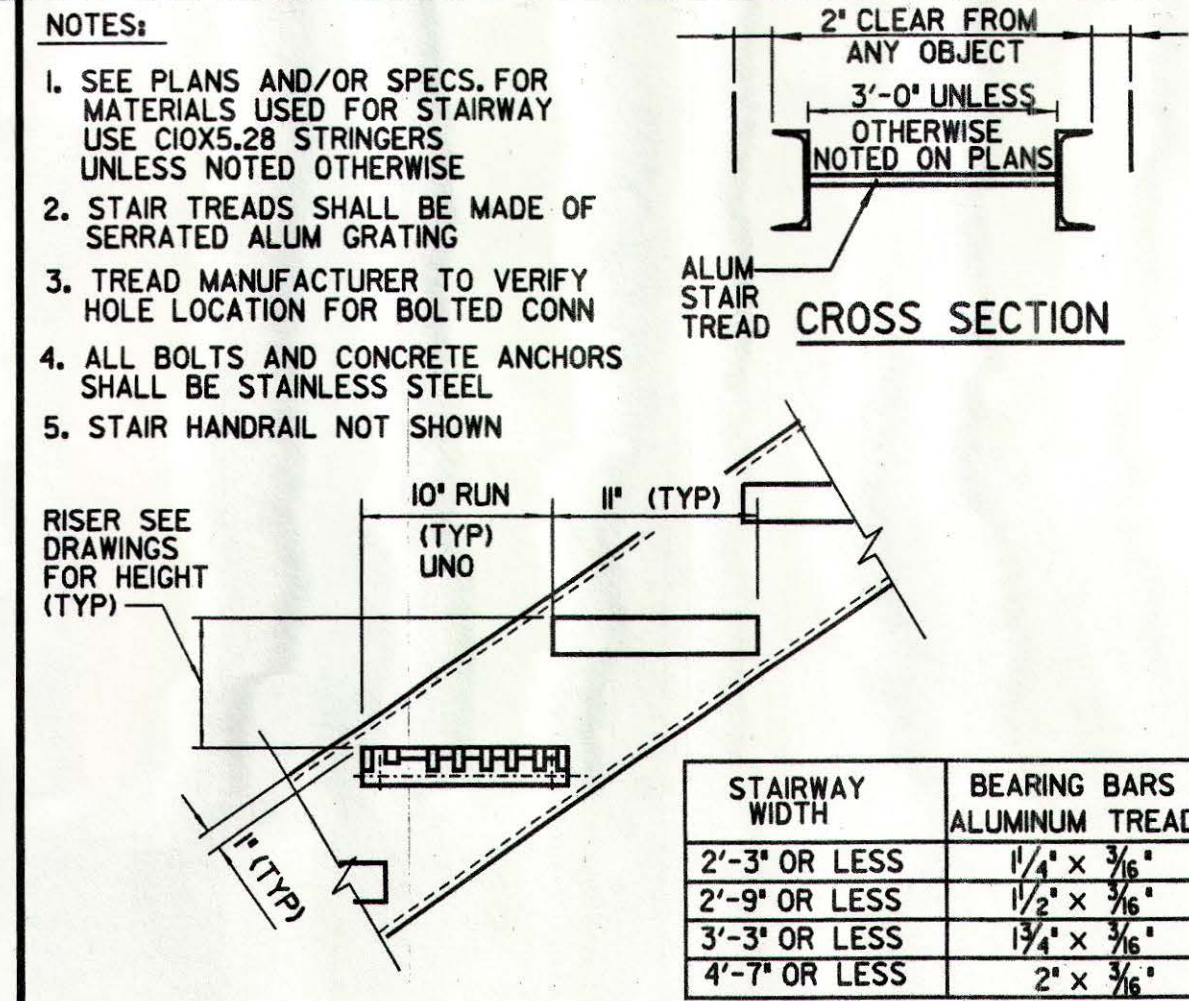

STAIR DETAIL

REV 010196


S-526

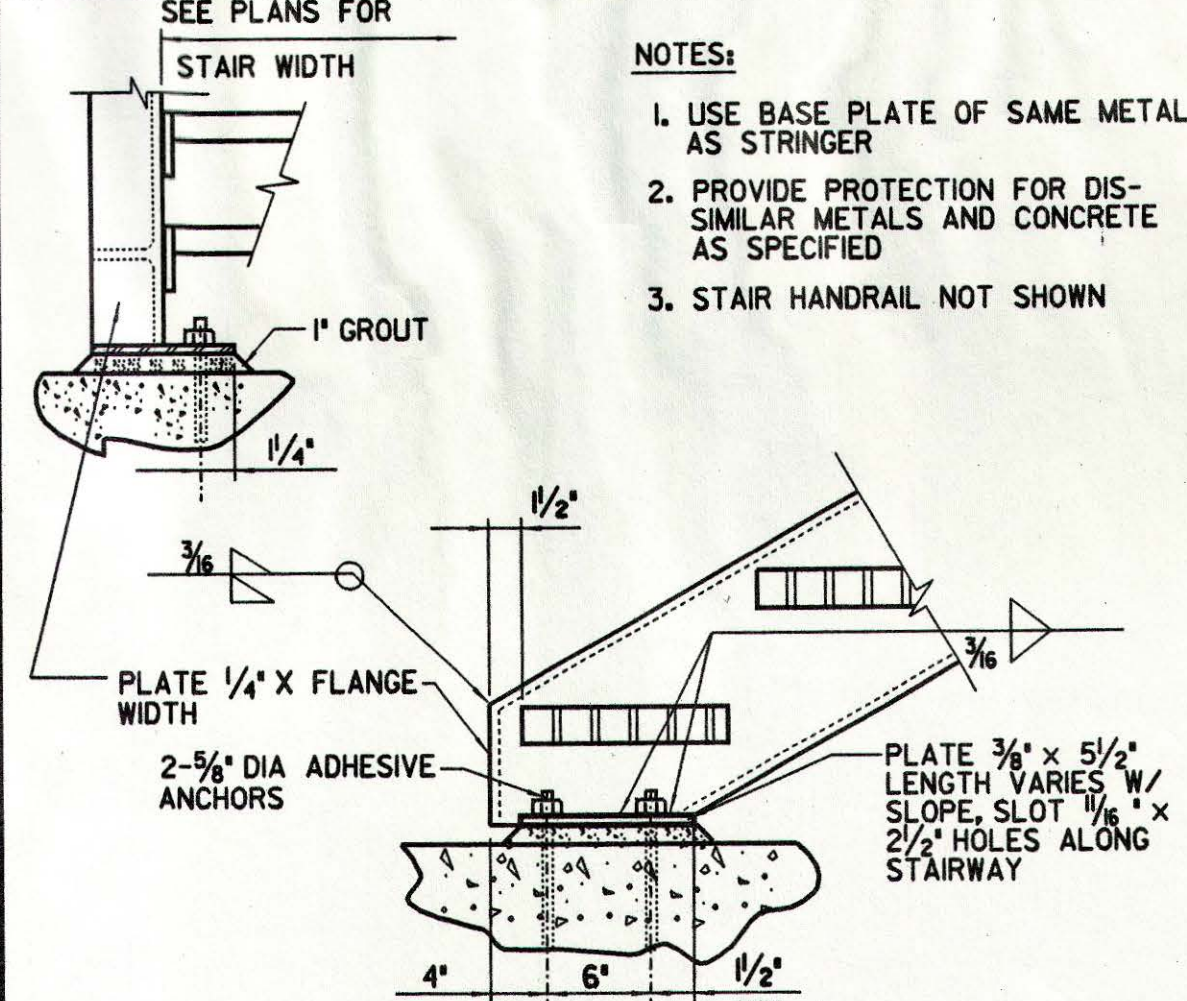

STAIR BOTTOM CONNECTION

REV 010196


S-527

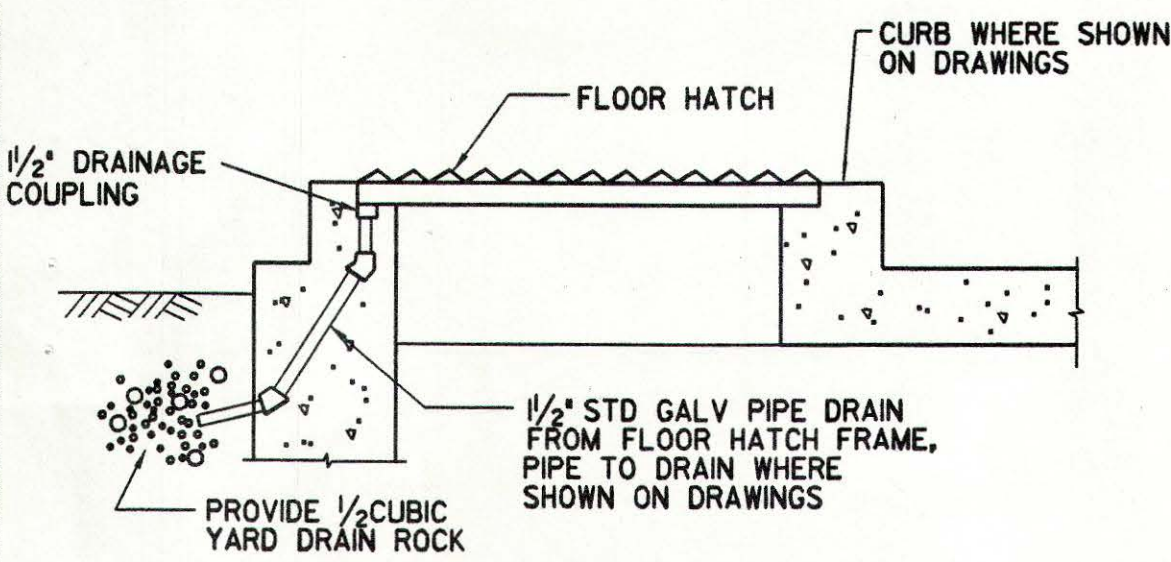

FLOOR HATCH DETAIL

REV 010196

S-531

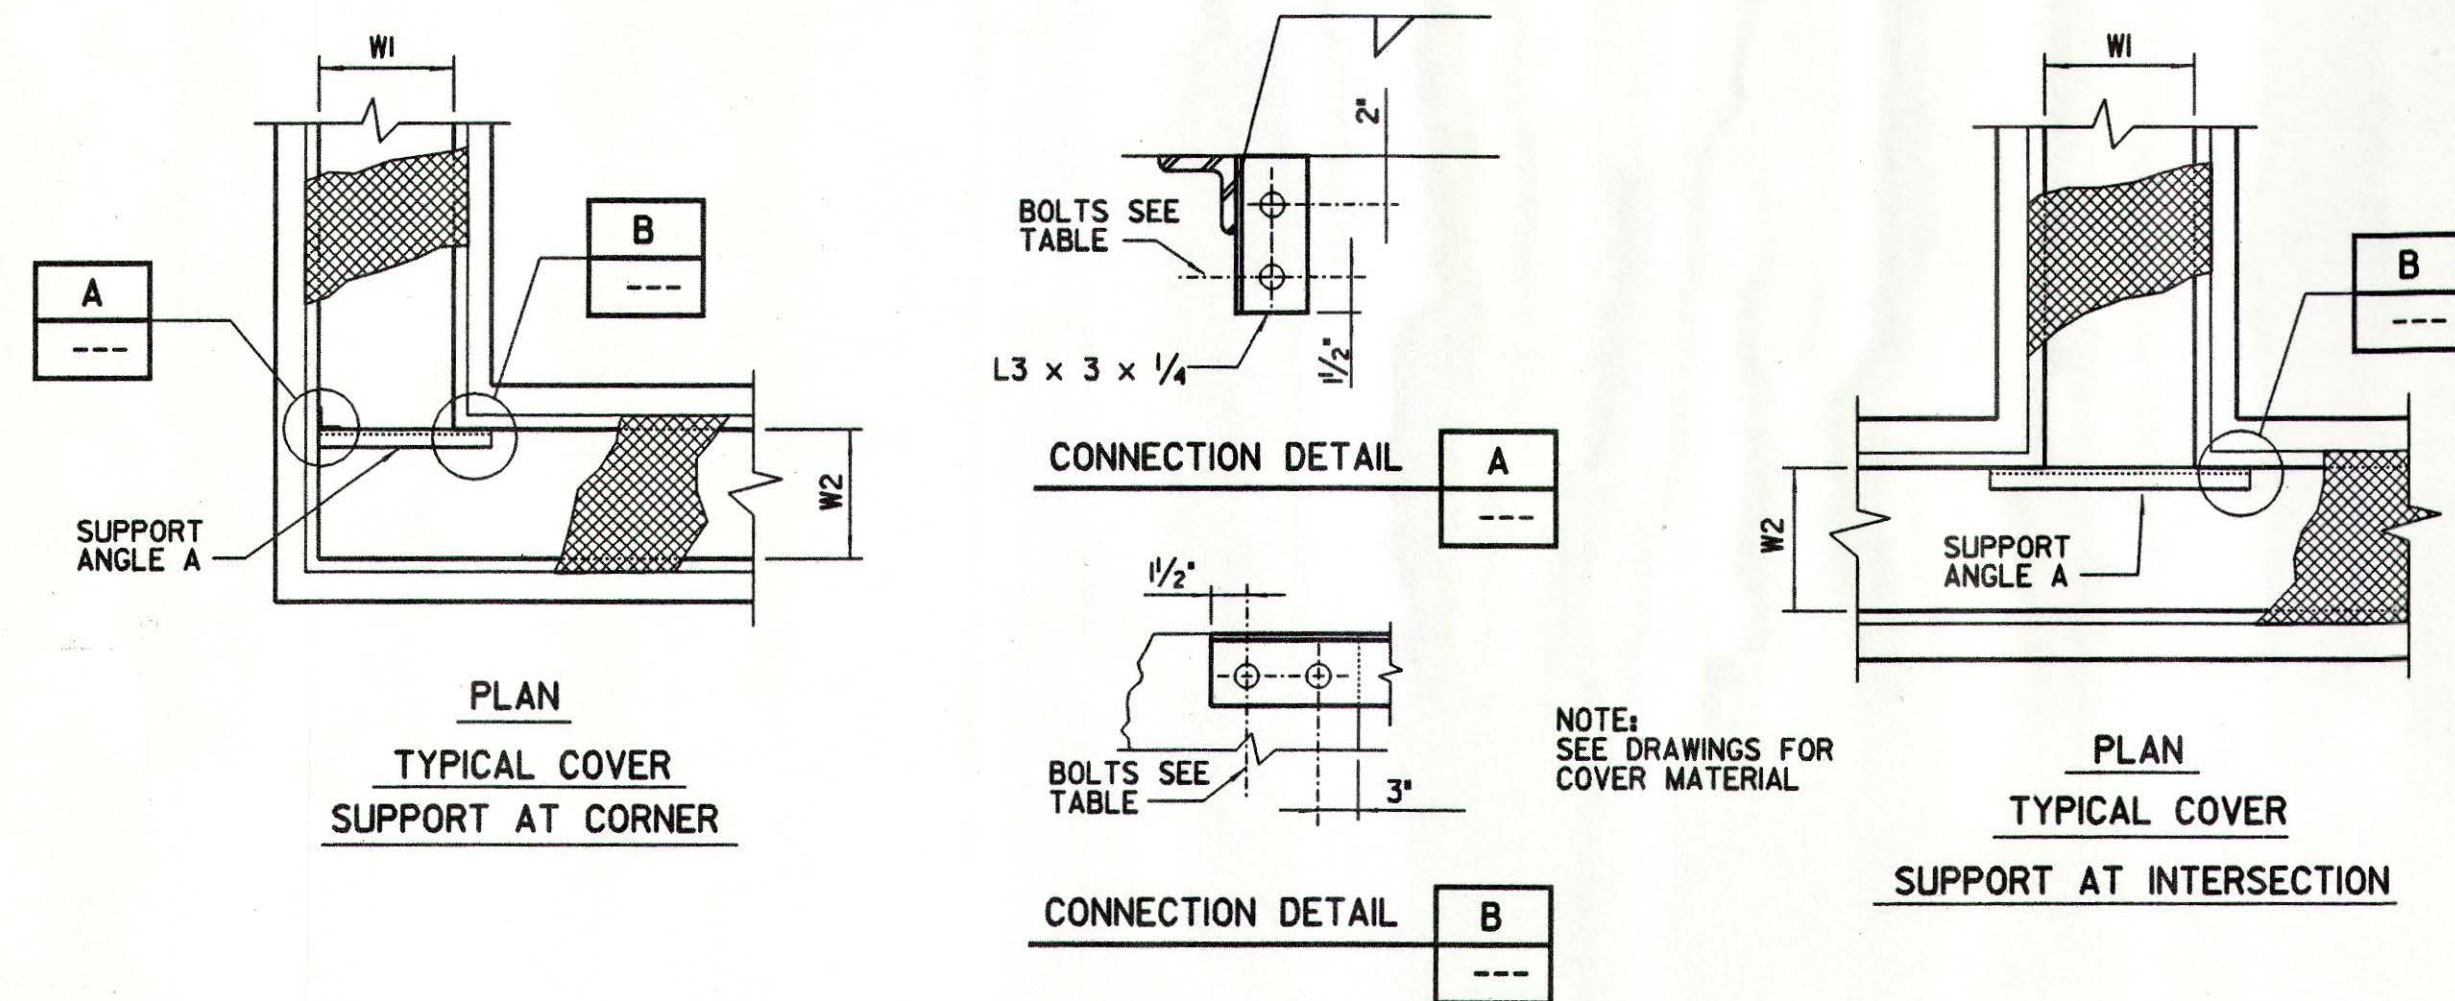


COVER SUPPORTS AT INTERSECTIONS

REV 010196

S-543

W1	W2	A (IN) (LLV)	& SPACING
< 3	< 3	3 x 3 x 1/4	1/2 @ 4 1/2"
3 TO 4 1/2	< 3	4 x 3 x 1/4	1/2 @ 4 1/2"
4 1/2 TO 6	< 3	4 x 3 x 3/8	1/2 @ 4 1/2"
< 3	3 TO 4 1/2	4 x 3 x 1/4	1/2 @ 4 1/2"
3 TO 4 1/2	3 TO 4 1/2	4 x 3 x 3/8	1/2 @ 4 1/2"
4 1/2 TO 6	3 TO 4 1/2	5 x 3 x 3/8	5/8 @ 6"
< 3	4 1/2 TO 6	4 x 3 x 1/4	1/2 @ 4 1/2"
3 TO 4 1/2	4 1/2 TO 6	5 x 3 x 3/8	5/8 @ 6"
4 1/2 TO 6	4 1/2 TO 6	6 x 4 x 3/8	5/8 @ 6"


- NOTES:
1. SUPPORT ANGLES SHALL MATCH COVER MATERIAL UNO
  2. TOP OF SUPPORT ANGLE SHALL BE ALIGNED WITH COVER SEAT
  3. WHERE EMBEDDED COVER SEAT REQUIRES A NEOPRENE GASKET A MATCHING GASKET SHALL BE PROVIDED AT THE SUPPORT ANGLE AND SHALL EXTEND THE FULL WIDTH OF THE ANGLE
  4. THIS DETAIL SHALL APPLY TO METAL GRATING, METAL PLATE COVERS AND PRECAST CONCRETE COVERS NOT THICKER THAN 4 INCHES. THE COVER LIVE LOAD SHALL NOT EXCEED 150 PSF AND THE COVER SPAN SHALL NOT EXCEED 6 FEET
  5. FOR FRP GRATING, THE GRATING SPAN SHALL NOT EXCEED 4.5 FEET AND THE SUPPORT AND CONNECTION ANGLES SHALL BE 4 x 4 x 3/8 FRP CONNECTION BETWEEN FRP ANGLES SHALL BE BY EPOXY BONDING
  6. BOLTS SHALL BE SS CAST-IN-PLACE AB OR ADHESIVE ANCHORS

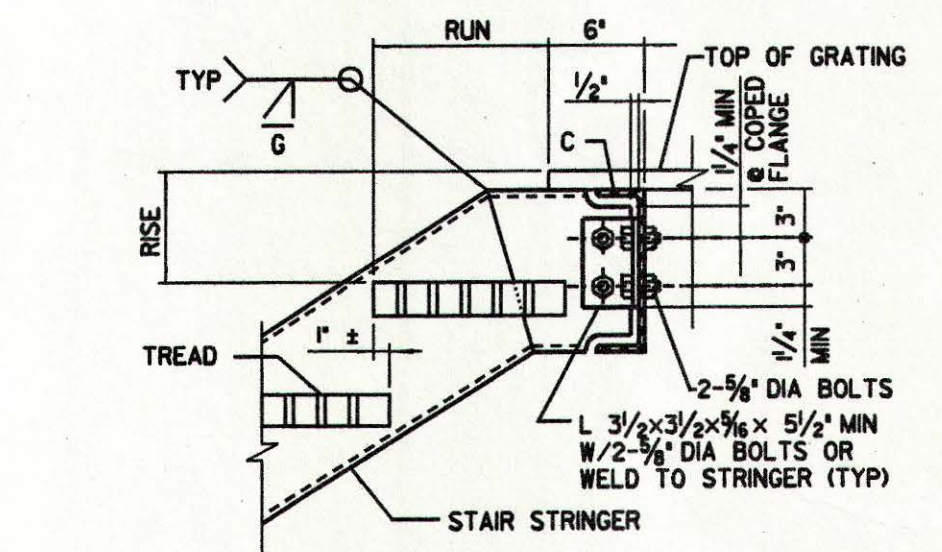

STAIR TOP TO CHANNEL CONNECTION

REV 010196

S-528

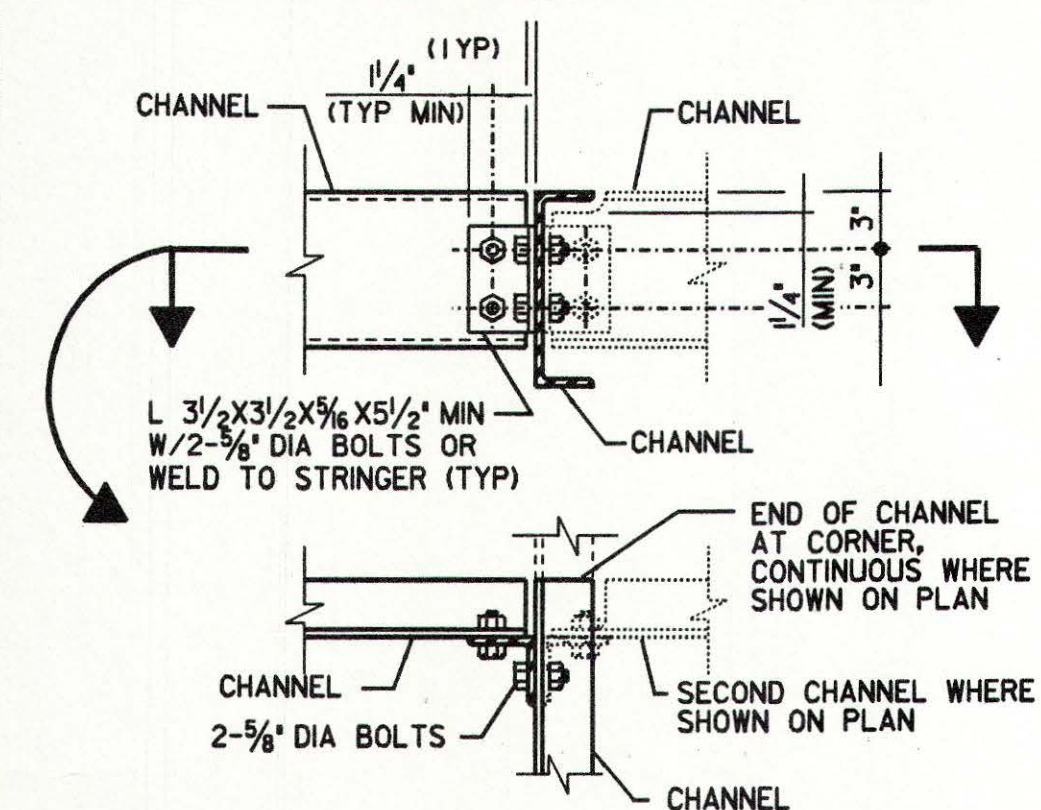


- NOTES:
1. FOR CHANNEL SIZES SEE PLAN
  2. COPE STRINGER MINIMUM AS NEEDED
  3. STANDARD SIZE HOLES UNLESS NOTED OTHERWISE

CHANNEL TO CHANNEL CONNECTION

REV 010196

S-555

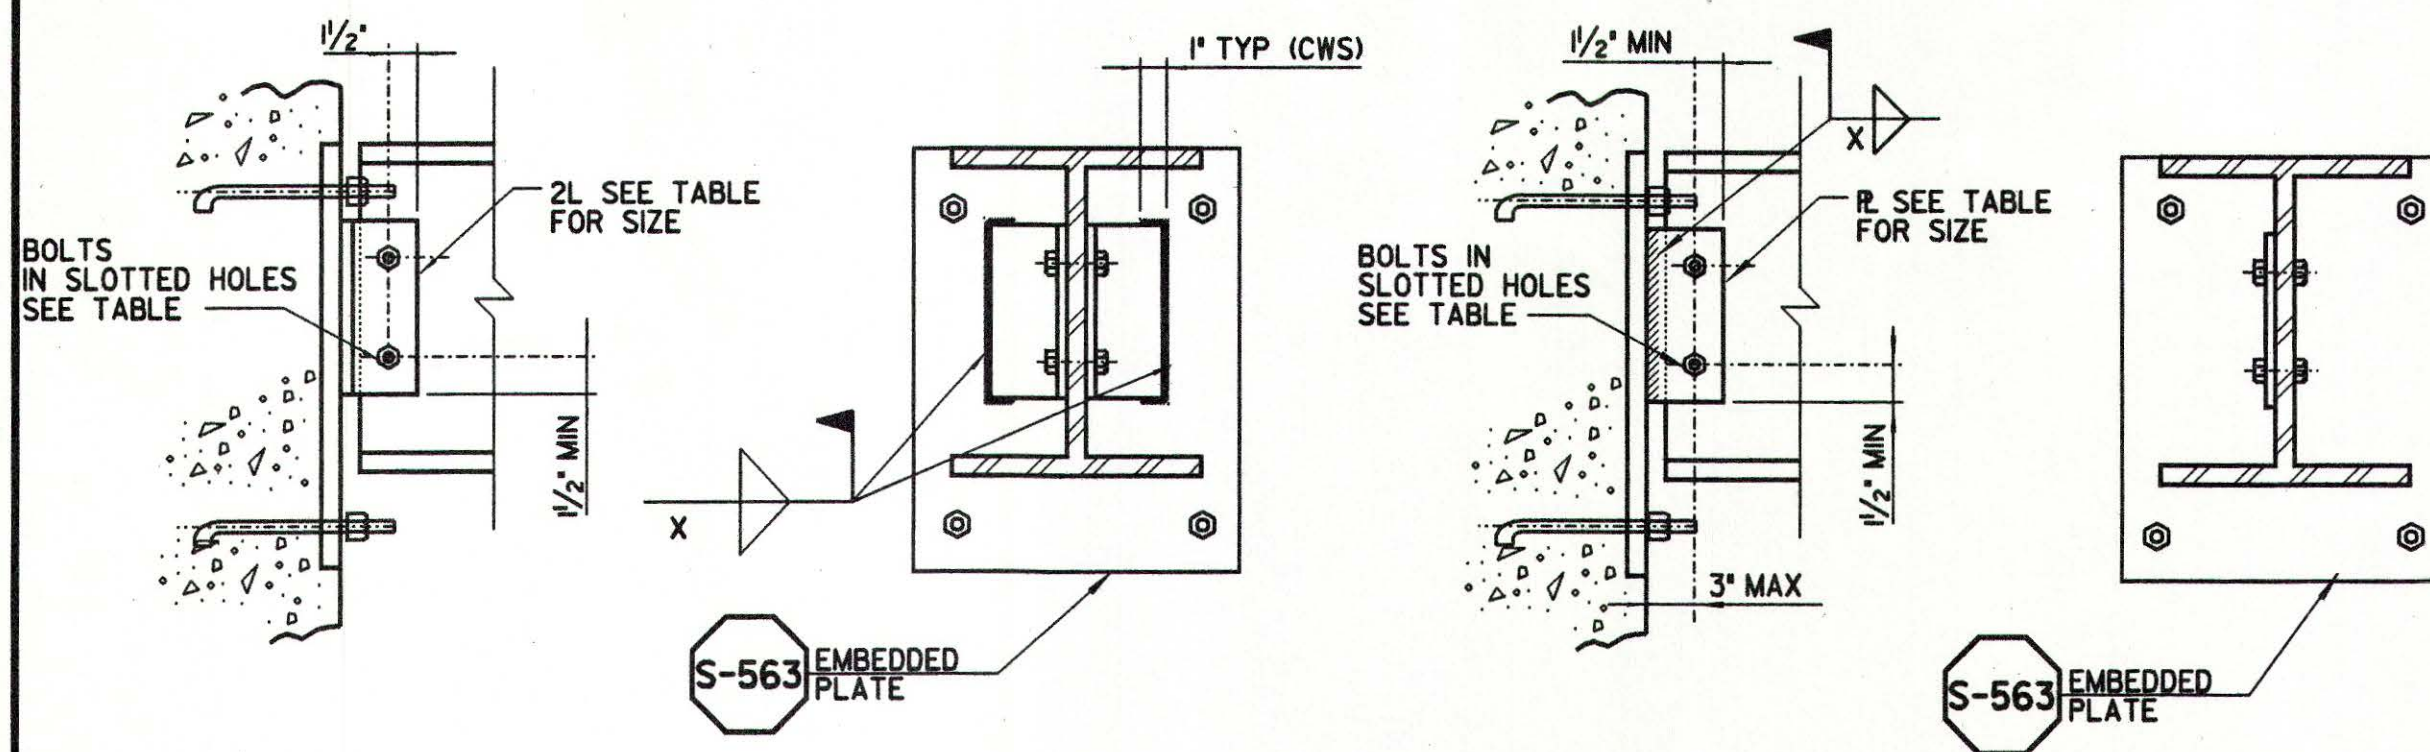

TYPE A CONNECTION

TYPE B CONNECTION

- NOTES:
1. ALL CONNECTIONS ARE BEARING TYPE UNLESS NOTED OTHERWISE
  2. PROVIDE 2" DIA WASHERS

BEAM SIZE	ANGLE OR PLATE SIZE	CONN TYPE	# OF BOLTS	BOLT SPACING	EMBEDDED PLATE THICKNESS	WELD SIZE X
W8, W10	3/8"	B	2	3"	1/2"	1/4"
W12, W14	3/8"	B	3	3"	5/8"	5/8"
W16, W18	3/8"	A	4	3"	5/8"	5/8"
W21, W24	3/8"	A	6	3"	3/4"	3/8"
W27	3/8"	A	8	3"	3/4"	3/8"


TYPICAL BEAM TO CONCRETE CONNECTION

REV 010196

S-560

The limited review of this document by PBS & J on behalf of the Olivenhain Municipal Water District, is intended as a limited review only for general conformance with; (1) This approved Design/Build documents, (2) Accepted standards of practice within the industry, and (3) The standards of the Olivenhain Municipal Water District. This limited review in no way is intended, nor shall it act, to relieve the Design/Build Team of any professional liability to the responsibility to provide a complete and functional facility that is compliant with all applicable specifications, standards, codes, and regulations.

PBS & J  
Date: 8/23/01 By: [Signature]

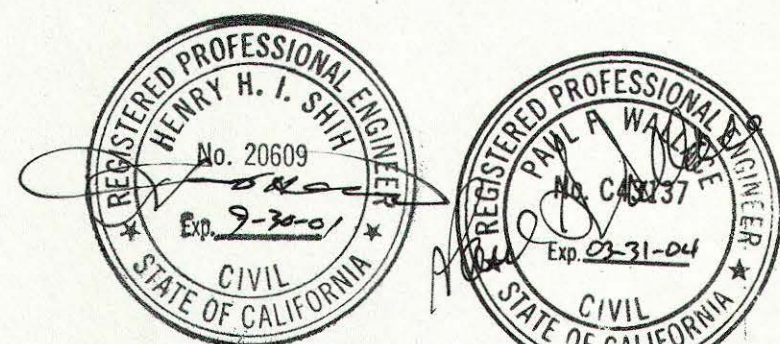

**MONTGOMERY WATSON**  
Pasadena, California

APPROVED  
[Signature]  
OLIVENHAIN MWD  
APPROVED  
FILANC CONSTRUCTION CO.

8.29.01  
DATE

**KELWOOD DEVELOPMENT COMPANY**  
4S RANCH SANITATION DISTRICT  
WASTEWATER TREATMENT PLANT EXPANSION TO 2.0 MGD

STANDARD DETAILS VI

SHEET

GS-7

OF 5 SHEETS










# ROOF FRAMING PLAN


SCALE: 1/4"=1'-0"

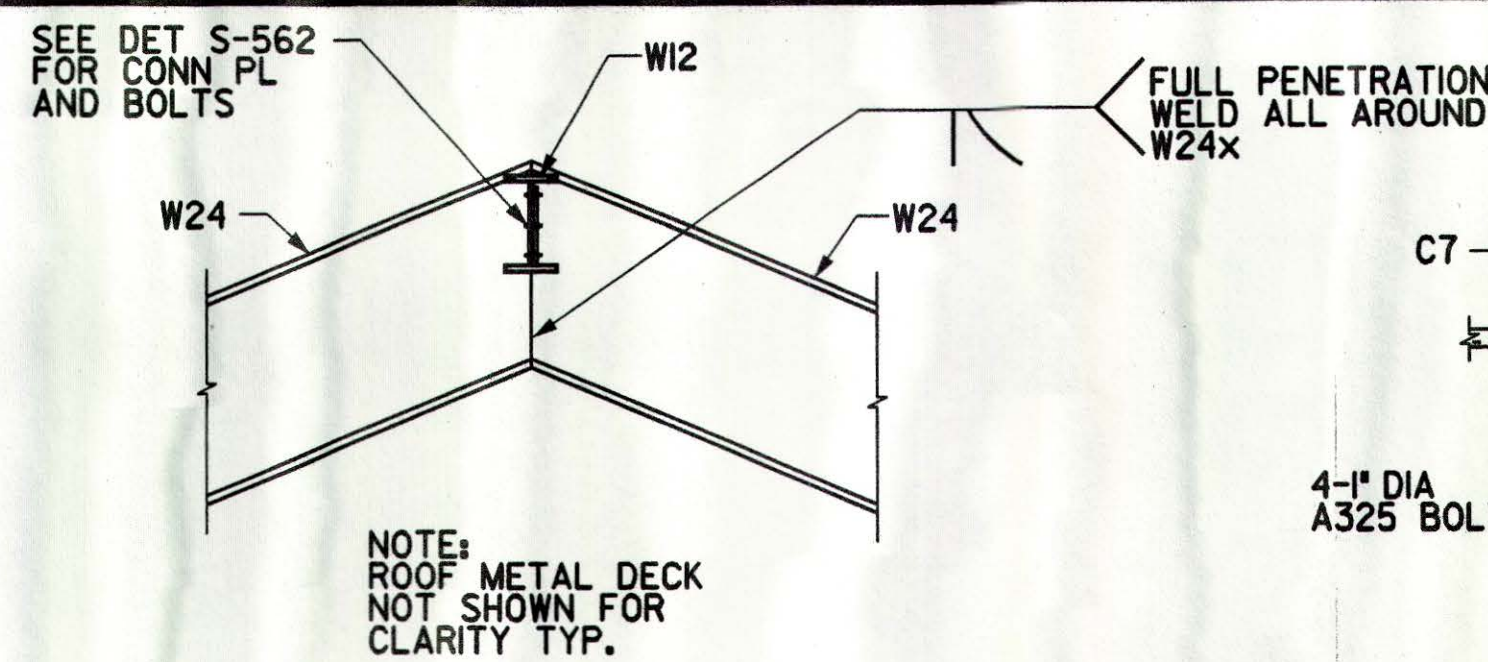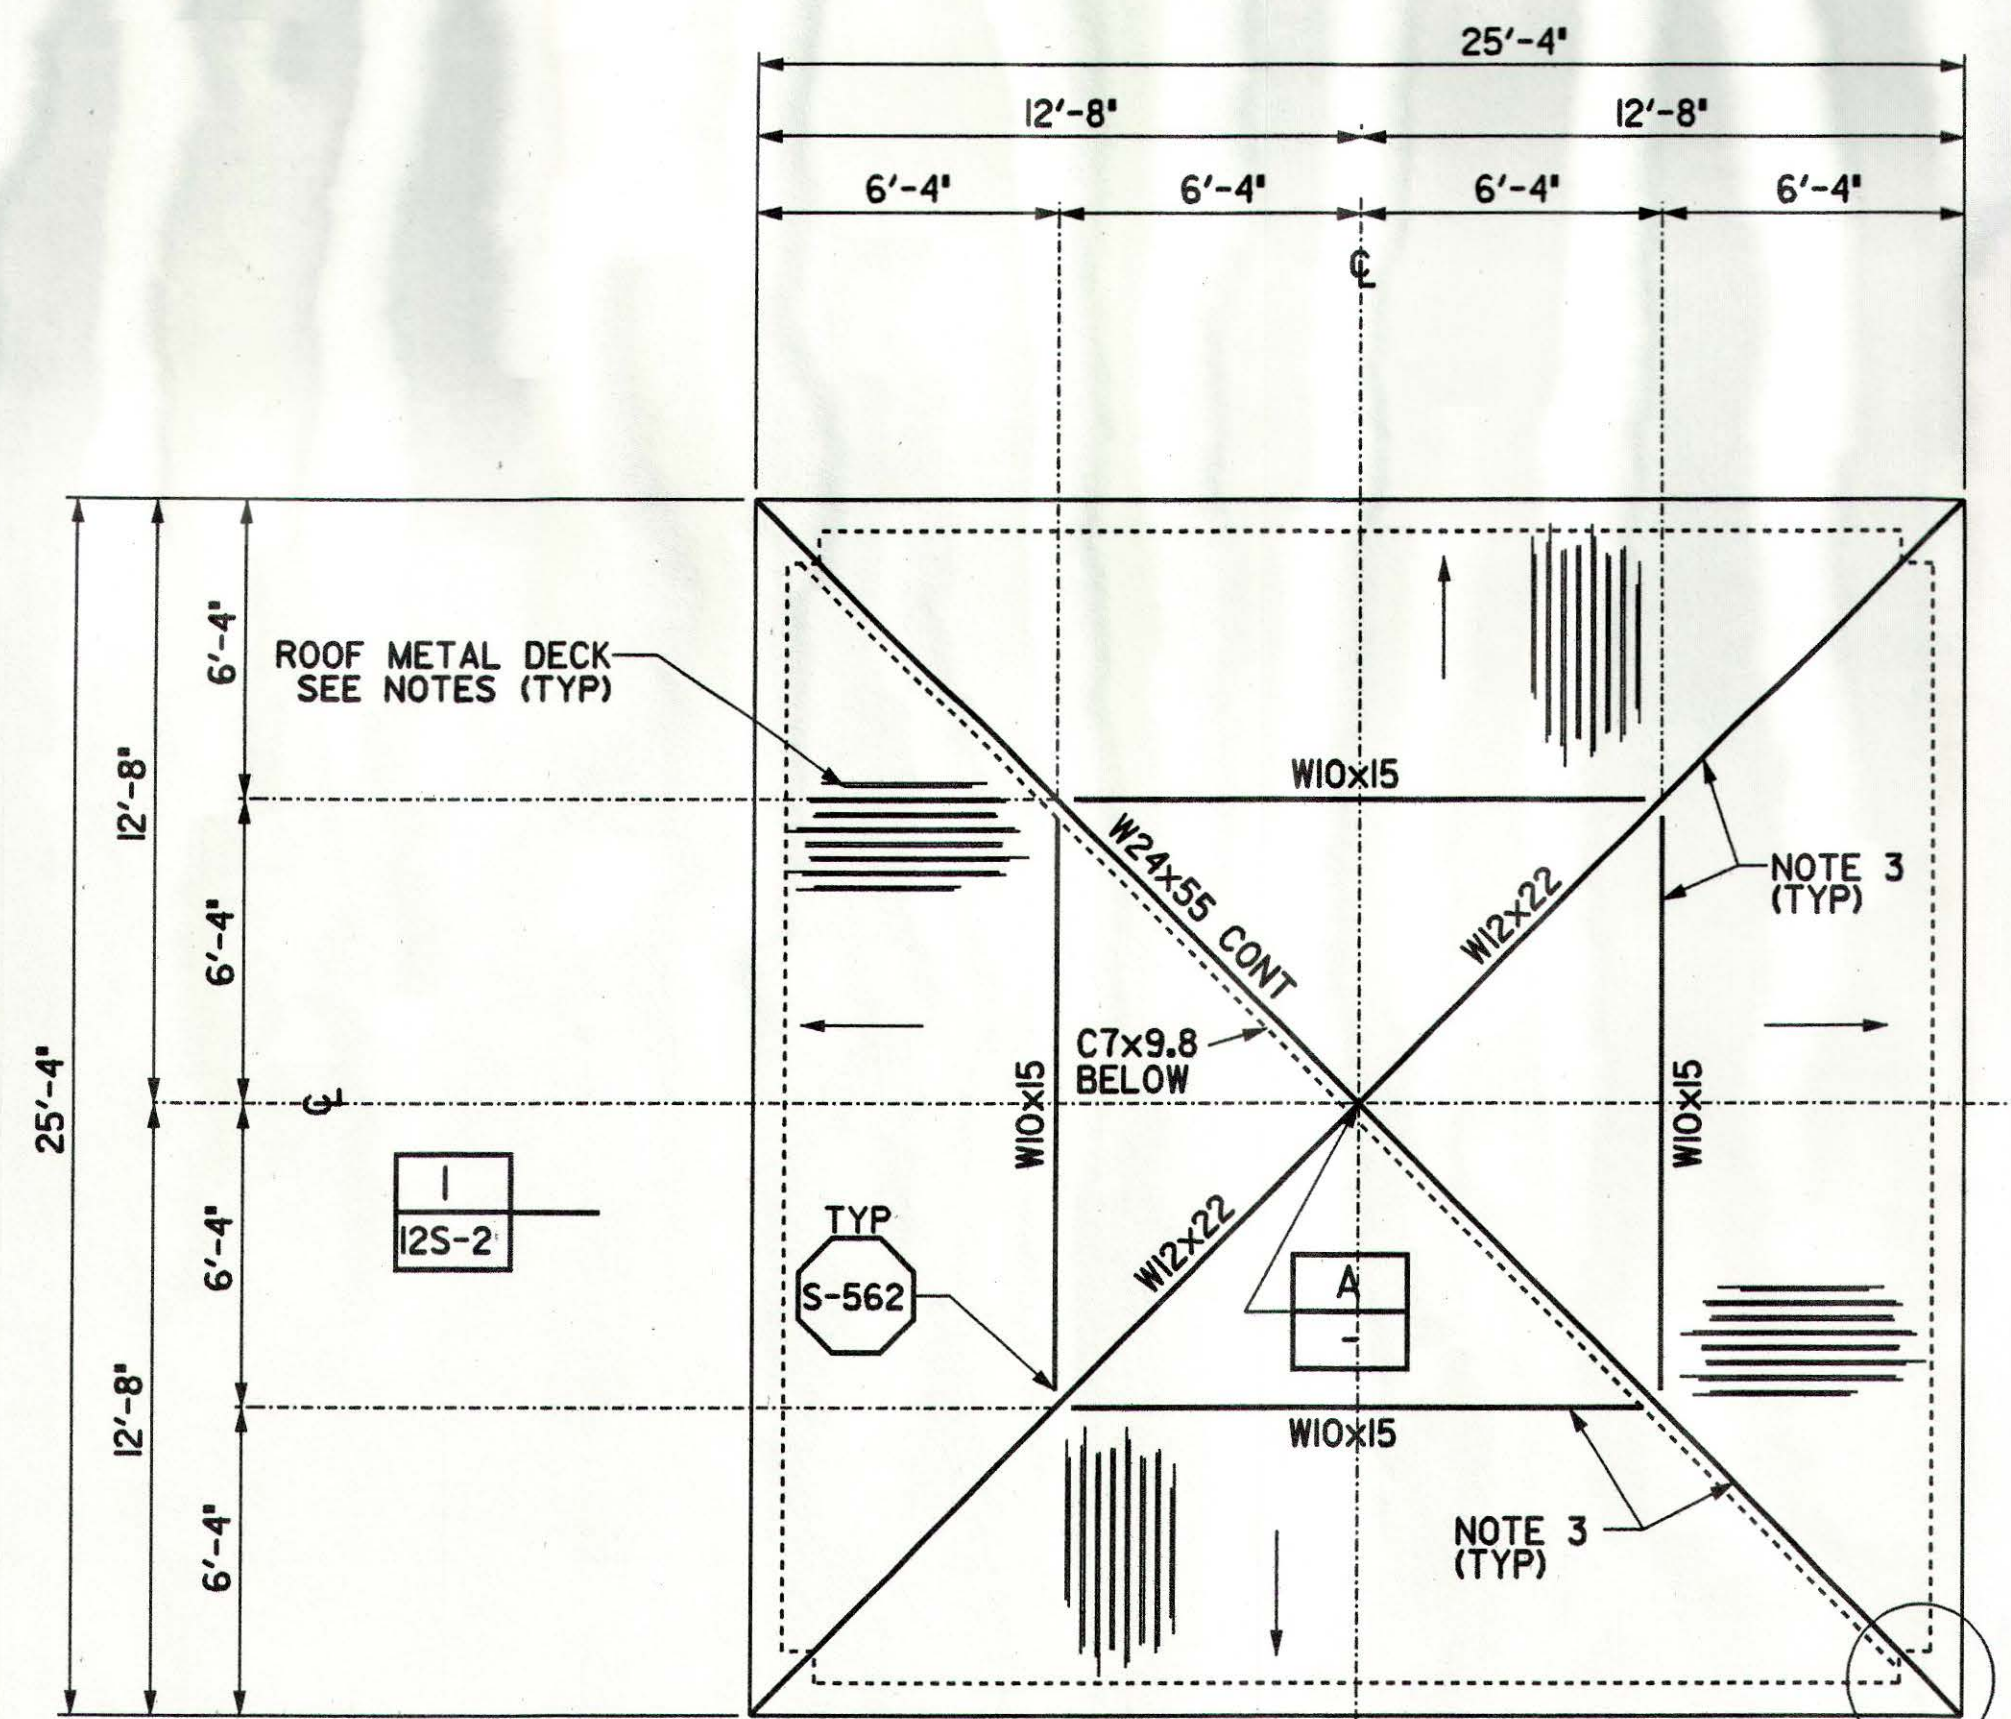

DETAIL A  
SCALE: 1/2"=1'-0"

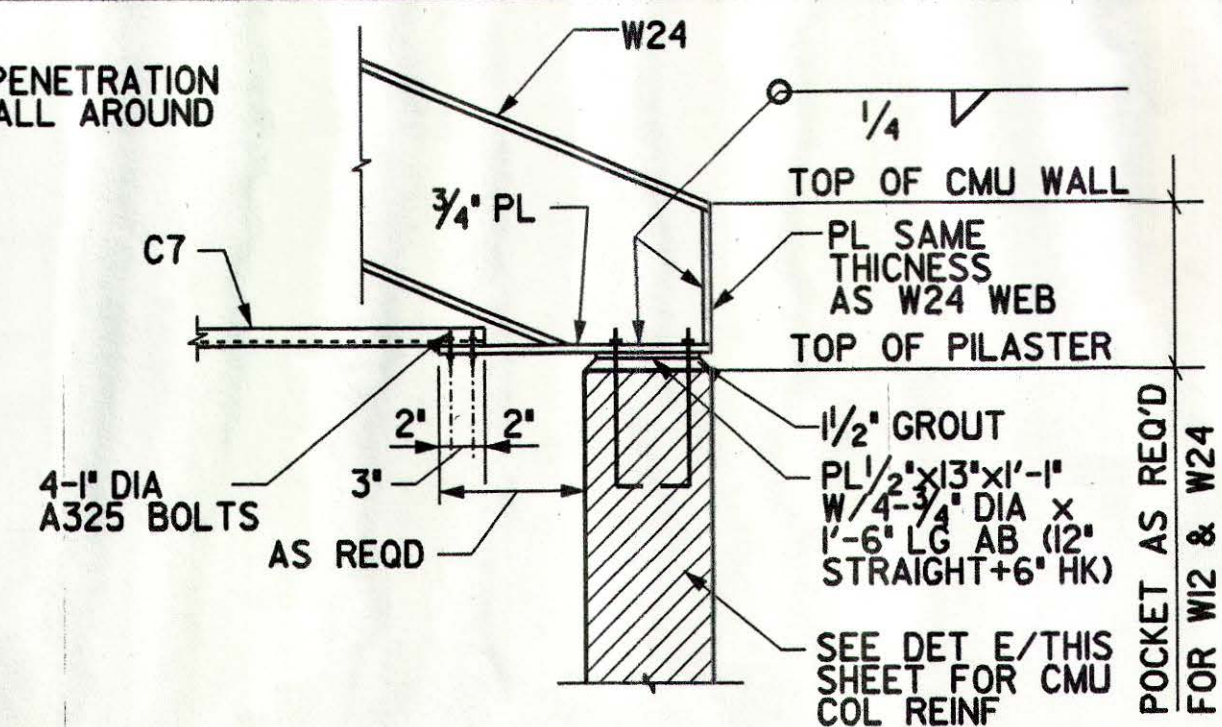


DETAIL B  
SCALE: 1/2"=1'-0"

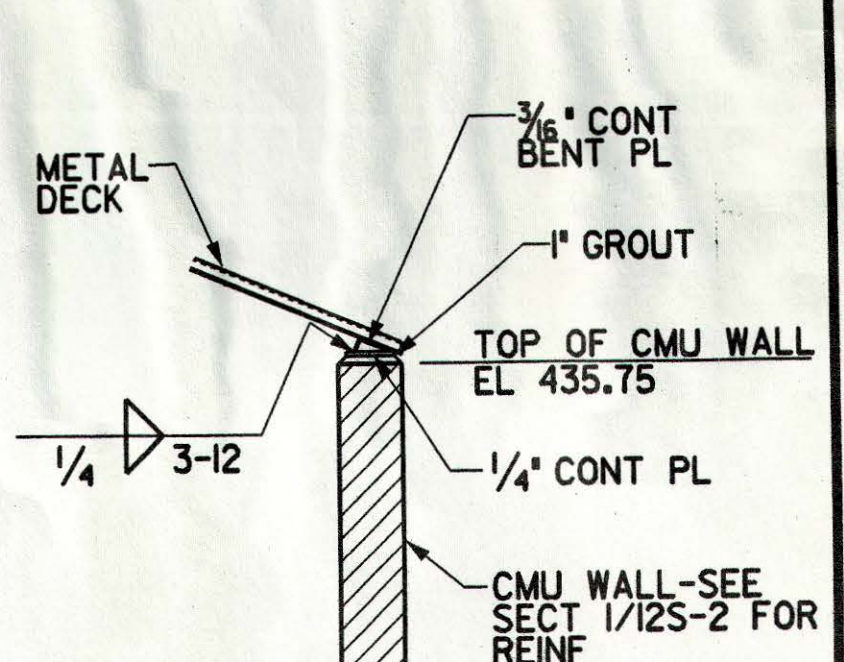


DETAIL C  
SCALE: 1/2"=1'-0"

## NOTES:

- SEE DWGS GS-1 THRU GS-8 FOR STRUCTURAL GENERAL NOTES AND STANDARD DETAILS.
- ROOF METAL DECK SHALL BE 1/2" x 18 GA. GALV TYPE HSB-36 BY VERO OR APPROVED EQUAL.  
DECK WELDING: PROVIDE 5 WELDS PER SHEET TO SUPPORTS. SIDE LAP BUTT PUNCH WELDS @ 12" OC AND ALL AROUND BOUNDARIES @ 12" OC.
- PROVIDE 3/8" CONT BENT PL ON TOP OF BM FOR METAL DECK SUPPORT. WELD TO TOP FLANGE OF BM W/ 3/8" WELDS, 3" LONG @ 12" OC ON BOTH SIDES (TYP).
- (\*) COORDINATE DIMENSIONS WITH MECH DWGS.

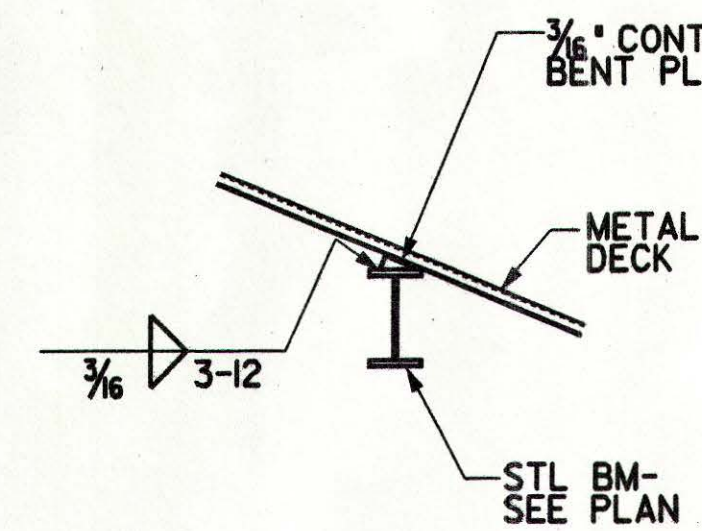


DETAIL D  
SCALE: 1/2"=1'-0"

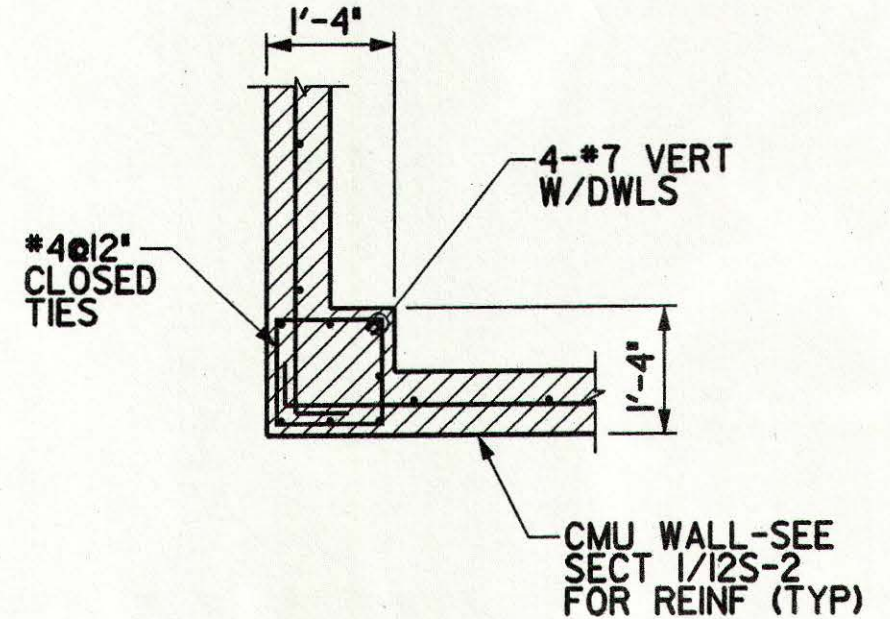

DETAIL E  
SCALE: 1/2"=1'-0"


# FOUNDATION AND FLOOR PLAN

SCALE: 1/4"=1'-0"

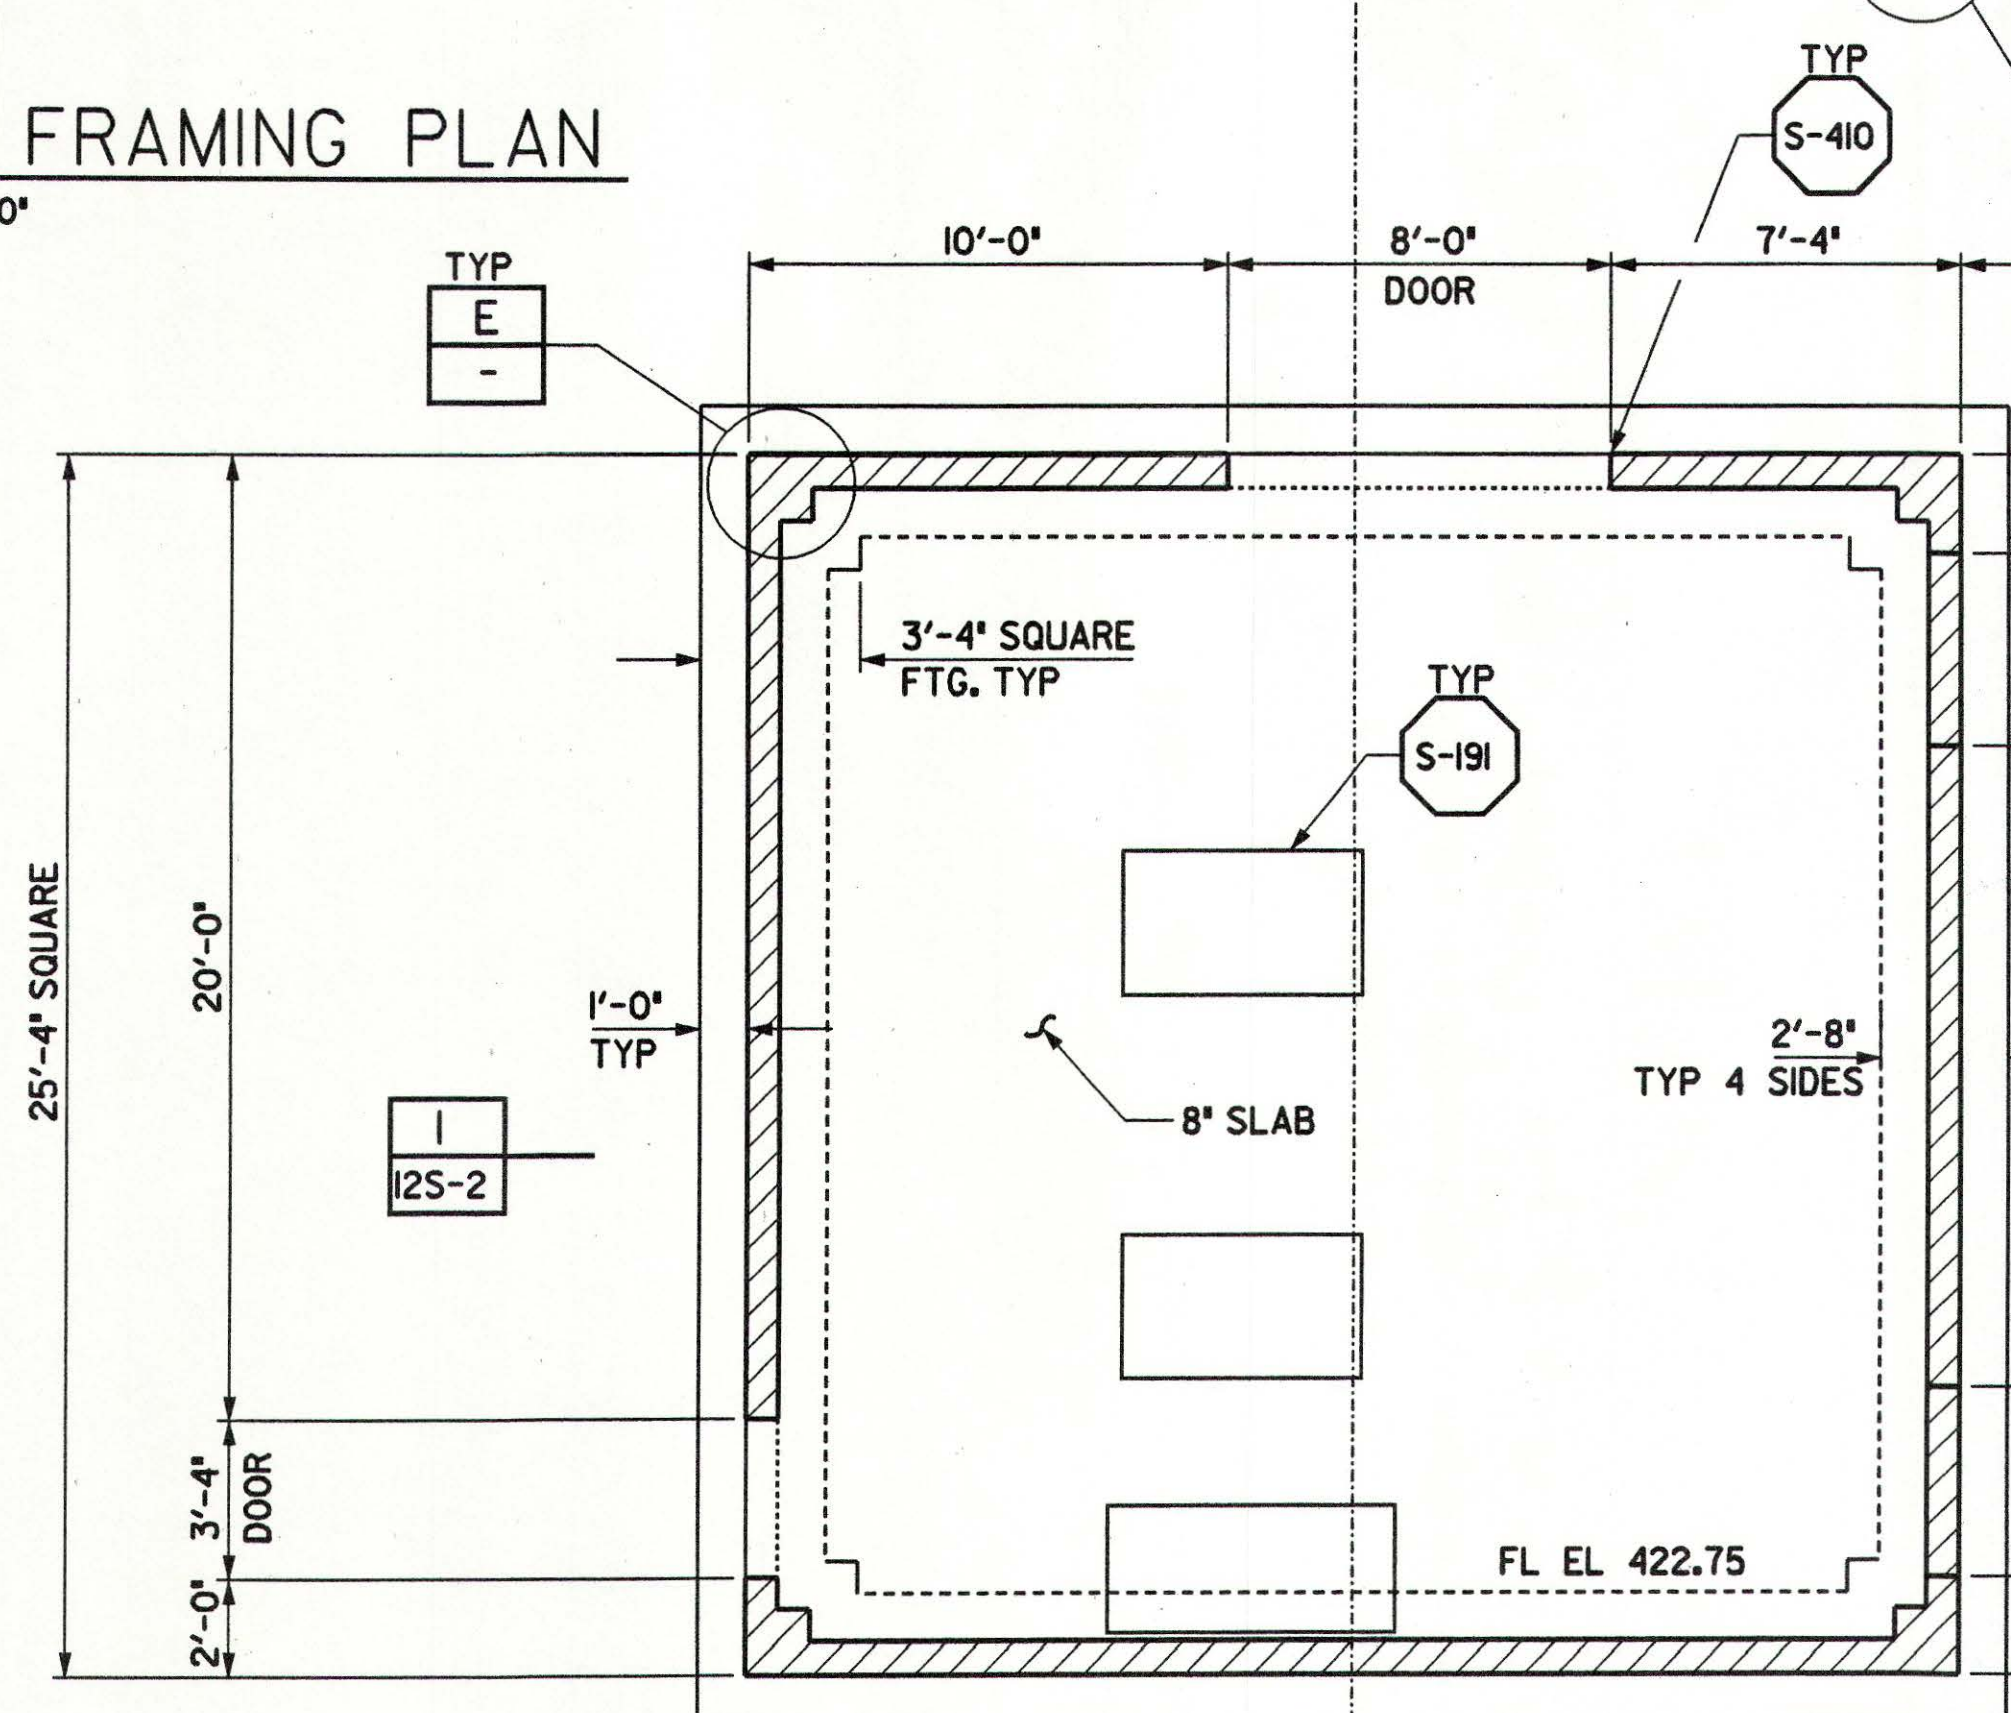



# WET WELL TOP PLAN

SCALE: 1/4"=1'-0"

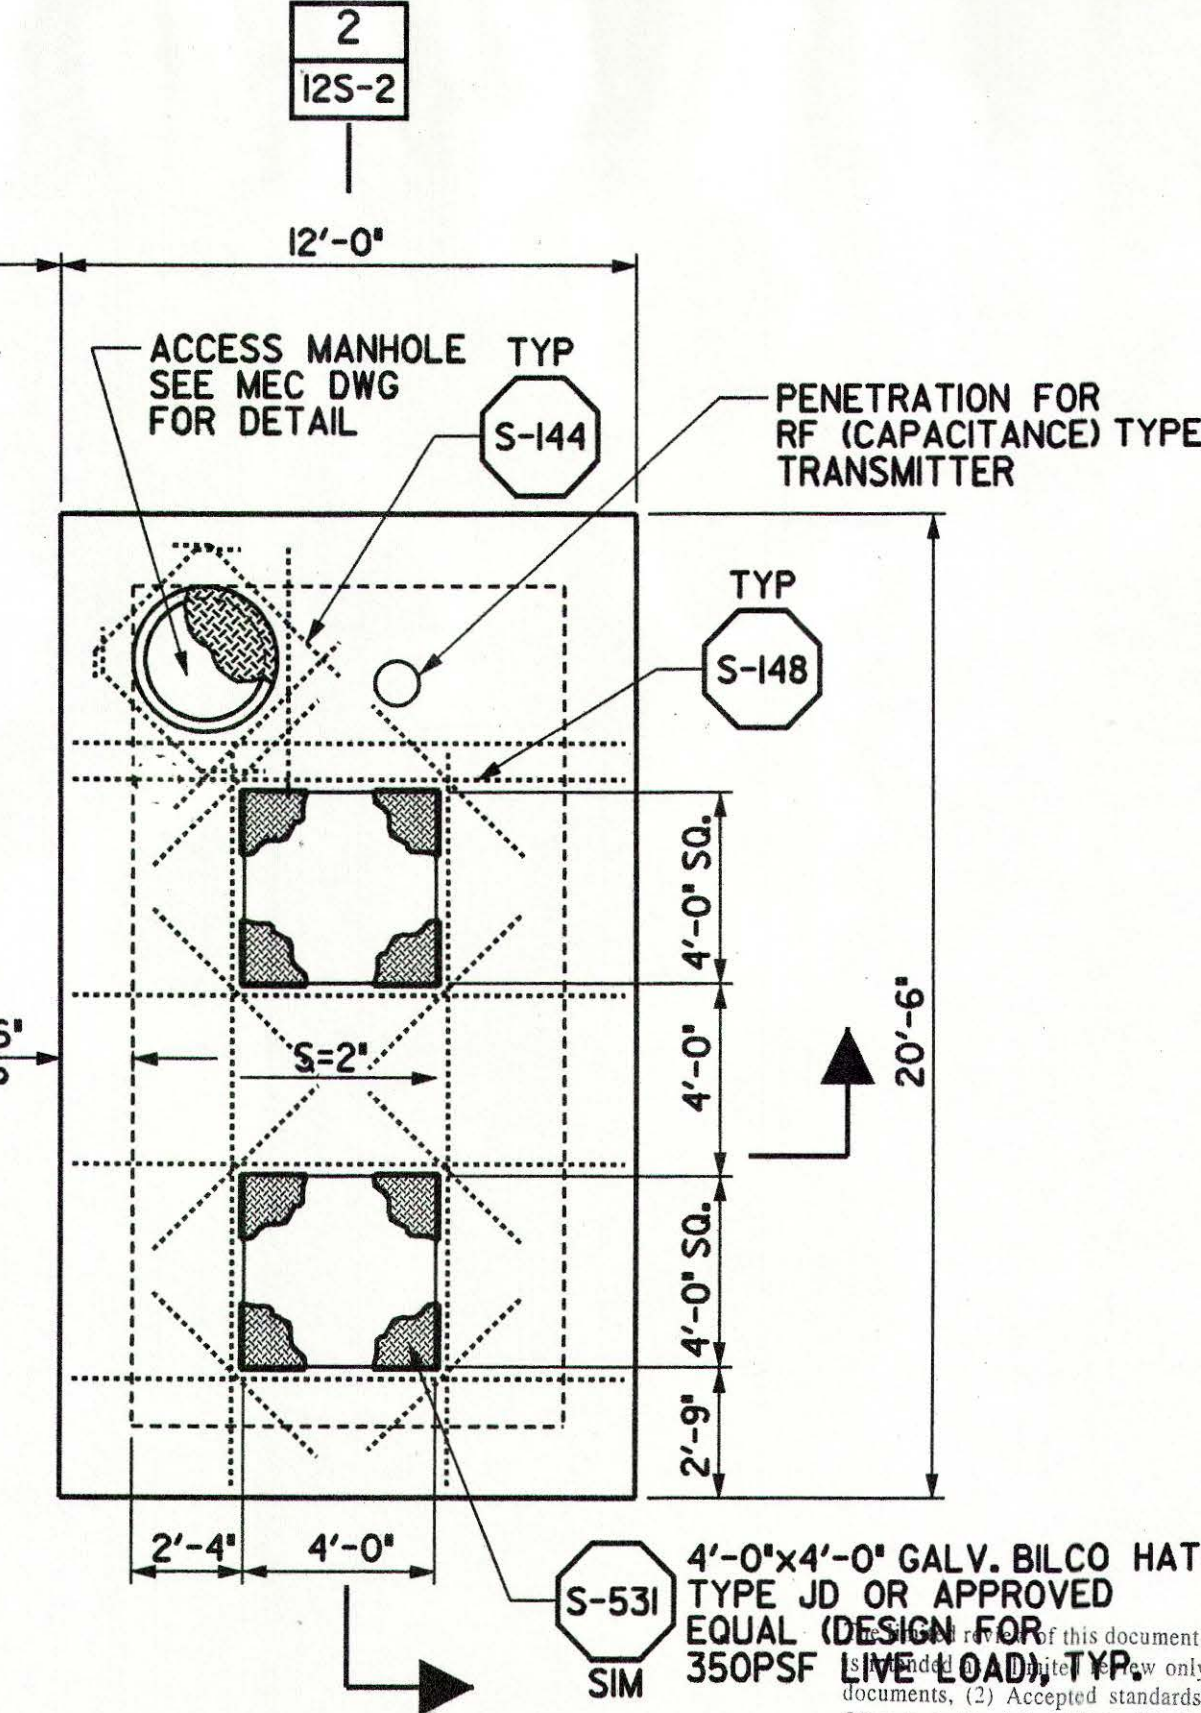

# WET WELL BOTTOM PLAN

SCALE: 1/4"=1'-0"

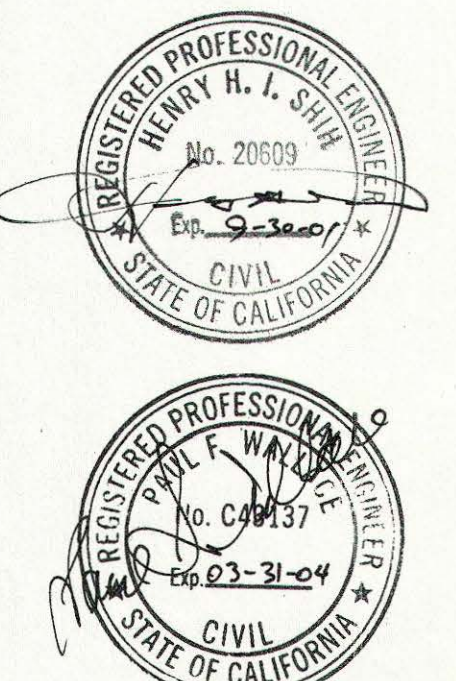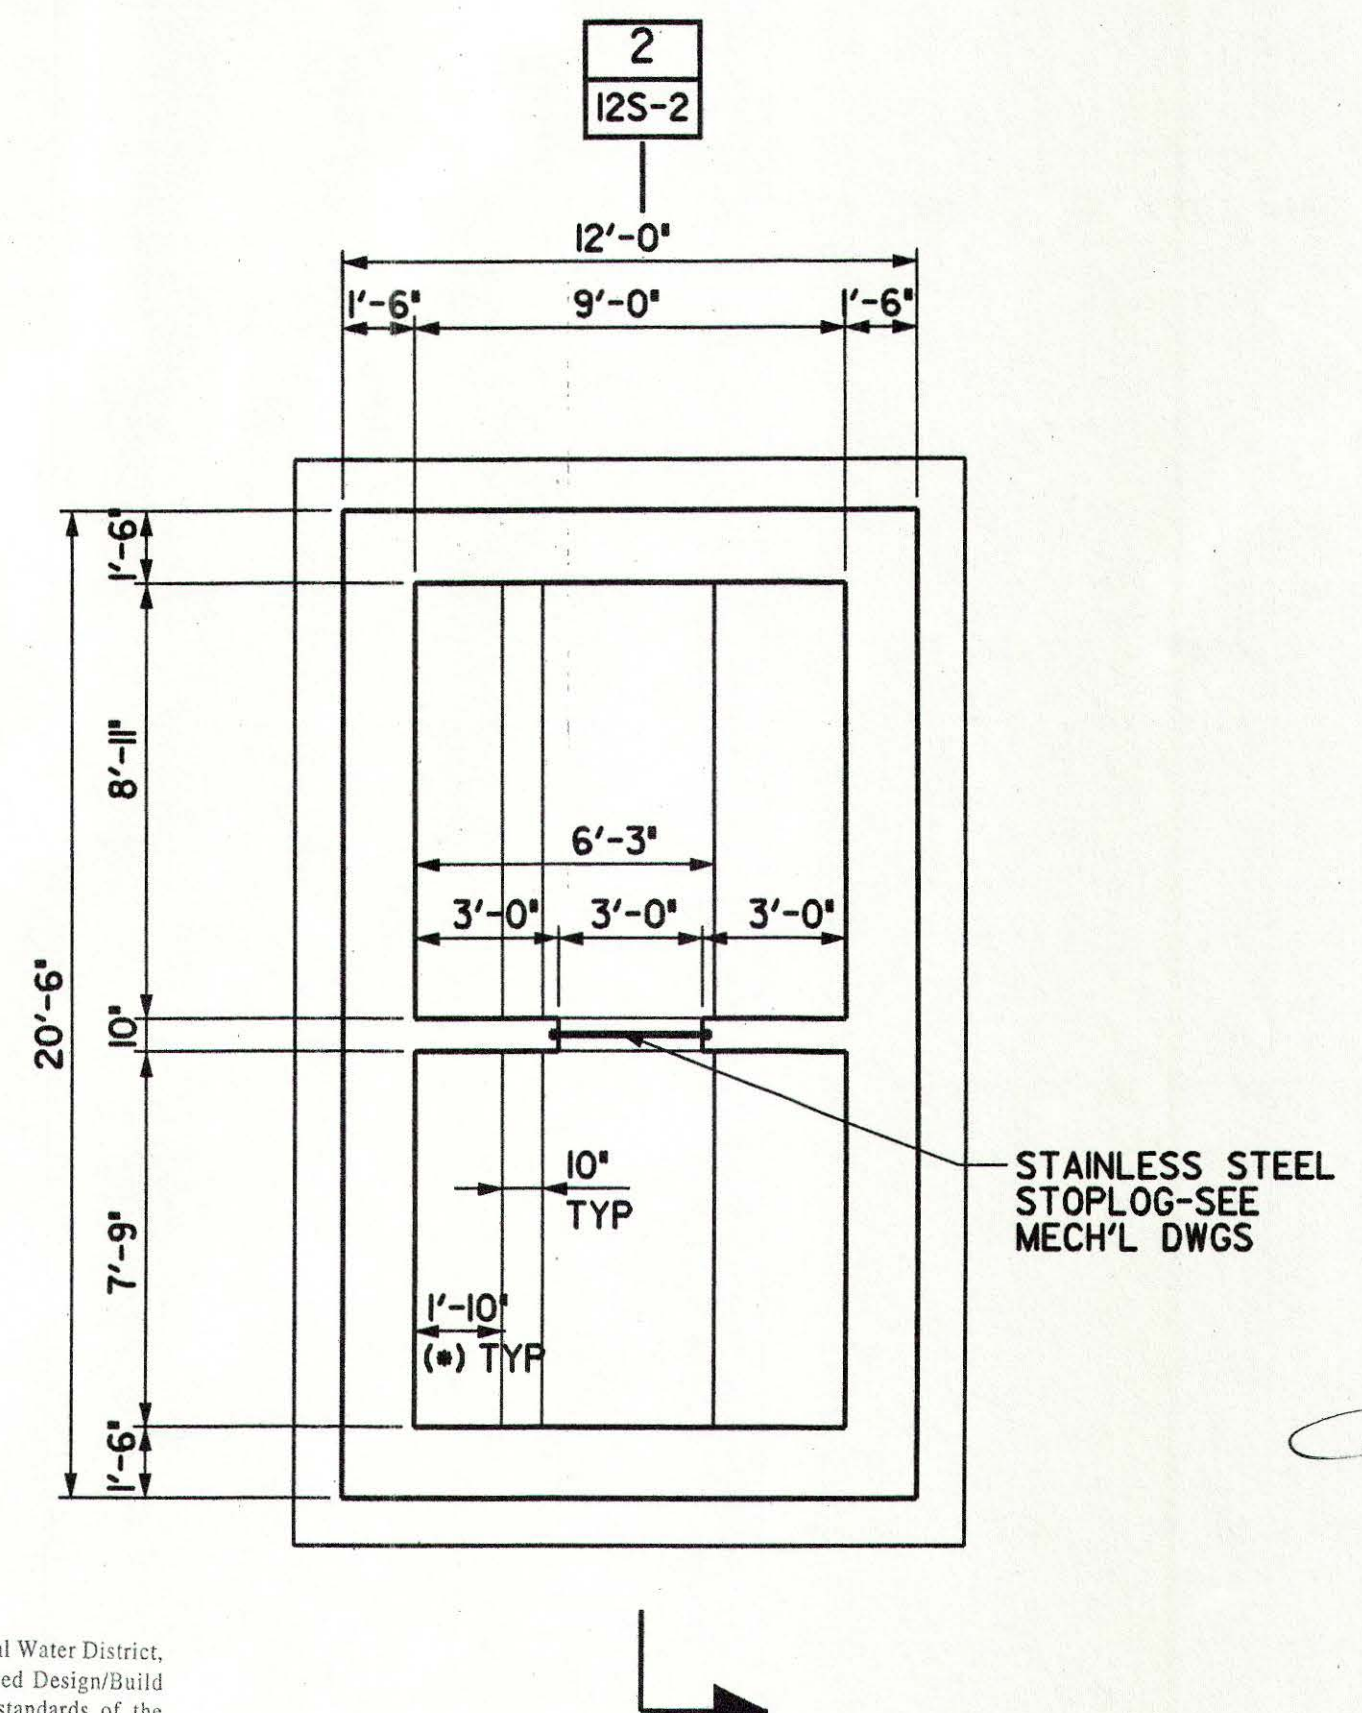

REV	DATE	BY	OMWD	DESCRIPTION

SCALE	AS SHOWN
WARNING	IF THIS BAR DOES NOT MEASURE 1" THEN DRAWING IS NOT TO SCALE
DESIGNED	H. SHIH
DRAWN	J. TRAN
CHECKED	C. LEE

SUBMITTED BY	PROJECT MANAGER	DATE




**MONTGOMERY WATSON**  
Pasadena, California

APPROVED  
OLIVENHAIN MWD  
APPROVED  
DATE: 8/29/01

KELWOOD DEVELOPMENT COMPANY  
4S RANCH SANITATION DISTRICT  
WASTEWATER TREATMENT PLANT EXPANSION TO 2.0 MGD  
NEIGHBORHOOD NO.1 PUMP STATION  
PLANS

SHEET  
12S-1  
OF 5 SHEETS



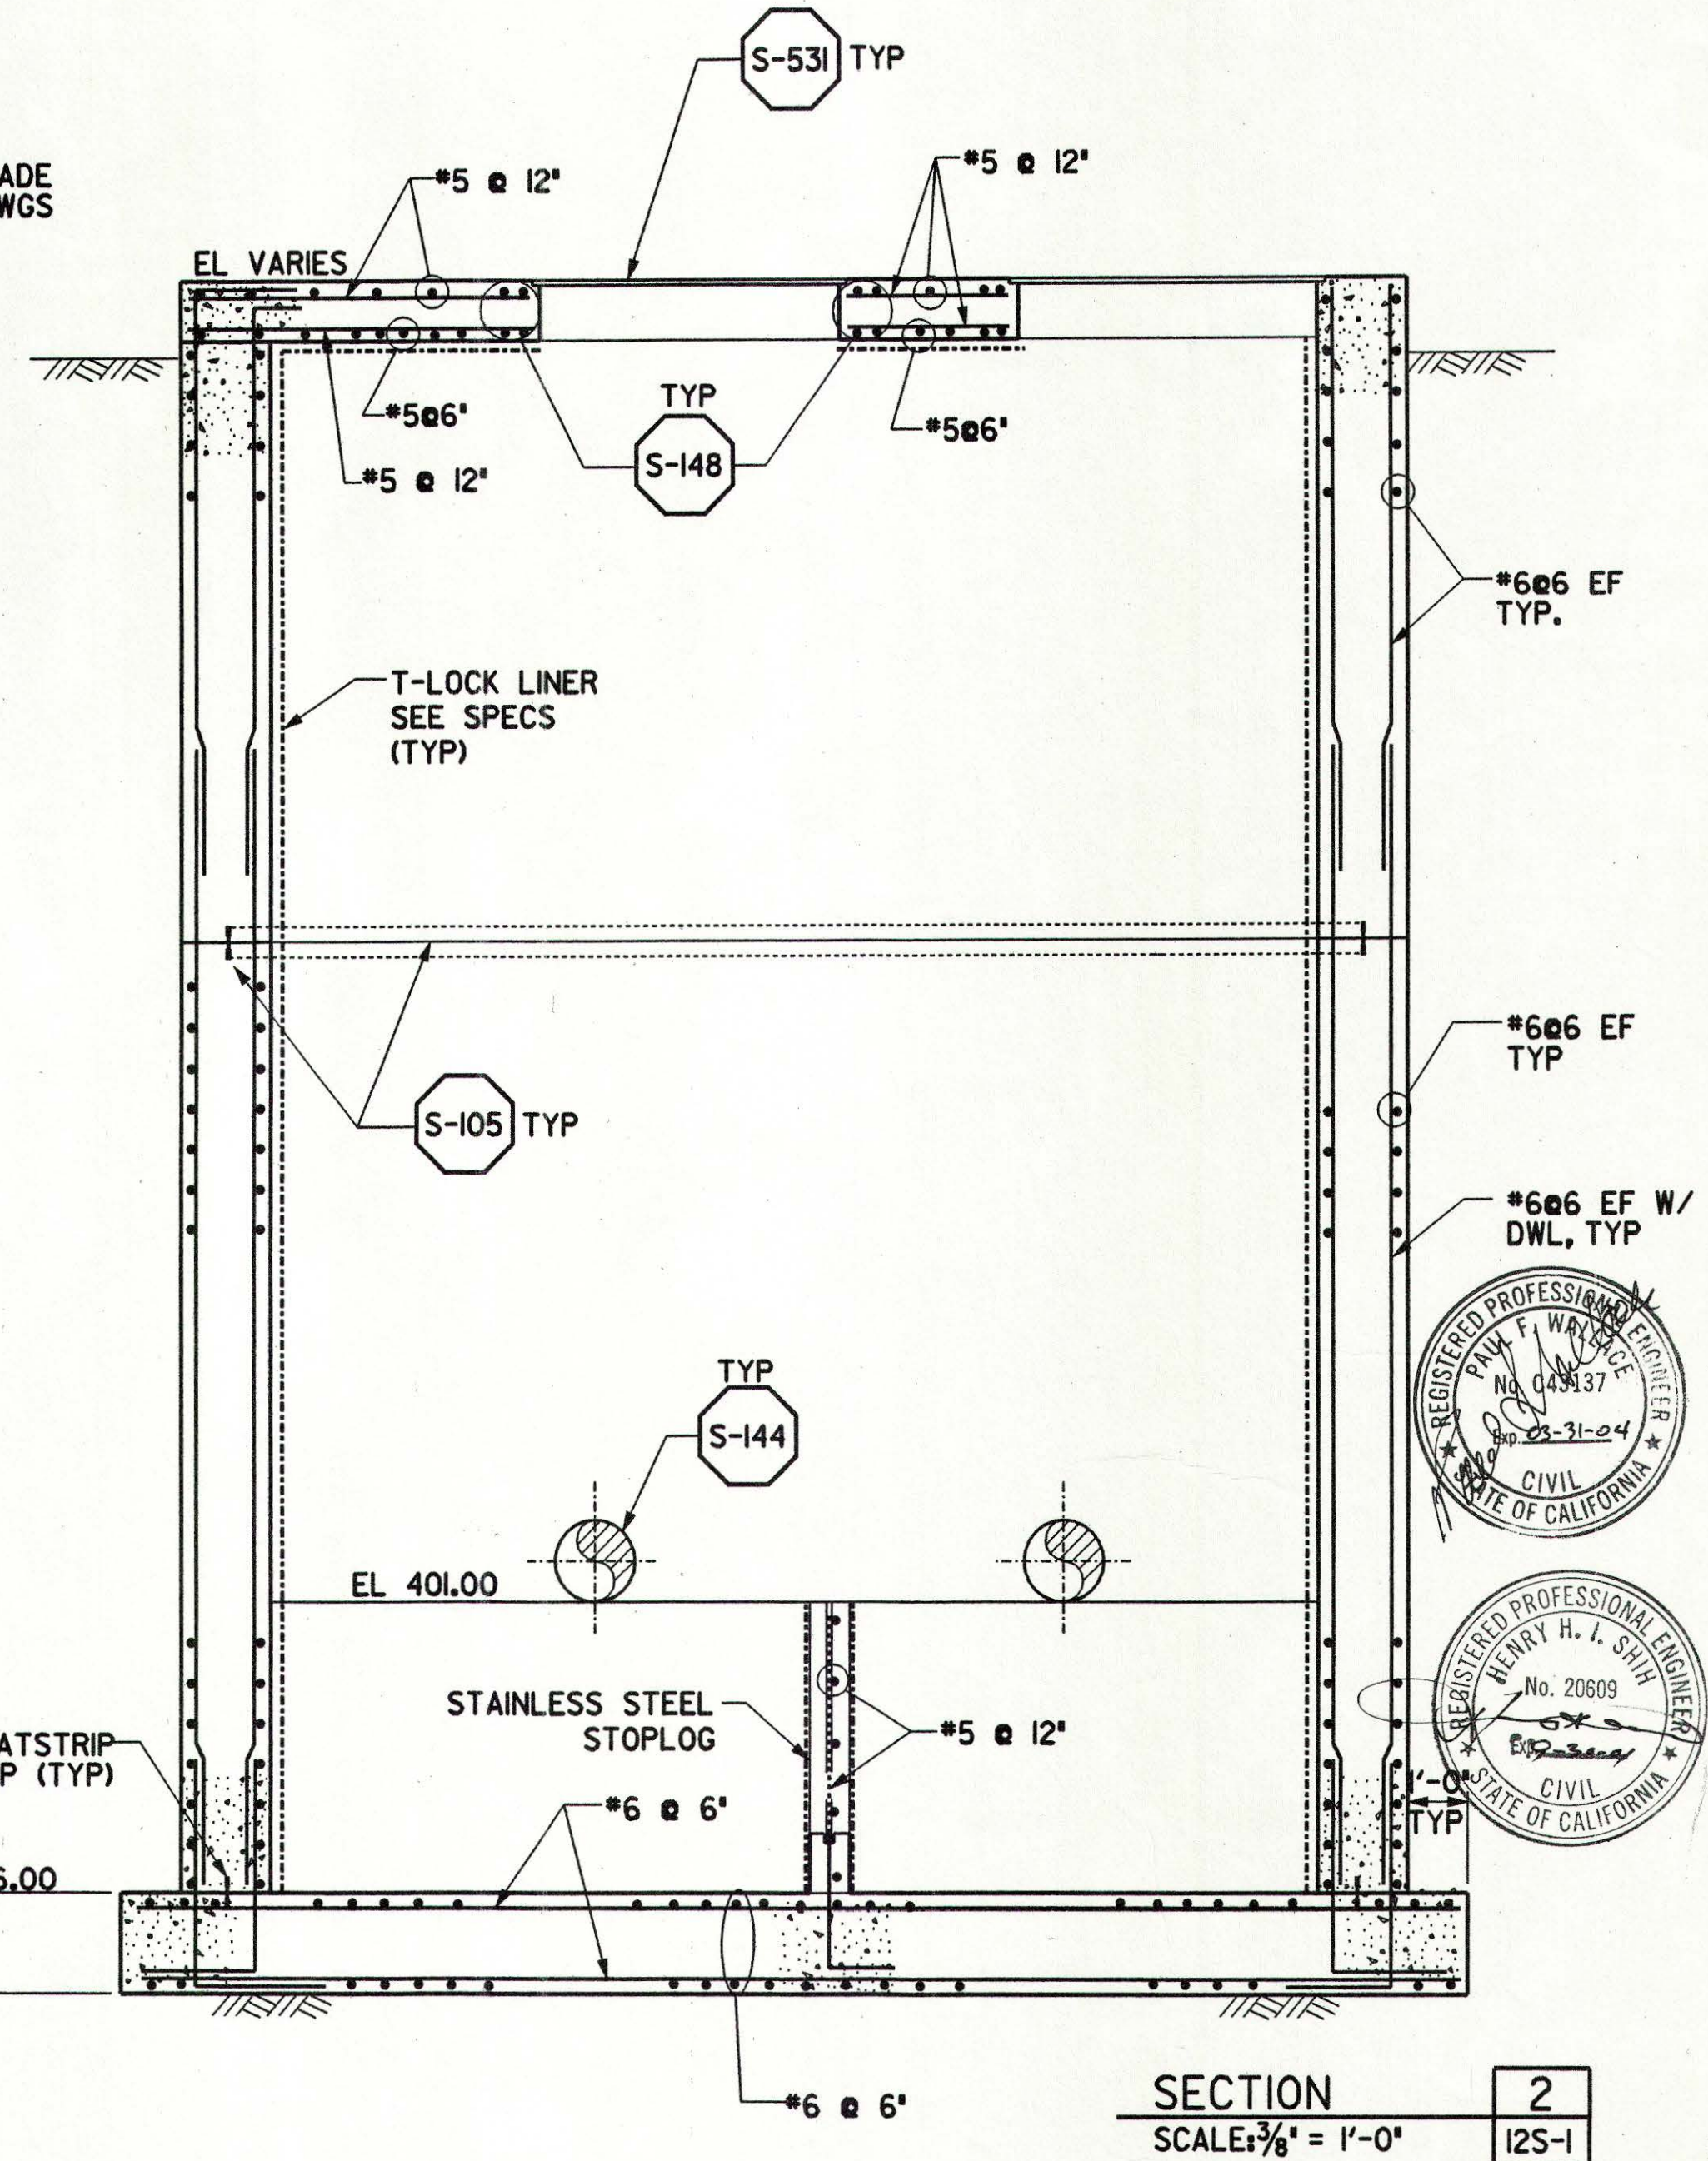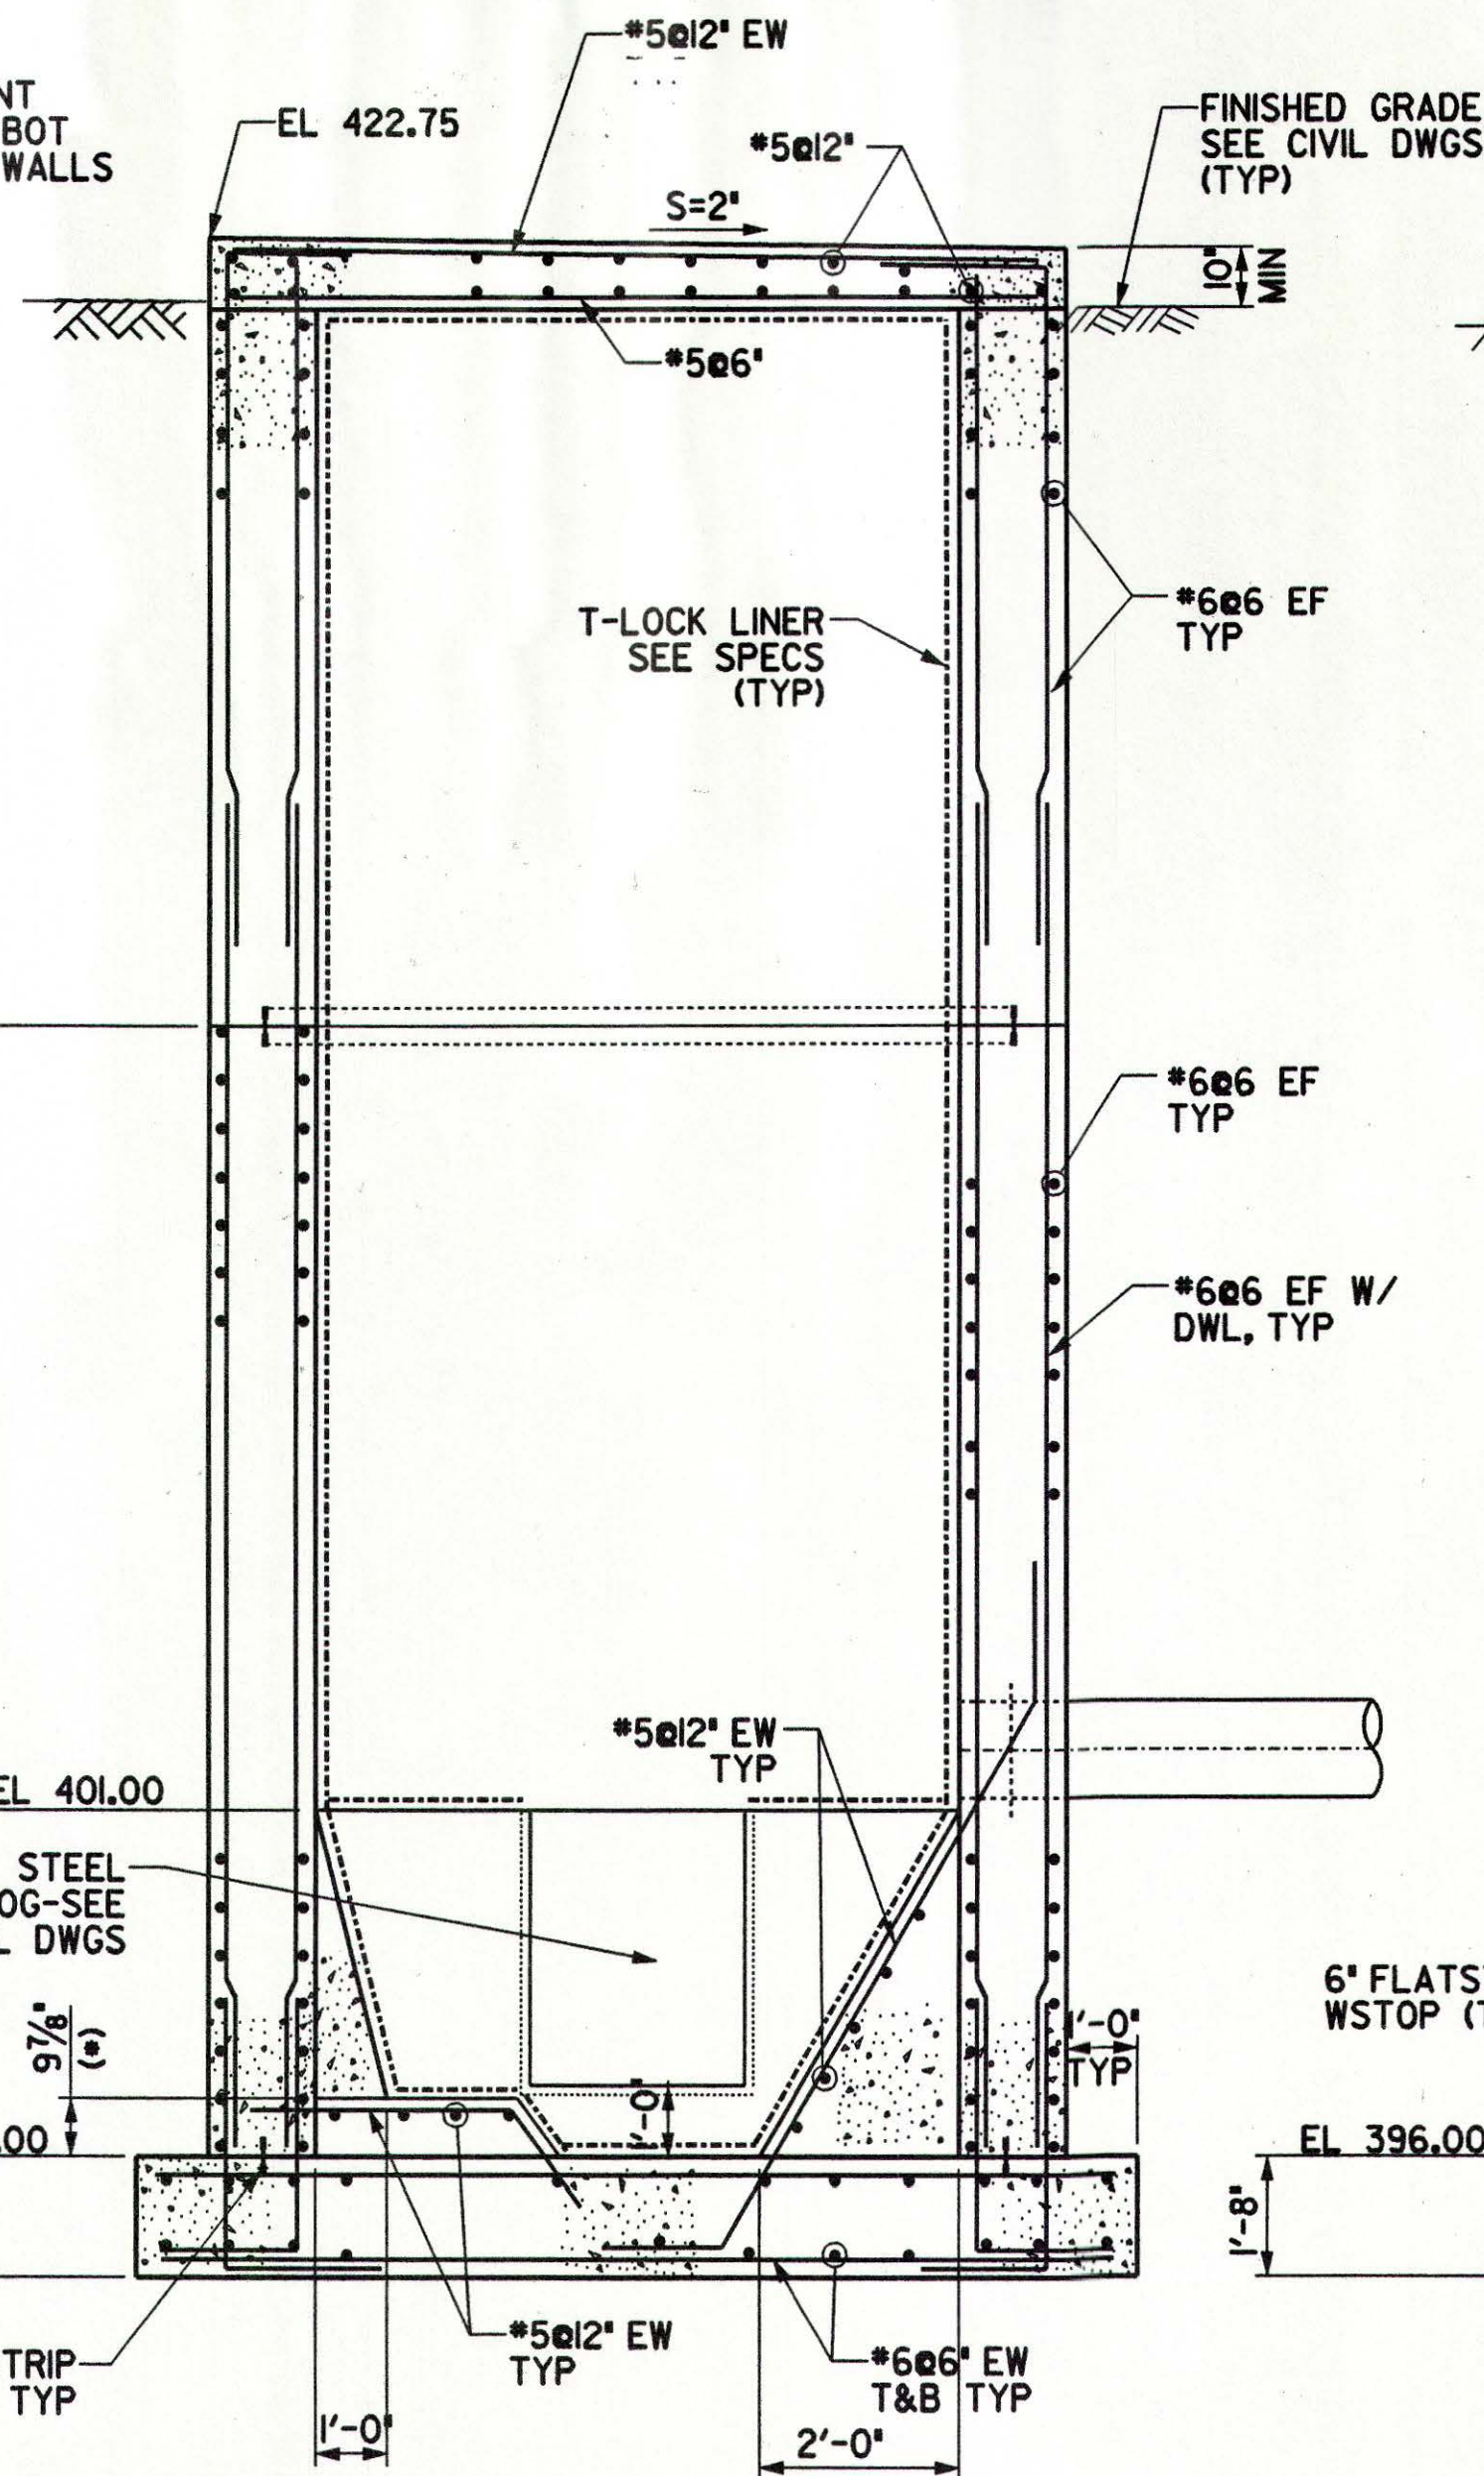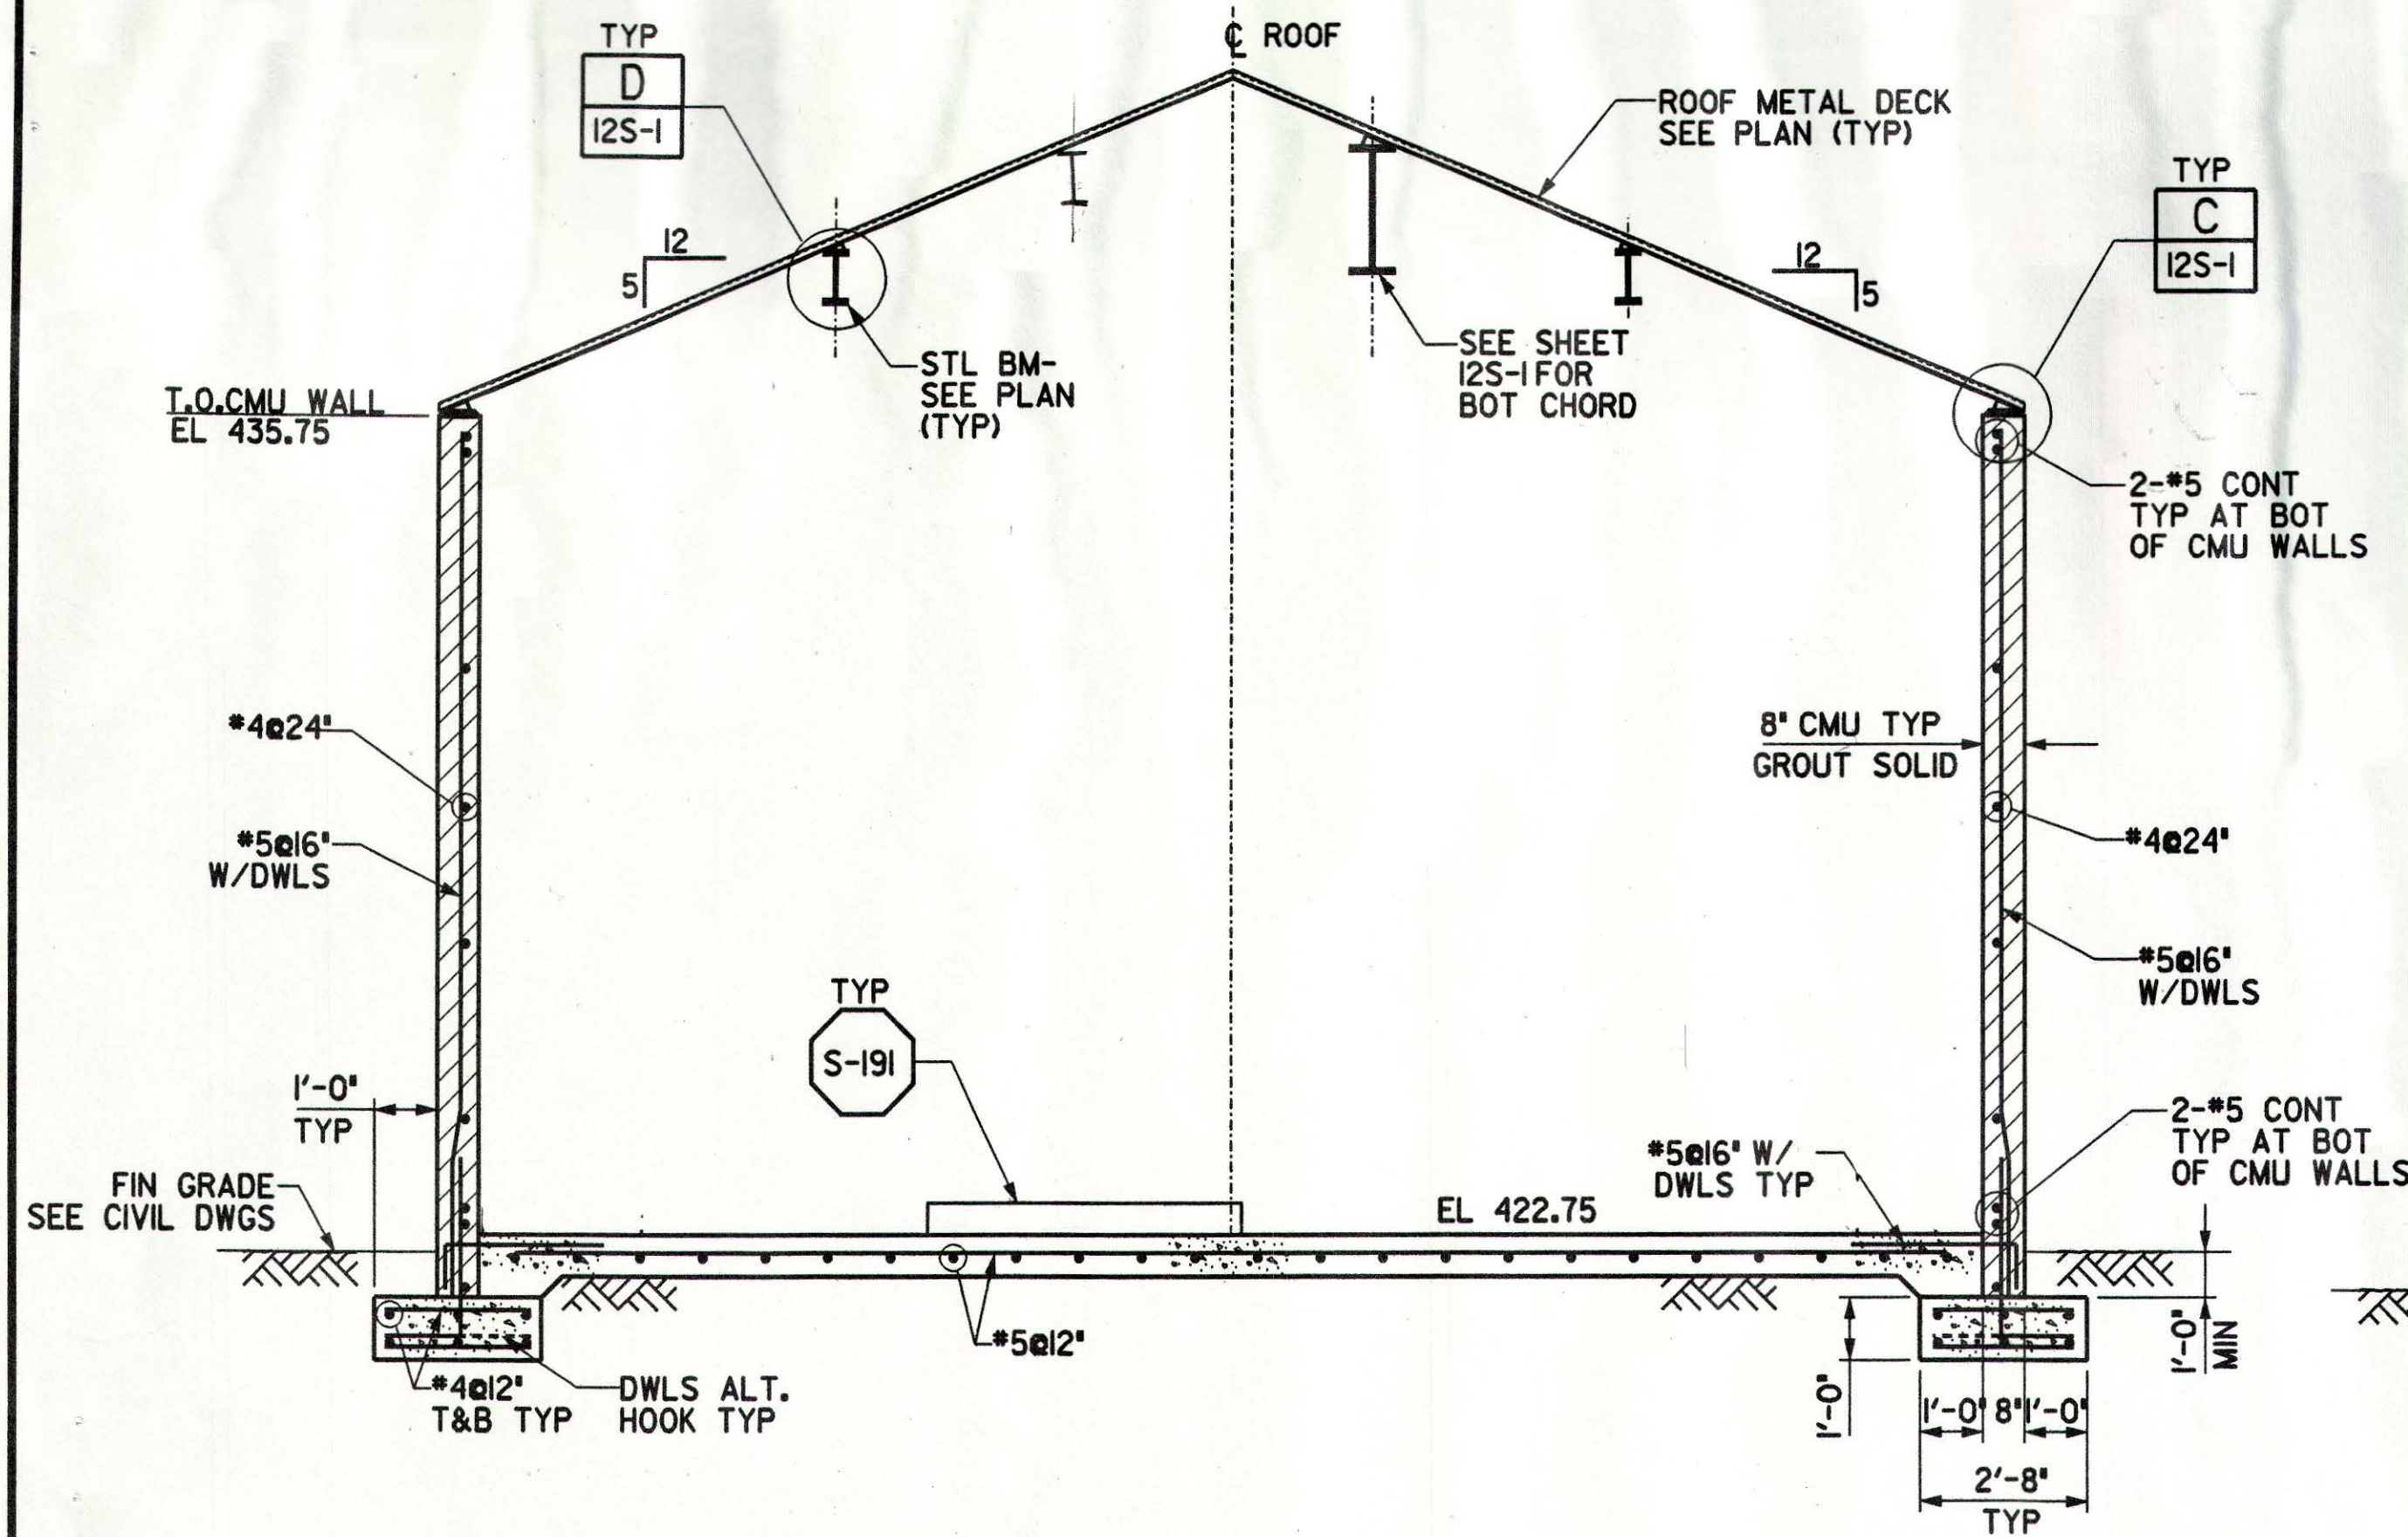

The limited review of this document by PBS & J on behalf of the Olivenhain Municipal Water District, is intended as a limited review only for general conformance with: (1) This approved Design/Build documents, (2) Accepted standards of practice within the industry, and (3) The standards of the Olivenhain Municipal Water District. This limited review in no way is intended, nor shall it act, to relieve the Design/Build Team of any professional liability to the responsibility to provide a complete and functional facility that is compliant with all applicable specifications, standards, codes, and regulations.

PBS & J  
Date: 8/23/01 By: *[Signature]*

SECTION 1  
SCALE: 3/8" = 1'-0" 12S-1

SECTION 2  
SCALE: 3/8" = 1'-0" 12S-1

REV	DATE	BY	OMWD	DESCRIPTION

SCALE	AS SHOWN
WARNING	IF THIS BAR DOES NOT MEASURE 1" THEN DRAWING IS NOT TO SCALE

DESIGNED	H. SHIH
DRAWN	J. TRAN
CHECKED	C. LEE

SUBMITTED BY	<i>[Signature]</i>
PROJECT MANAGER	<i>[Signature]</i>
COMPANY OFFICER	<i>[Signature]</i>
LICENSE NO.	33699
DATE	12/13/00




**MONTGOMERY WATSON**  
Pasadena, California

APPROVED	<i>[Signature]</i>
OLIVENHAIN MWD	8.29.01
APPROVED	DATE
FILANC CONSTRUCTION CO.	DATE



KELWOOD DEVELOPMENT COMPANY
45 RANCH SANITATION DISTRICT
WASTEWATER TREATMENT PLANT EXPANSION TO 2.0 MGD
NEIGHBORHOOD NO.1 PUMP STATION
SECTIONS

SHEET
12S-2
OF 5 SHEETS



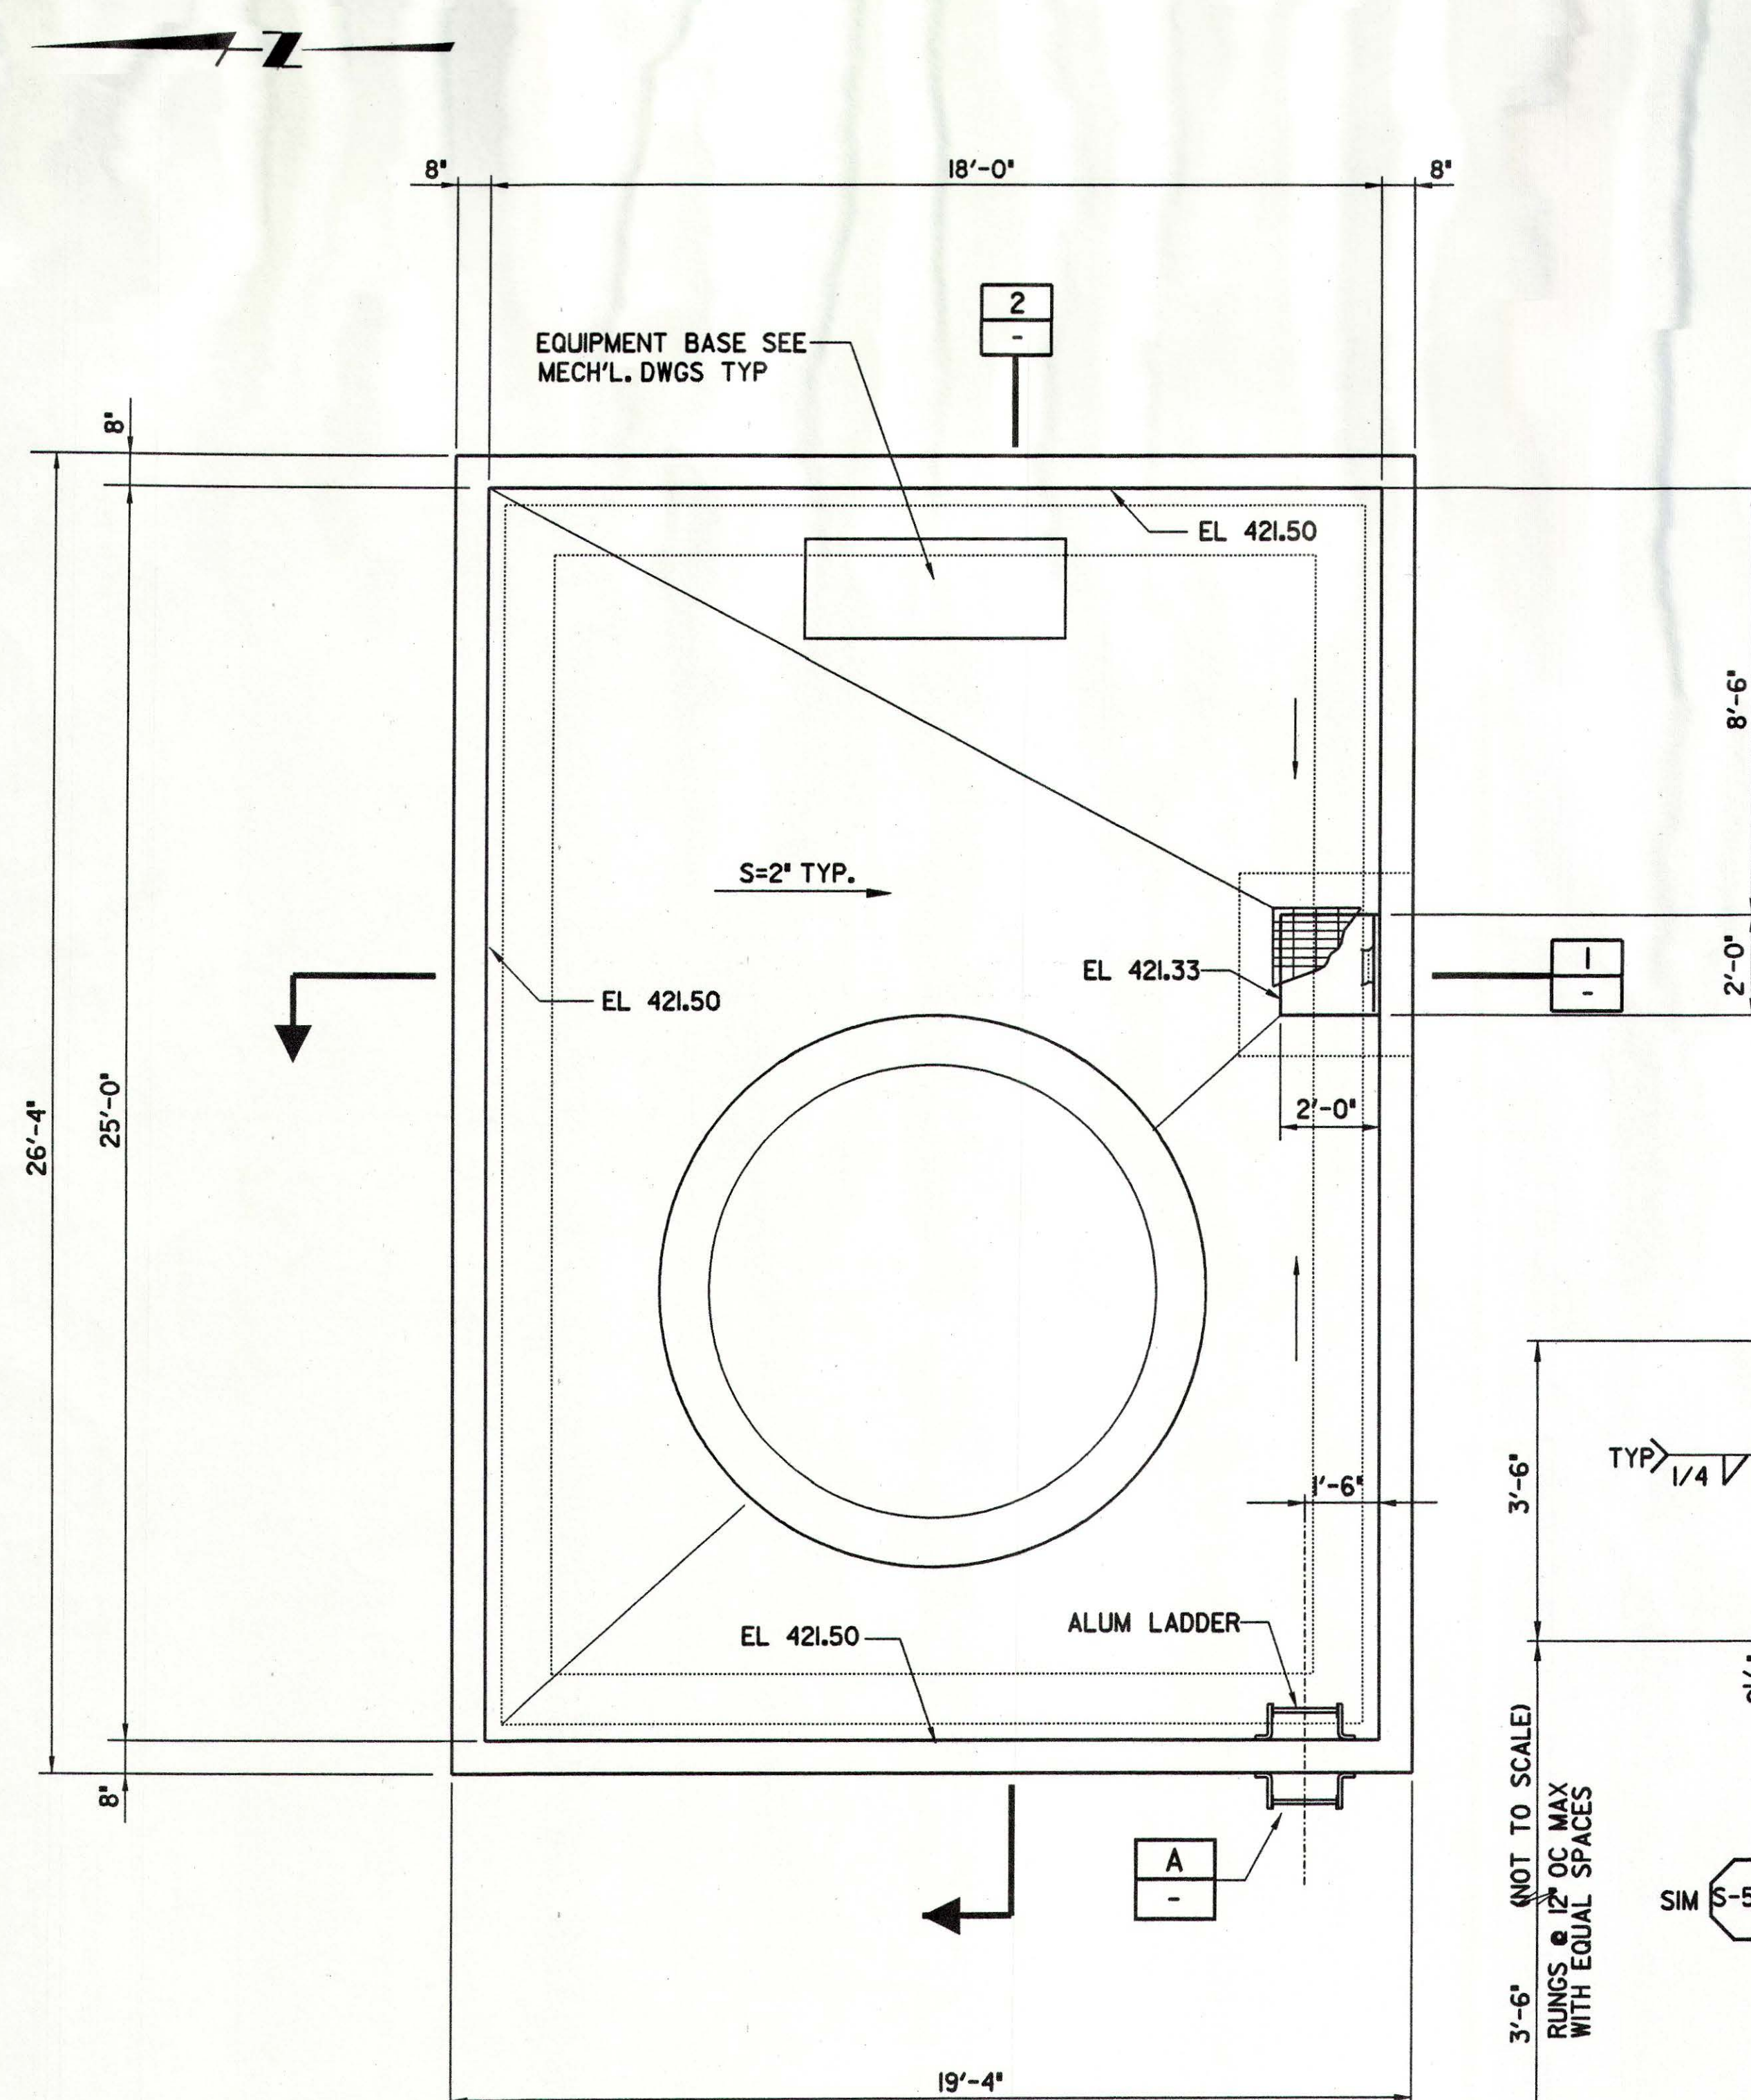

FERRIC CHLORIDE FEED AND STORAGE FACILITY PLAN  
SCALE :  $\frac{3}{8}" = 1'-0"$

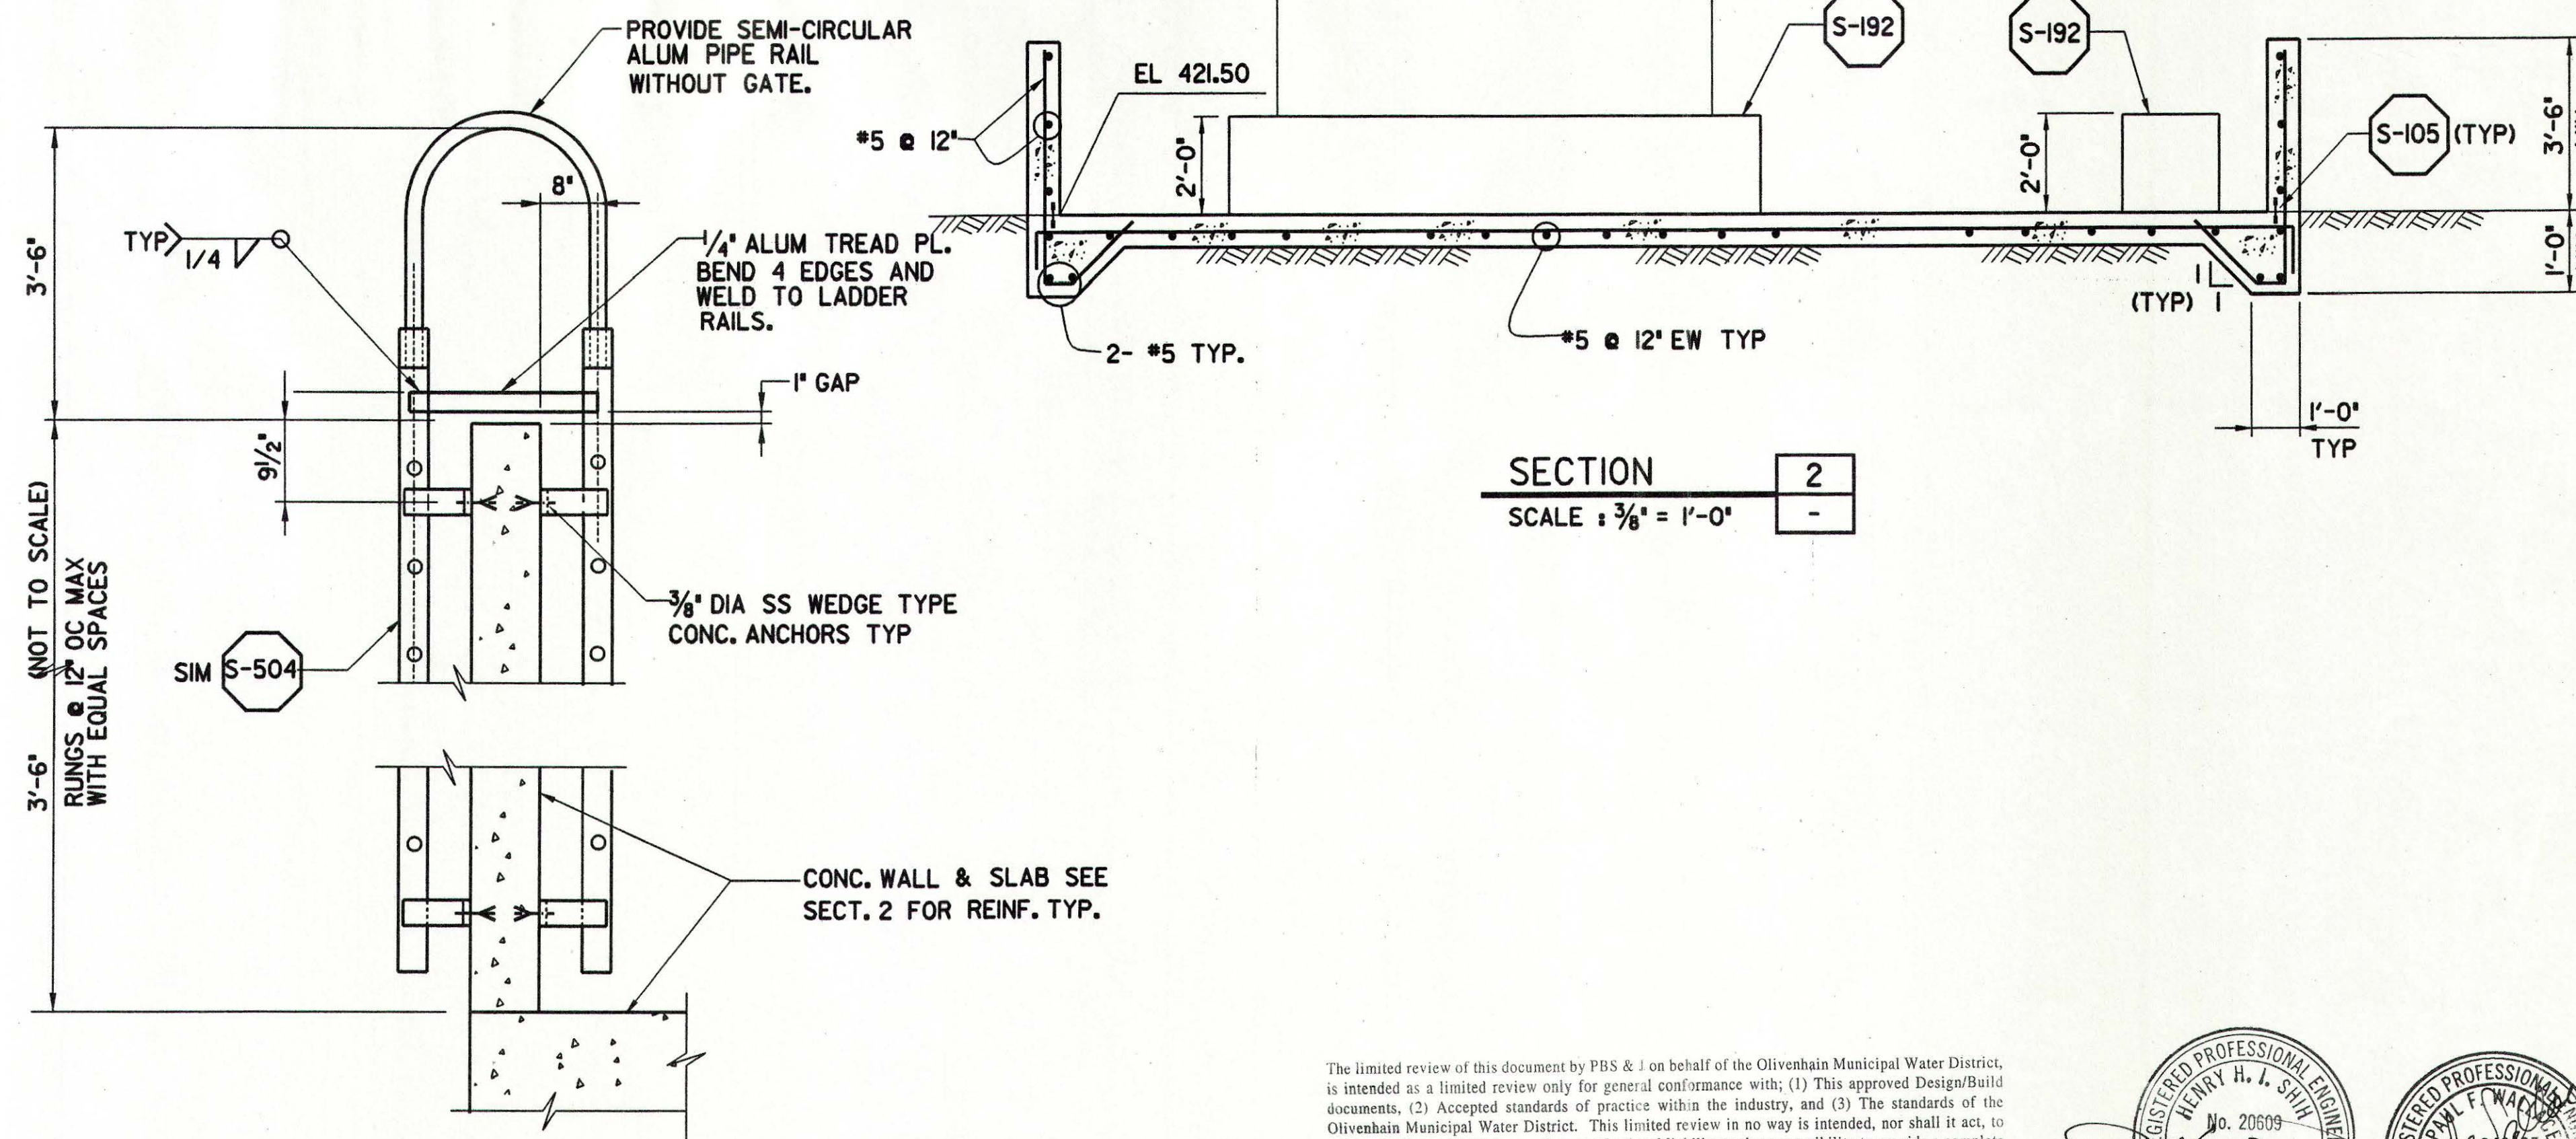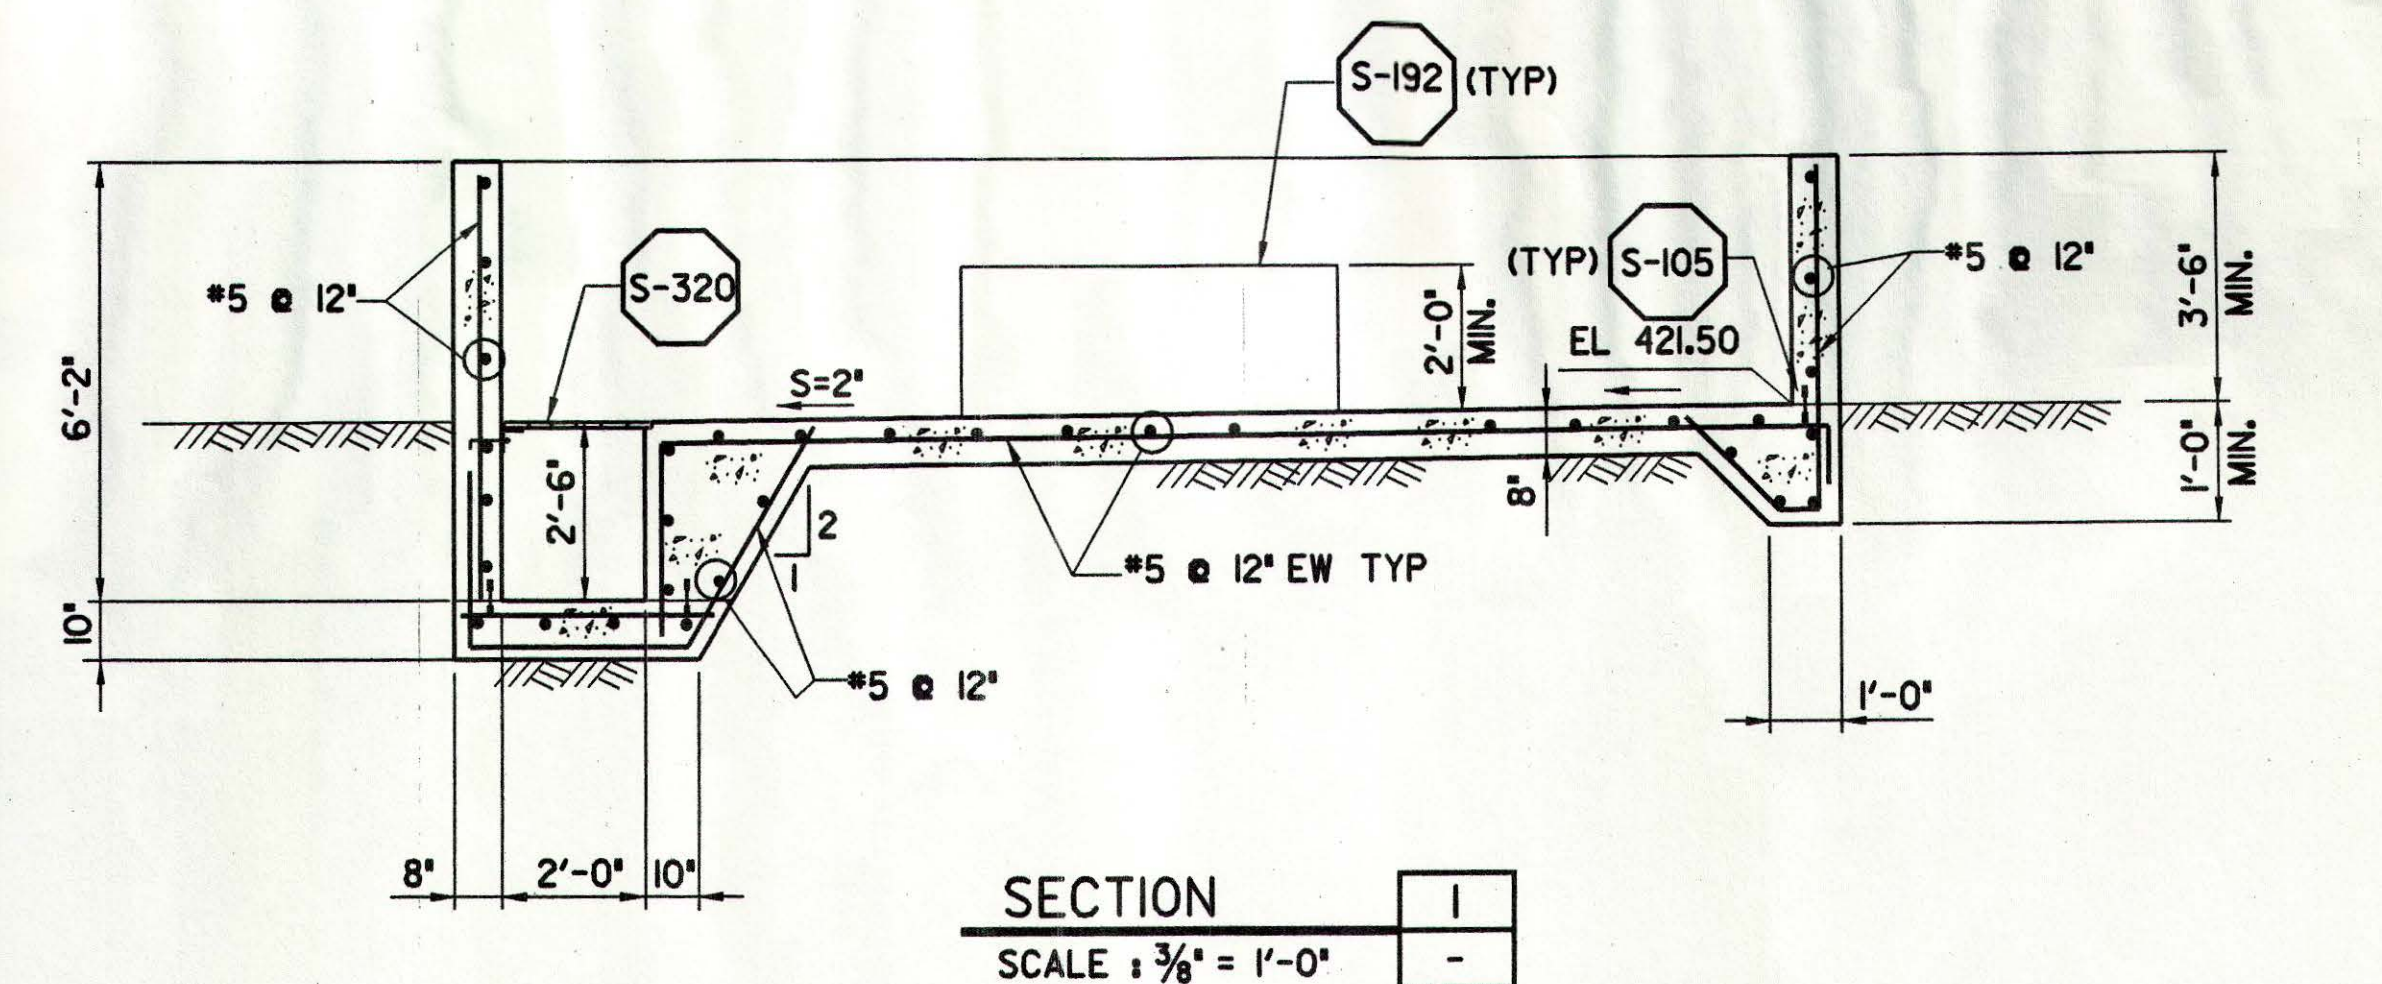


SECTION	A
NO SCALE	-

The limited review of this document by PBS & J on behalf of the Olivenhain Municipal Water District, is intended as a limited review only for general conformance with; (1) This approved Design/Build documents, (2) Accepted standards of practice within the industry, and (3) The standards of the Olivenhain Municipal Water District. This limited review in no way is intended, nor shall it act, to relieve the Design/Build Team of any professional liability to the responsibility to provide a complete and functional facility that is compliant with all applicable specifications, standards, codes, and regulations.

PBS & J  
Date 8/23/01 By A. S. Cap...



REV	DATE	BY	OMWD	DESCRIPTION

SCALE	<p><b>WARNING</b></p>  <p>IF THIS BAR DOES NOT MEASURE 1" THEN DRAWING IS NOT TO SCALE</p>
AS SHOWN	

DESIGNED H. SHIH  
DRAWN T. MA  
CHECKED C. LEE

SUBMITTED BY		
<u>[Signature]</u>	<u>5082</u>	<u>12/13/00</u>
PROJECT MANAGER	LICENSE NO.	DATE
<u>[Signature]</u>	<u>33699</u>	<u>12/13/00</u>
COMPANY OFFICER	LICENSE NO.	DATE




**MONTGOMERY WATSON**  
Pasadena, California

APPROVED	<i>George B Bmt</i>	\$ 29.00
OLIVENHAIN MWD		DATE
APPROVED		
FILANC CONSTRUCTION CO.		DATE


	KELWOOD DEVELOPMENT COMPANY
	4S RANCH SANITATION DISTRICT
	WASTEWATER TREATMENT PLANT EXPANSION TO 2.0 MGD
	NEIGHBORHOOD NO.1 PUMP STATION
	FERRIC CHLORIDE FEED AND STORAGE FACILITY

SHEET  
**12S-3**  
OF • SHEETS




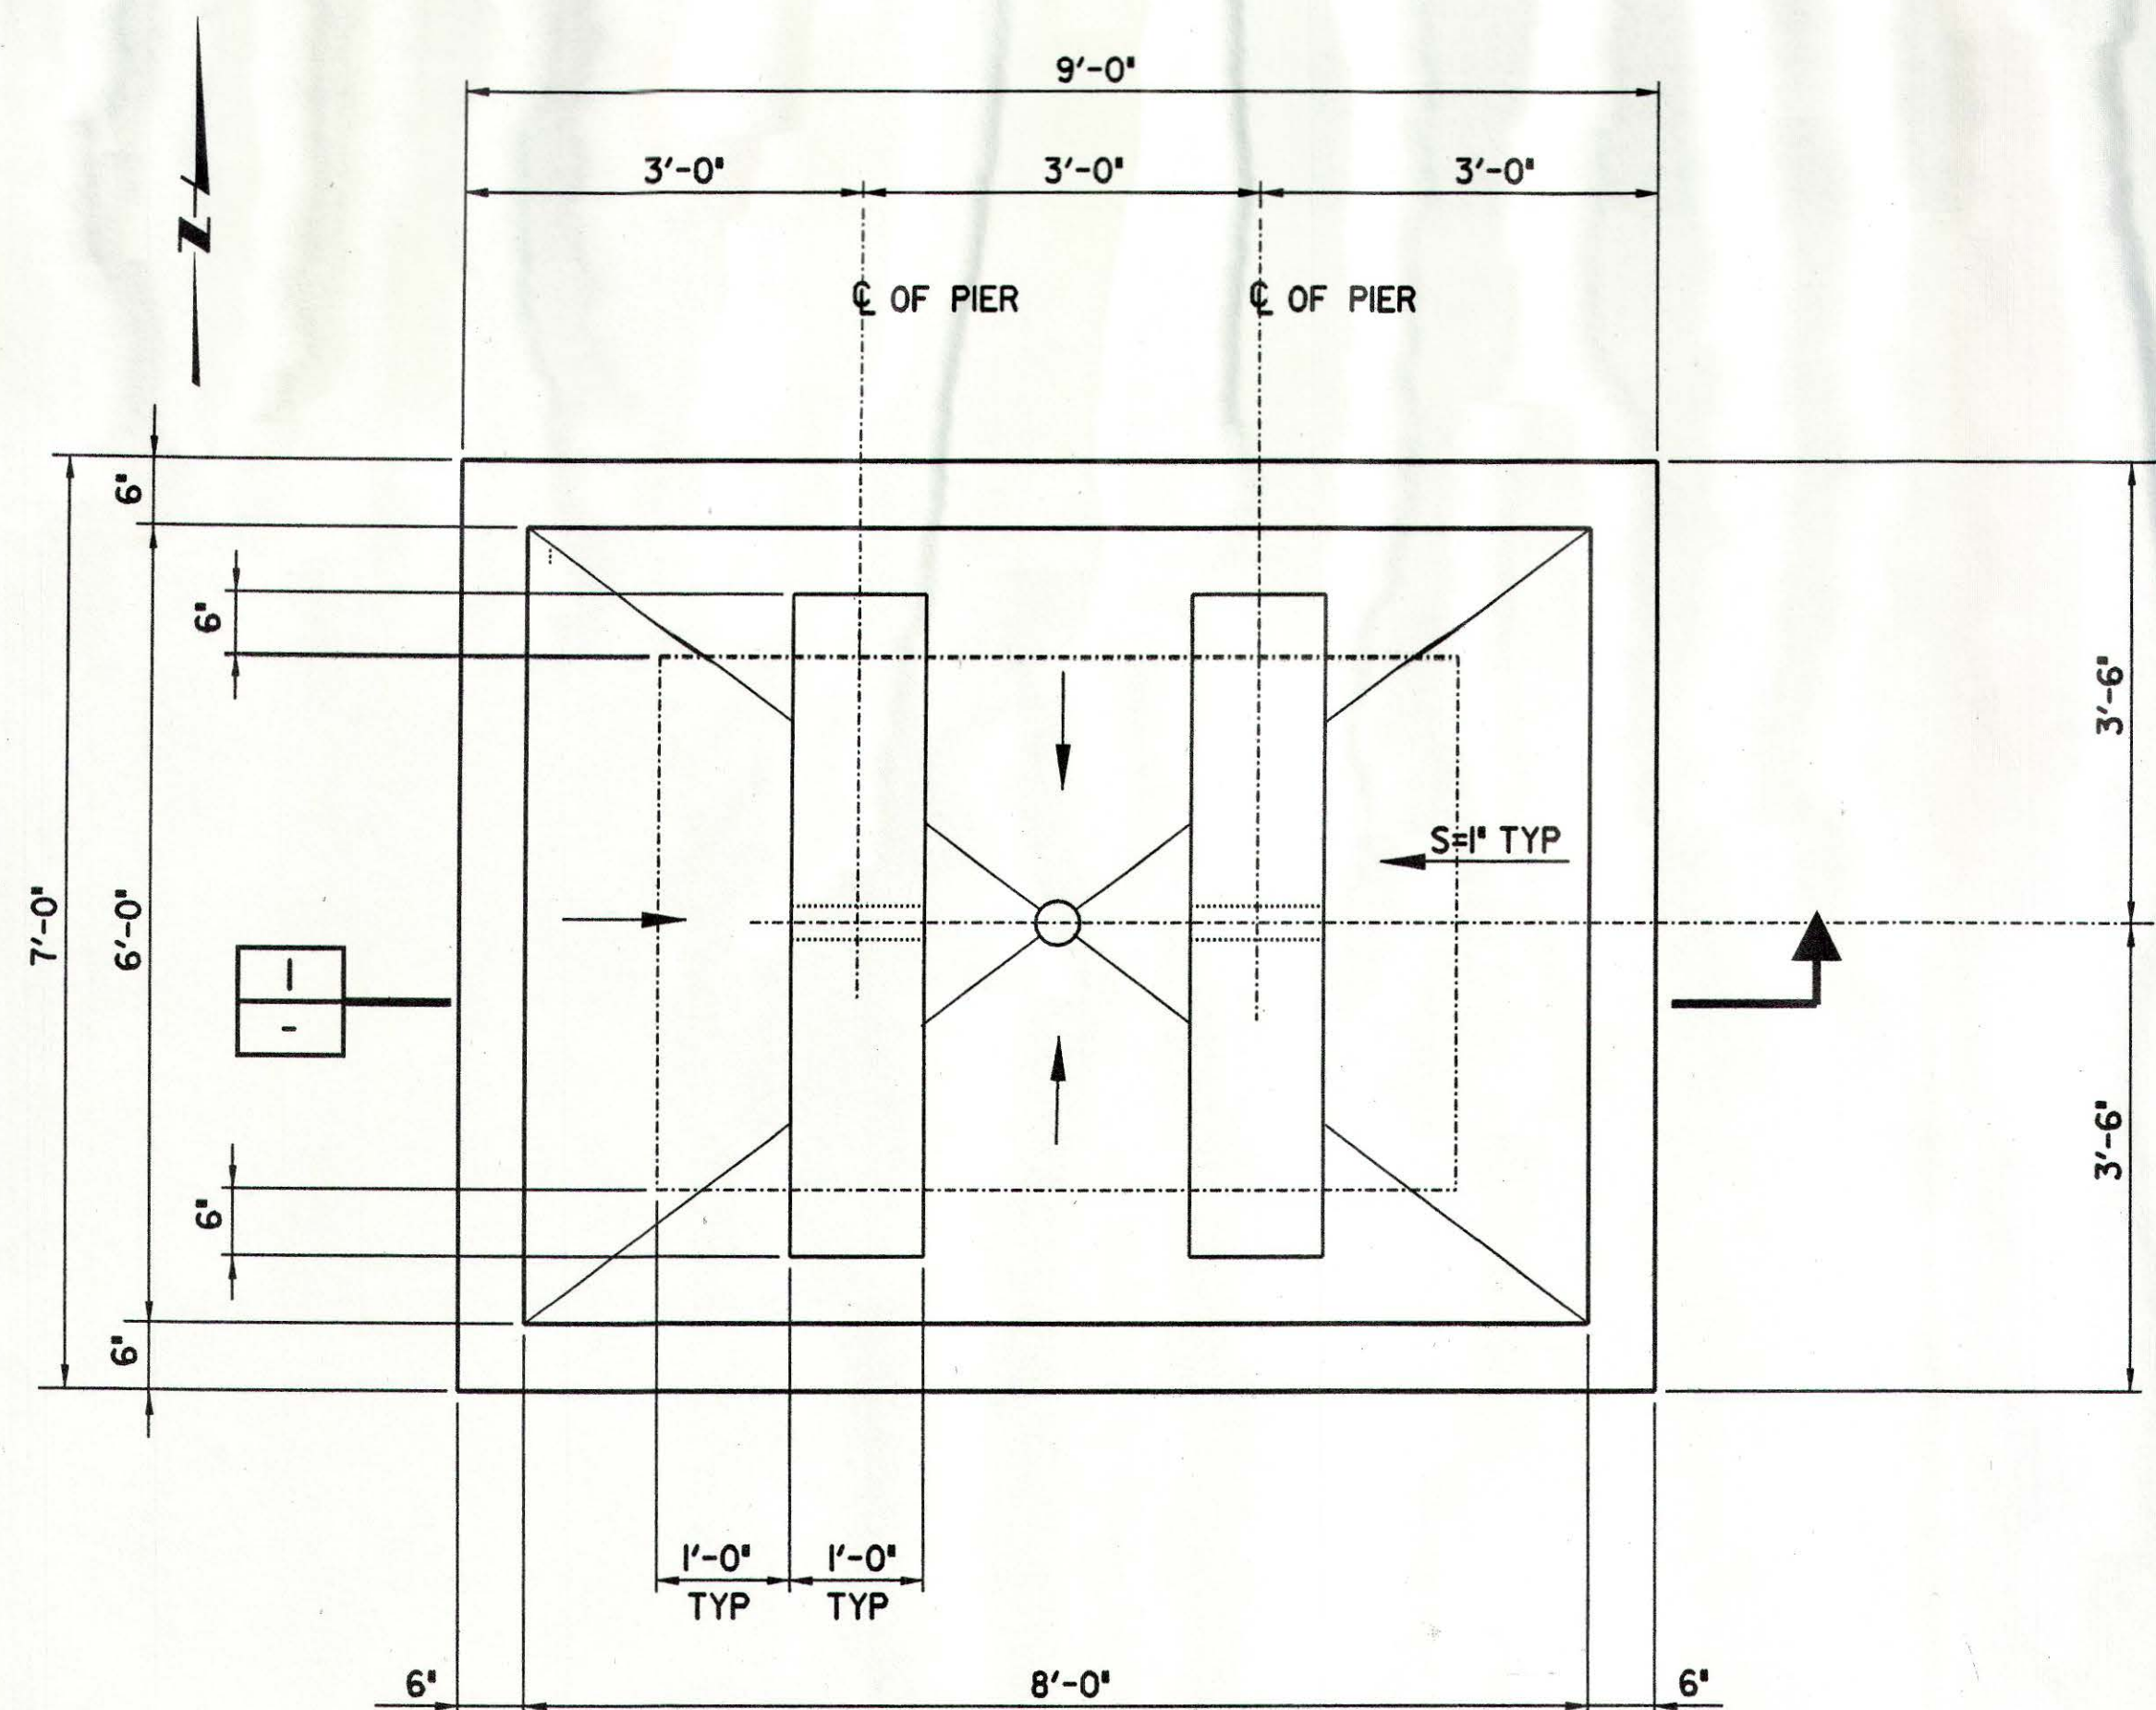

FUEL TANK PLAN

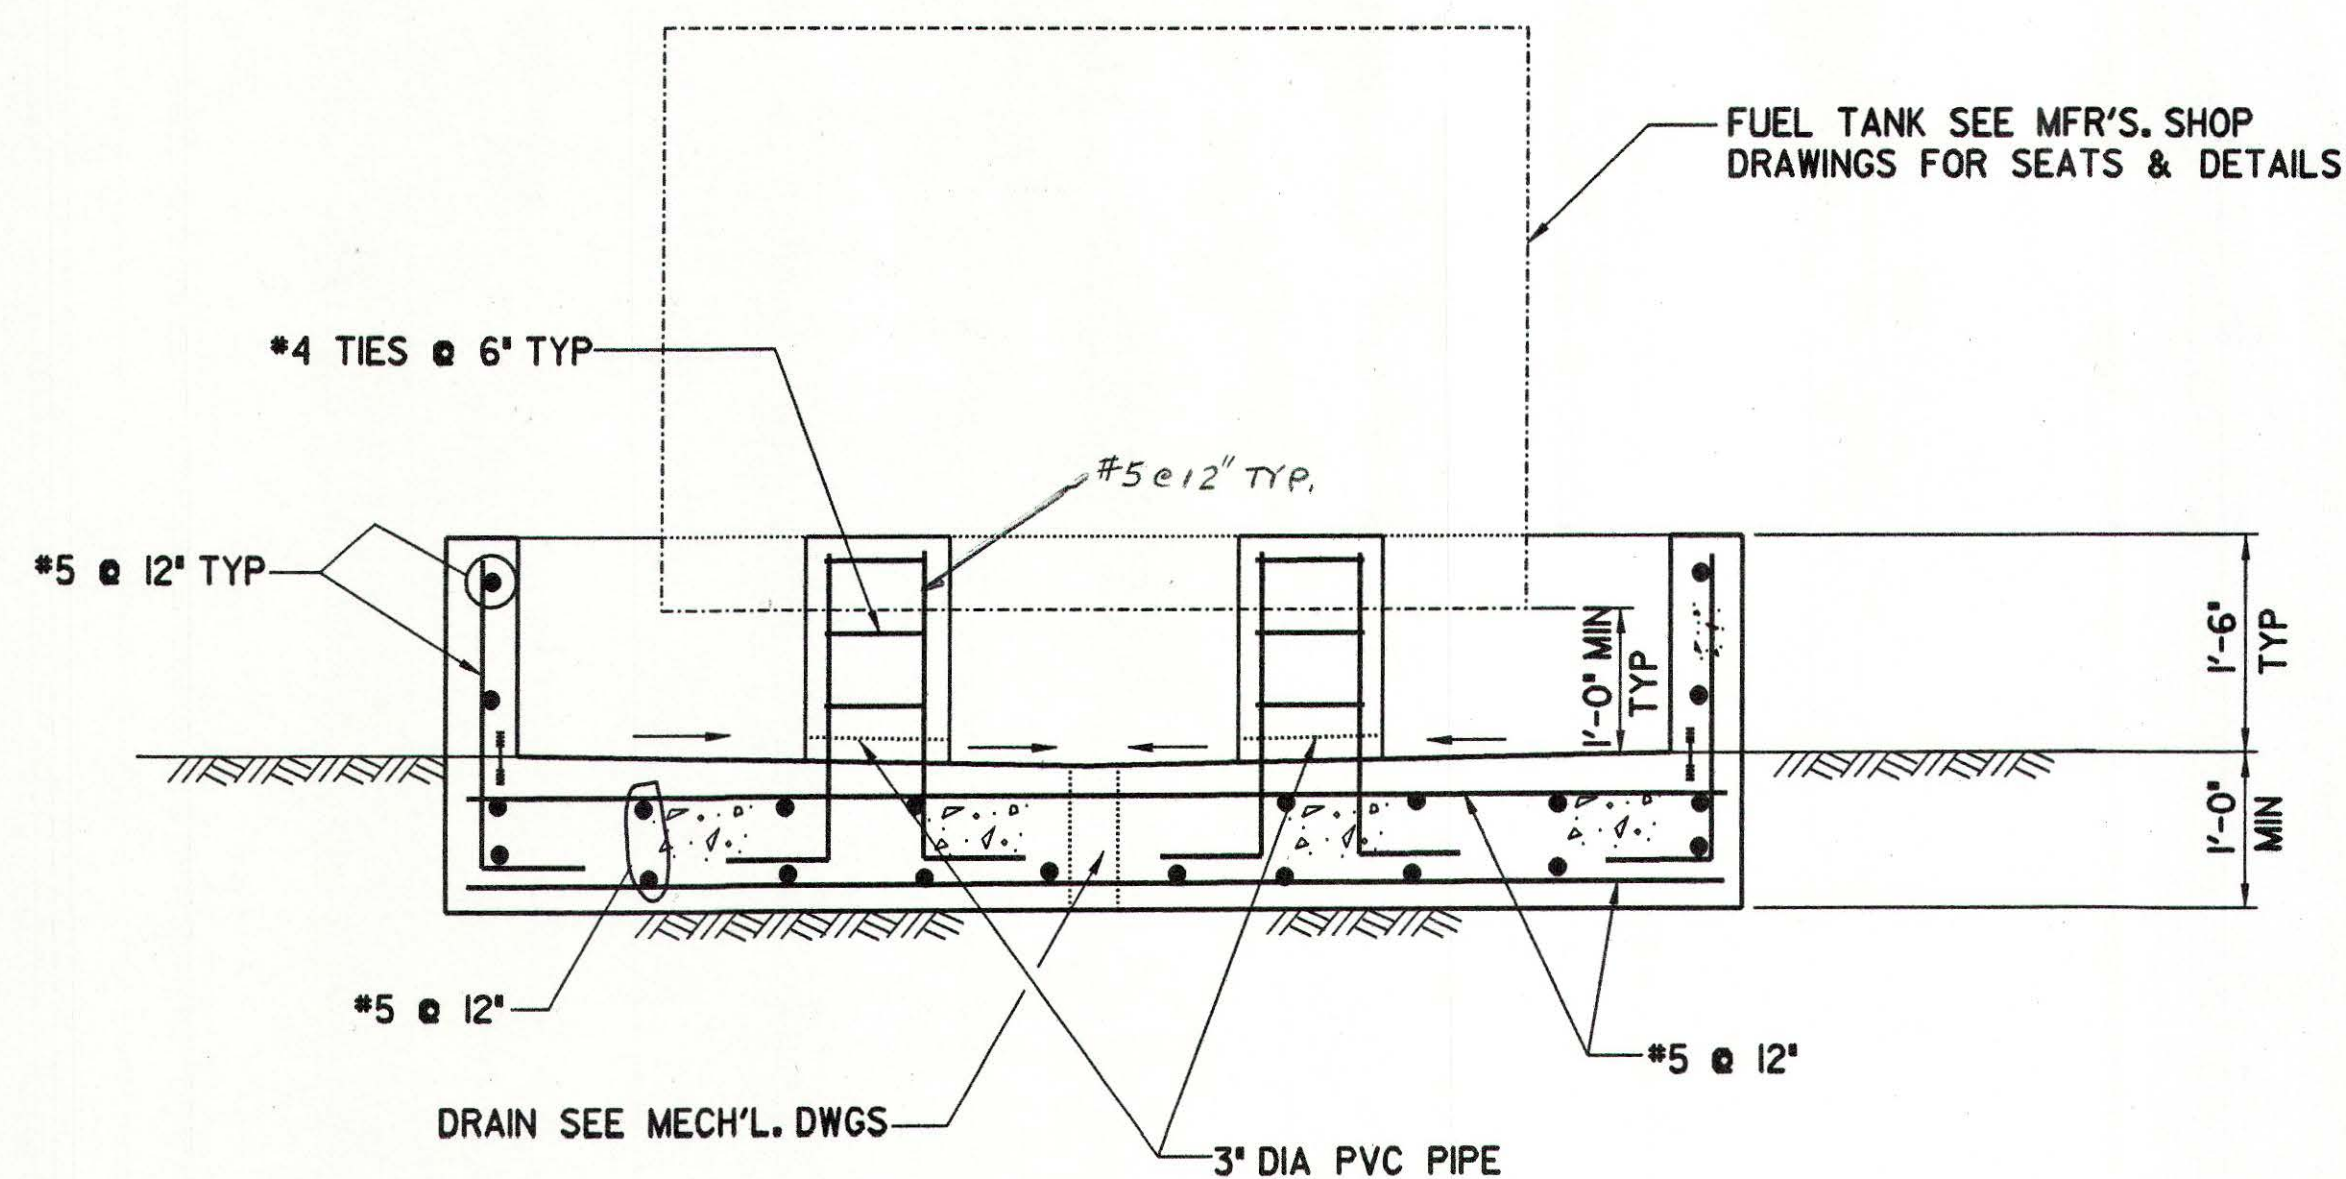


SECTION

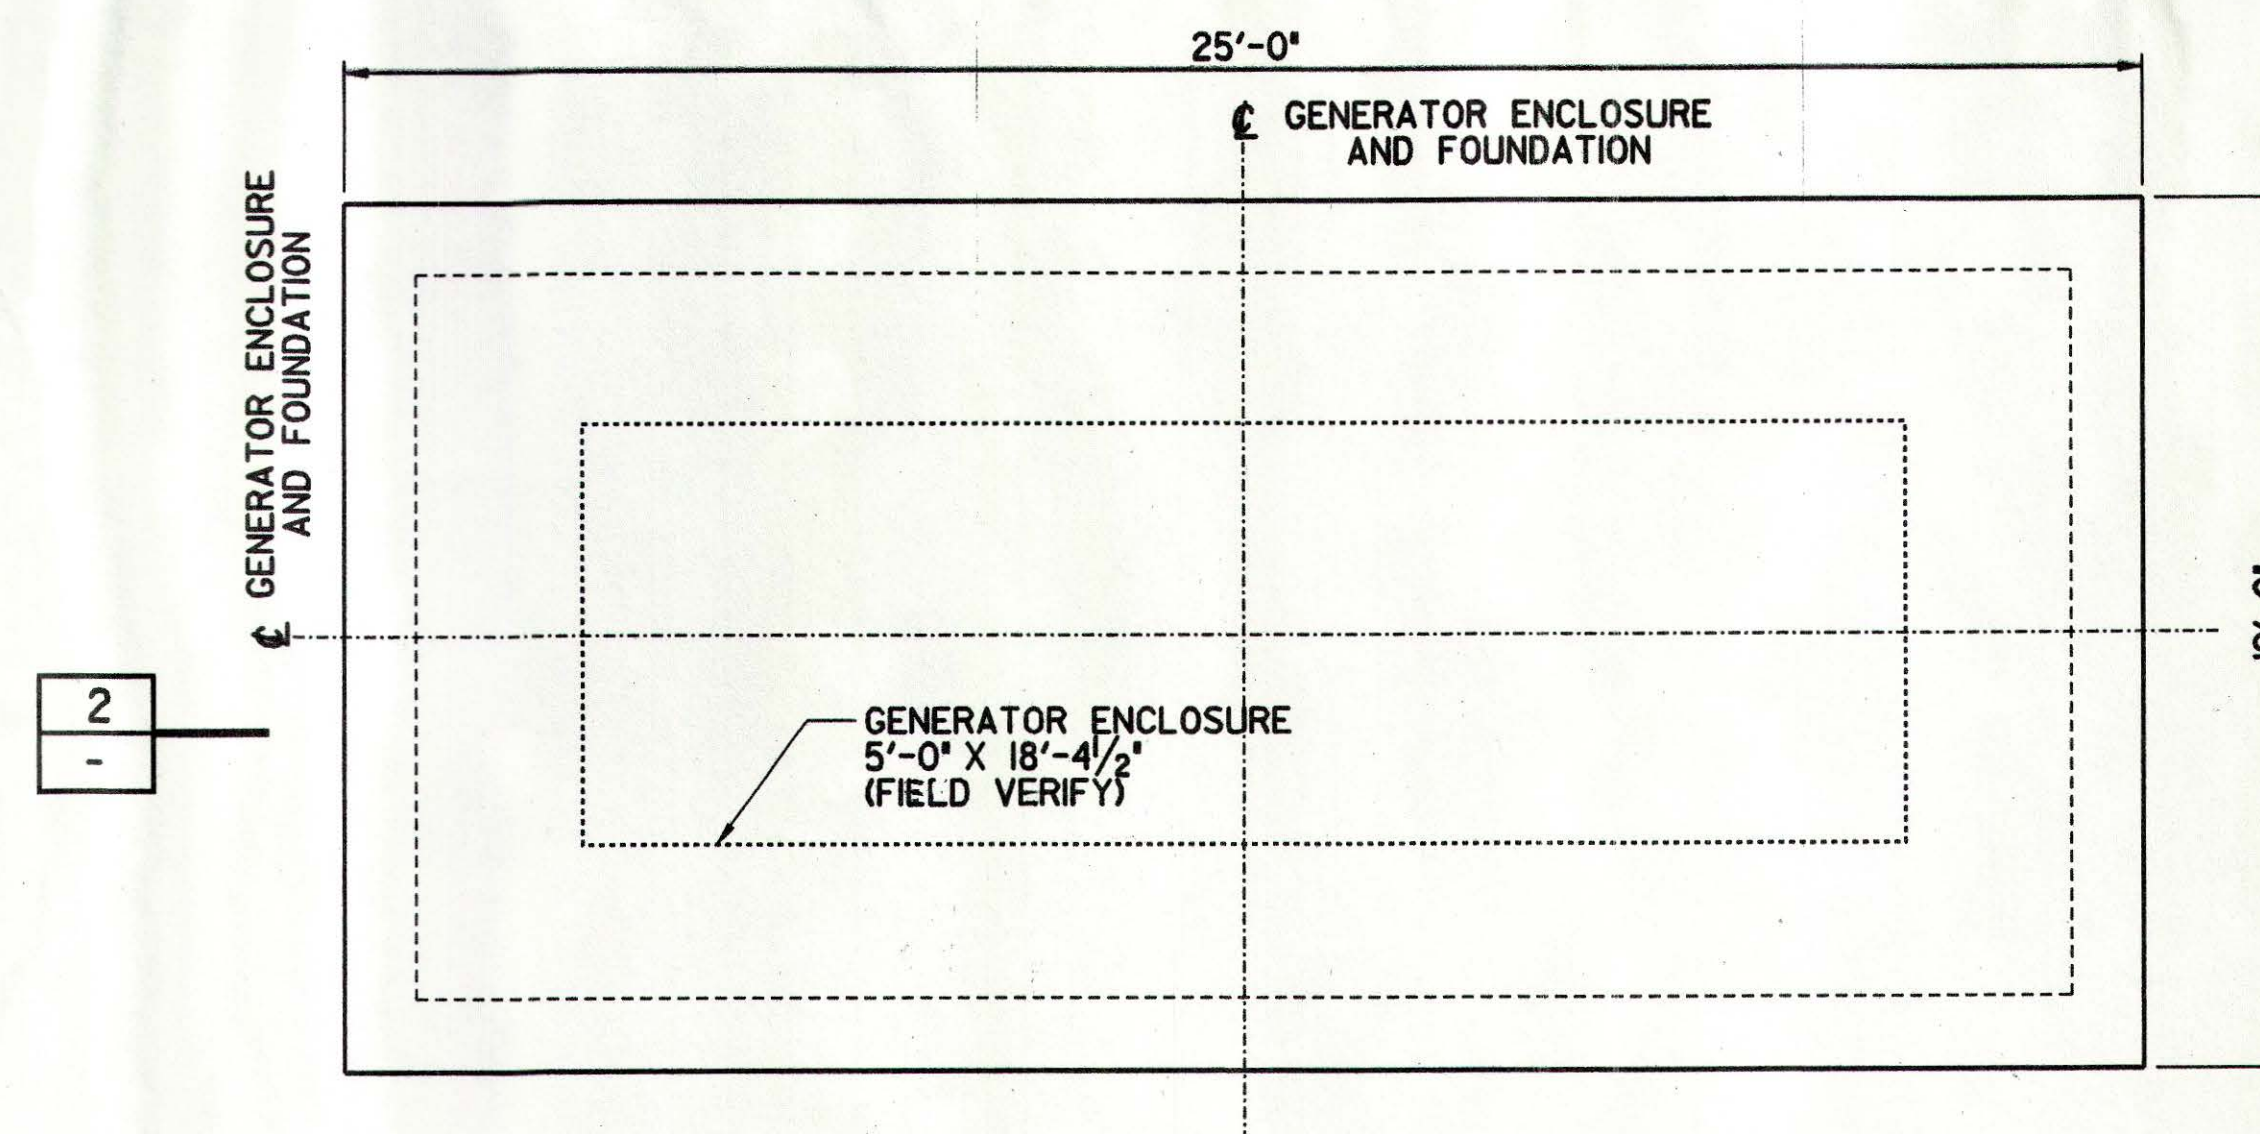

PLAN - GENERATOR FOUNDATION

SCALE:  $\frac{3}{8}"=1'-0"$

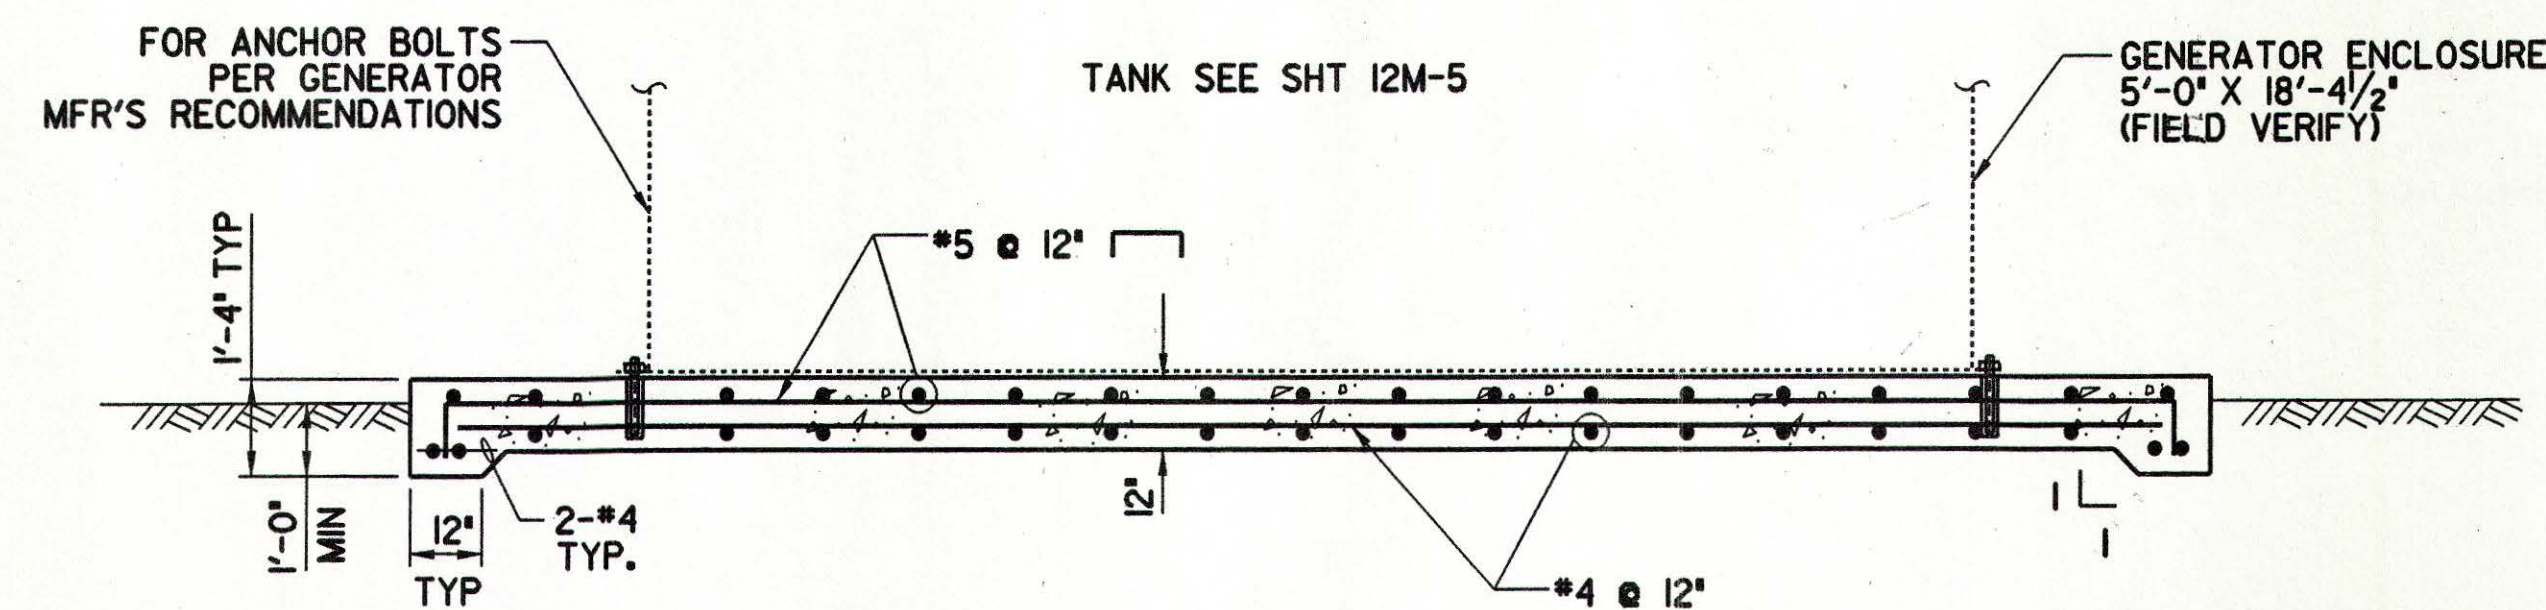

SECTION

**SCALE:  $\frac{3}{8}"=1'-0"$**

2

The limited review of this document by PBS & J on behalf of the Olivenhain Municipal Water District, is intended as a limited review only for general conformance with; (1) This approved Design/Build documents, (2) Accepted standards of practice within the industry, and (3) The standards of the Olivenhain Municipal Water District. This limited review in no way is intended, nor shall it act, to relieve the Design/Build Team of any professional liability to the responsibility to provide a complete and functional facility that is compliant with all applicable specifications, standards, codes, and regulations.

PBS &amp; J


Date 8/23/01

BS &amp; J

By



REV	DATE	BY	OMWD	DESCRIPTION

<p><b>SCALE</b></p> <p><math>\frac{3}{4}" = 1' - 0"</math></p>	<p><b>WARNING</b></p> <p>0 <math>\frac{1}{2}</math> 1</p>  <p>IF THIS BAR DOES NOT MEASURE 1" THEN DRAWING IS NOT TO SCALE</p>
--	---

DESIGNED H. SHIH  
DRAWN T. MA  
CHECKED C. LEE

SUBMITTED BY		
<i>[Signature]</i>	50802	12/13/00
PROJECT MANAGER	LICENSE NO.	DATE
<i>[Signature]</i>	33699	12/13/00
COMPANY OFFICER	LICENSE NO.	DATE



**MONTGOMERY WATSON**  
Pasadena, California

APPROVED George R Bunt 8-29-0  
OLIVENHAIN MWD DATE

APPROVED \_\_\_\_\_  
FILANC CONSTRUCTION CO. \_\_\_\_\_ DATE \_\_\_\_\_

	KELWOOD DEVELOPMENT COMPANY
	4S RANCH SANITATION DISTRICT
	WASTEWATER TREATMENT PLANT EXPANSION TO 2.0 MGD
	NEIGHBORHOOD NO.1 PUMP STATION GENERATOR PAD AND FUEL TANK

SHEET  
12S-4  
OF • SHEETS



## P L A N

## S Y M B O L S

## S I N G L E L I N E D I A G R A M

## S C H E M A T I C D I A G R A M

- EXPOSED CONDUIT  
CONDUIT CONCEALED ABOVE FLOOR.  
CONDUIT RUN UNDERGROUND OR IN CONCRETE  
EXPOSED CONDUIT RUN BEHIND OBSTRUCTION  
BARE COPPER GROUND TO GROUND WIRE IN SLAB, OR UNDERGROUND GROUND GRID, SIZE AS NOTED.  
HOME RUN TO PANEL "LPI", CIRCUITS #1, 3, 7. CROSS MARKS INDICATE NUMBER OF CONDUCTORS. CONDUCTORS SHALL BE NO. 12 UNLESS OTHERWISE NOTED. CONDUIT SHALL BE 3/4" UNLESS OTHERWISE NOTED. CONDUIT RUNS NOT MARKED SHALL BE 3/4" WITH 2#12 & 1#12 GROUND. CONDUIT SHOWN IS 3/4" WITH 5#12 & 1#12 GROUND, CIRCUIT 1 & 3 WITH COMMON NEUTRAL AND CIRCUIT 7 WITH SEPARATE NEUTRAL.  
CONDUIT RUN - CHANGE IN ELEVATION  
CONDUIT BENDS TOWARD OBSERVER  
CONDUIT BENDS AWAY FROM OBSERVER  
CONDUIT CAPPED, OR SEALED  
TELEPHONE CONDUIT ONLY. \*UNLESS OTHERWISE NOTED\* CONDUIT SHALL 2" DIAMETER.  
PA CONDUIT - 2" C W/VENDOR CABLES  
FA FIRE ALARM CONDUIT. 3/4" C.O.  
FLEXIBLE LIQUID - TIGHT CONDUIT CONNECTION  
IM - I INDICATES CONDUIT NUMBER FROM MCC "IM" "I" INDICATES FEEDER NO.  
CEILING OR PENDANT INCANDESCENT, MERCURY VAPOR, OR SIMILAR LAMP FIXTURE. "2" INDICATES CIRCUIT NUMBER. "a" INDICATES FIXTURE CONTROLLED BY SWITCH "a".  
WALL BRACKET INCANDESCENT, MERCURY VAPOR, OR SIMILAR LAMP FIXTURE WITH EXPOSED BACK BOX AND CONDUIT.  
WALL BRACKET FLOOD OR SPOTLIGHT WITH CONCEALED BACK BOX AND CONDUIT.  
POLE MOUNTED FIXTURE DISTRIBUTION TYPE AS INDICATED ON PLAN  
FIXTURE TYPE A. 2-32 WATT LAMPS  
3 - NUMBER OF TYPE "A" FIXTURES  
FLUORESCENT LIGHTING FIXTURE  
FLUORESCENT LIGHTING FIXTURE, UNSWITCHED (SWITCHED AT LIGHTING PANEL ONLY)  
FLUORESCENT LIGHTING FIXTURE ON EMERGENCY CIRCUIT OR WITH BATTERY BACKUP  
BATTERY EMERGENCY LIGHT FIXTURE  
EXIT LIGHT.  
SINGLE POLE SWITCH. "a" INDICATES CIRCUIT CONTROLLED  
DOUBLE POLE SWITCH  
THREE-WAY SWITCH  
FOUR-WAY SWITCH  
KEY-OPERATED SWITCH  
SWITCH AND PILOT LIGHT  
MANUAL MOTOR STARTER  
WEATHERPROOF SWITCH  
PROCESS INSTRUMENT CALLOUTS PER P & ID.  
SMOKE DETECTOR

## WALL FLOOR

- 120V SINGLE RECEPTACLE, NEMA CONFIGURATION 5-20.  
120V DUPLEX RECEPTACLE, NEMA CONFIGURATION 5-20  
240V DUPLEX RECEPTACLE, NEMA CONFIGURATION 6-20  
SINGLE SPECIAL-PURPOSE RECEPTACLE, ASTERISK INDICATES NUMBER, SUCH AS AMPERAGE, TO DIFFERENTIATE BETWEEN TWO OR MORE DIFFERENT TYPES. 120 OR 240 V.A.C.  
WELDING RECEPTACLE  
SINGLE SPECIAL PURPOSE RECEPTACLE 480 V.A.C.  
CLOCK HANGER RECEPTACLE  
LIGHTING PANEL  
POWER PANEL, CONTROL PANEL, ETC.  
MOTOR CONTROL CENTER  
FLOOR TYPE TELEPHONE OUTLET  
SOUND OR PAGING SYSTEM DEVICE. \*DENOTE NUMBER TO DIFFERENTIATE BETWEEN DIFFERENT DEVICES.  
TELEPHONE OUTLET  
DATA COMMUNICATION OUTLET  
GROUND CONNECTION BOLTED TYPE  
DISCONNECT SWITCH  
MOTOR STARTER  
MOTOR  
PUSHBUTTON STATION "SS" START-STOP, "LOS" LOCKOUT-STOP, "SLOS" START-LOCKOUT-STOP  
RACEWAY BOX "JB" JUNCTION BOX  
"MH" MANHOLE  
"HH" HANDHOLE  
"PB" PULLBOX  
"TB" TERMINAL BOX  
JUNCTION BOX OR FITTING  
FIELD INSTRUMENT I.E. "PSL" PRESSURE SWITCH  
"LSH" LEVEL SWITCH  
"SV" SOLENOID VALVE  
SOLENOID VALVE  
THERMOSTAT  
HEATER  
HORN  
DENOTES REFERENCE TO NOTE I  
I.E. - "SEE NOTE I"  
GROUND ROD 3/4" x 10' - 0" WITH GROUND WELL (UNLESS OTHERWISE NOTED)  
GROUND CONNECTION - EXOTHERMIC TYPE  
MOTOR OPERATED VALVE

- BUS  
ACROSS-THE-LINE, NON-REVERSING, II INDICATES NEMA SIZE 2 MAGNETIC STARTER  
NEMA SIZE 4 MAGNETIC STARTER:  
PW - PART WINDING, REV - REVERSING  
RV - REDUCED VOLTAGE, AUTO-AUTO TRANSFORMER  
2SP-2W - TWO SPEED, TWO WINDING  
CONTACTOR, SIZE AS NOTED  
UNIT MOUNTED COMBINATION STARTER  
SOLID STATE REDUCED VOLTAGE STARTER  
VACUUM CONTACTOR  
MOLDED CASE CIRCUIT BREAKER, 3 POLE UNLESS OTHERWISE NOTED. 50A.-TRIP RATING IN AMPERE  
NA-NON-AUTOMATIC  
MCP - MOTOR CIRCUIT PROTECTOR  
AF-FRAME SIZE (225 AMPS NOTED)  
AT-TRIP RATING (125 AMPS NOTED)  
MEDIUM OR HIGH VOLTAGE DRAWOUT BREAKER  
DRAWOUT BREAKER, SIZE AS NOTED  
EO - DENOTES ELECTRICALLY OPERATED  
MEDIUM OR HIGH VOLTAGE STARTER  
LIGHTNING ARRESTOR  
MOTOR 10 HP NOTED  
TRANSFORMER WITH GROUNDED SECONDARY, KVA SIZE & VOLTAGE RATIO AS NOTED.  
POTENTIAL TRANSFORMER, RATIO AND NUMBER OF PT'S AS NOTED  
CURRENT TRANSFORMER, RATIO AND NUMBER OF CT'S AS NOTED  
E: ELECTRICAL INTERLOCK  
K: KEY INTERLOCK  
ELECTRICAL ENCLOSURE OUTLINE  
EQUIPMENT WITH INTEGRAL CONTROLLER  
DISCONNECT SWITCH, SIZE AS NOTED  
FUSED DISCONNECT SWITCH  
CAPACITOR, KVAR AS NOTED  
AMMETER  
VOLTMETER  
AMMETER SWITCH  
VOLTMETER SWITCH  
SURGE AND LIGHTNING ARRESTER

- CONTROL RELAY OR COIL  
I: MCC NUMBER  
M: STARTER HOLDING COIL  
CR: CONTROL RELAY  
TD: TIME DELAY RELAY  
I2: MCC FEEDER NUMBER 12  
I: RELAY NUMBER J.  
SOLID STATE STARTER CONTROL FUNCTION  
N.O. CONTACT  
N.C. CONTACT  
TORQUE SWITCH (SPECIFY WHEN OPEN)  
NORMALLY OPEN LIMIT SWITCH  
NORMALLY CLOSED LIMIT SWITCH  
FLOAT TYPE LIQUID LEVEL SWITCH, CLOSING ON RISING LEVEL  
FLOAT TYPE LIQUID LEVEL SWITCH, OPENING ON RISING LEVEL  
VACUUM OR PRESSURE SWITCH, CLOSING ON RISING PRESSURE  
VACUUM OR PRESSURE SWITCH, OPENING ON RISING PRESSURE  
TEMPERATURE ACTUATED SWITCH, CLOSING ON RISING TEMPERATURE  
TEMPERATURE ACTUATED SWITCH, OPENING ON RISING TEMPERATURE  
FLOW SWITCH (AIR, WATER, ETC.), CLOSING ON FLOW INCREASE  
FLOW SWITCH (AIR, WATER, ETC.), OPENING ON FLOW INCREASE  
NORMALLY OPEN PUSHBUTTON, MOMENTARY CLOSE  
NORMALLY CLOSED PUSHBUTTON, MOMENTARY OPEN  
NO/NC MAINTAINED PUSHBUTTON  
TWO-POSITION SELECTOR SWITCH:  
H-HAND, M-MANUAL, R-REMOTE, L-LOCAL, A-AUTOMATIC, O-OFF  
THREE-POSITION SELECTOR SWITCH. (SAME AS ABOVE)  
THREE-POSITION SPRING RETURN-TO-CENTER MOMENTARY CONTACT SWITCH ("LATCH-UNLATCH," "ON-OFF," ETC.)  
SINGLE POLE TOGGLE SWITCH ("ON-OFF", ETC.)  
GROUND CONNECTION  
OVERLOAD RELAY CONTACTS (MAGNETIC)  
TIMED CONTACTS - CONTACT ACTION DELAYED AFTER COIL IS :  
ENERGIZED  
DE-ENERGIZED  
NORMALLY OPEN WITH TIME DELAY CLOSING  
NORMALLY CLOSED WITH TIME DELAY OPENING  
NORMALLY OPEN WITH INSTANT CLOSING AND TIME DELAY OPENING

- NORMALLY CLOSED WITH INSTANT OPENING AND TIME DELAY CLOSING  
MANUAL MOTOR STARTER WITH OVERLOAD PROTECTION  
FUSE  
RESISTOR (FIXED)  
POTENTIOMETER TYPE RESISTOR (CONTINUOUSLY ADJUSTABLE)  
PUSH-TO-TEST INDICATING LIGHT  
ELAPSED TIME METER  
HEATER  
CROSSING OF CONDUCTORS-NOT CONNECTED  
CONNECTION OF CONDUCTORS, FITTING AS REQUIRED  
STRESS RELIEF CONNECTION  
ELECTRODE PROBES  
PANEL DOOR MOUNTED DEVICE  
FIELD OR REMOTE MOUNTED DEVICE  
CONTACT AT PCM, DCS, PLC, RTU OR LCP

MOTOR OPERATED VALVE  
LIMIT SWITCH CONTACT DEVELOPMENT

CONTACT	VALVE POSITION		
	FULL OPEN	INTERMEDIATE	FULLY CLOSED
COO	CLOSE	OPEN	OPEN
OOC	OPEN	OPEN	CLOSE
CCO	CLOSE	CLOSE	OPEN
OCC	OPEN	CLOSE	CLOSE

The limited review of this document by PBS & J on behalf of the Olivenhain Municipal Water District, is intended as a limited review only for general conformance with: (1) This approved Design/Build Olivenhain Municipal Water District. This limited review in no way is intended, nor shall it act, to relieve the Design/Build Team of any professional liability to the responsibility to provide a complete and functional facility that is compliant with all applicable specifications, standards, codes, and regulations.

PBS & J  
Date 8/23/01 By J. J. J.



REV	DATE	BY	OMWD	DESCRIPTION

SCALE	WARNING 0 1/2 1 IF THIS BAR DOES NOT MEASURE 1" THEN DRAWING IS NOT TO SCALE
NONE	

DESIGNED	N. CONCEPCION
DRAWN	N. CHRAKIAN
CHECKED	K.D. CHUN

SUBMITTED BY	George R. Bant
PROJECT MANAGER	51802 12/13/00
LICENSE NO.	DATE
33689 12/13/00	DATE
LICENSE NO.	DATE



APPROVED	George R. Bant	8.29.01
OLIVENHAIN MWD	DATE	DATE
APPROVED		
FILANC CONSTRUCTION CO.		DATE

KELWOOD DEVELOPMENT COMPANY	SHEET
45 RANCH SANITATION DISTRICT	GE-1
WASTEWATER TREATMENT PLANT EXPANSION TO 2.0 MGD	OF SHEETS
NEIGHBORHOOD NO. 1 PUMP STATION	
ELECTRICAL SYMBOLS	



A B B R E V I A T I O N S

A	AMPERE, AUTO, AMMETER	FVR	FULL VOLTAGE REVERSING
AC	ALTERNATING CURRENT	FVNR	FULL VOLTAGE NON-REVERSING
A/C	AIR CONDITIONING	FWD	FORWARD CONTACTOR COIL
AF	AMPERE FRAME SIZE OF CKT. BRKRS	GALV	GALVANIZED
AFF	ABOVE FINISHED FLOOR	GEN	GENERATOR
AL	ALUMINUM	GFR	GROUND FAULT RELAY
AM	AMMETER	GFS	GROUND FAULT SENSOR
ANN	ANNUNCIATOR	GRD	GROUND
AMP	AMPERES, AMPERAGE	HH	HAND HOLE
APPR	APPROVED	HID	HIGH INTENSITY DISCHARGE
AS	AMMETER SWITCH, ADJUSTABLE SPEED	HIGH	HIGH SPEED CONTACTOR
		HOA	HAND - OFF - AUTOMATIC
AT	AMPERE TRIP	HP	HORSE POWER
ATS	AUTOMATIC TRANSFER SWITCH	HPS	HIGH PRESSURE SODIUM
AUTO	AUTOMATIC	HTR	HEATER
AWG	AMERICAN WIRE GAUGE	HVAC	HEATING VENTILATION AIR CONDITIONING
		HZ	HERTZ
BATT	BATTERY		
BKR	BREAKER	IMC	INTERMEDIATE METAL CONDUIT
BBL	BUBBLER	INCAND	INCANDESCENT
BLDG	BUILDING	IND	INDICATION (SYSTEM)
		I/O	INPUT/OUTPUT
C	CONDUIT, CLOSED	INST	INSTANTANEOUS
CAB	CABINET	INSTR	INSTRUMENT
CB	CIRCUIT BREAKER	IsC	SHORT CIRCUIT CURRENT, AMPS
CKT	CIRCUIT	INVT	INVERT
CO	CONDUIT ONLY		
COND	CONDUIT	JB	JUNCTION BOX
COMPT	COMPARTMENT	J BOX	JUNCTION BOX
COMPR	COMPRESSOR		
CP	CONTROL PANEL	KAIC	KILOAMPERE INTERRUPTING AND WITHSTAND CAPACITY
CPT	CONTROL POWER TRANSFORMER	KCM	THOUSAND CIRCULAR MILLS
CR	CONTROL RELAY	KVA	KILO (1000) VOLT AMPS
CT	CURRENT TRANSFORMER	KW	KILOWATTS
CU	COPPER	KWH	KILOWATT HOUR
DC	DIRECT CURRENT	LC	LIGHTING CONTACTOR
DH	DATA HIGHWAY	LCB	LOCAL CONTROL BOARD
DISC	DISCONNECT	LCP	LOCAL CONTROL PANEL
DISTR	DISTRIBUTION	LOC	LOCAL
DPDT	DOUBLE POLE DOUBLE THROW	L-O-R	LOCAL-OFF-REMOTE
DWG	DRAWING	LOS	PUSHBUTTON W/"LOCK-OUT-STOP"
		LS	LEVEL SWITCH
E	EMPTY, EMERGENCY	LT, LTS	LIGHT, LIGHTS
ELEV	ELEVATION	LTG	LIGHTING
EMERG	EMERGENCY	LOW	LOW SPEED CONTACTOR
EMT	ELECTRICAL METALLIC TUBING		
ENCL	ENCLOSURE	M	MOTOR CONTACTOR COIL
EO	ELECTRICALLY OPERATED	MA	MILLIAMPS
EP	EXPLOSION PROOF	MAN	MANUAL
EQPT	EQUIPMENT	MAG	MAGNETIC
ER	ELECTRODE LEVEL RELAY	MAX	MAXIMUM
ETM	ELAPSED TIME METER	MCC	MOTOR CONTROL CENTER
EXH	EXHAUST	MCB	MAIN CONTROL BOARD
EXIST	EXISTING	MCM	THOUSAND CIRCULAR MILS
		MD	MOTORIZED DAMPER
F, ~	FREQUENCY	MH	MANHOLE
FDR	FEEDER	MIN	MINUTES, MINIMUM
FLEX	FLEXIBLE	MLO	MAIN LUGS ONLY
FLUOR	FLUORESCENT	MOV	MOTOR OPERATED VALVE
FM	FREQUENCY METER	MS	MANUAL MOTOR STARTER
FUT	FUTURE	MT, MTD	MOUNT, MOUNTED

MTR	MOTOR	STA	STATION
MUX	MULTIPLEXING PANEL	STD	STANDARD
MVA	MILLION-VOLT-AMPERE	STL	STEEL
		STR	STARTER
N	NEUTRAL	SV	SOLENOID VALVE
NA	NON-AUTOMATIC OR NOT APPLICABLE	SW	SWITCH
NC	NORMALLY CLOSED	SYS	SYSTEM
NO, NOS	NUMBER, NUMBERS, NORMALLY OPEN		
NP	NAMEPLATE	TB	TERMINAL BOX
NIC	NOT IN CONTRACT	TC	TIME CLOCK
NITS	NOT IN THIS SECTION	TACH	TACHOMETER
NTS	NOT TO SCALE	TEMP	TEMPERATURE
		TERM	TERMINAL
O	OPEN	TH	THERMOSTAT
OC	ON CENTER	TM	REPEAT CYCLE TIMER
CC	CENTER TO CENTER	TD	TIME DELAY RELAY
OL	OVERLOAD RELAY	TS	TEMPERATURE SWITCH
OTT	TRANSFORMER OVERTEMPERATURE SW.	TYP	TYPICAL
P	POLE	UG	UNDERGROUND
PA	PUBLIC ADDRESS SYSTEM	UH	UNIT HEATER
PB	PUSHBUTTON	US	UNIT SUBSTATION
PCM	PROCESS CONTROL MODULE	UST	UNIT SUBSTATION TRANSFORMER
PCP	PROCESS CONTROL PANEL		
PF	POWER FACTOR	V	VOLTAGE, VOLTS
PH, Ø	PHASE	VAR	VAR METER
PLC	PROGRAMMABLE LOGIC CONTROLLER	VFD	VARIABLE FREQUENCY DRIVE
PNL	PANEL	VSD	VARIABLE SPEED DRIVE (OTHER THAN VFD)
PNLBD	PANELBOARD	VP	VAPORPROOF
POS	POSITION	VS	VARIABLE SPEED, VOLTMETER SWITCH
POT	POTENTIOMETER	W	WATTS, WIRE
PP	POWER PANEL	WHD	WATTHOUR DEMAND METER
PRI	PRIMARY	WHM	WATTHOUR METER
PS	PRESSURE SWITCH	WP	WEATHERPROOF
PT	POTENTIAL TRANSFORMER		
PVC	POLYVINYL CHLORIDE	XD	TRANSDUCER
PW	PART WINDING	XFMR	TRANSFORMER
PWR	POWER	XMTR	TRANSMITTER
REC	RECEPTACLE		
RECPTS	RECEPTACLES		
REQ'D	REQUIRED		
REV	REVERSE CONTACTOR COIL		
RGS	RIGID GALVANIZED STEEL		
RUN	RUN CONTACTOR COIL		
RTU	REMOTE TERMINAL UNIT		
RVAT	REDUCED VOLTAGE AUTO-TRANSFORMER		
RVNR	REDUCED VOLTAGE NON-REVERSING		
SCH	SCHEDULE		
SEC	SECONDS, SECONDARY		
SECT	SECTION		
SEL SW	SELECTOR SWITCH		
SEQ	SEQUENCE		
SHLD	SHIELDED		
SHT	SHEET		
SIG	SIGNAL		
SI, S2	START CONTACTOR COILS		
SP	SPARE		
SPDT	SINGLE POLE DOUBLE THROW		
SPECS	SPECIFICATIONS		
SP HTR	SPACE HEATER		
SPST	SINGLE POLE SINGLE THROW		
ST, SH	SHUNT TRIP		

The limited review of this document by PBS & J on behalf of the Olivenhain Municipal Water District, is intended as a limited review only for general conformance with: (1) This approved Design/Build documents, (2) Accepted standards of practice within the industry, and (3) The standards of the Olivenhain Municipal Water District. This limited review in no way is intended, nor shall it act, to relieve the Design/Build Team of any professional liability to the responsibility to provide a complete and functional facility that is compliant with all applicable specifications, standards, codes, and regulations.

PBS & J  
Date: 8/23/01 By: [Signature]

GENERAL NOTES

RACEWAY

- ALL CONDUIT, CABLE, CABLE TRAY RUNS ARE SHOWN DIAGRAMMATICALLY AND THEY SHALL BE ROUTED TO SUIT FIELD CONDITIONS.
- THE CONTRACTOR SHALL VERIFY EXACT LOCATION OF TERMINAL BOXES AND CONDUIT ENTRANCES OF ALL EQUIPMENT AGAINST SHOP DRAWINGS BEFORE STUBBING UP CONDUITS.
- CONNECTION BETWEEN RIGID CONDUIT AND MOTOR TERMINAL BOX SHALL BE LIQUID TIGHT FLEXIBLE CONDUIT.
- CONDUIT TERMINATING AT SWITCHBOARD, MOTOR CONTROL CENTER, POWER AND LIGHTING PANEL, CONTROL CABINET, ETC SHALL BE EQUIPPED WITH SEALING HUB AND GROUNDING BUSHING, AND SHALL BE GROUNDED WITH NO. 6 GROUND WIRE.
- INSTALL EXPANSION FITTINGS EVERY 200 FEET OF STRAIGHT RUN OF CONDUITS AND CABLE TRAYS.
- CONDUIT CROSSING BUILDING OR STRUCTURAL EXPANSION JOINTS SHALL BE PROVIDED WITH SUITABLE EXPANSION FITTINGS. THESE FITTINGS MUST BE CONSTRUCTED IN SUCH A MANNER THAT WILL INSURE THE CONTINUITY OF THE GROUND PATH IN EACH CONDUIT OR RACEWAY.
- CONDUIT FITTINGS AND SUPPORTS ARE NOT SHOWN ON THE DRAWINGS. THE CONTRACTOR SHALL PROVIDE ALL FITTINGS AND SUPPORT REQUIRED AND TO SUIT THE CONDITIONS.
- THE CONTRACTOR SHALL LIMIT THE NUMBER OF BENDS BETWEEN PULL POINTS.
- THE CONTRACTOR SHALL BE RESPONSIBLE FOR PROVIDING ALL SLEEVES AND OPENINGS REQUIRED FOR THE PASSAGE OF ELECTRICAL RACEWAYS OR CABLES EVEN WHEN THESE OPENINGS OR SLEEVES ARE NOT SPECIFICALLY SHOWN ON THE DRAWINGS.
- PROVIDE FLEXIBLE CONDUIT WHERE RIGID CONDUIT TERMINATES AT EQUIPMENT OR DEVICES SUBJECT TO MOVEMENT FROM VIBRATION, EXPANSION AND CONTRACTION.
- ALL UNDERGROUND CONDUIT RUNS SHALL BE WITH LONG RADIUS SWEEP BENDS. THE MINIMUM BENDING RADIUS SHALL BE 12 TIMES NOMINAL DIAMETER OF THE CONDUIT, AND NO FACTORY BENDS SHALL BE PERMITTED.
- ALL UNDERGROUND CONDUITS NOT ENCASED IN CONCRETE SHALL BE RIGID STEEL, GALVANIZED, PVC COATED.
- THE MINIMUM SIZE OF CONDUITS INSTALLED BELOW GRADE SHALL BE 1" UNLESS OTHERWISE NOTED.
- THE MINIMUM SIZE OF CONDUIT INSTALLED ABOVE GRADE SHALL BE 3/4" UNLESS OTHERWISE NOTED.
- ALL FLEXIBLE CONDUIT SHALL HAVE COPPER GROUNDING CONDUCTOR.
- FOR LIGHTING AND RECEPTACLE SYSTEMS, ONLY CONDUIT HOMERUNS AND CIRCUIT NUMBERS ARE SHOWN. CONTRACTOR SHALL PROVIDE AND INSTALL ALL NECESSARY CONDUITS, FITTINGS, JUNCTION BOXES AND ALL NECESSARY COMPONENTS SHOWN OR NOT SHOWN ON THE DRAWINGS TO MAKE ELECTRICAL INSTALLATION COMPLETE AND OPERATIONAL. ALL CONDUITS RUNS SHALL BE CONCEALED UNLESS INDICATED OTHERWISE. CIRCUIT LOADING SHALL BE AS SHOWN AND AS STATED IN PANEL SCHEDULE. ALL INSTALLATIONS SHALL BE IN ACCORDANCE WITH ALL CODES AND STANDARDS AS ENUMERATED IN SPEC. SECTION 16050. ALL MATERIALS SHALL BE IN ACCORDANCE WITH SPEC. SECTION 16400 AND 16500 ALL LIGHTING AND RECEPTACLE CIRCUITS SHALL INCLUDE 1#12 GROUND WIRE.

GROUNDING

- ALL METALLIC STRUCTURES, METALLIC ENCLOSURES, AND ELECTRICAL EQUIPMENT, SUCH AS STRUCTURAL STEEL, METALLIC RACEWAY, FENCE, STAIR HANDRAILS, LIGHTING POLE, TANK, VESSELS, SWITCHING EQUIPMENT, PANEL, EQUIPMENT ENCLOSURE AND CABINETS GENERATOR, MOTOR, TRANSFORMERS, SWITCHGEAR, ETC. SHALL BE PERMANENTLY AND EFFECTIVELY GROUNDED AND GROUND CONNECTION SHALL BE MADE TO THE PLANT GROUND GRID. THE EQUIPMENT GROUNDING CONDUCTOR SHALL BE SIZED PER N.E.C. UNLESS OTHERWISE SHOWN EXCEPT THE MINIMUM SIZE SHALL BE #2AWG.
- GROUNDING CONDUCTOR STUB-UP AND INSERT LOCATION ARE APPROXIMATE ONLY. THE CONTRACTOR SHALL USE HIS BEST JUDGEMENT FOR CORRECT LOCATIONS IN FIELD.
- ALL GROUNDING GRID CONDUCTORS SHALL BE #4/0 SIZE UNLESS OTHERWISE NOTED.
- ALL GROUND CONDUCTOR SHALL BE BARE, COPPER, STRANDED UNLESS OTHERWISE NOTED.
- ALL GROUNDING CONDUCTOR SHALL BE MINIMUM OF 18" BELOW GRADE EXCEPT UNDER BUILDING SLAB WHEN THEY SHALL BE MINIMUM OF 6" BELOW SLAB.

EQUIPMENT AND DEVICES


- LOCATIONS OF EQUIPMENT, CONTROL DEVICES, INSTRUMENTS, BOXES, PANELS, ETC ARE APPROXIMATE ONLY, AND PROPER JUDGEMENT MUST BE EXERCISED IN EXECUTING THE WORK TO INSURE THE BEST POSSIBLE INSTALLATION.
- PACKAGE EQUIPMENT. SOME CONDUITS AND WIRES ARE SHOWN ON THE DRAWINGS, BUT IT IS EXPECTED THAT SOME ADDITIONAL CONDUITS AND WIRES MAY BE REQUIRED BY EQUIPMENT MANUFACTURERS TO COMPLETE INSTALLATION. IT IS INCUMBENT UPON THE GENERAL CONTRACTOR TO COORDINATE THIS REQUIREMENT WITH HIS SUBCONTRACTORS TO MAKE SURE THAT EQUIPMENT SUPPLIER PROVIDES ALL NECESSARY ELECTRICAL INFORMATION TO HIS ELECTRICAL SUBCONTRACTOR FOR INCLUSION OF COSTS IN BID PACKAGE. ALL NECESSARY MATERIALS AND LABOR TO COMPLETE ELECTRICAL INSTALLATION SHALL BE PROVIDED WHETHER SHOWN OR NOT SHOWN ON THE DRAWINGS. ALL ELECTRICAL WORK SHALL BE IN ACCORDANCE WITH ALL CODES AND STANDARDS PER SPEC. SECTIONS DIVISION 16.
- ALL EQUIPMENT DIMENSIONS SHOWN ON PLANS AND ELEVATIONS ARE APPROXIMATE ONLY. THE CONTRACTOR SHALL USE THE SHOP DRAWINGS FOR PROPER LAYOUT, FOUNDATION AND PAD, ETC. FOR FINAL INSTALLATION. WITHOUT ANY ADDITIONAL COST TO THE OWNER.
- SWITCHGEAR, SWITCHBOARD, MOTOR CONTROL CENTER AND ALL FREE STANDING PANEL SHALL BE SET ON CONCRETE PAD AND LEVELING CHANNELS EMBEDDED IN THE PAD UNLESS OTHERWISE NOTED.
- ALL EQUIPMENT OR CUSTOM-MADE PANELS SHALL BE "UL" LISTED OR CERIFIED BY A TESTING AGENCY ACCEPTABLE TO BUILDING DEPARTMENT.

SCHEMATIC DIAGRAMS

- ALL CONTROLS ARE SHOWN DE-ENERGIZED
- ALL CONTROL DIAGRAMS SHOW CONTROL FUNCTION ONLY. CONTRACTOR SHALL INCORPORATE OTHER NECESSARY FUNCTIONS FOR PROPER OPERATIONS AND PROTECTION ON THE SYSTEM.
- SLAVE RELAY SHALL BE ADDED WHERE REQUIRED TO PROVIDE ALL NECESSARY CONTACTS FOR THE SCHEMATIC DIAGRAMS SHOWN.
- ALL DEVICES SHOWN ON MOTOR STARTER SCHEMATIC DIAGRAMS SHALL BE MOUNTED IN THE MOTOR STARTER CUBICLES UNLESS OTHERWISE NOTED.
- ALL DEVICES SHOWN IN THE CONTROL PANEL OR CABINET SHALL BE MOUNTED IN THE CONTROL PANEL OR CABINET UNLESS OTHERWISE NOTED.
- ALL MOTOR OPERATED VALVES ARE SHOWN FULLY OPEN.

MISCELLANEOUS

- IN CASE OF INTERFERENCE BETWEEN ELECTRICAL EQUIPMENT SHOWN ON THE DRAWINGS AND THE OTHER EQUIPMENT, THE CONTRACTOR SHALL NOTIFY THE ENGINEER IN WRITING AND ENGINEER SHALL REVIEW THE PROPOSED CHANGES BEFORE THEY ARE MADE.
- ALL RECEPTACLES SHALL BE MOUNTED 15' ABOVE FLOOR SURFACE UNLESS OTHERWISE NOTED.
- ALL RECEPTACLES IN OUTDOOR AND ANTICIPATED WET AREA SHALL BE GROUND FAULT INTERRUPTER RECEPTACLES.
- ALL OUTDOOR DEVICES SHALL BE WEATHERPROOF TYPE.
- LOCATION OF MANHOLES AND PULLBOXES ARE APPROXIMATE. CONTRACTOR SHALL COORDINATE EXACT LOCATION OF MANHOLES AND PULLBOXES WITH MECHANICAL AND CIVIL WORK.
- CONTRACTOR SHALL PROVIDE ADDITIONAL MANHOLES OR PULLBOXES TO THOSE SHOWN WHERE THEY ARE REQUIRED TO MAKE A WORKABLE INSTALLATION.
- CIRCUITS OF DIFFERENT SERVICE VOLTAGE SHALL BE INSTALLED IN SEPARATE RACEWAYS, MANHOLES, HANDHOLES, PULLBOXES AND JUNCTION BOXES. THE VOLTAGE AND SERVICE LEVELS ARE:  
① 12KV, 13.2KV, 16.5KV, 21KV  
② 2.4KV, 5KV  
③ 120V-480VOLT  
④ INSTRUMENTATION LESS THAN 50VDC  
⑤ TELEPHONE AND COMMUNICATIONS.

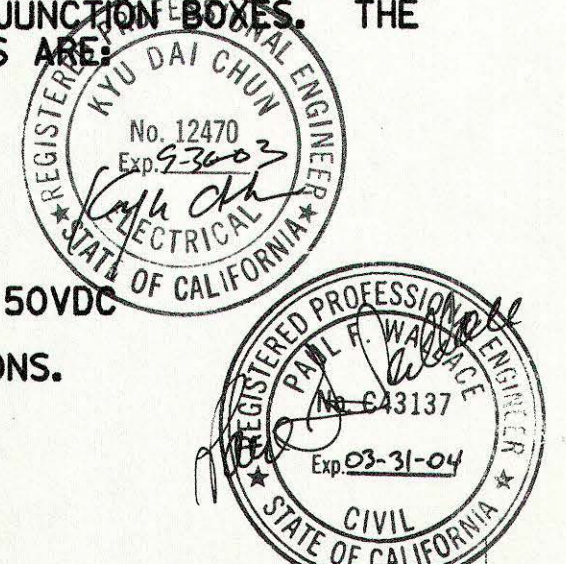

REV	DATE	BY	OMWD	DESCRIPTION	SCALE	WARNING	DESIGNED	N. CONCEPCION	DRAWN	N. CHRAKIAN	CHECKED	K.D. CHUN	SUBMITTED BY	PROJECT MANAGER	DATE	12/13/00	LICENSE NO.	33699	DATE	12/13/00	APPROVED	George R. Bont	DATE	8.29.01	APPROVED	FILANC CONSTRUCTION CO.	DATE		KELWOOD DEVELOPMENT COMPANY	45 RANCH SANITATION DISTRICT	WASTEWATER TREATMENT PLANT EXPANSION TO 2.0 MGD	NEIGHBORHOOD NO. 1 PUMP STATION	ELECTRICAL ABBREVIATIONS AND GENERAL NOTES	SHEET	GE-2	OF • SHEETS
-----	------	----	------	-------------	-------	---------	----------	---------------	-------	-------------	---------	-----------	--------------	-----------------	------	----------	-------------	-------	------	----------	----------	----------------	------	---------	----------	-------------------------	------	--	-----------------------------	------------------------------	---	---------------------------------	--	-------	------	-------------

















1424

Plot Date: 12-DEC-2000

File: p:\Projects\45R\general details\ele\neighbor\45rnee03.dwg

Job No: NW Job #

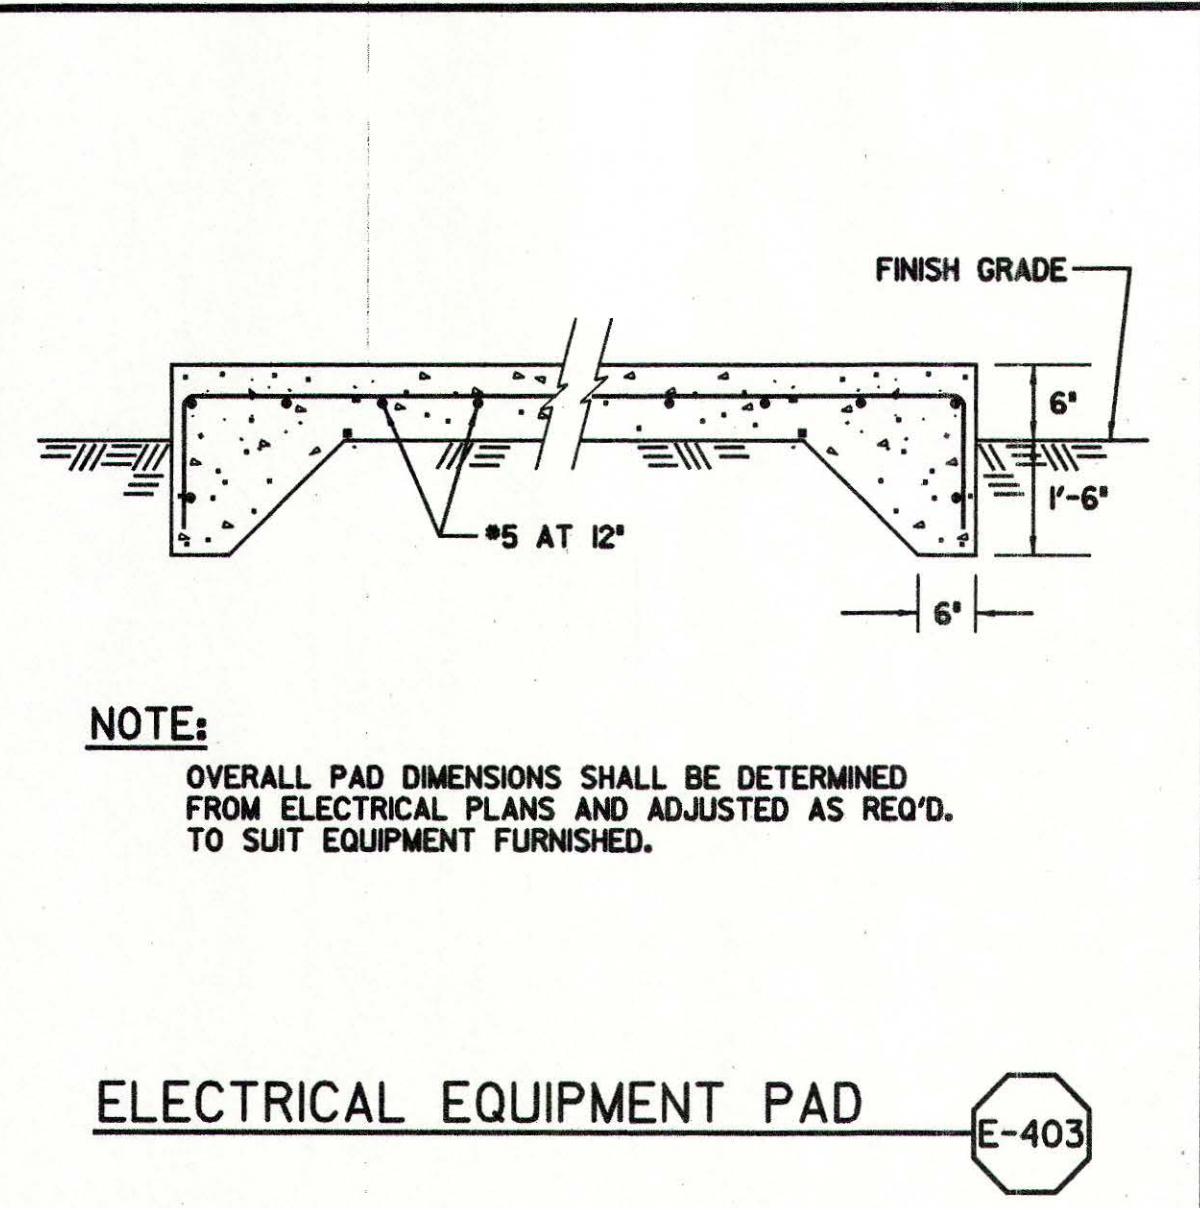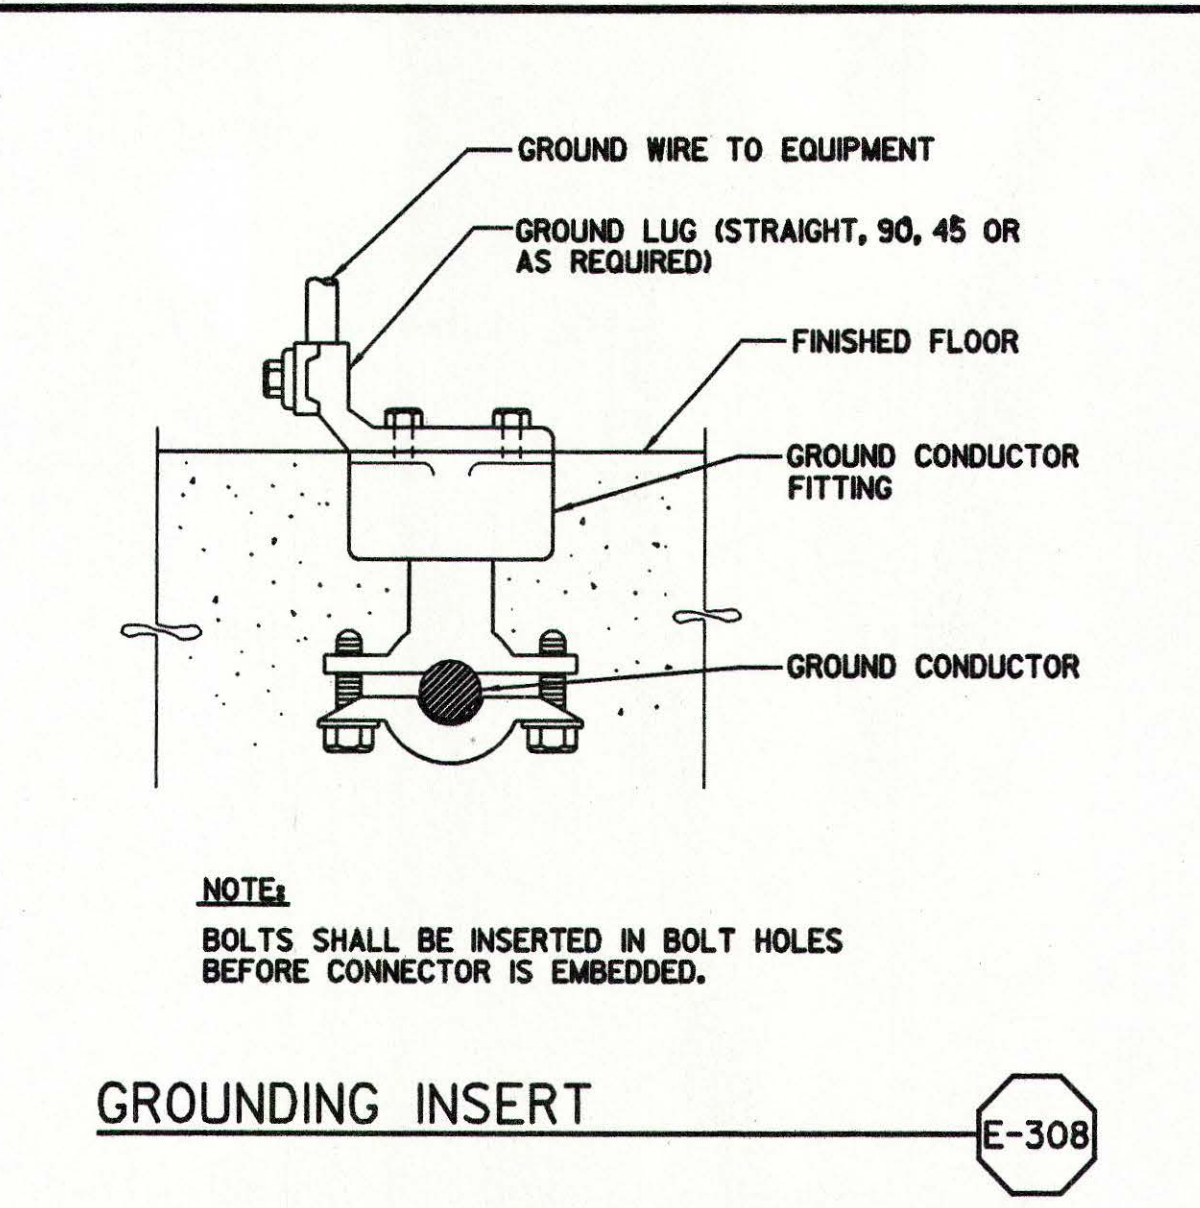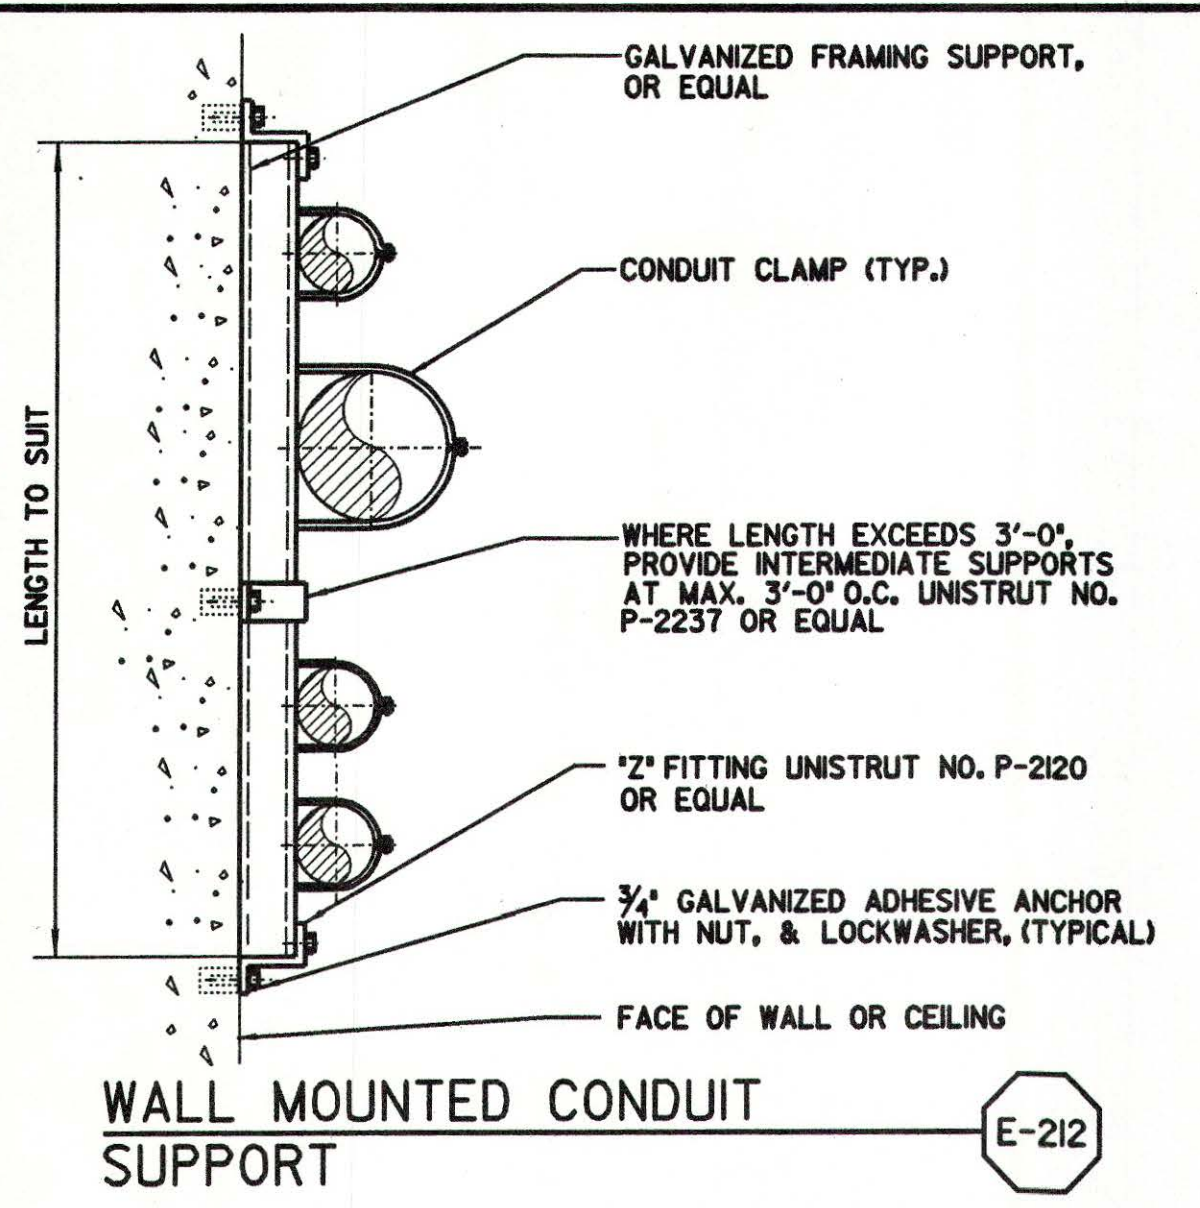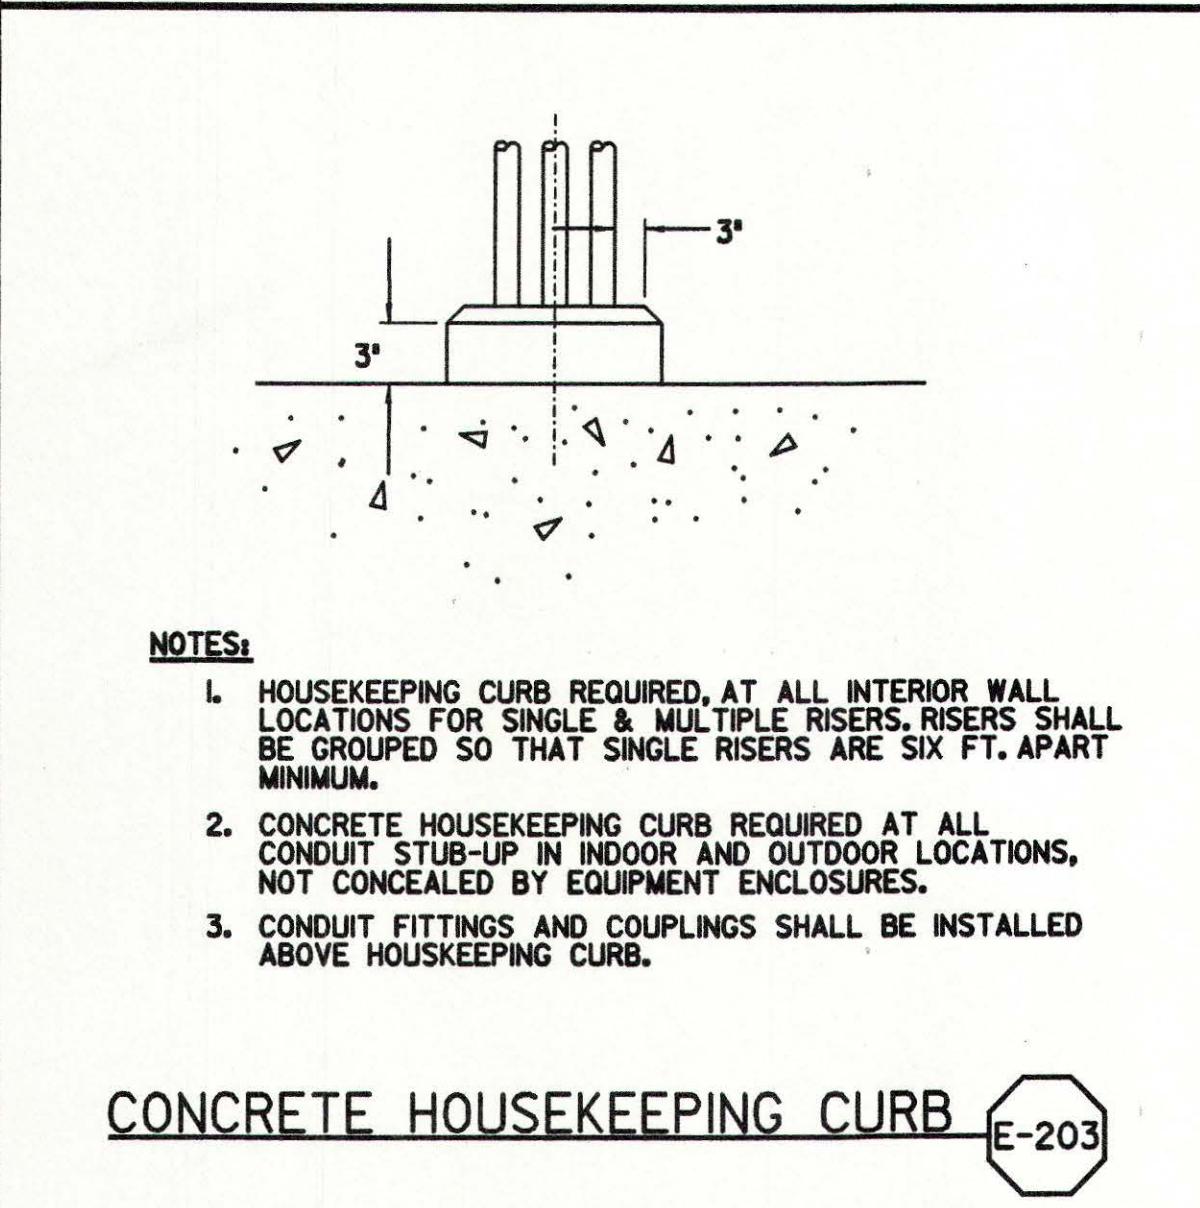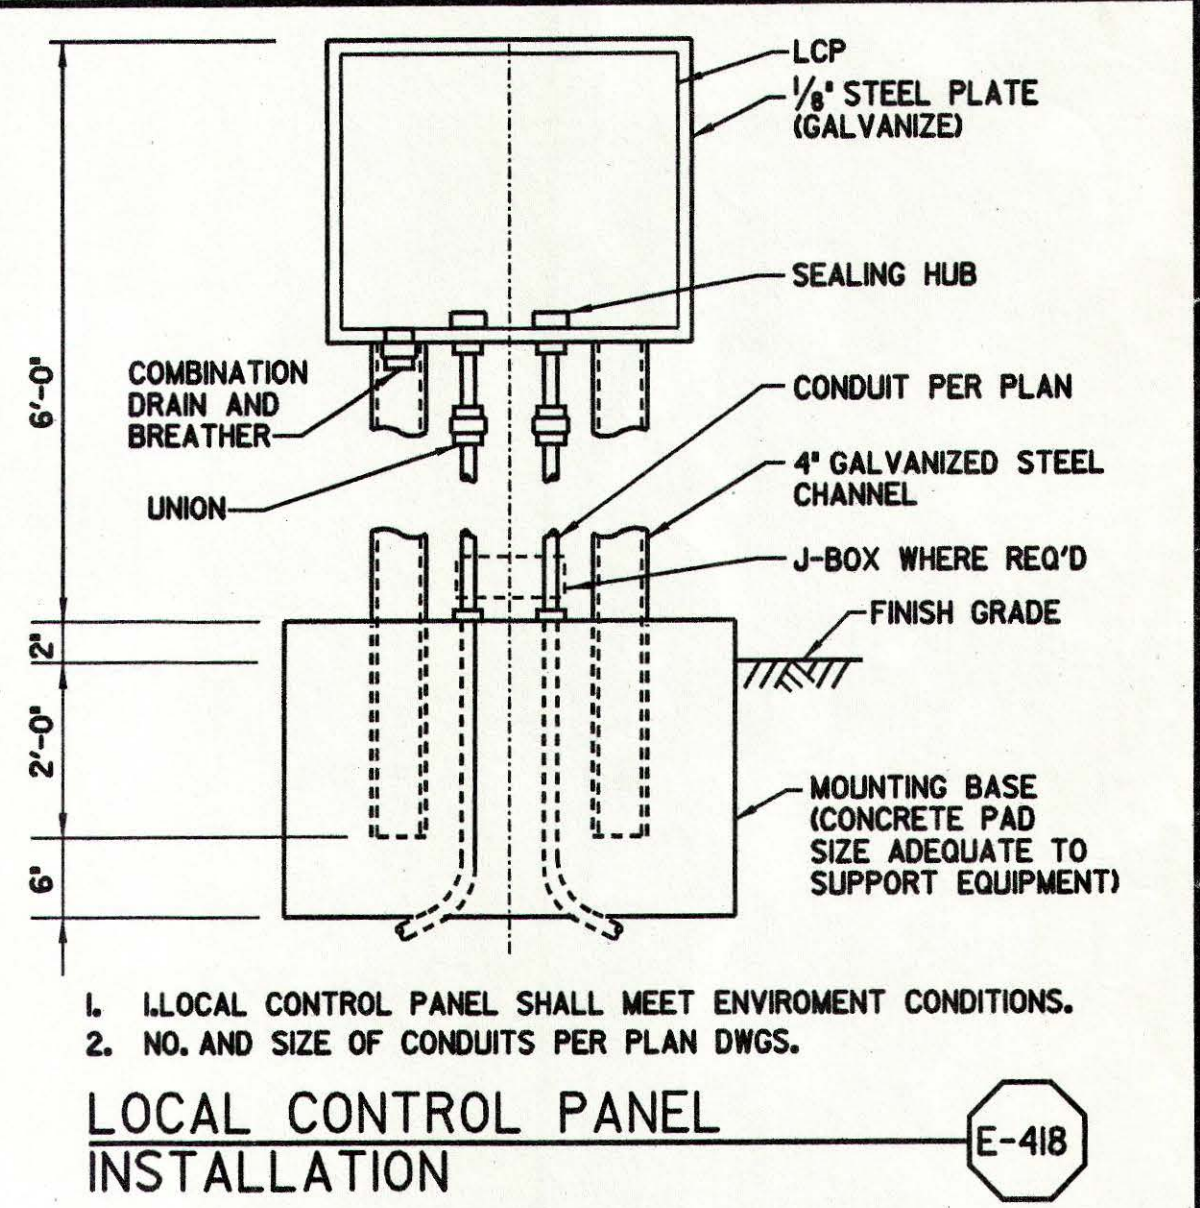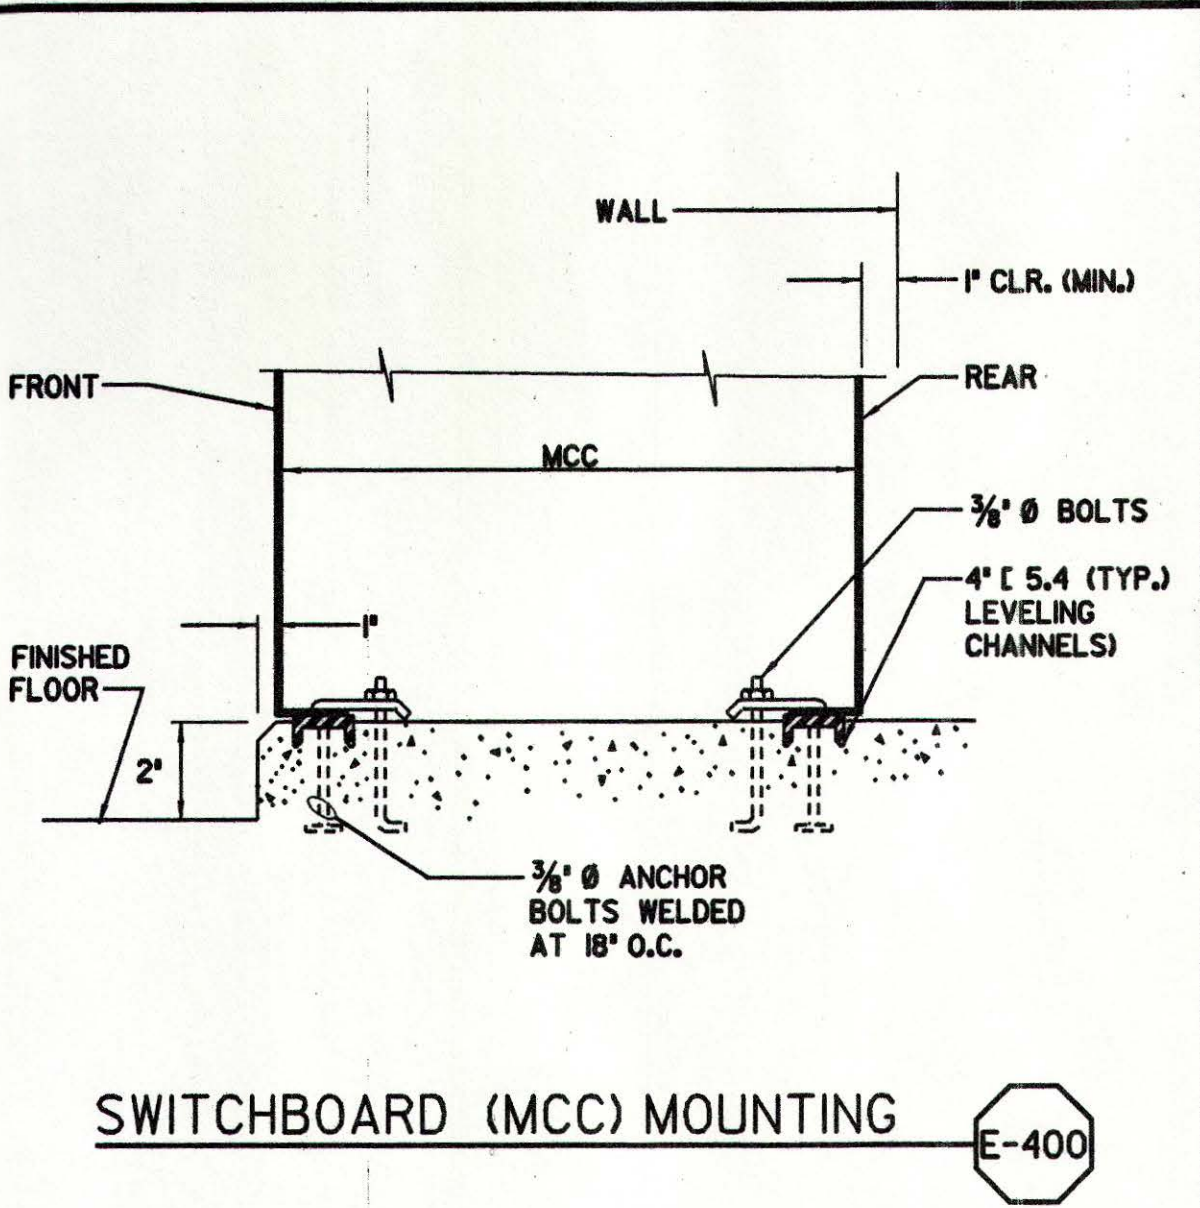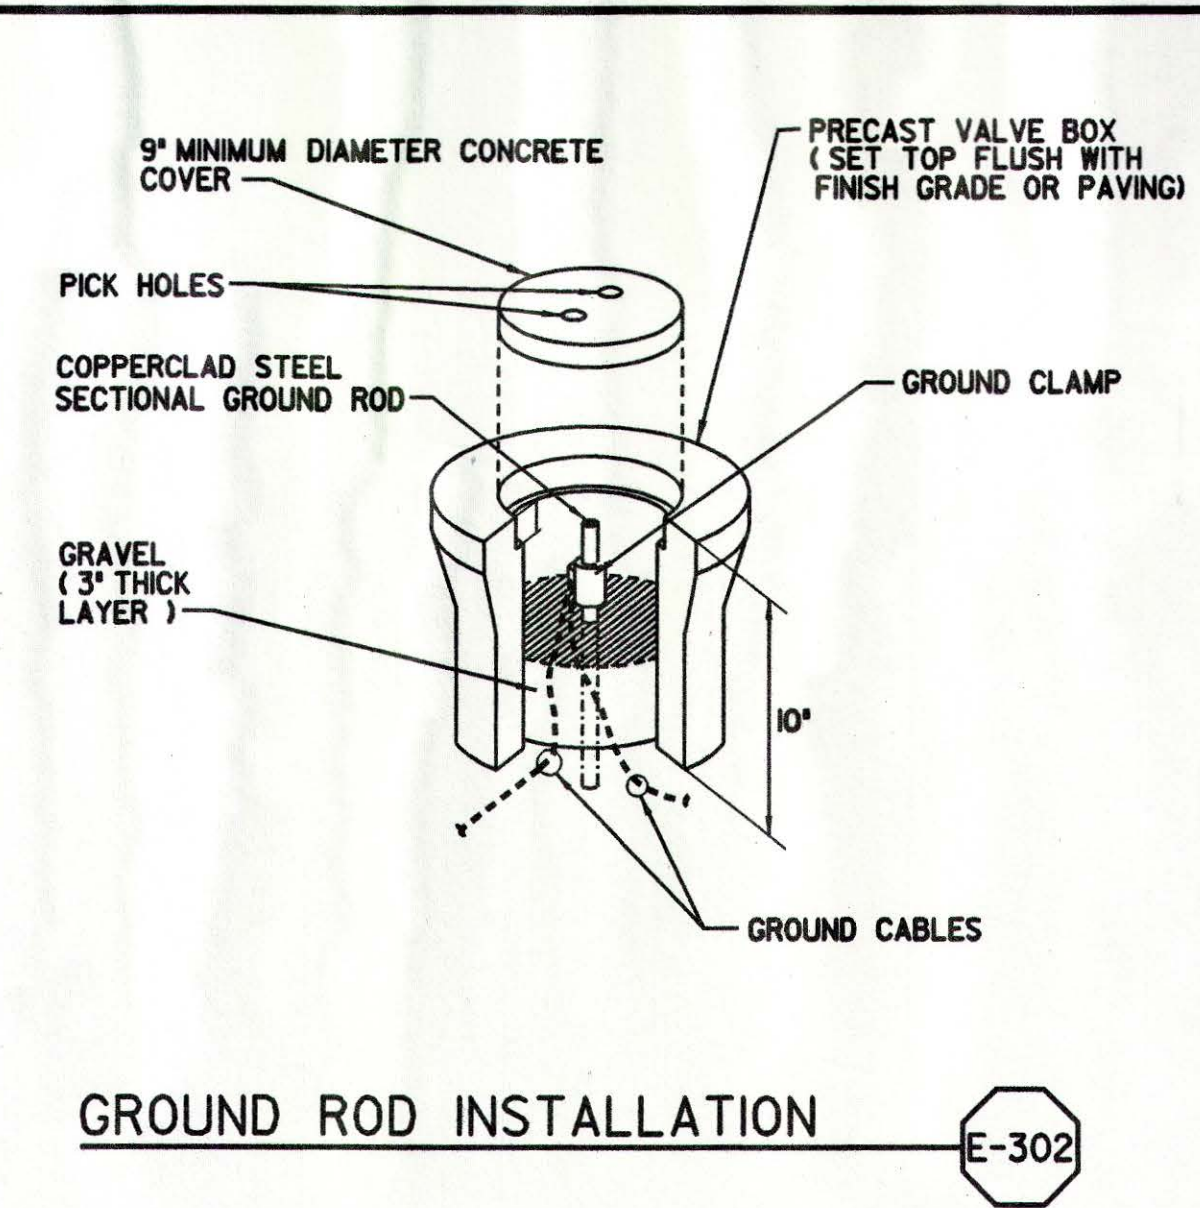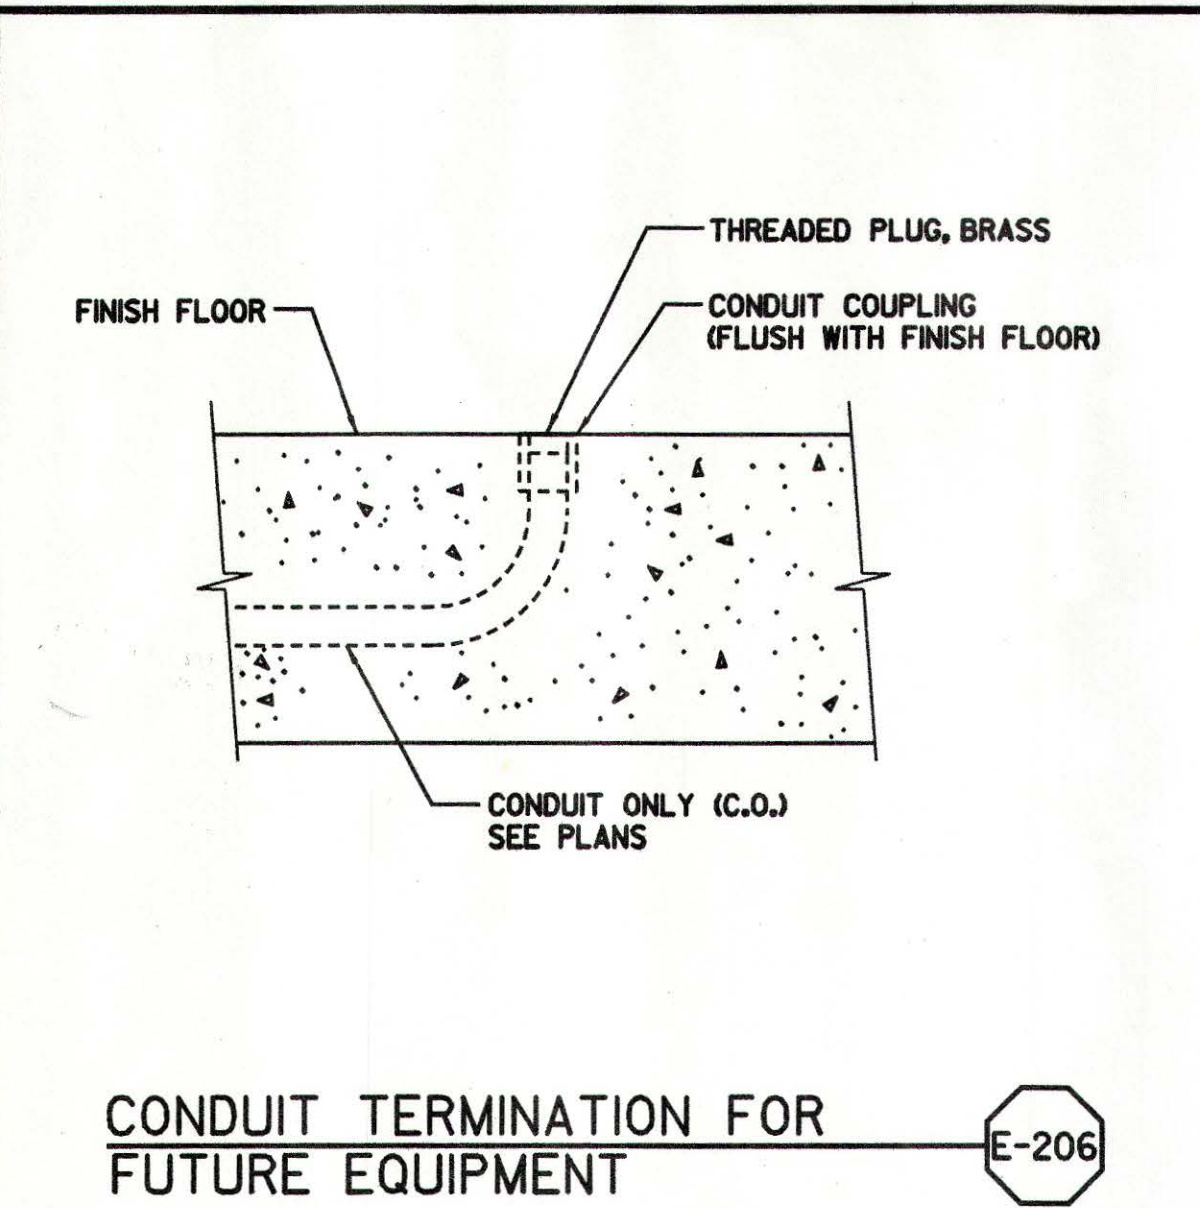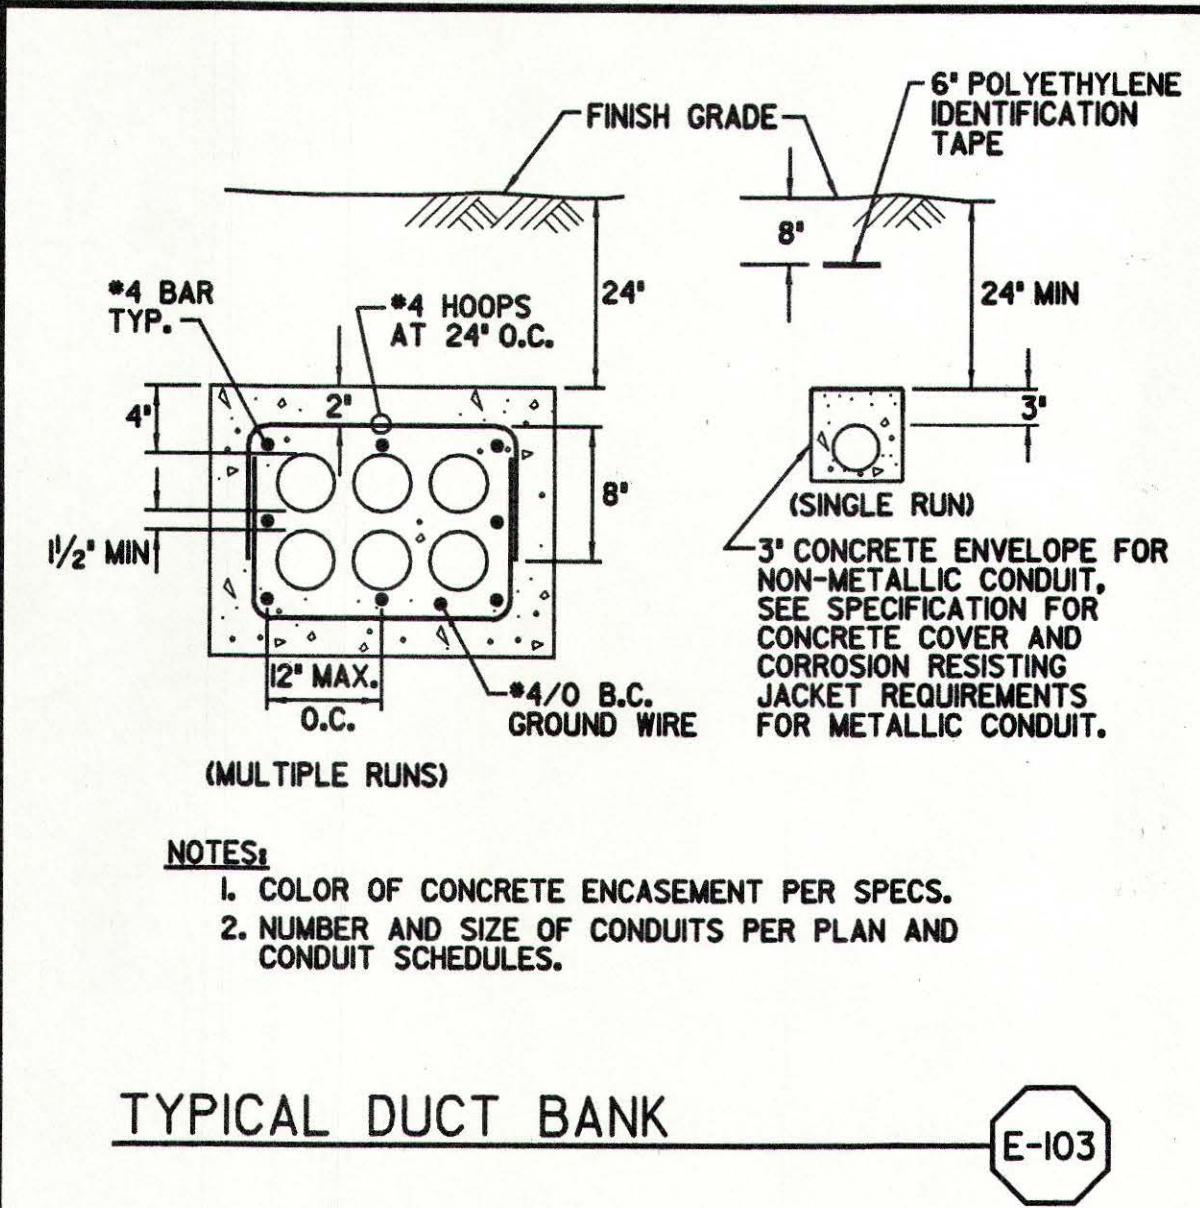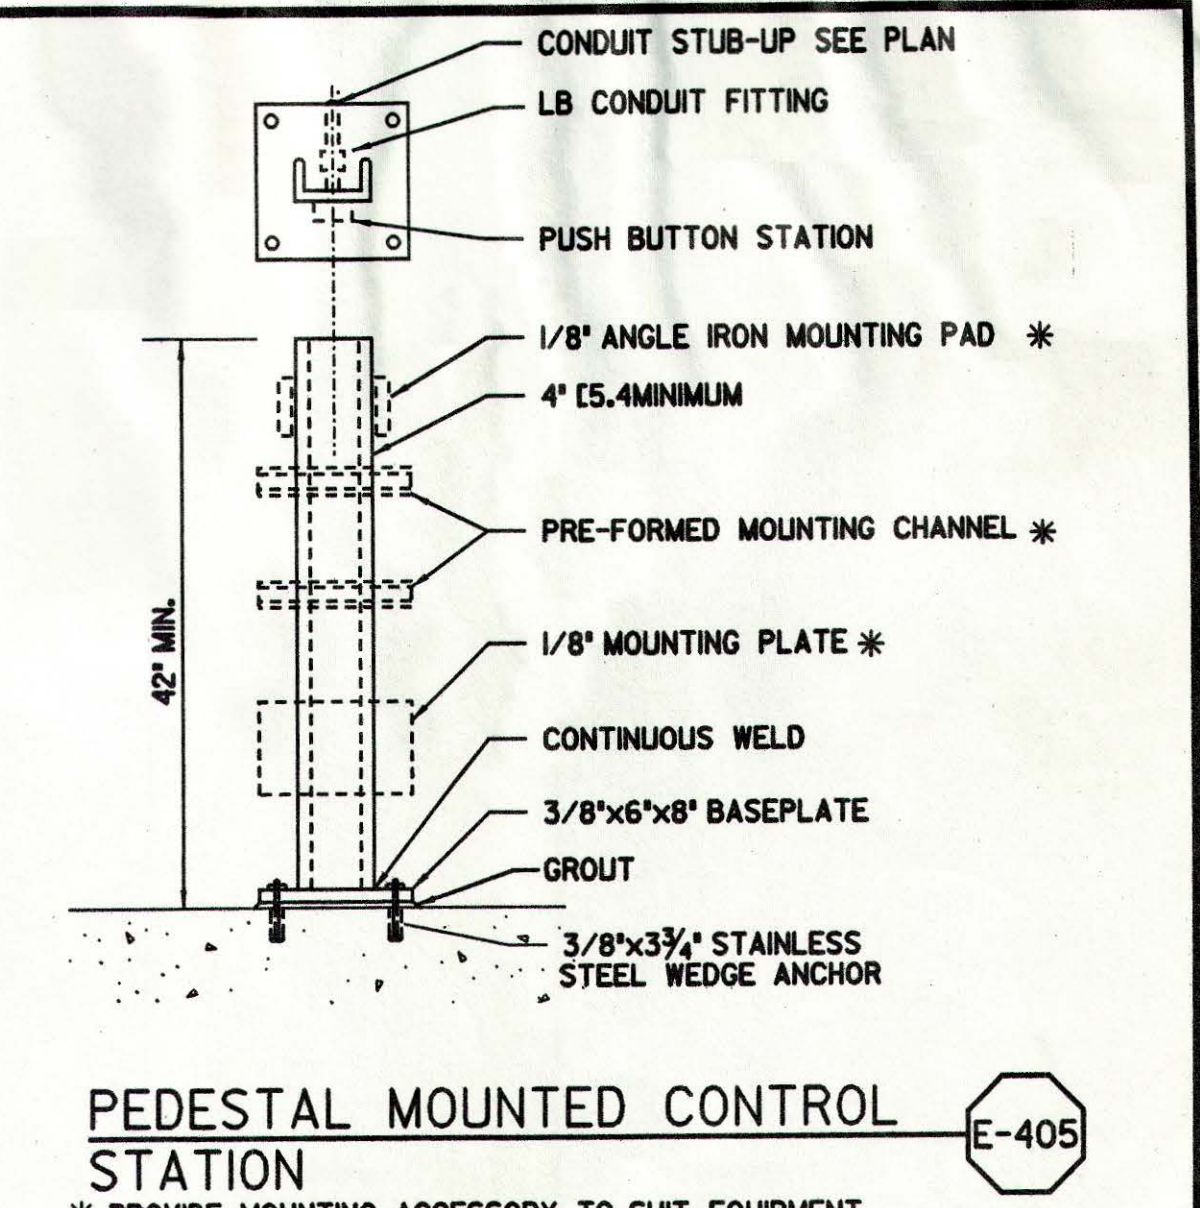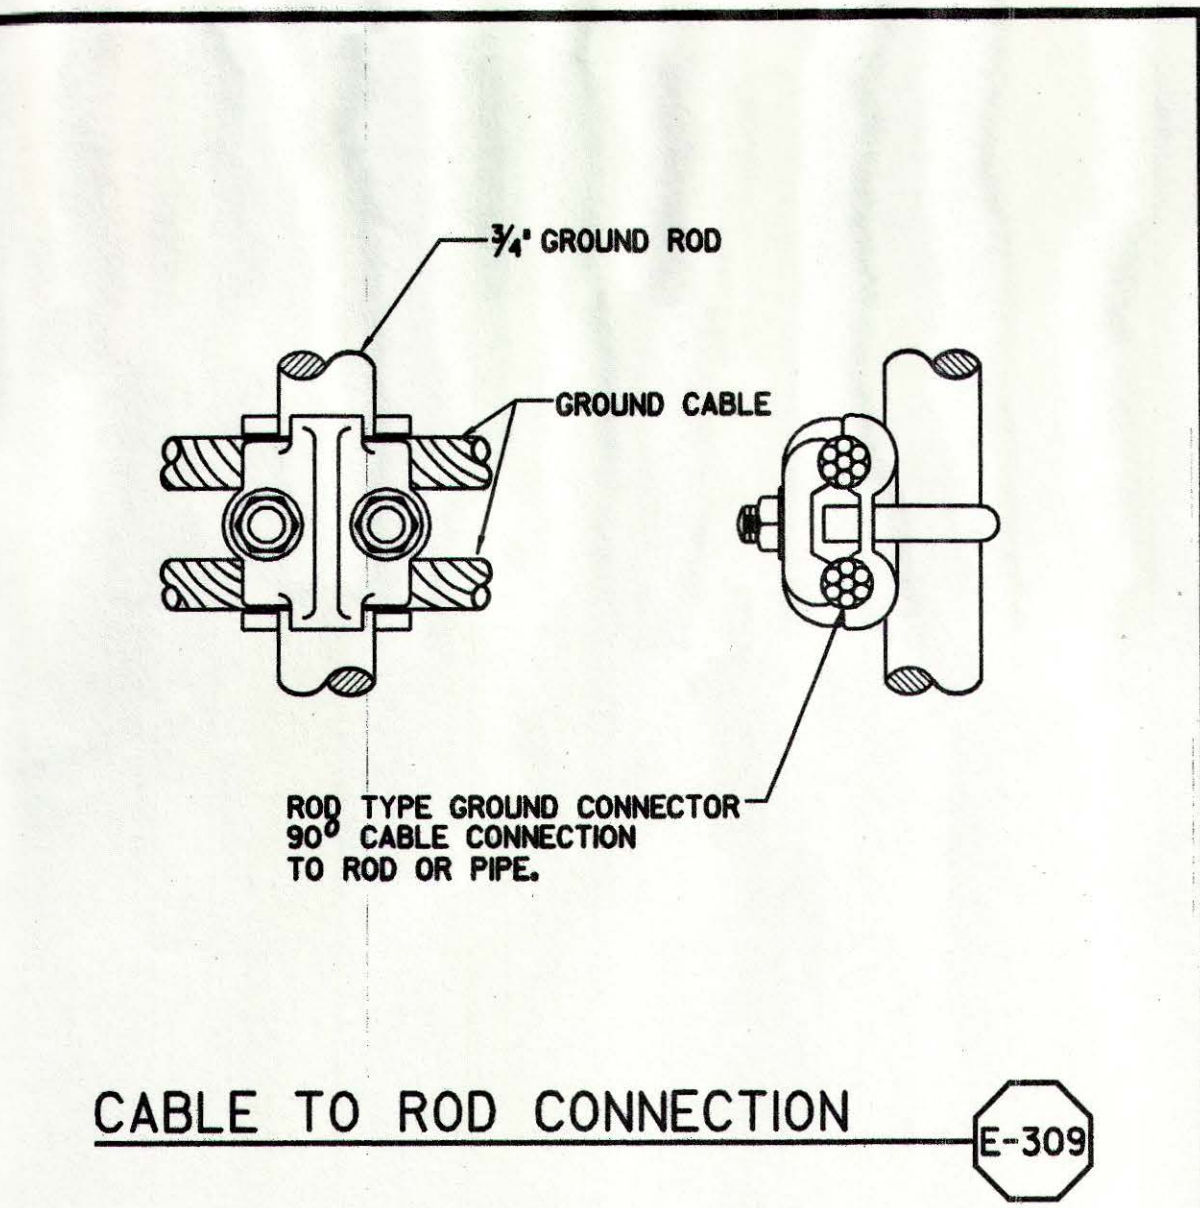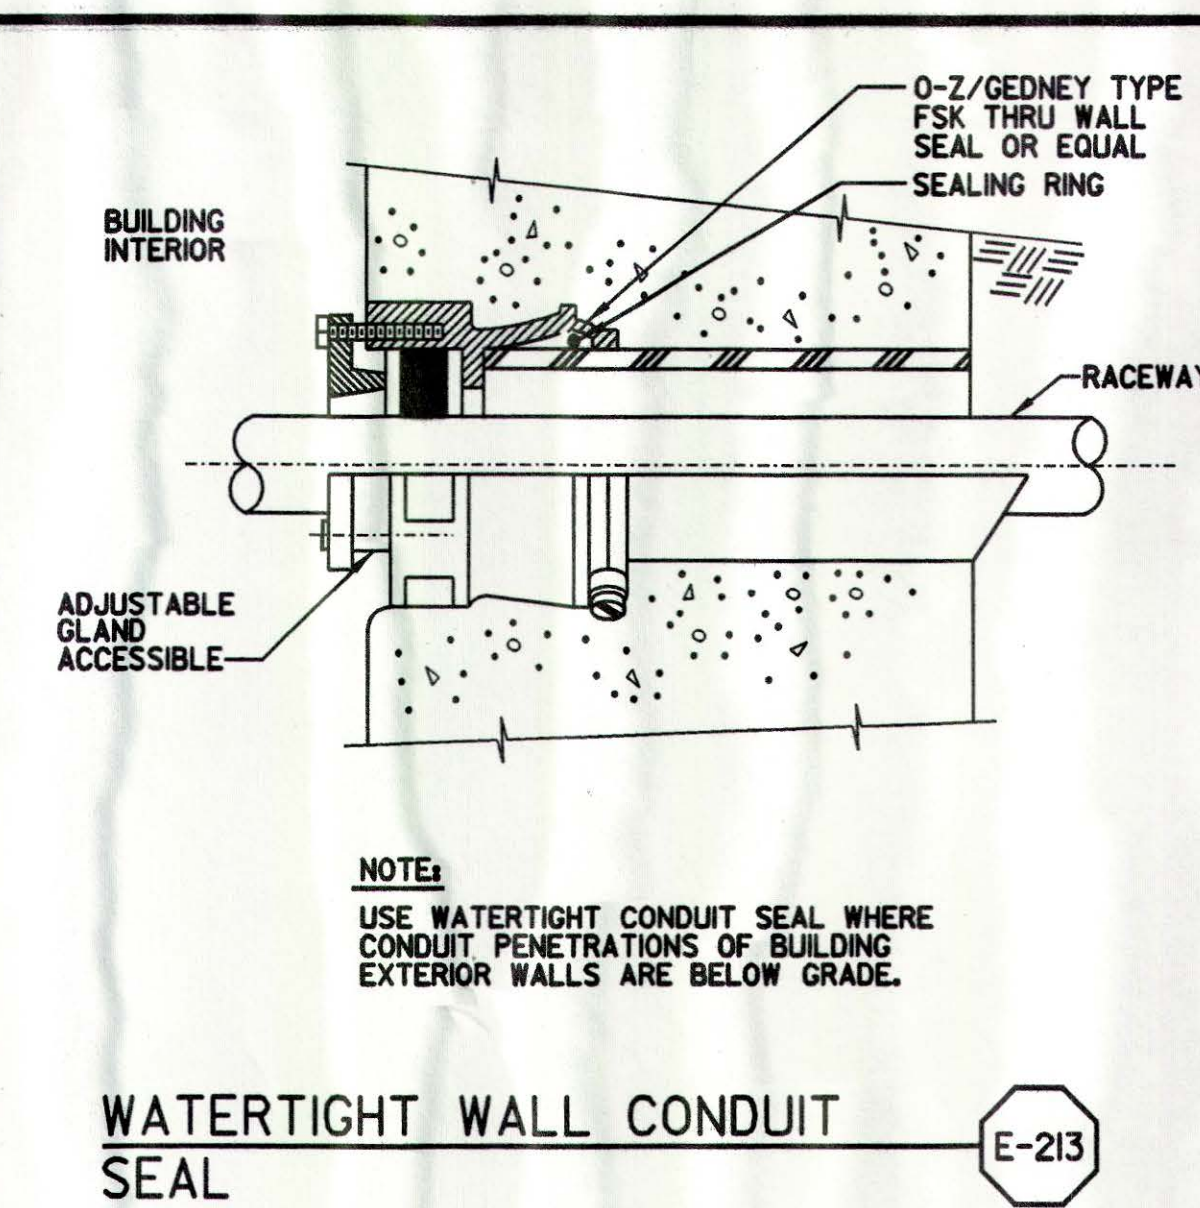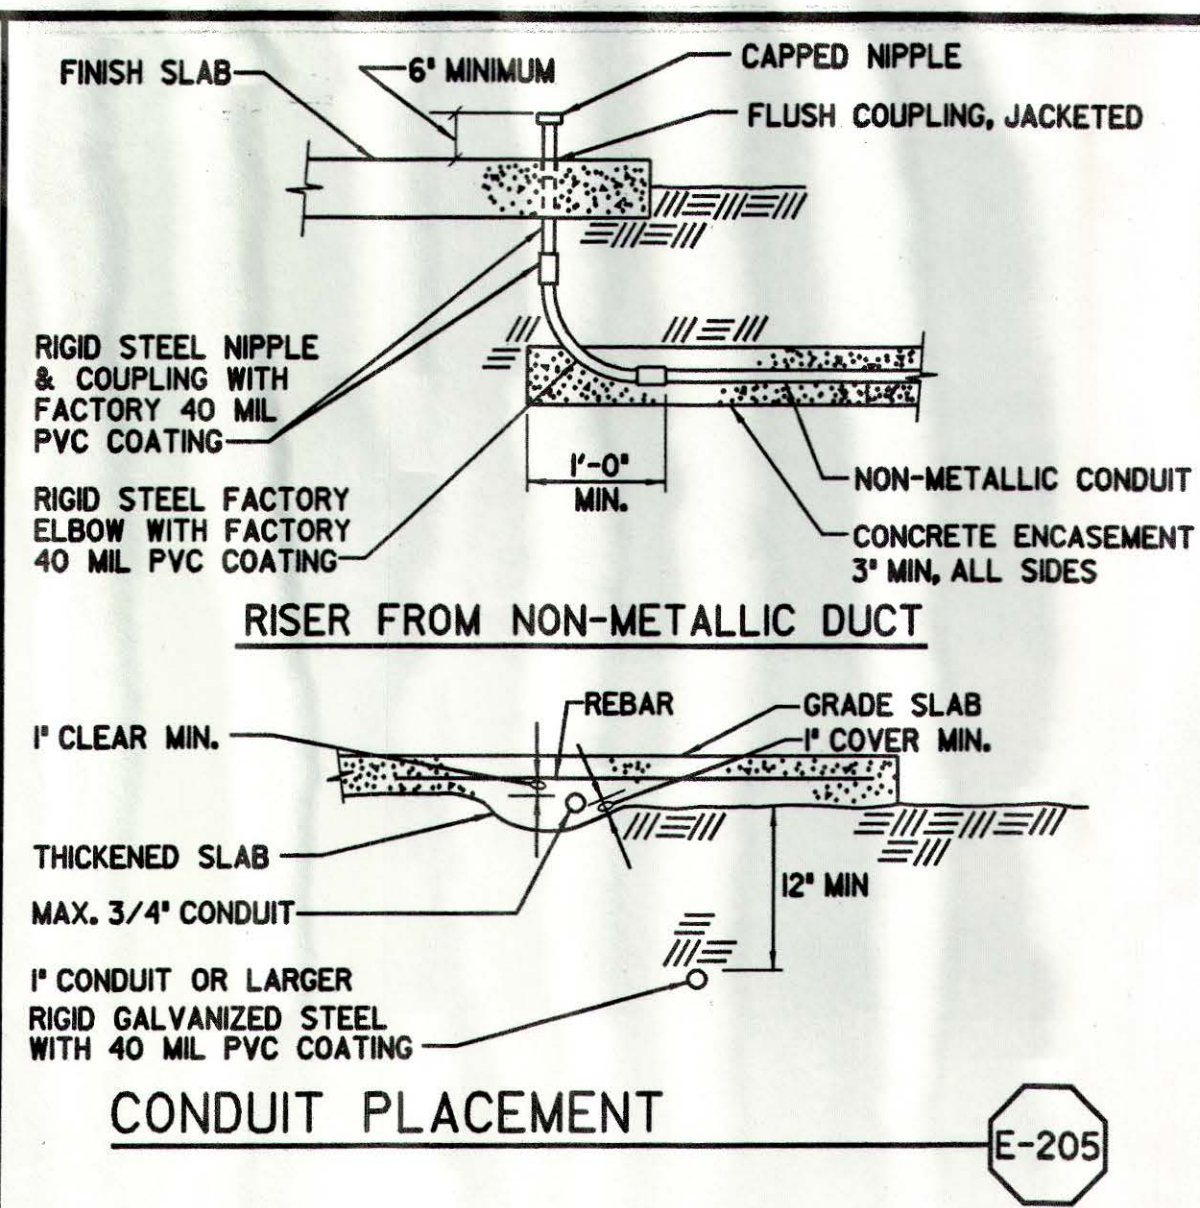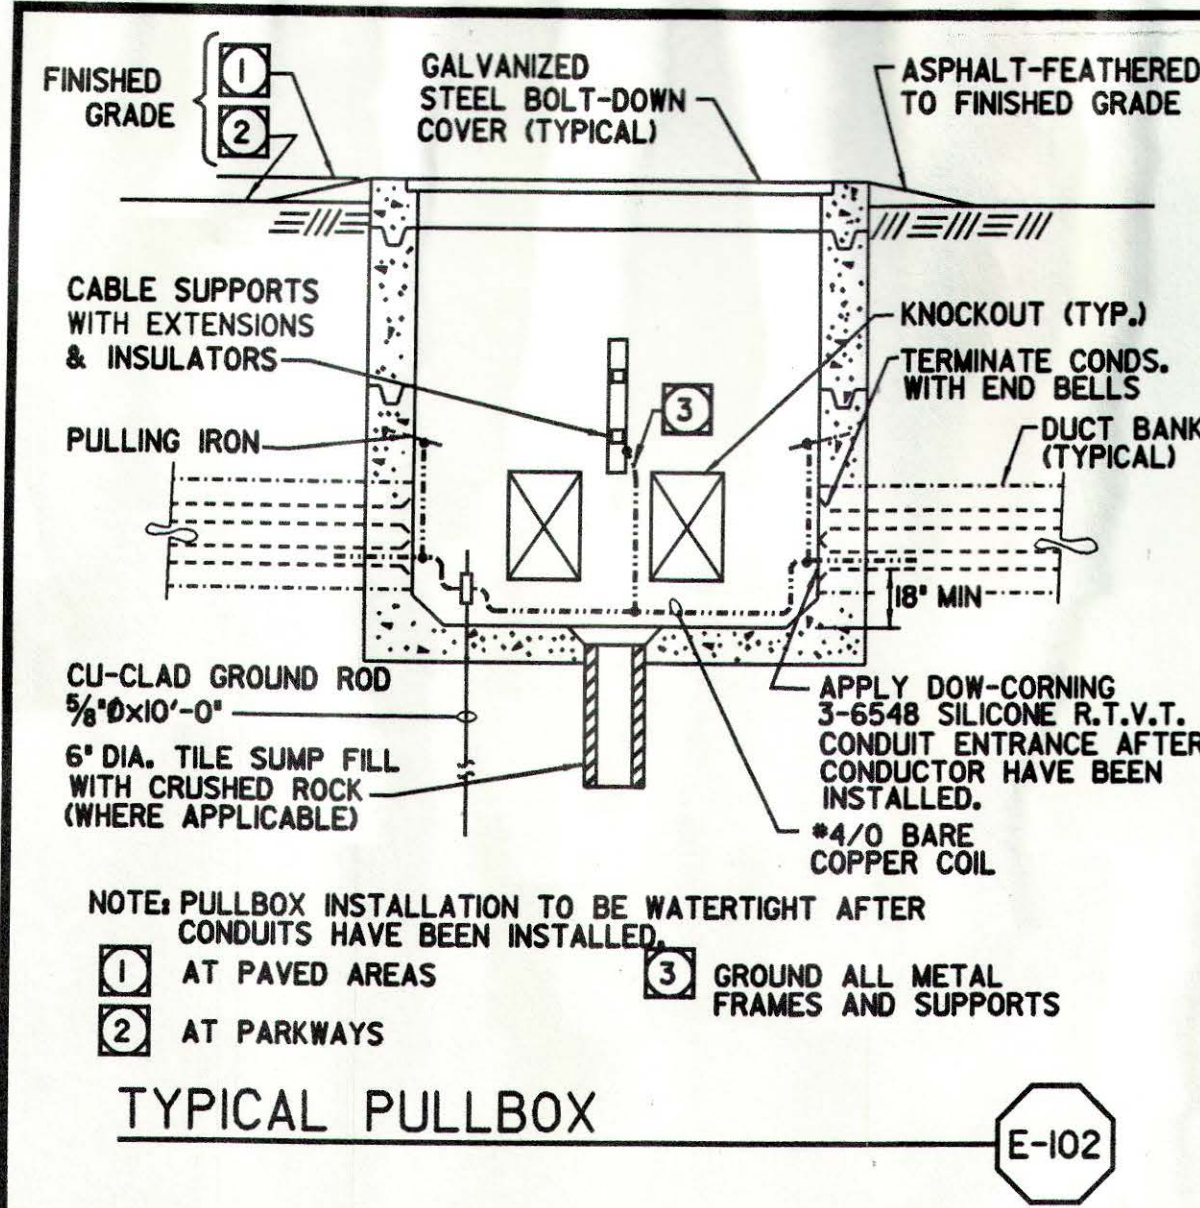

The limited review of this document by PBS & J on behalf of the Olivenhain Municipal Water District, is intended as a limited review only for general conformance with: (1) This approved Design/Build documents, (2) Accepted standards of practice within the industry, and (3) The standards of the Olivenhain Municipal Water District. This limited review in no way is intended, nor shall it act, to relieve the Design/Build Team of any professional liability to the responsibility to provide a complete and functional facility that is compliant with all applicable specifications, standards, codes, and regulations.


PBS & J  
Date: 8/23/01 By: [Signature]

REGISTERED PROFESSIONAL ENGINEER  
No. 12470  
Exp. 3-2003  
STATE OF CALIFORNIA

REGISTERED PROFESSIONAL ENGINEER  
No. 44887  
Exp. 03-3-04  
STATE OF CALIFORNIA



NOTE: NO. OF FLOATS SHALL BE AS SHOWN IN SCHEMATIC DIAGRAM OR P & ID.

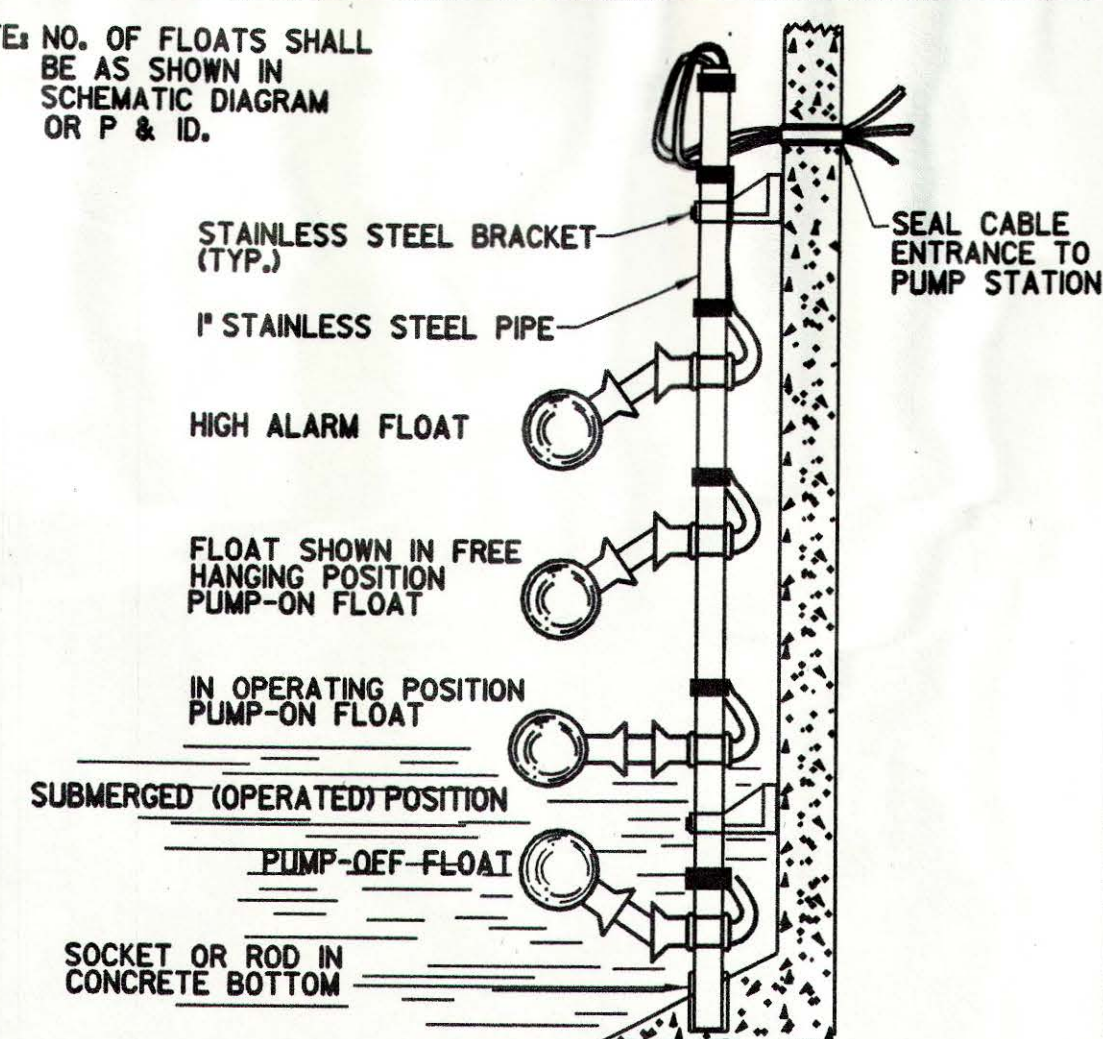


FLOAT SWITCH INSTALLATION

E-423


NOTES:

1. CAST OUTLET BOX
2. SET BOX OUT FROM BLOCK AS SHOWN.
3. PROVIDE GASKET BETWEEN BOX AND FIXTURE.
4. INSTALLATION SHALL BE WATER-TIGHT.

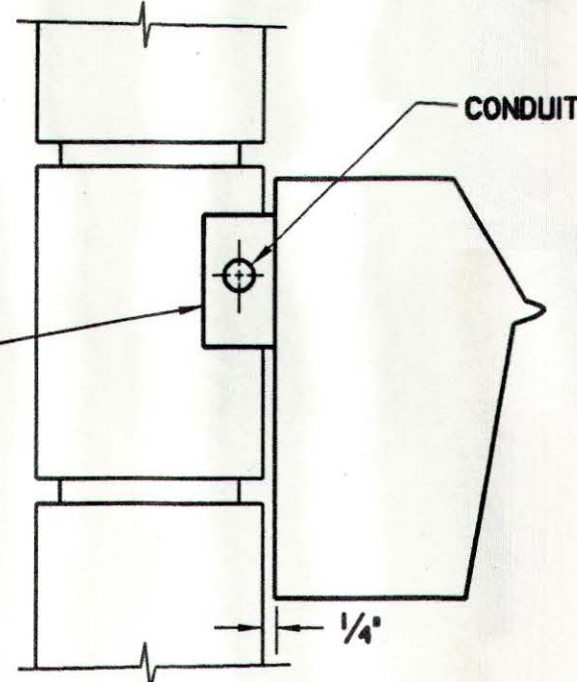


WALL HUNG FIXTURE MOUNTING

E-605

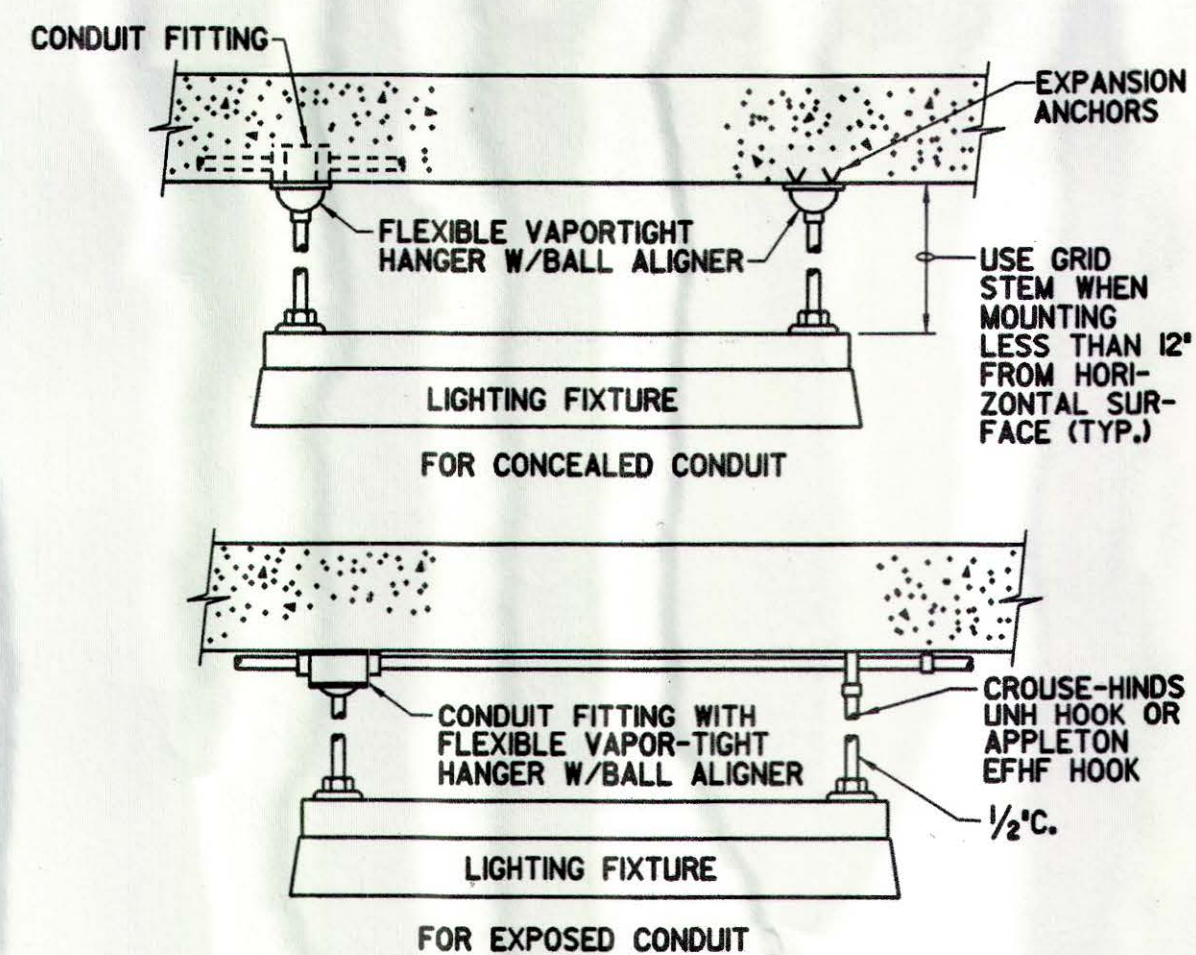


FIXTURE MOUNTING DETAIL

E-614

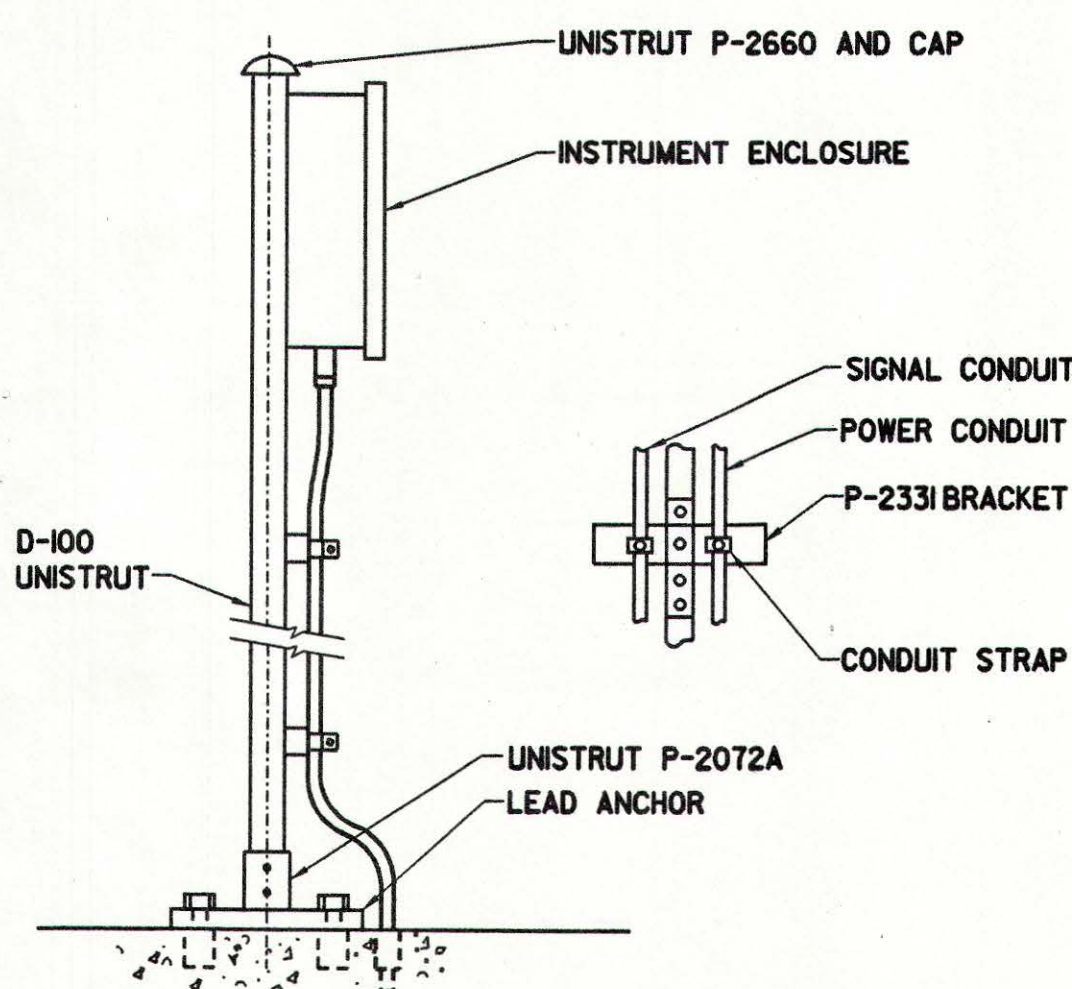


INSTRUMENT ENCLOSURE MOUNTING DETAIL

E-502

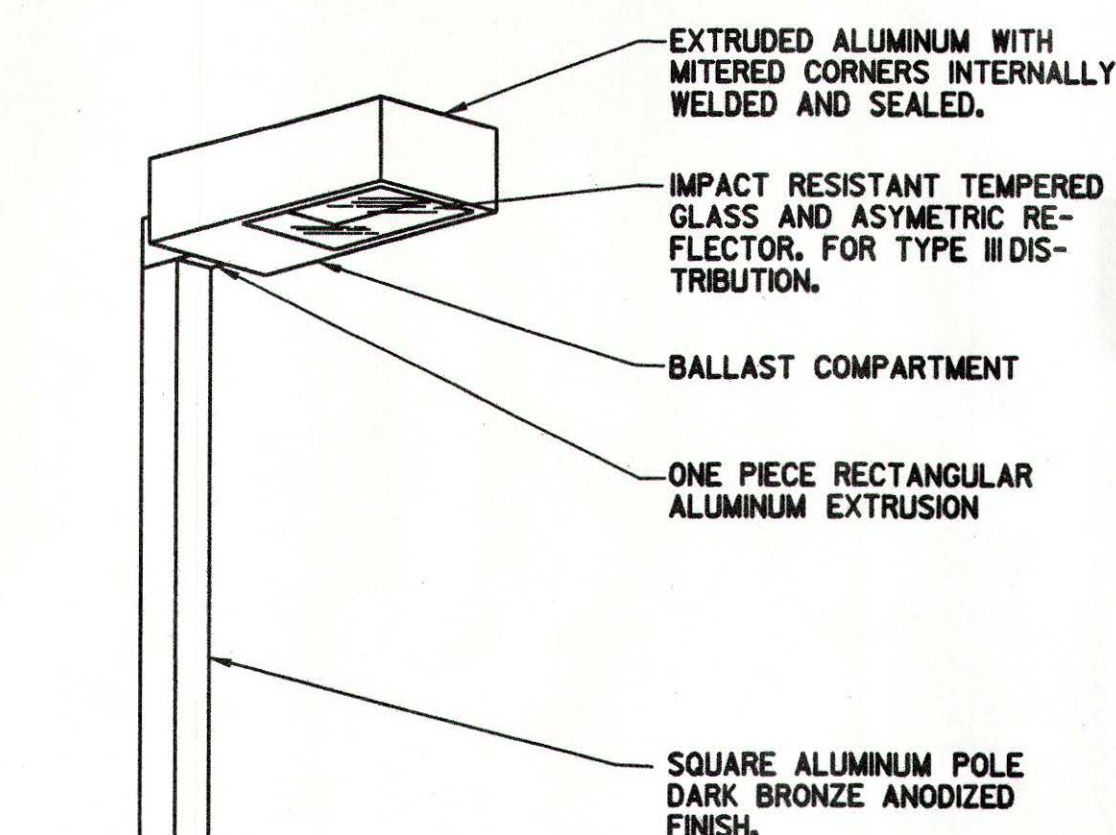


AREA LUMINAIRE

E-606

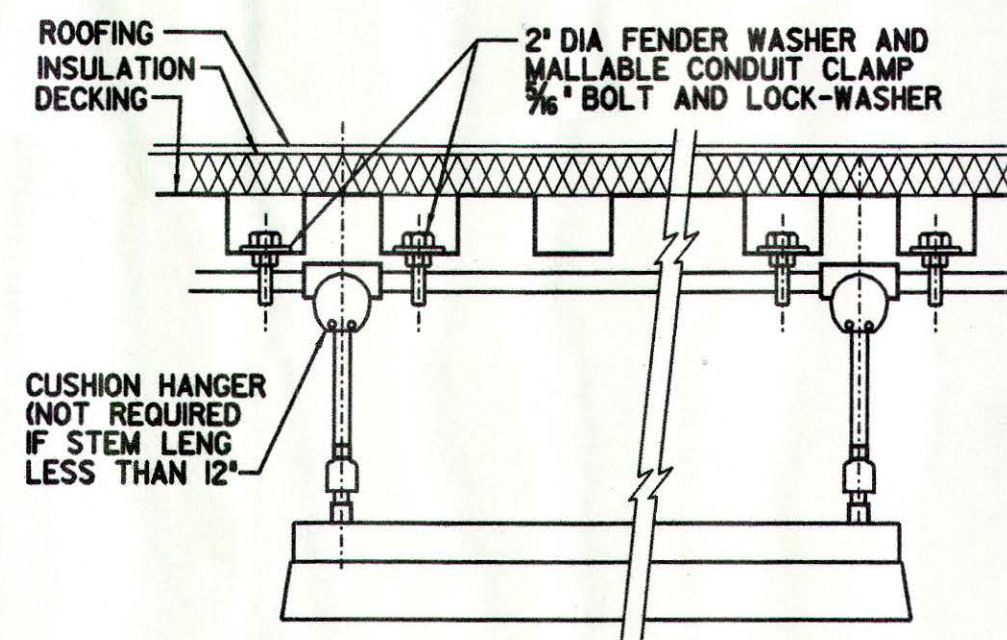

FIXTURE MOUNTING DETAIL CONCEALED CONDUIT


E-623

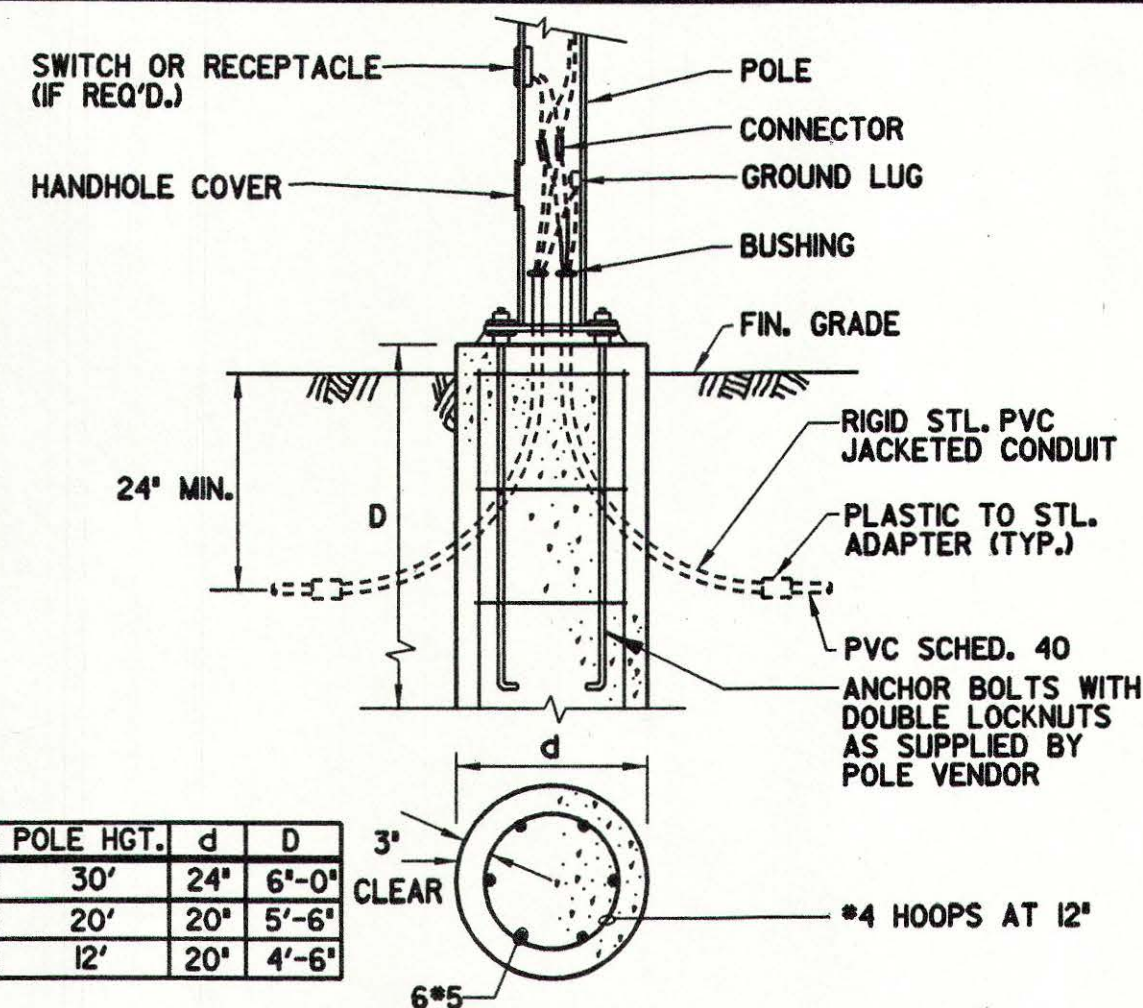

LIGHTING POLE FOUNDATION


NOTE: EXPOSED FOUNDATION CAPS SHALL BE FORMED TO MATCH THE OUTLINE OF POLE BASEPLATE.

E-600

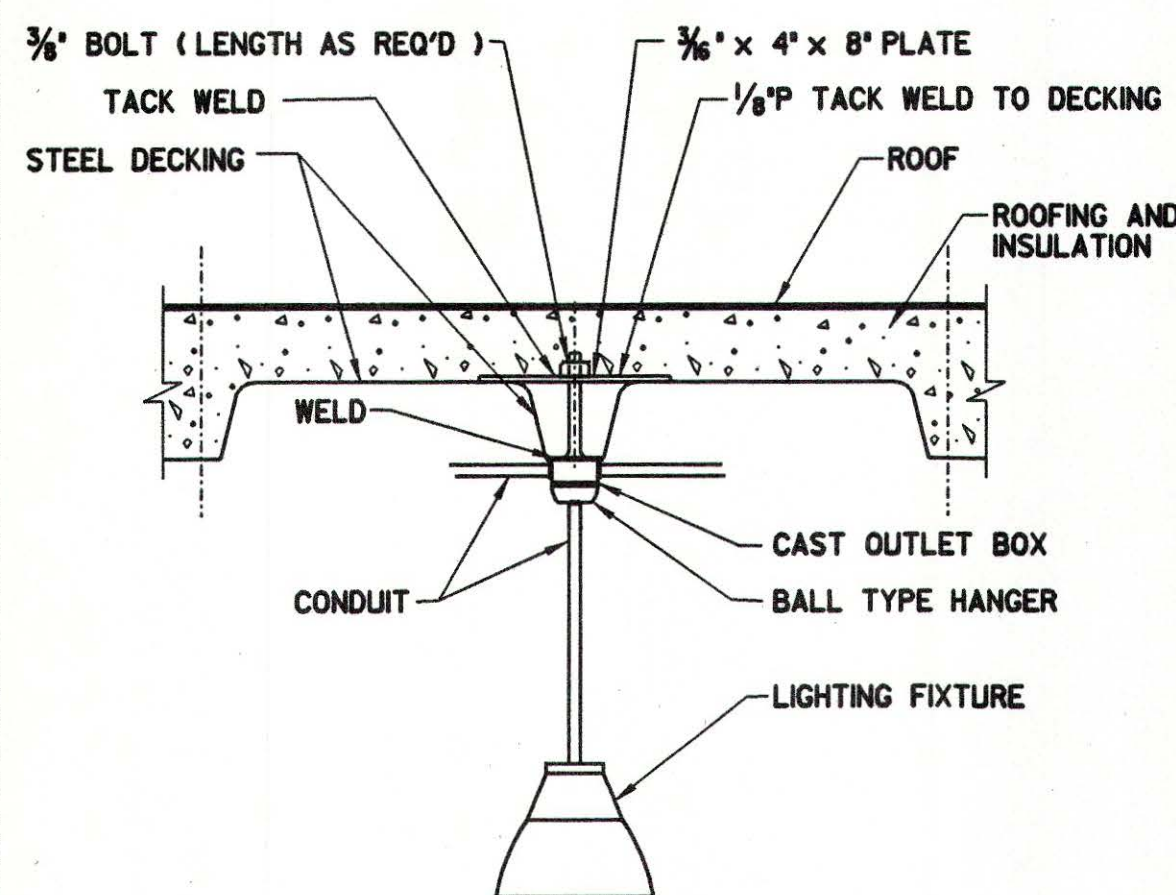

FIXTURE HANGING TO STEEL DECK DETAIL

E-607

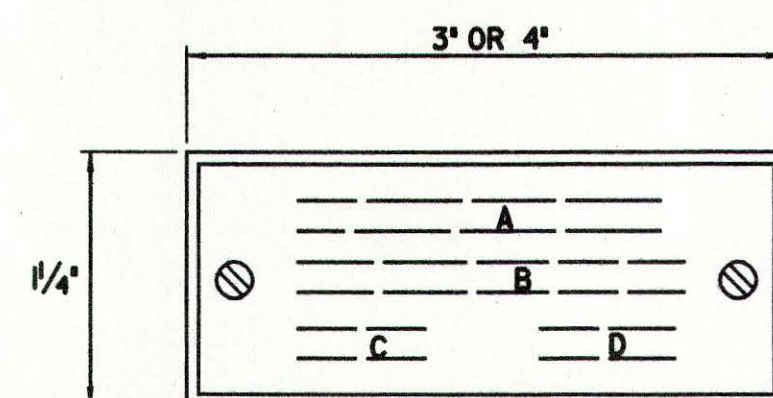


1. ALL LETTERS ARE 1/4" IF NOT NOTED OTHERWISE.
2. ALL NAMEPLATES TO BE MOUNTED ON VERTICAL CENTER LINE OF THEIR CUBICLE OR DEVICE.
3. ATTACH ALL NAMEPLATES WITH BRASS SCREWS.
4. PROVIDE BLANK NAMEPLATES FOR ALL SPARE AND FUTURE CIRCUITS.

NAMEPLATE

E-708

The limited review of this document by PBS & I on behalf of the Olivenhain Municipal Water District, is intended as a limited review only for general conformance with: (1) This approved Design/Build documents, (2) Accepted standards of practice within the industry, and (3) The standards of the Olivenhain Municipal Water District. This limited review in no way is intended, nor shall it act, to relieve the Design/Build Team of any professional liability to the responsibility to provide a complete and functional facility that is compliant with all applicable specifications, standards, codes, and regulations.

PBS & I  
Date: 8/23/01 By: [Signature]

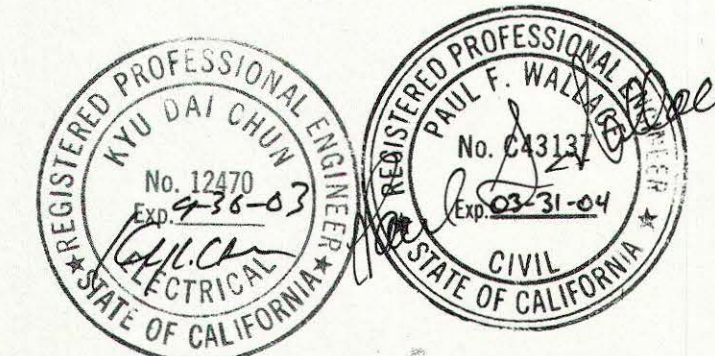

REV	DATE	BY	QMW	DESCRIPTION

SCALE	NONE
WARNING	IF THIS BAR DOES NOT MEASURE 1" THEN DRAWING IS NOT TO SCALE

DESIGNED	K.D. CHUN
DRAWN	N. CHRAKIAN
CHECKED	K.D. CHUN

SUBMITTED BY	[Signature]
PROJECT MANAGER	[Signature]
COMPANY OFFICER	[Signature]
LICENSE NO.	50602
DATE	12/13/00
LICENSE NO.	33699
DATE	12/13/00



**MONTGOMERY WATSON**  
Pasadena, California

APPROVED	[Signature]
OLIVENHAIN MWD	8.29.01
DATE	8.29.01
APPROVED	
FILANC CONSTRUCTION CO.	
DATE	

KELWOOD DEVELOPMENT COMPANY
4S RANCH SANITATION DISTRICT
WASTEWATER TREATMENT PLANT EXPANSION TO 2.0 MGD
NEIGHBORHOOD NO.1 PUMP STATION
ELECTRICAL STANDARD DETAILS - 2

SHEET
GE-4
OF 5 SHEETS




Plot Date: 12-DEC-2000 14:25

Job No: MW Job # File: p:\Projects\4SR\general details\ele\neighbor\4srnele.dwg




**NOTES:**

1. ELECTRIC SERVICE AND TRANSFORMER PAD SHALL COMPLY WITH SDG & E SERVICE REQUIREMENTS.
2. TELEPHONE SERVICE SHALL COMPLY WITH TEL. CO SERVICE REQUIREMENTS.
3. CONDUIT FOR ROADWAY LIGHTING SHALL BE 1" MINIMUM AND WIRES SHALL BE #10 AWG MINIMUM.

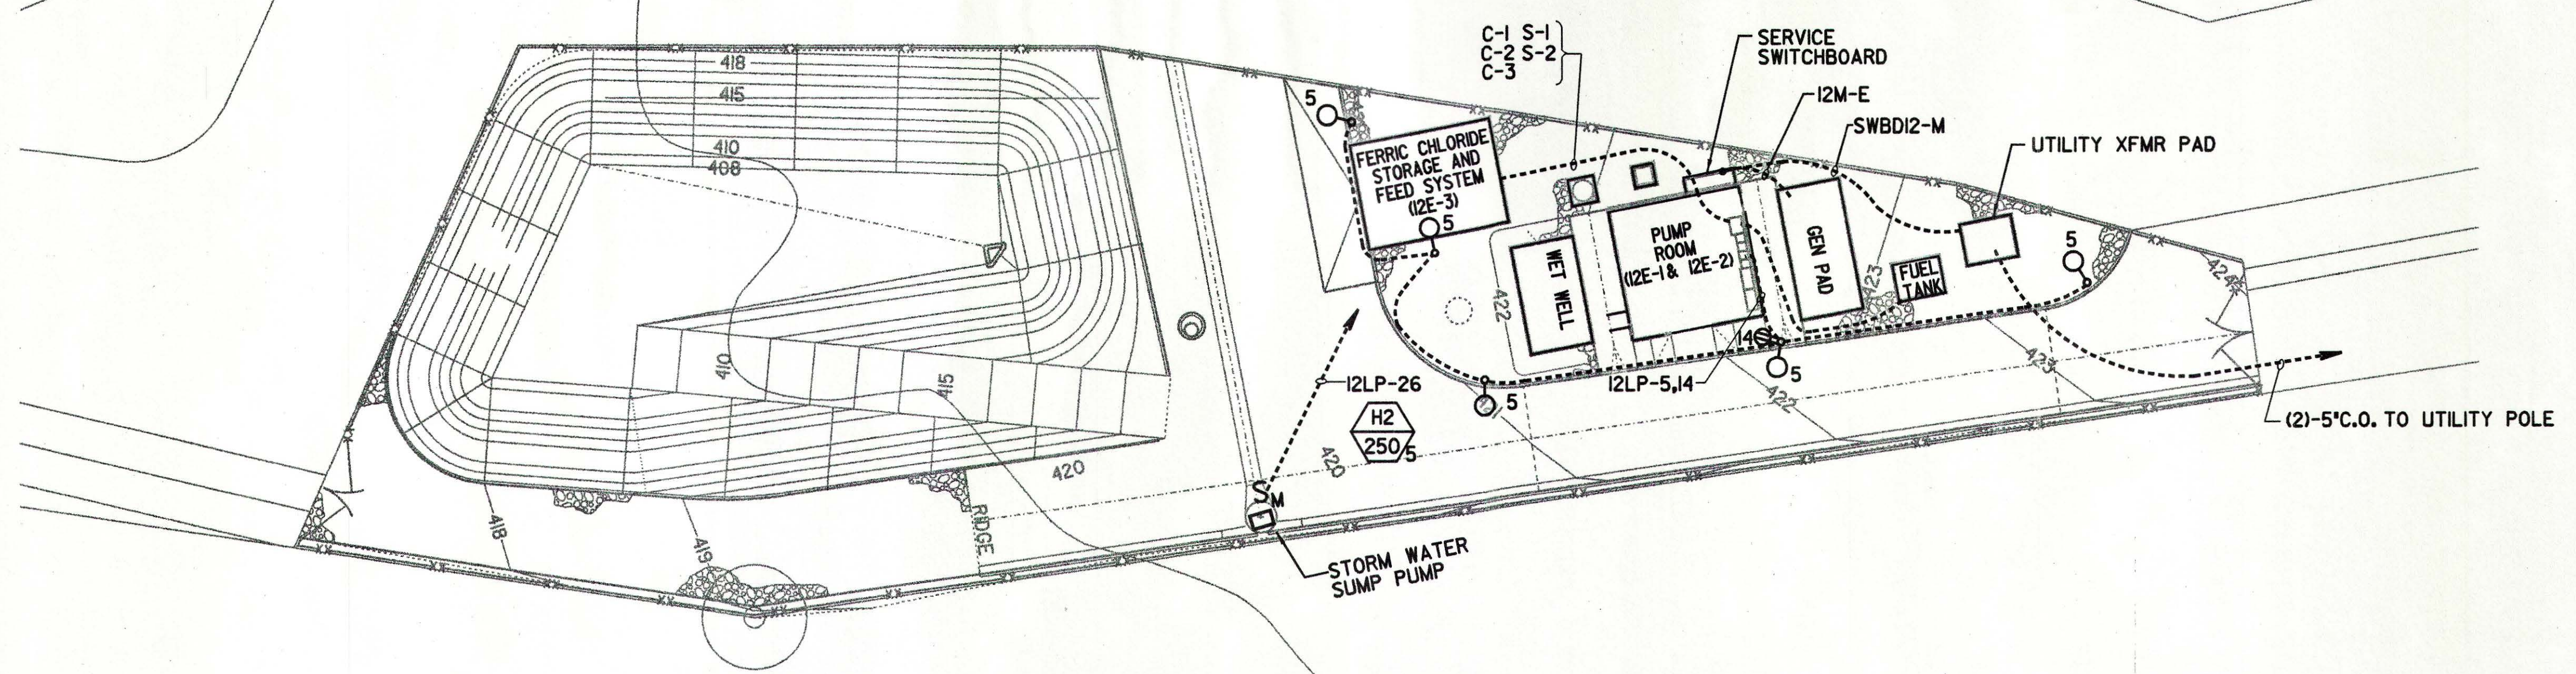

The limited review of this document by PBS & J on behalf of the Olivenhain Municipal Water District, is intended as a limited review only for general conformance with: (1) This approved Design/Build documents, (2) Accepted standards of practice within the industry, and (3) The standards of the Olivenhain Municipal Water District. This limited review in no way is intended, nor shall it act, to relieve the Design/Build Team of any professional liability to the responsibility to provide a complete and functional facility that is compliant with all applicable specifications, standards, codes, and regulations.

PBS & J  
Date 8/22/01 By [Signature]

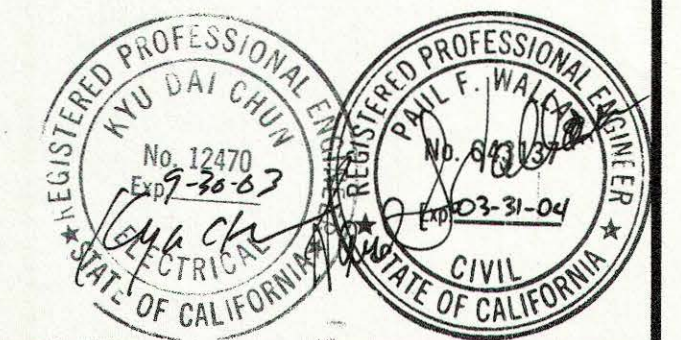

REV	DATE	BY	OMWD	DESCRIPTION

SCALE  
1"=20'

DESIGNED K. D. CHUN  
DRAWN N. CHRAKIAN  
CHECKED K. D. CHUN

SUBMITTED BY  
PROJECT MANAGER  
COMPANY OFFICER  
50802  
33699  
12/13/00  
12/13/00

**MONTGOMERY WATSON**  
Pasadena, California

APPROVED  
OLIVENHAIN MWD  
APPROVED  
FILANC CONSTRUCTION CO.  
8.29.01  
DATE

KELWOOD DEVELOPMENT COMPANY  
45 RANCH SANITATION DISTRICT  
WASTEWATER TREATMENT PLANT EXPANSION TO 2.0 MGD  
NEIGHBORHOOD NO. 1 PUMP STATION  
ELECTRICAL SITE PLAN

SHEET  
E-1  
OF 5 SHEETS









1451

Plot Date: 05-NOV-2001


File: D:\Projects\WSPR\generat\details\ele\neighbor\4srne03.dwg

Job No: MW Job

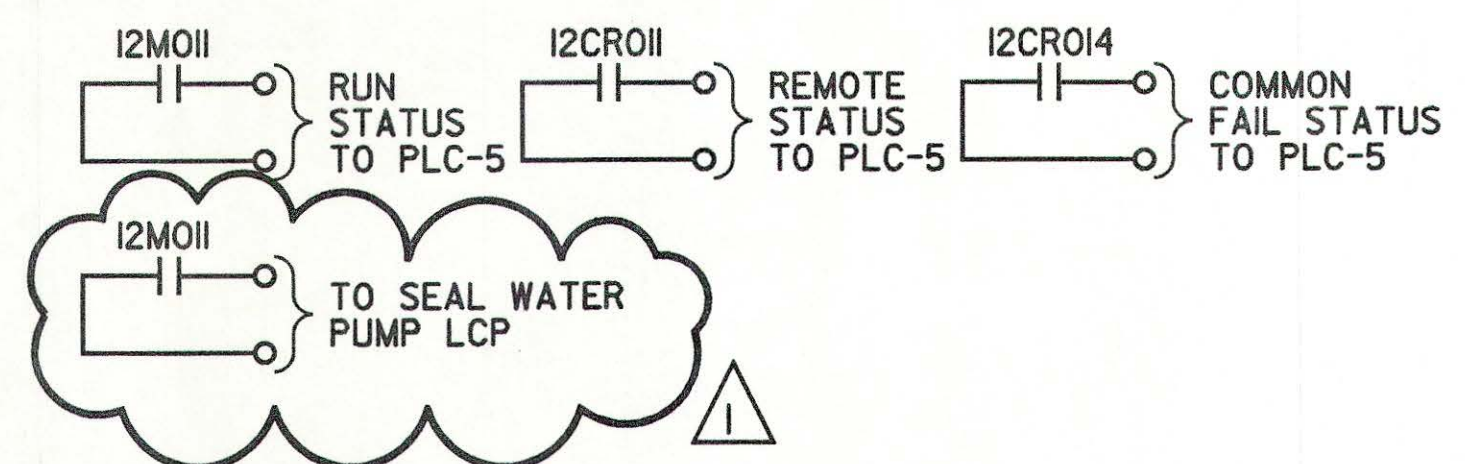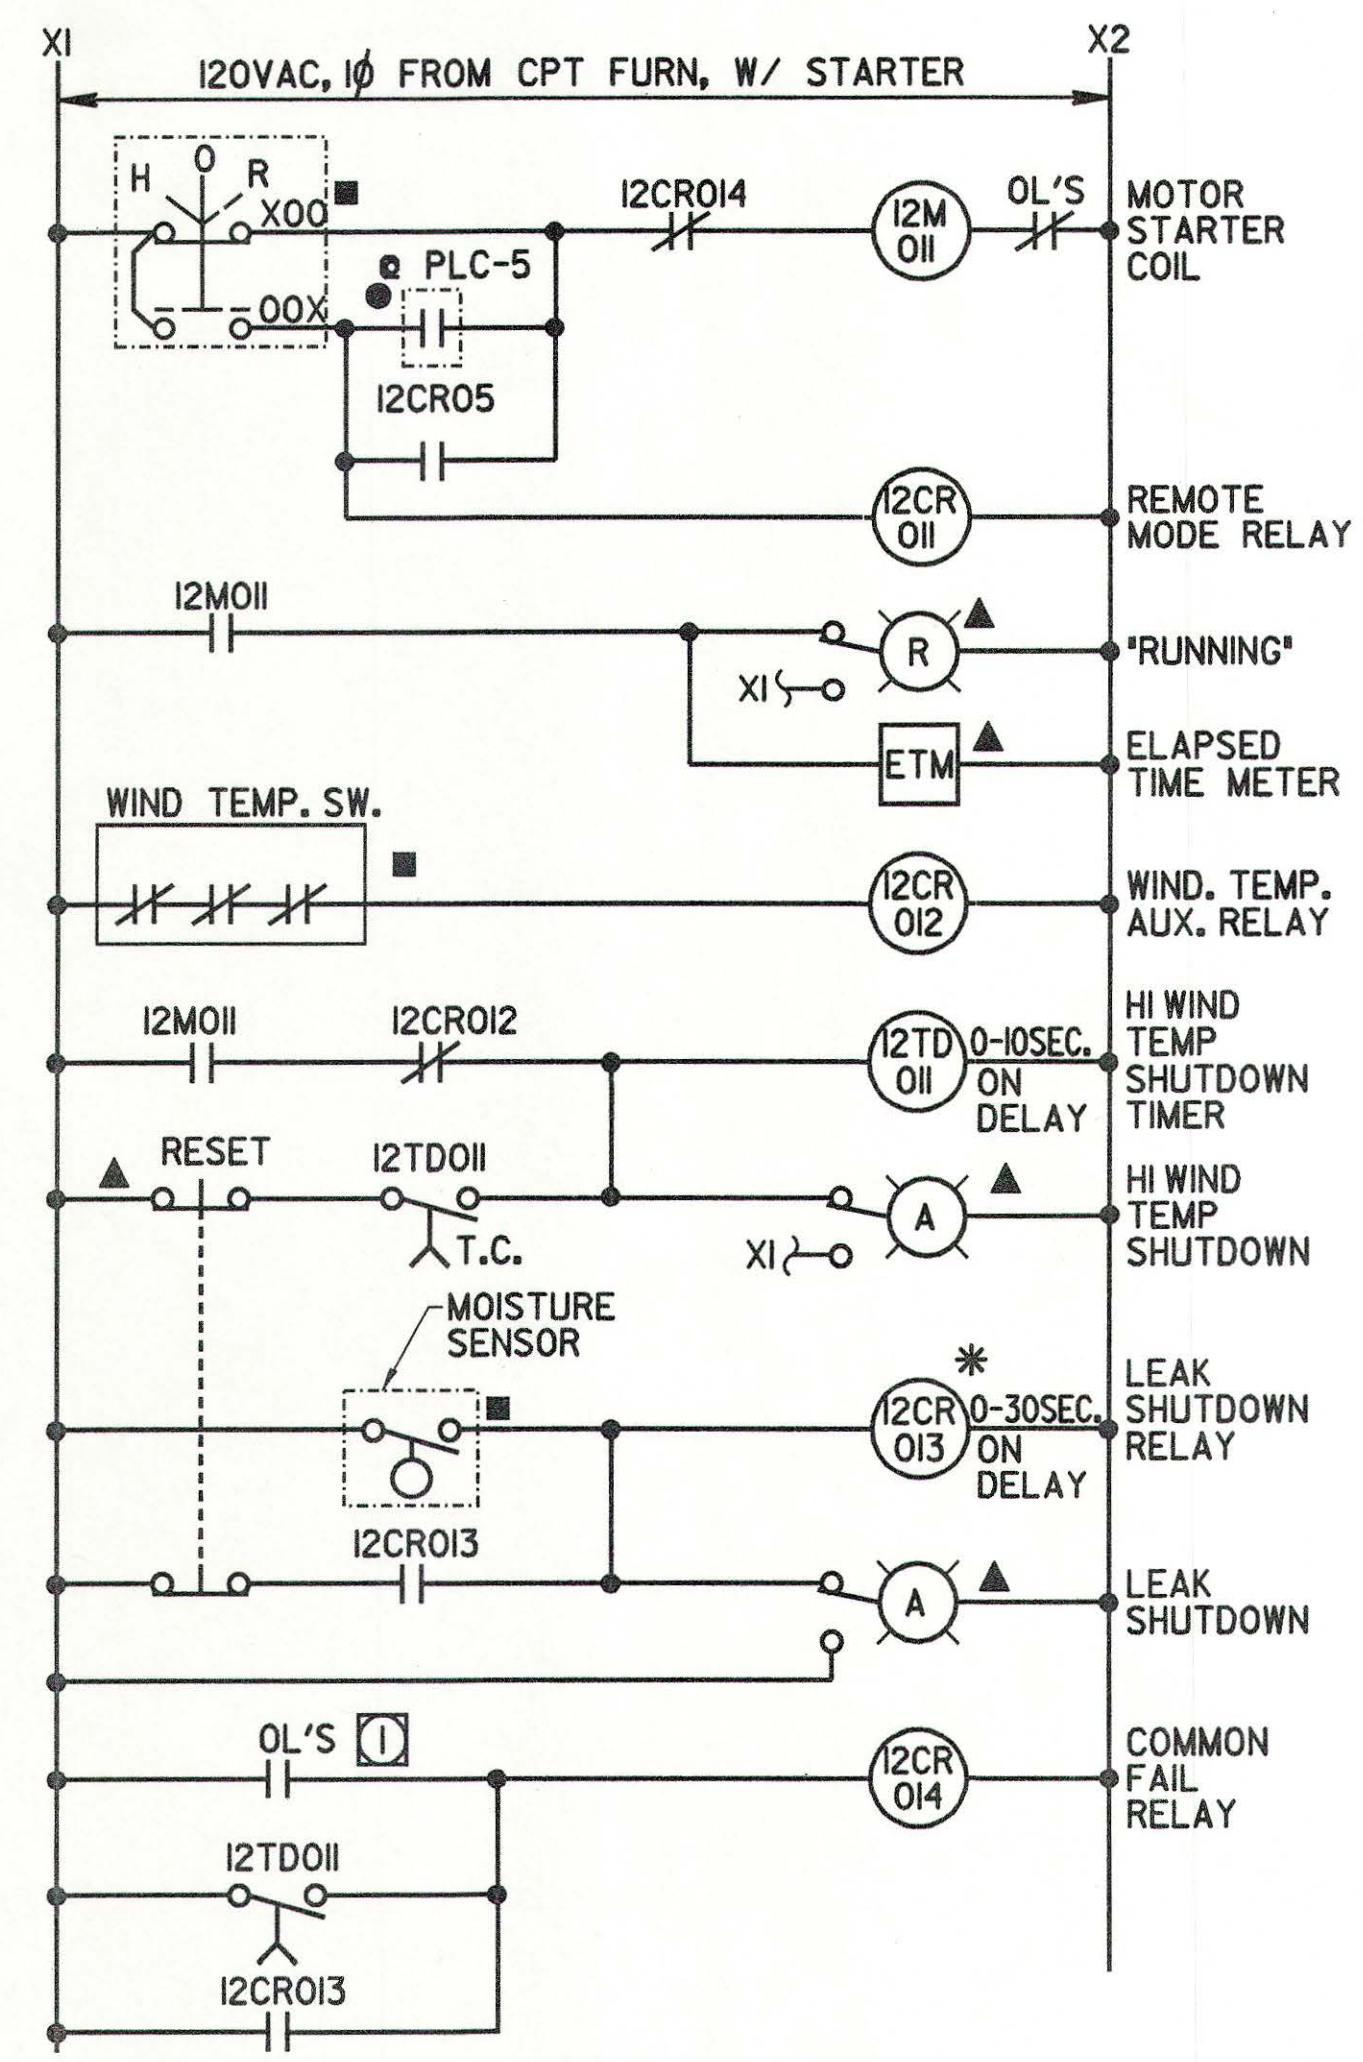


\* COORDINATE WITH PUMP VENDOR FOR RELAY TYPE  
① 3 OVERLOAD RELAY CONTACTS IN PARALLEL

### INFLUENT PUMP 12-P-1 STARTER (SIMILAR 12-P-2)

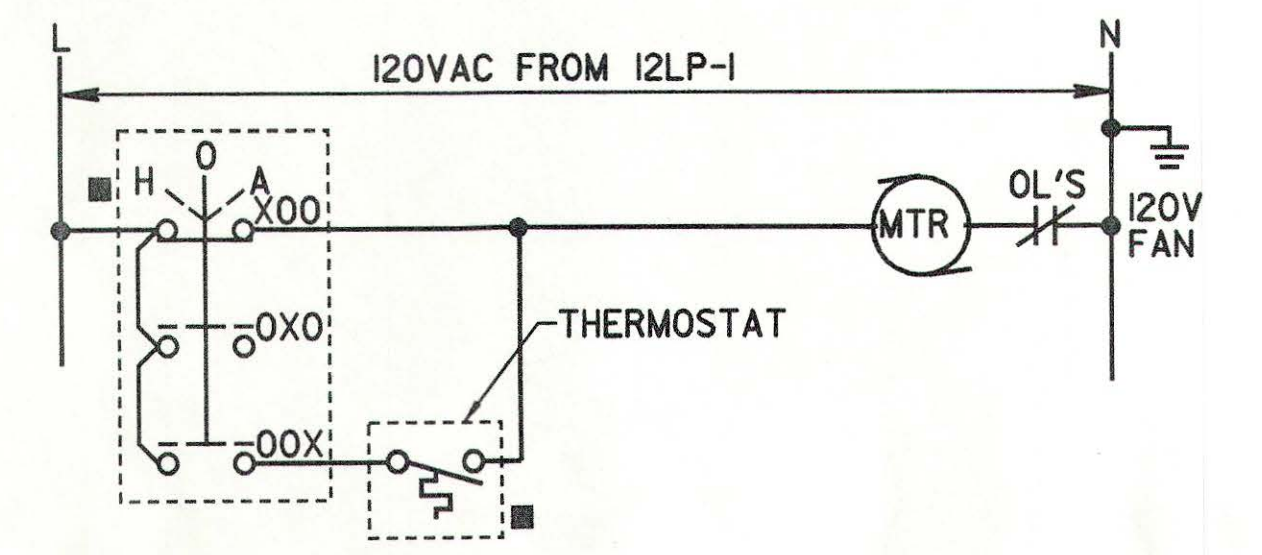


### EXHAUST FAN 12-EF-1 (SIMILAR FOR EXHAUST FAN 12-EF-2)

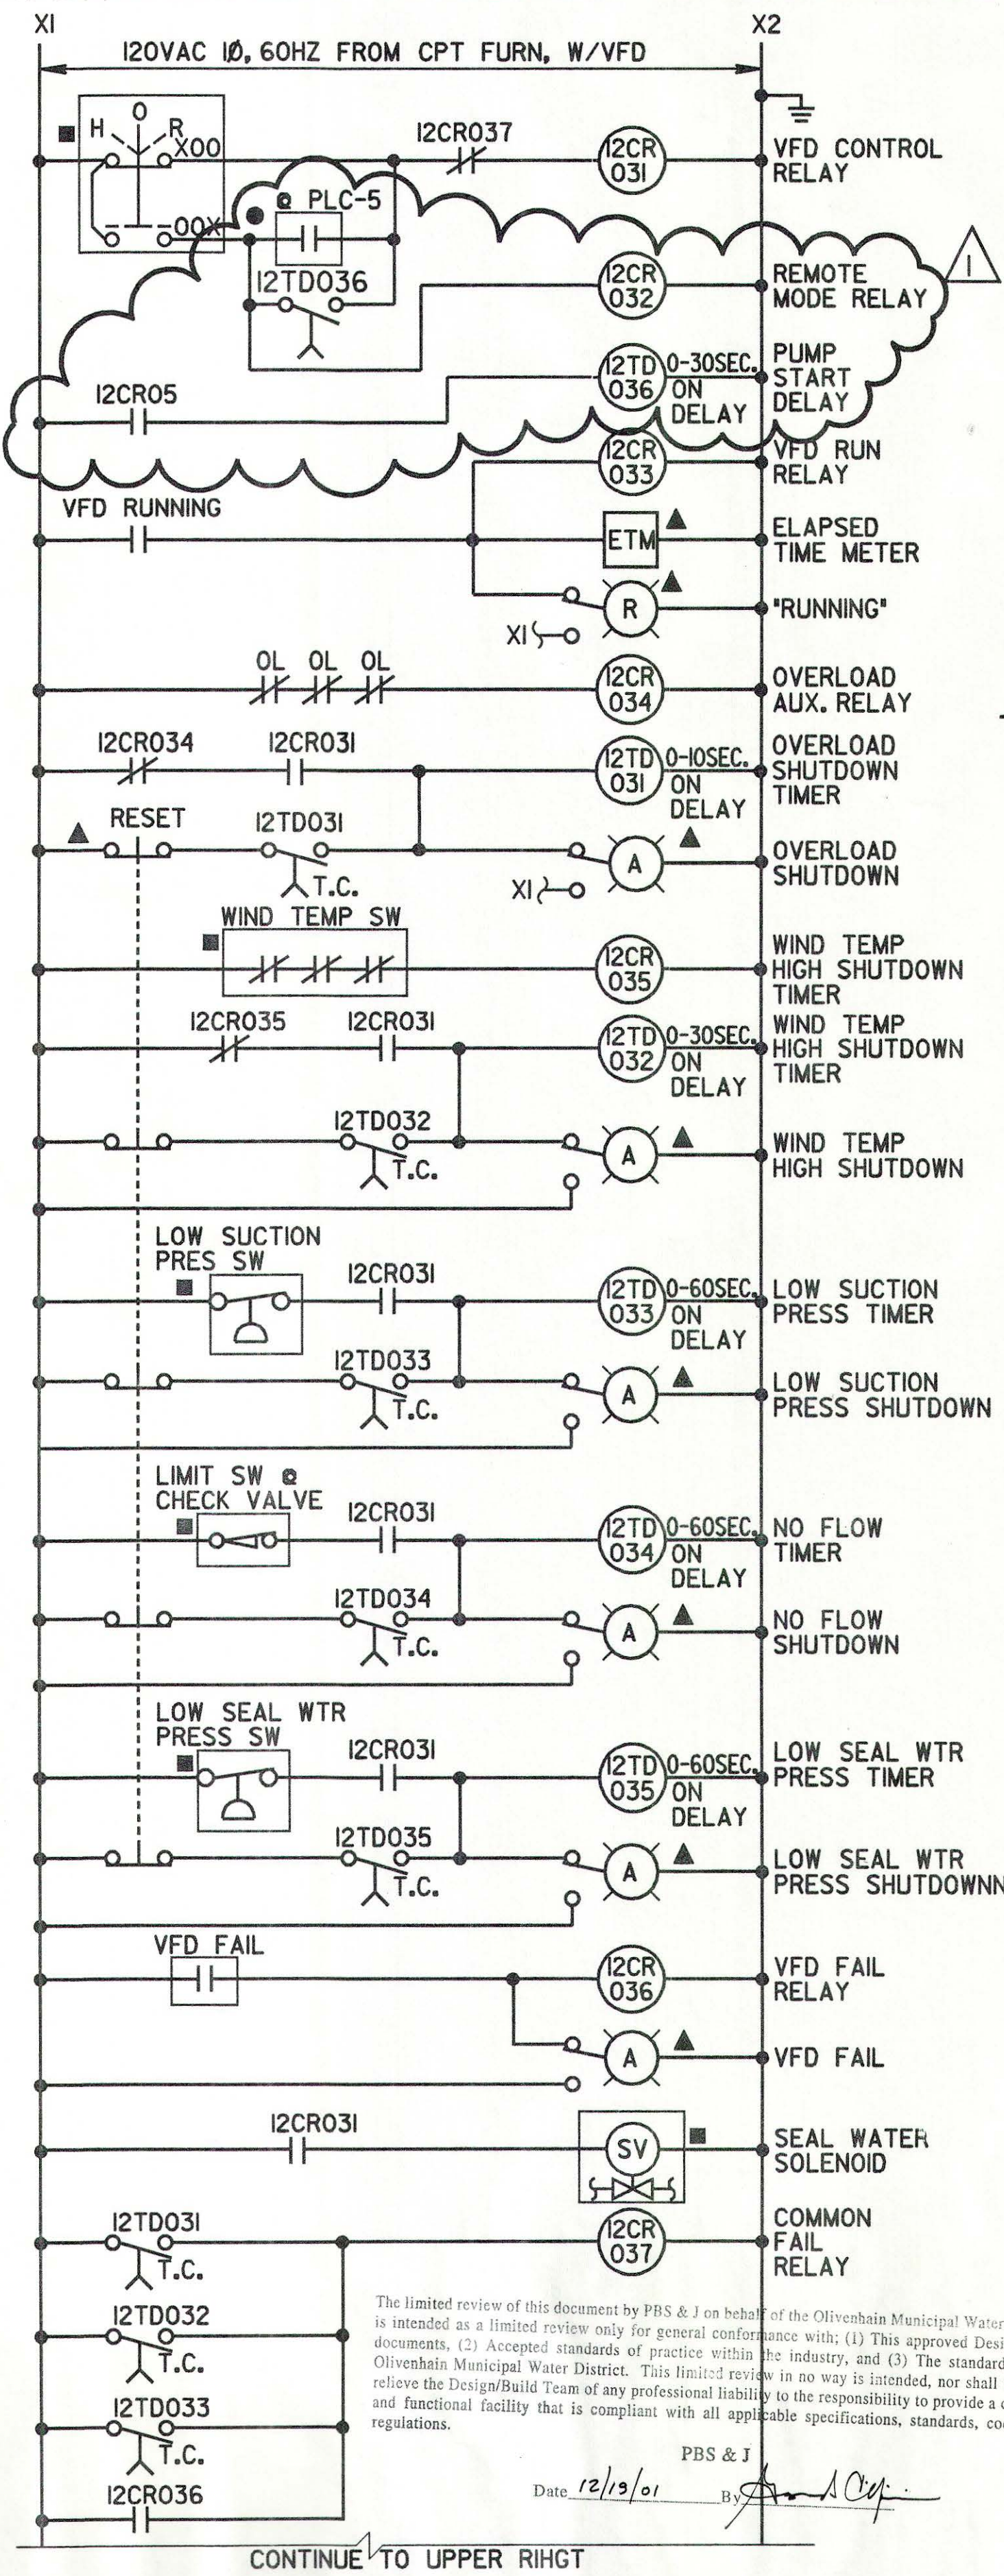


The limited review of this document by PBS & J on behalf of the Olivenhain Municipal Water District, is intended as a limited review only for general conformance with: (1) This approved Design/Build Olivenhain Municipal Water District. This limited review in no way is intended, nor shall it act, to relieve the Design/Build Team of any professional liability to the responsibility to provide a complete and functional facility that is compliant with all applicable specifications, standards, codes, and regulations.


PBS & J  
Date: 12/19/01 By: [Signature]

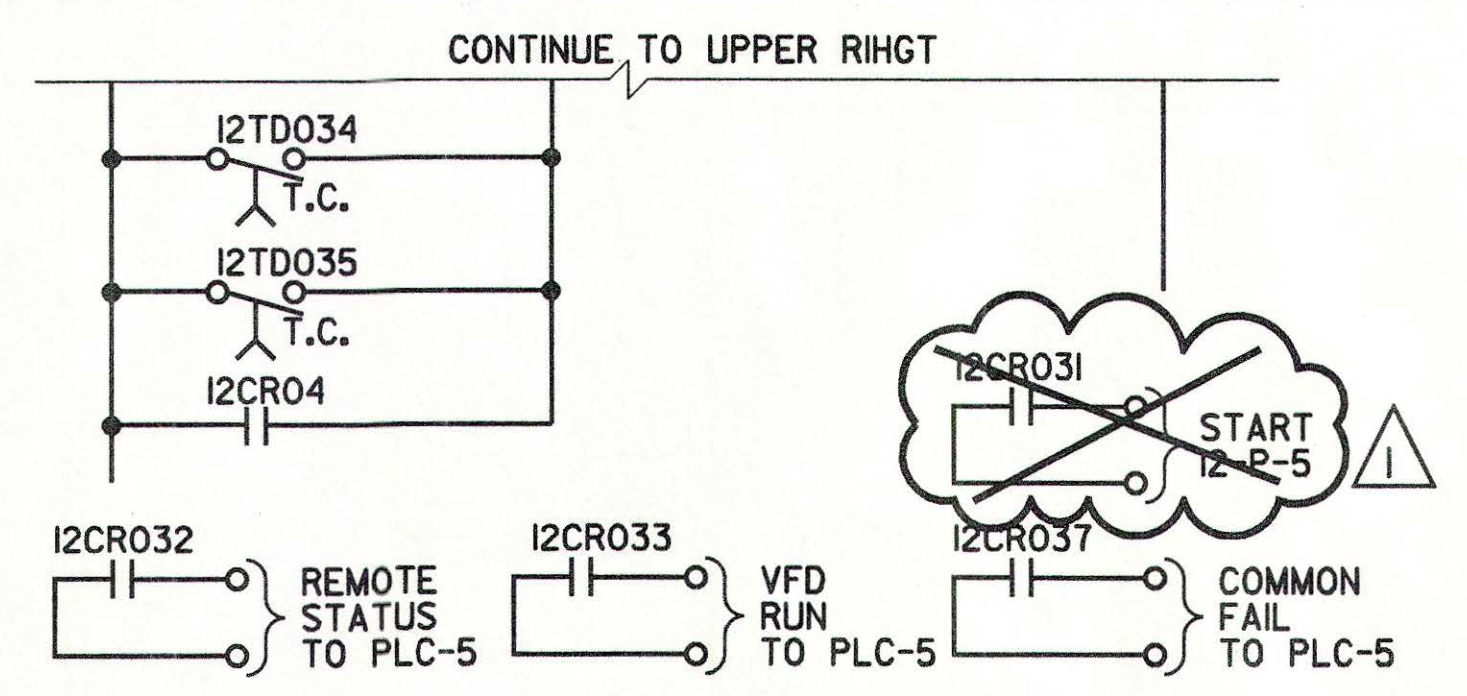

### INFLUENT PUMP 12-P-3 VFD (ALL ITEMS LOCATED AT VFD PANEL UNLESS OTHERWISE NOTED) (SIMILAR FOR 12-P-4)

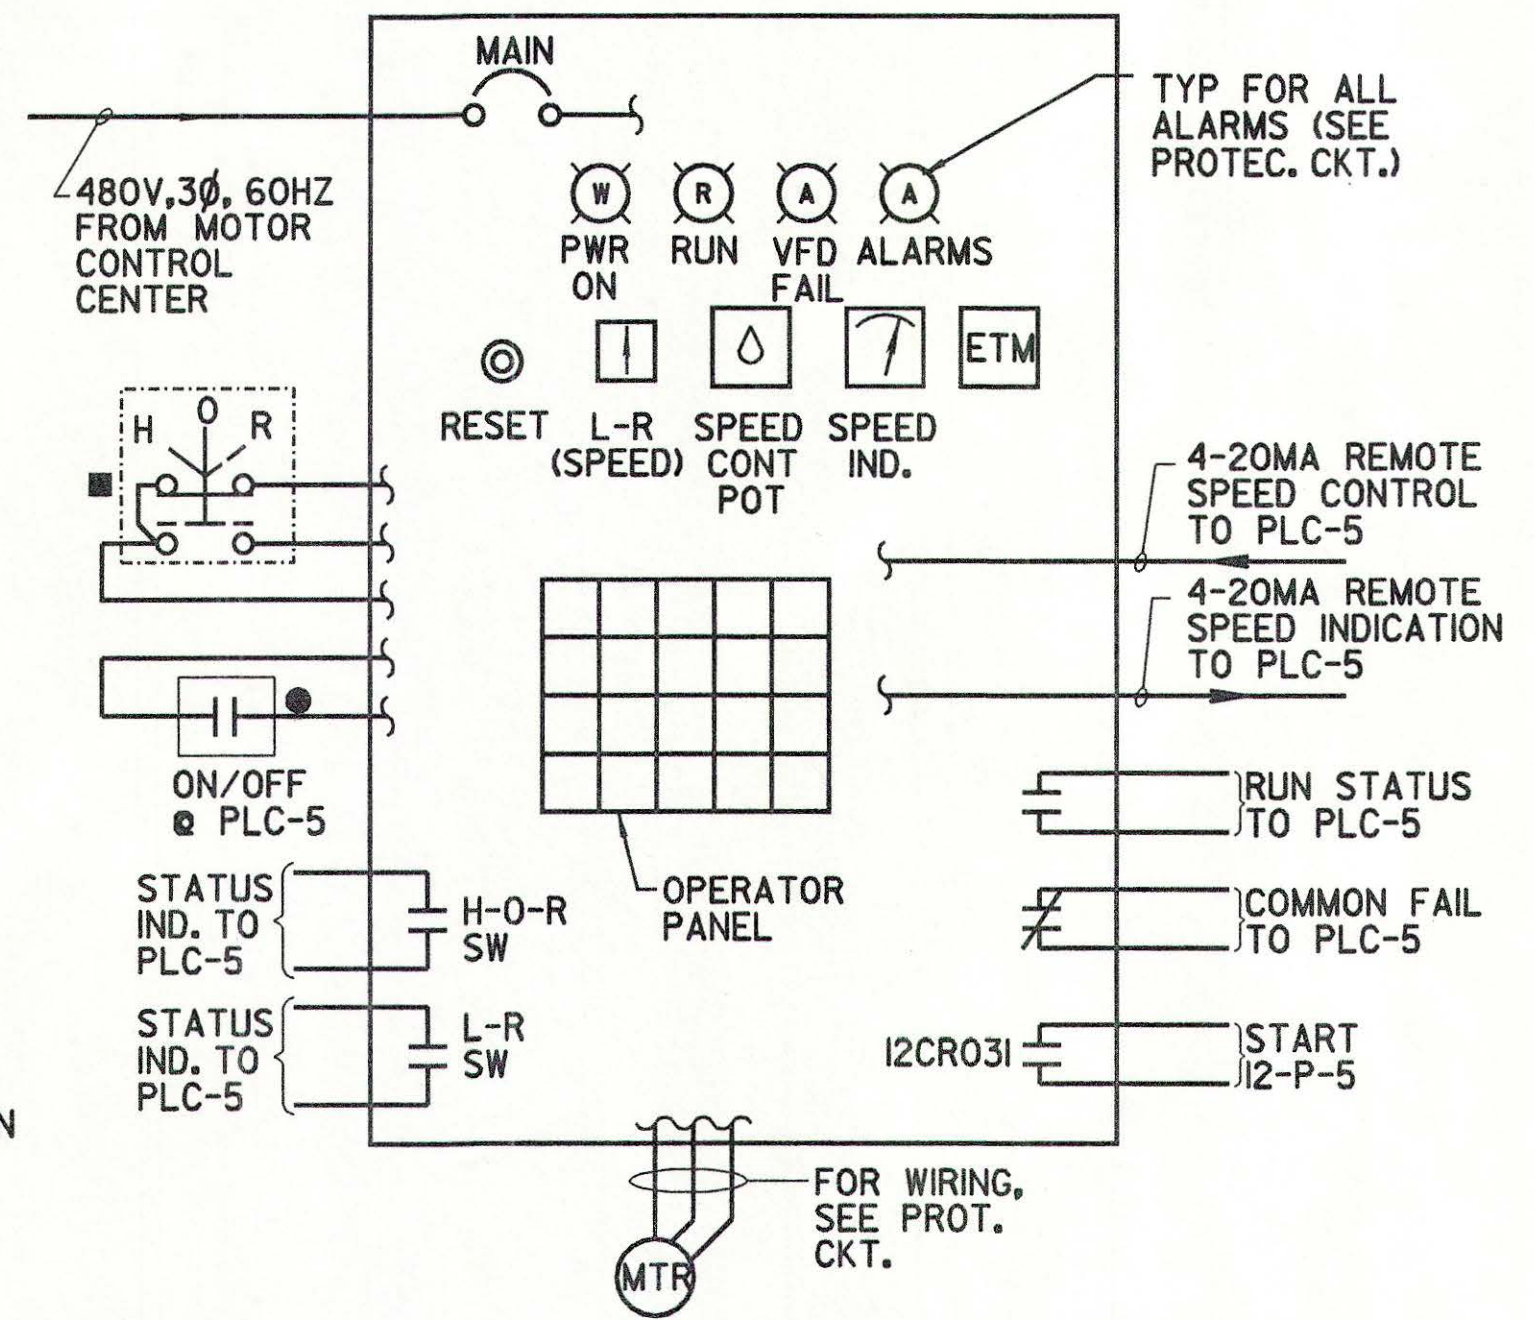


### INFLUENT PUMP 12-P-3 VFD (SIMILAR FOR 12-P-4)

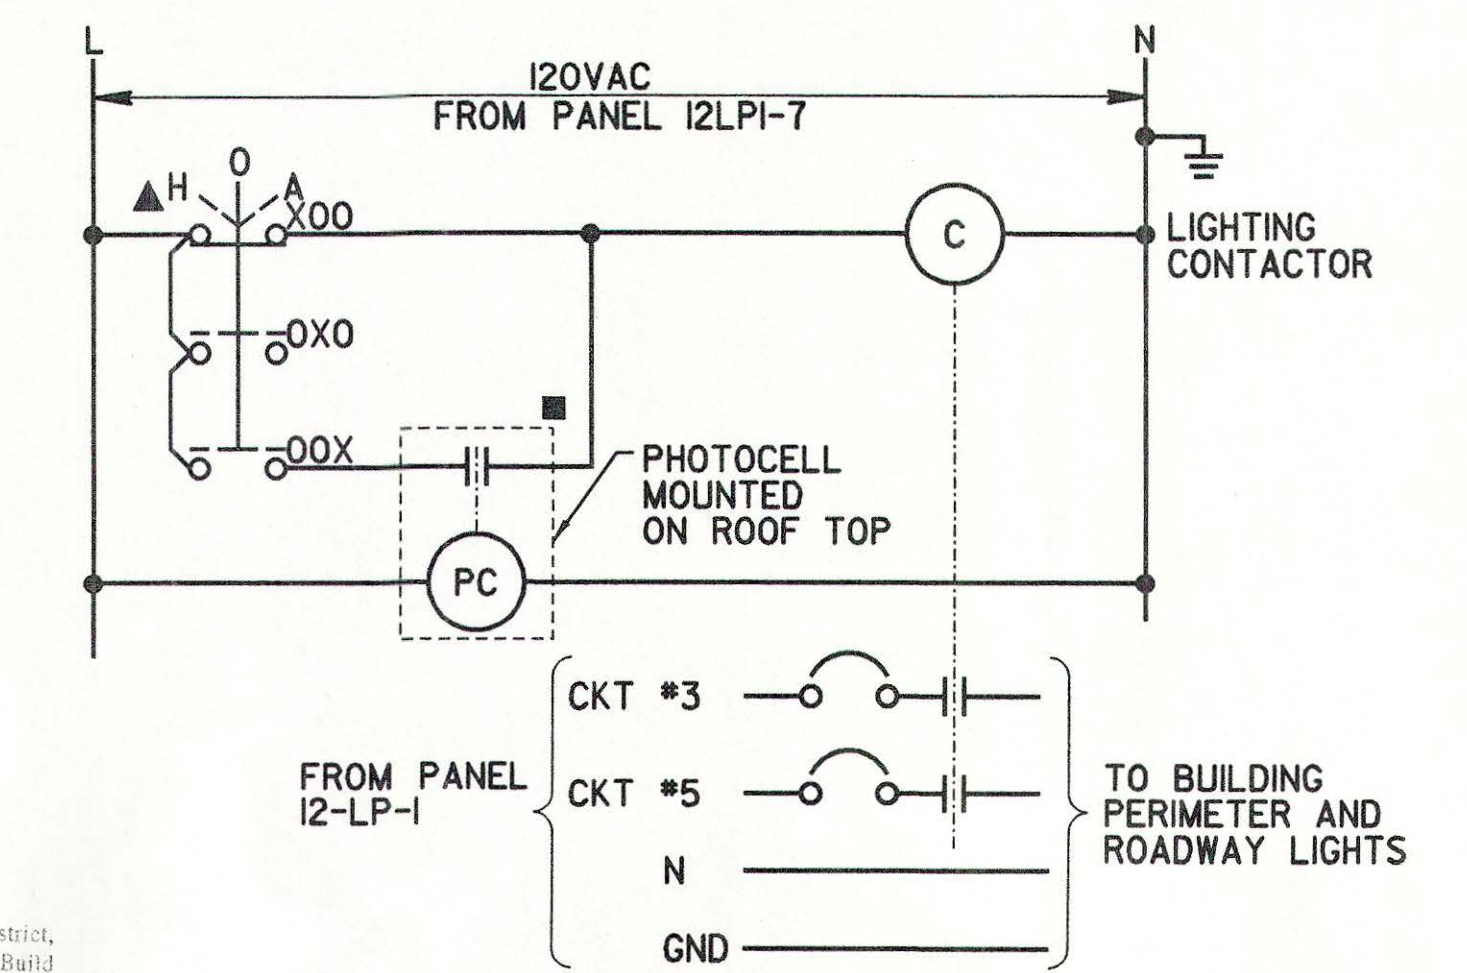

### NEIGHBORHOOD NO. 1 PUMP STATION BUILDING PERIMETER & ROADWAY LIGHTING CONTROL

(ALL ITEMS LOCATED AT MCC-12M LIGHTING CONTROL COMPARTMENT UNLESS OTHERWISE NOTED)

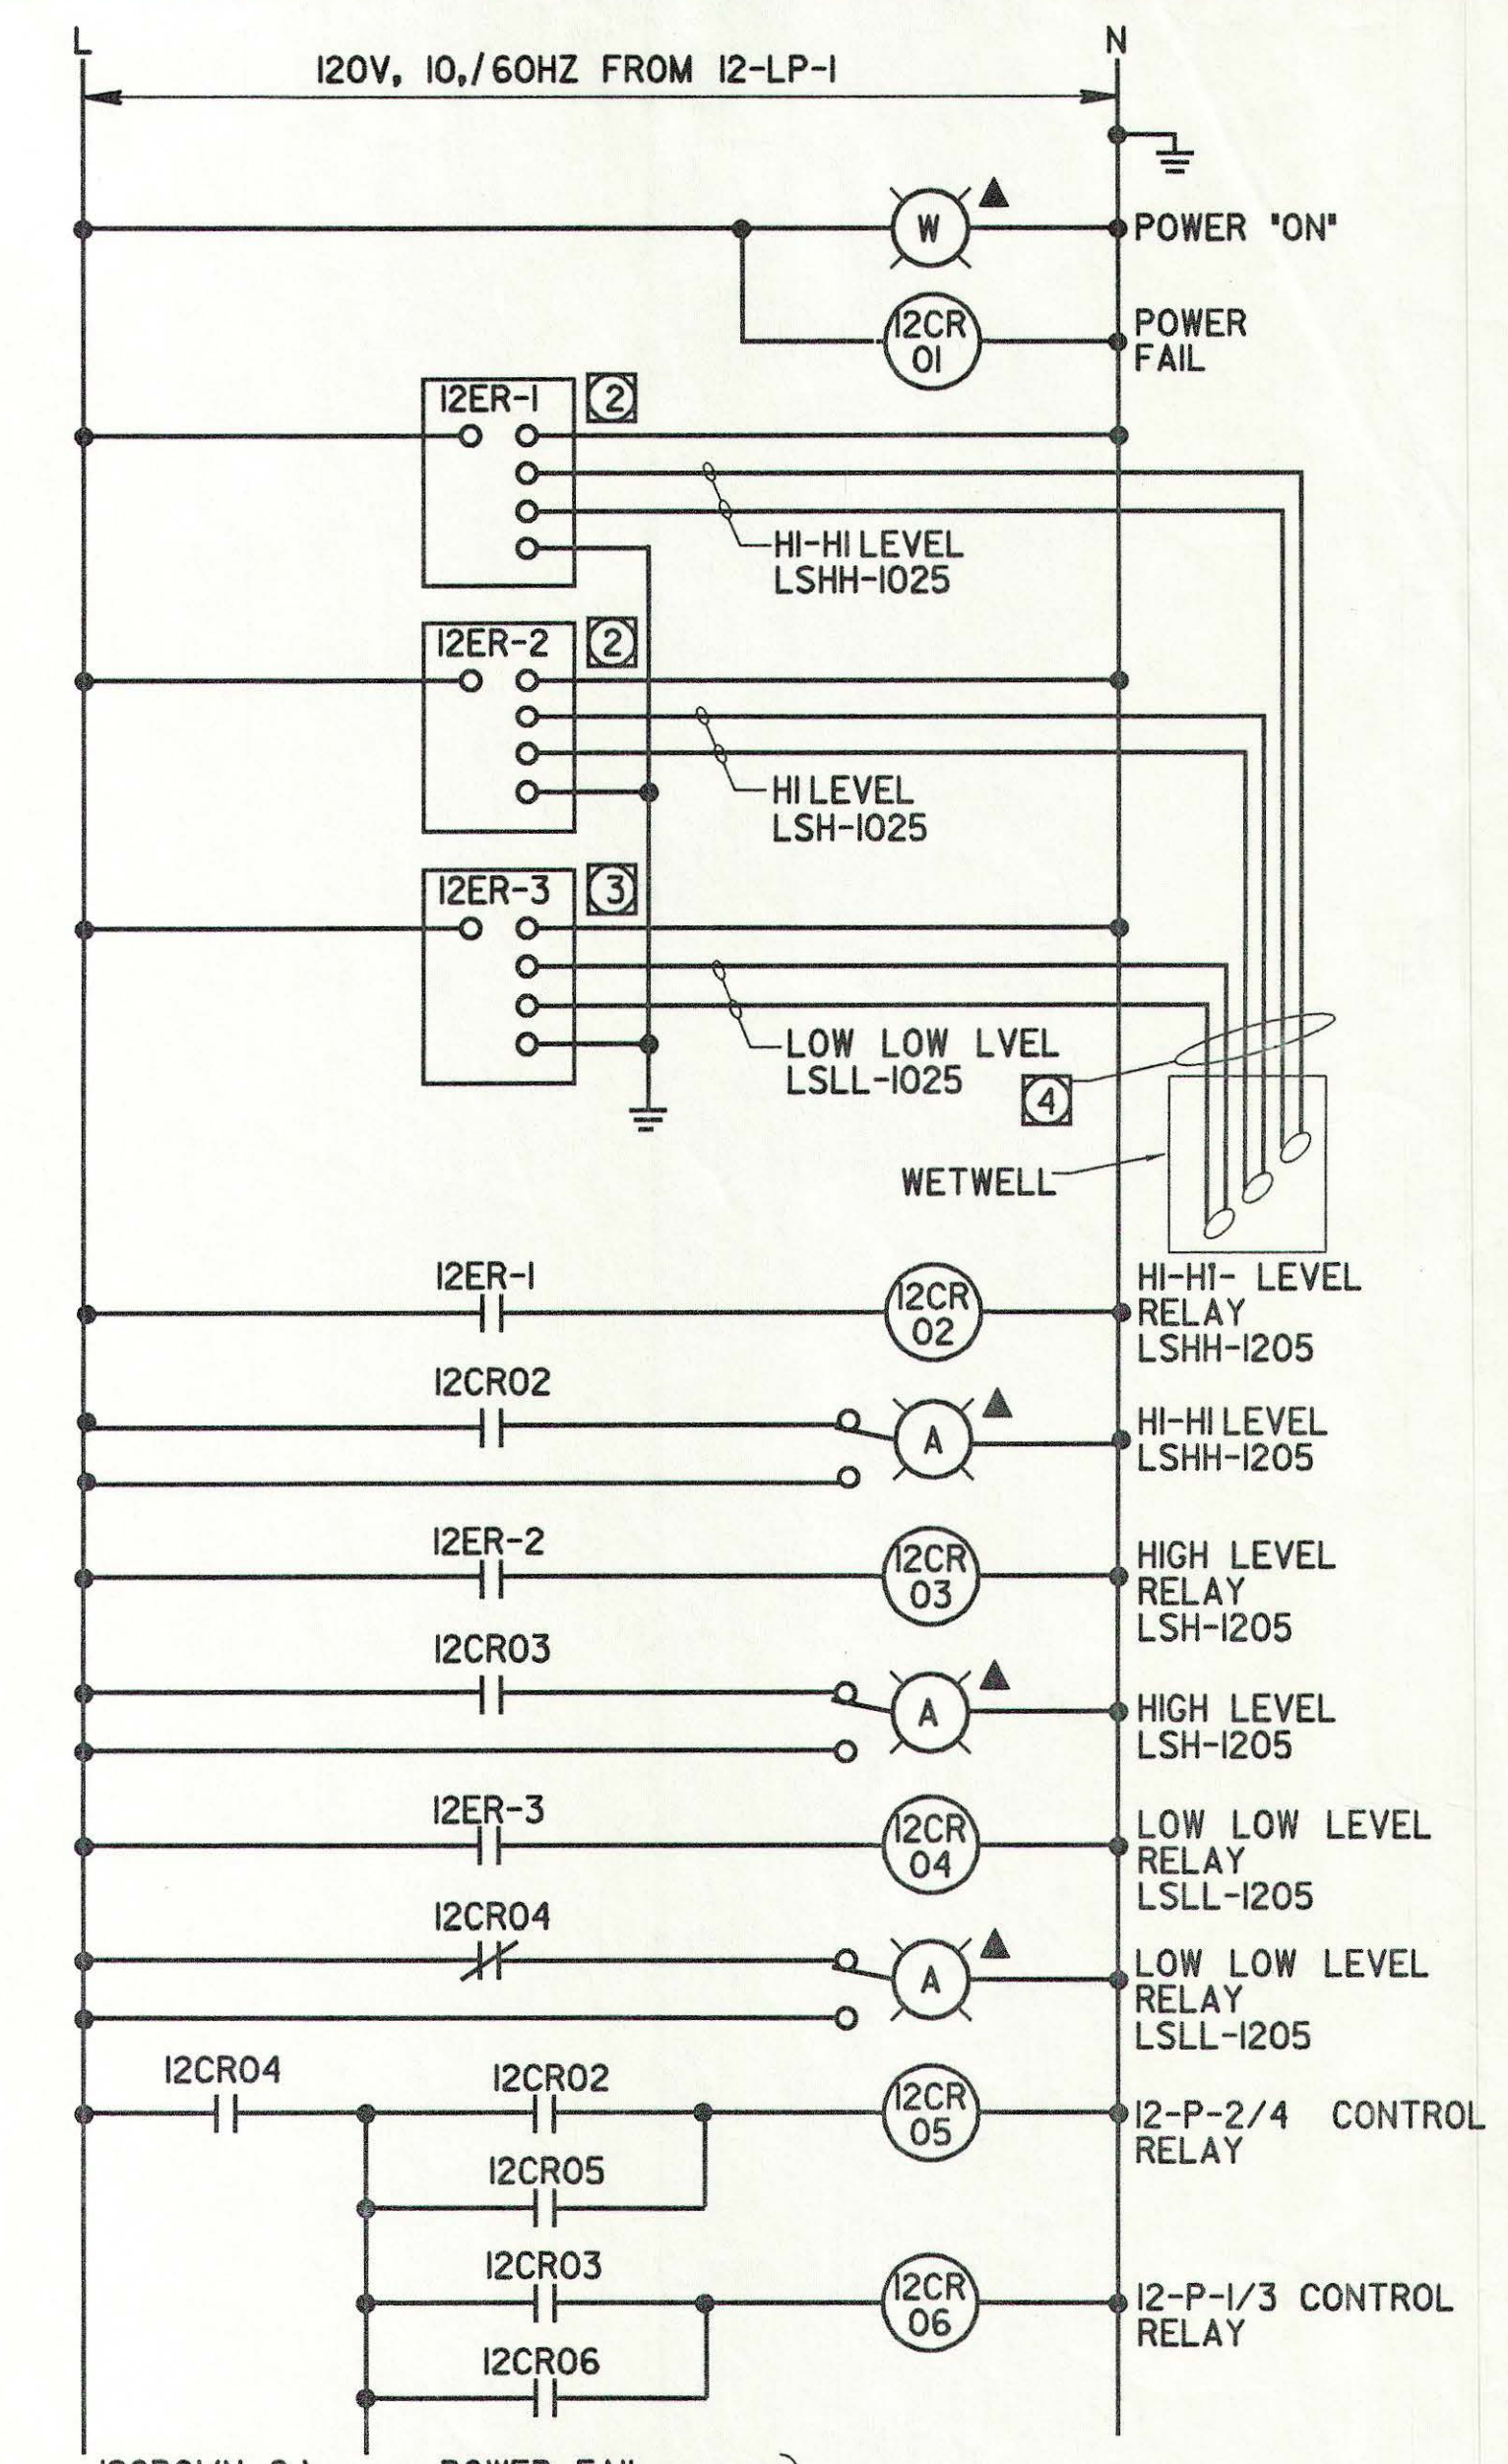

12CRO1 (N.C.) ----- POWER FAIL  
12CRO2 (N.O.) HI-HI LEVEL (LSHH-1025)  
12CRO6 (N.O.) HI-LEVEL (LSH-1025)  
12CRO4 (N.C.) LOW LEVEL (LSL-1025) TO PLC-5

③ 12CRO5 (N.O.) ----- ON/OFF CONTROL  
12CRO5 (N.O.) ----- SPEED RAMPUP CONTROL } TO 12-P-4 VFD

12CRO5 (N.O.) ----- ON/OFF CONTROL  
12CRO4 (N.O.) ----- LOW LEVEL SHUTDOWN } TO 12-P-2 STARTER

③ 12CRO6 (N.O.) ----- ON/OFF CONTROL  
12CRO6 (N.O.) ----- SPEED RAMPUP CONTROL } TO 12-P-3 VFD

12CRO6 (N.O.) ----- ON/OFF CONTROL  
12CRO4 (N.O.) ----- LOW LEVEL SHUTDOWN } TO 12-P-1 STARTER

② INTRINSICALLY SAFE RELAY B/W CONTROLS SERIES 53 OR EQUAL.


③ WHEN THE VFD IS CONTROLLED BY FLOATS, THE VFD SHALL RUN AT FULL SPEED.

④ FLOAT SWITCHES LEVEL DETERMINED BY PROCESS REQUIREMENT.

### WETWELL LEVEL CONTROL CIRCUIT (ALL ITEMS LOCATED AT MCC RELAY COMPARTMENT UNLESS OTHERWISE NOTED)

10/2/01	PHP	REVISE SEAL WATER PUMP CONTROL	SCALE	WARNING 0 1/2 IF THIS BAR DOES NOT MEASURE 1" THEN DRAWING IS NOT TO SCALE	DESIGNED K.D. CHUN	SUBMITTED BY [Signature]	43131	11/5/01	DATE		MONTGOMERY WATSON Pasadena, California	APPROVED [Signature]	1/2/02	DATE	KELWOOD DEVELOPMENT COMPANY 45 RANCH SANITATION DISTRICT WASTEWATER TREATMENT PLANT EXPANSION TO 2.0 MGD	SHEET E OF
			NONE		DRAWN N. CHRAKIAN	PROJECT MANAGER [Signature]	33699	11/5/01	DATE			FILANC CONSTRUCTION CO.	DATE	NEIGHBORHOOD NO. 1 PUMP STATION SCHEMATIC DIAGRAMS		
REV	DATE	BY	OMWD	DESCRIPTION	CHECKED K.D. CHUN	COMPANY OFFICER [Signature]										




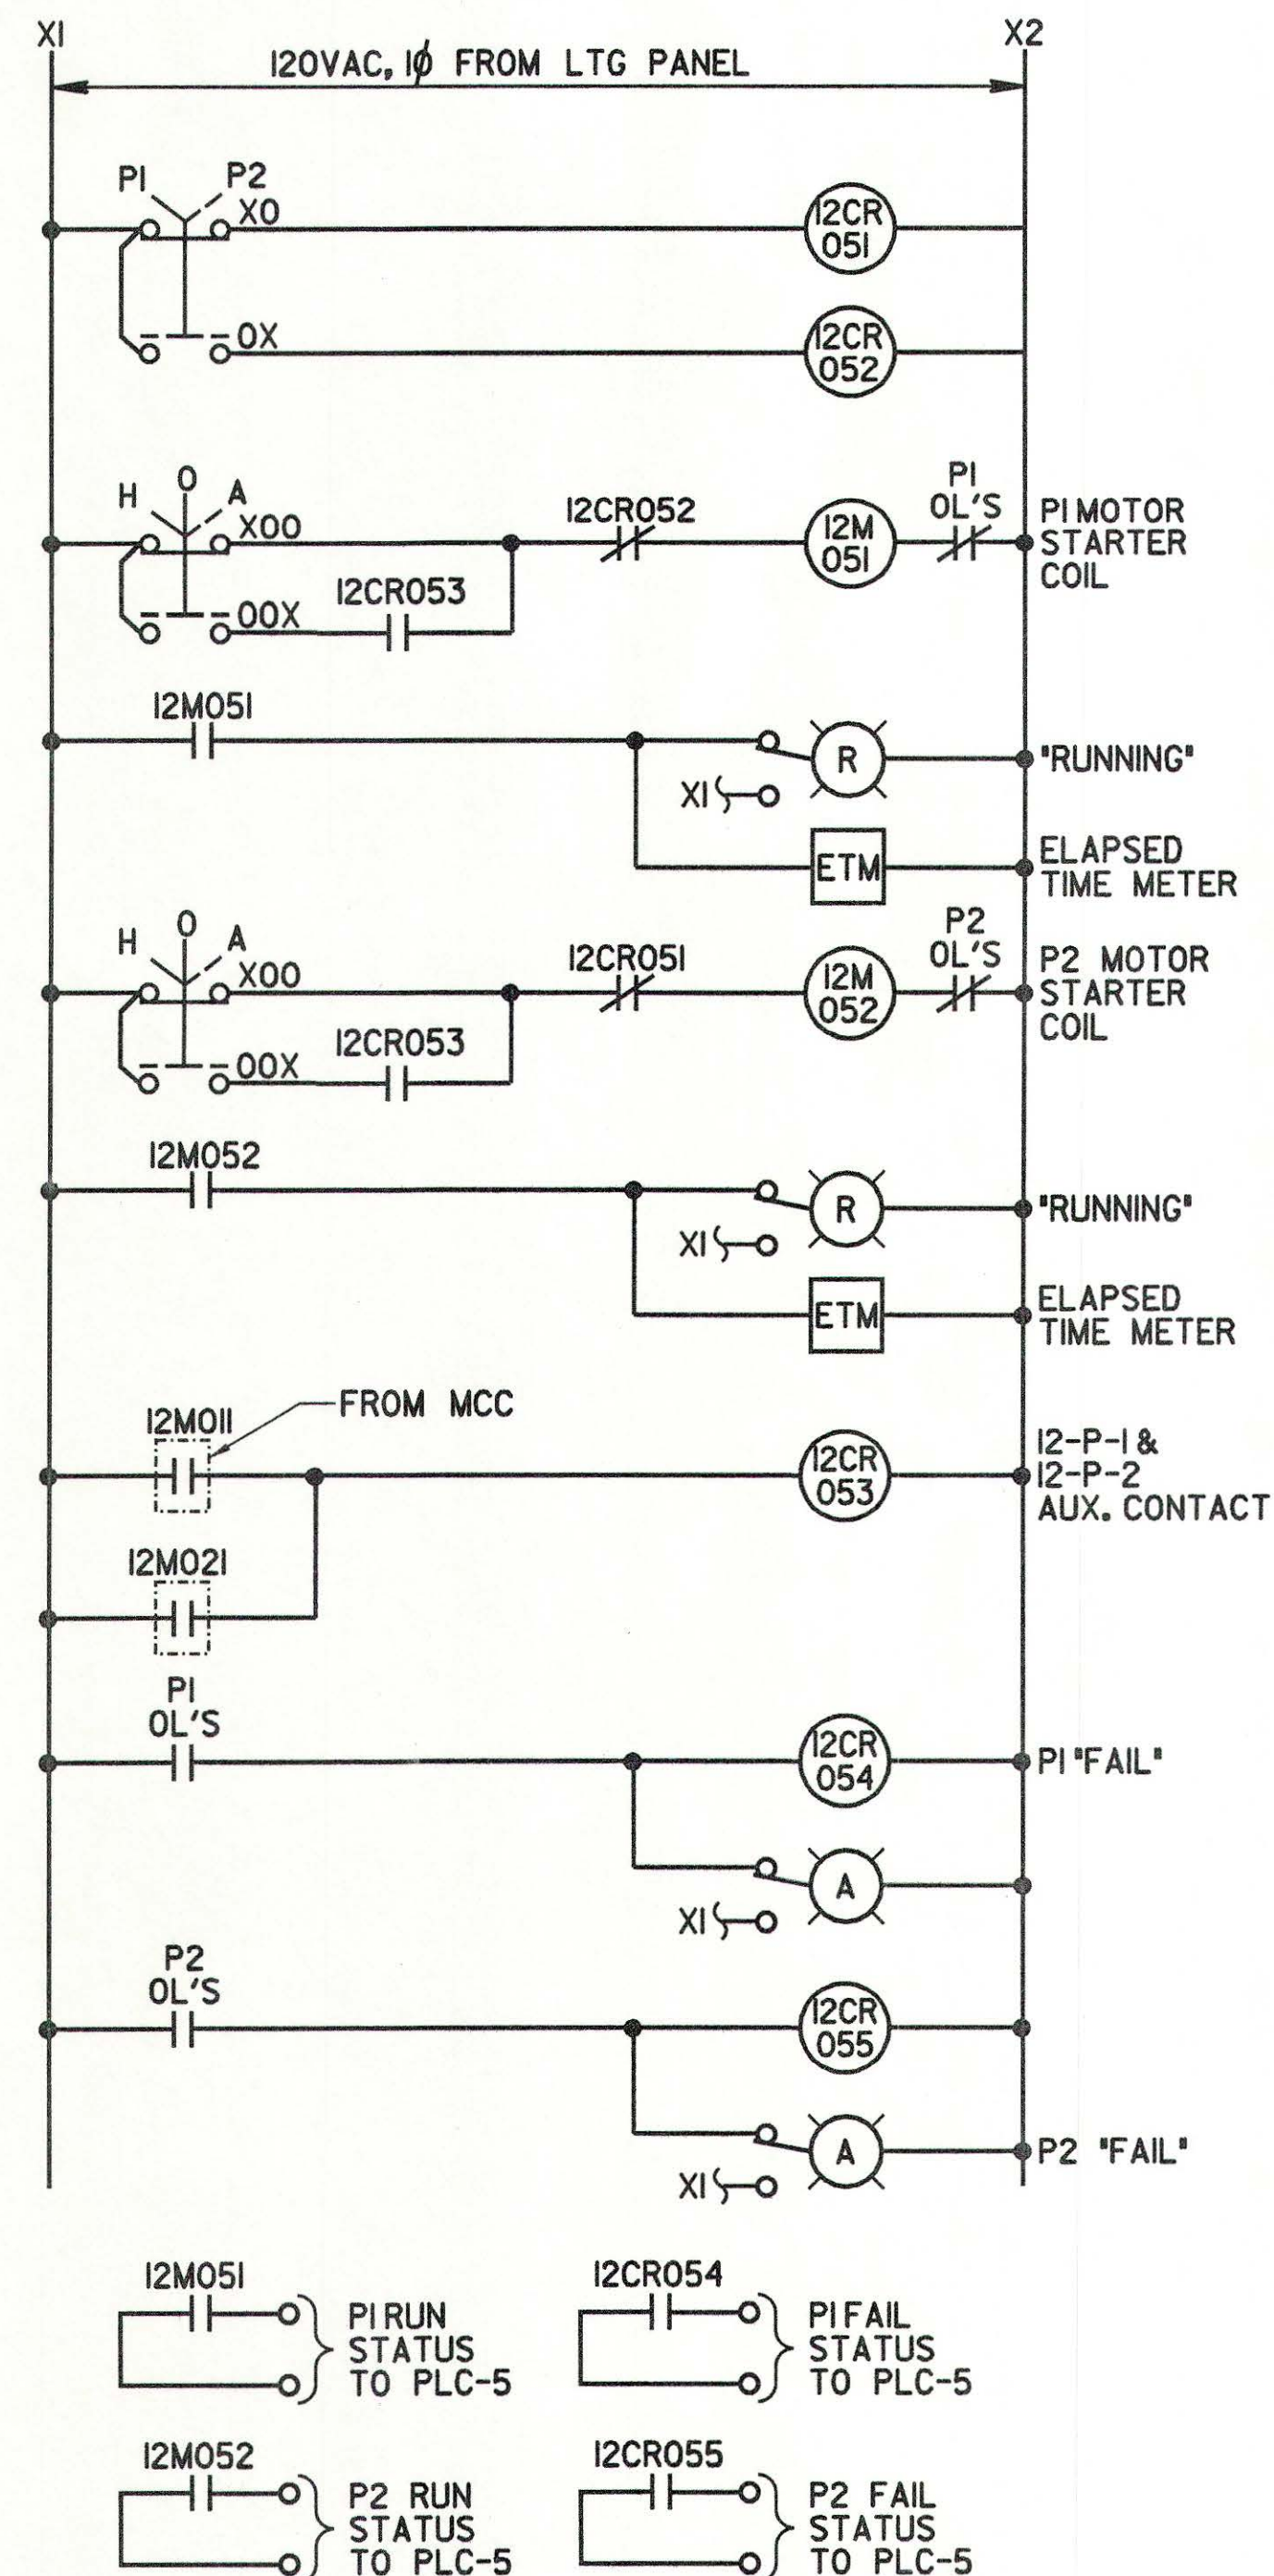

SEAL WATER PUMP LCP  
(12-P-5 & 12-P-6)

The limited review of this document by PBS & J on behalf of the Olivenhain Municipal Water District, is intended as a limited review only for general conformance with: (1) This approved Design/Build documents, (2) Accepted standards of practice within the industry, and (3) The standards of the Olivenhain Municipal Water District. This limited review in no way is intended, nor shall it act, to relieve the Design/Build Team of any professional liability to the responsibility to provide a complete and functional facility that is compliant with all applicable specifications, standards, codes, and regulations.

PBS & J  
Date: 12/1/01 By: [Signature]

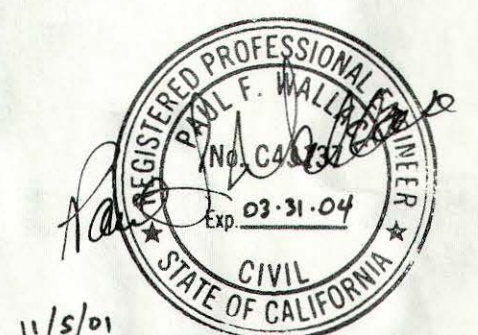

REV	DATE	BY	OMWD	DESCRIPTION	SCALE	WARNING 0 1/2 IF THIS BAR DOES NOT MEASURE 1" THEN DRAWING IS NOT TO SCALE	DESIGNED P. PHAM DRAWN P. PHAM CHECKED P. WALLACE	SUBMITTED BY PROJECT MANAGER P. WALLACE COMPANY OFFICER	43137 LICENSE NO. 33619 LICENSE NO.	11/5/01 DATE 11/5/01 DATE	MONTGOMERY WATSON Pasadena, California	APPROVED George P. Bunt OLIVENHAIN APPROVED FILANC CONSTRUCTION CO.	1/2/02 DATE	KELWOOD DEVELOPMENT COMPANY 4S RANCH SANITATION DISTRICT WASTEWATER TREATMENT PLANT EXPANSION TO 2.0 MGD NEIGHBORHOOD NO. 1 PUMP STATION SCHEMATIC DIAGRAMS - 2
-----	------	----	------	-------------	-------	--	---	--	--	------------------------------------	---	---	----------------	---




LIGHTING FIXTURE SCHEDULE			
TYPE	WATTS	VOLTS	DESCRIPTION
FI	2-32W T-8	120	4' INDUSTRIAL FLUORESCENT LIGHT FIXTURE, HOUSING OF DIE-FORMED, PRIME QUALITY STEEL, WELDED SOCKET PLATE, PAINTED AFTER FABRICATION, WHITE BAKED ENAMEL FINISH. PRUDENTIAL CAT. * P-202-48CTE OR EQUAL.
H	70W	120	HIGH PRESSURE SODIUM (HPS). STANCHION MOUNT, INTEGRAL BALLAST, OUTDOOR WEATHERPROOF TYPE, PRISMATIC GLASS REFRACTOR. HOLOPHANE CAT. * PTA-70HP-12- OR EQUAL.
HI	50W HPS	120	HIGH PRESSURE SODIUM (HPS). WALL MOUNTING TYPE, INTEGRAL BALLAST, OUTDOOR WEATHERPROOF TYPE, DIE CAST ALUMINUM HOUSING, TEXTURED BRONZE, THERMAL SHOCK RESISTANT, PRISMATIC GLASS REFRACTOR. HOLOPHANE CAT. * WP-1-A-050HP-12-BZ-F1OR EQUAL.
H2	250W HPS	120	POLE MOUNTED HIGH PRESSURE SODIUM (HPS). FORMED ALUMINUM HOUSING WITH CAST ALUMINUM DOOR FRAME, PRISMATIC LENS, ALUMINUM REFLECTOR AND INTEGRAL BALLAST. HANDHOLE AND RECEPTACLE WHERE REQUIRED. HOLOPHANE CAT. * SMST-25AHP-12-BZ-PM-F1, POLE *CSZSQ20J/1A OR EQUAL.

**1 CONDUITS SHALL BE SIZED PER  
PUMP VENDOR RECOMMENDATION**

A circular professional engineer seal for the State of California. The outer ring contains the text "REGISTERED PROFESSIONAL ENGINEER" at the top and "STATE OF CALIFORNIA" at the bottom, separated by two stars. Inside the ring, the name "PAUL F. WALL" is written in an arc. Below the name is the license number "No. C43187". At the bottom of the seal is the word "CIVIL". In the center, the expiration date "Exp. 03-31-04" is stamped. There are handwritten initials "PFW" over the license number and a signature "A. J. [illegible]" on the left side of the seal.


					SCALE	WARNING 0 1/2 1	DESIGNED K.D. CHUN	SUBMITTED BY <i>George P. Smith</i>	APPROVED <i>George P. Smith</i>		KELWOOD DEVELOPMENT COMPANY		SHEET  <b>E-4</b>  OF * SHEETS		
					NONE	IF THIS BAR DOES NOT MEASURE 1" THEN DRAWING IS NOT TO SCALE.	DRAWN N. CHRAKIAN	PROJECT MANAGER <i>George P. Smith</i>	LICENSE NO. 58602	DATE 12/13/06	8.29.01 DATE	4S RANCH SANITATION DISTRICT			
							CHECKED K.D. CHUN	<i>George P. Smith</i> COMPANY OFFICER	LICENSE NO. 33699	DATE 12/13/00		WASTEWATER TREATMENT PLANT EXPANSION TO 2.0 MGD			
REV	DATE	BY	OMWD	DESCRIPTION	 <b>MONTGOMERY WATSON</b> Pasadena, California								APPROVED FILANC CONSTRUCTION CO. DATE		NEIGHBORHOOD NO.1 PUMP STATION PANEL, FIXTURE AND CONDUIT SCHEDULES



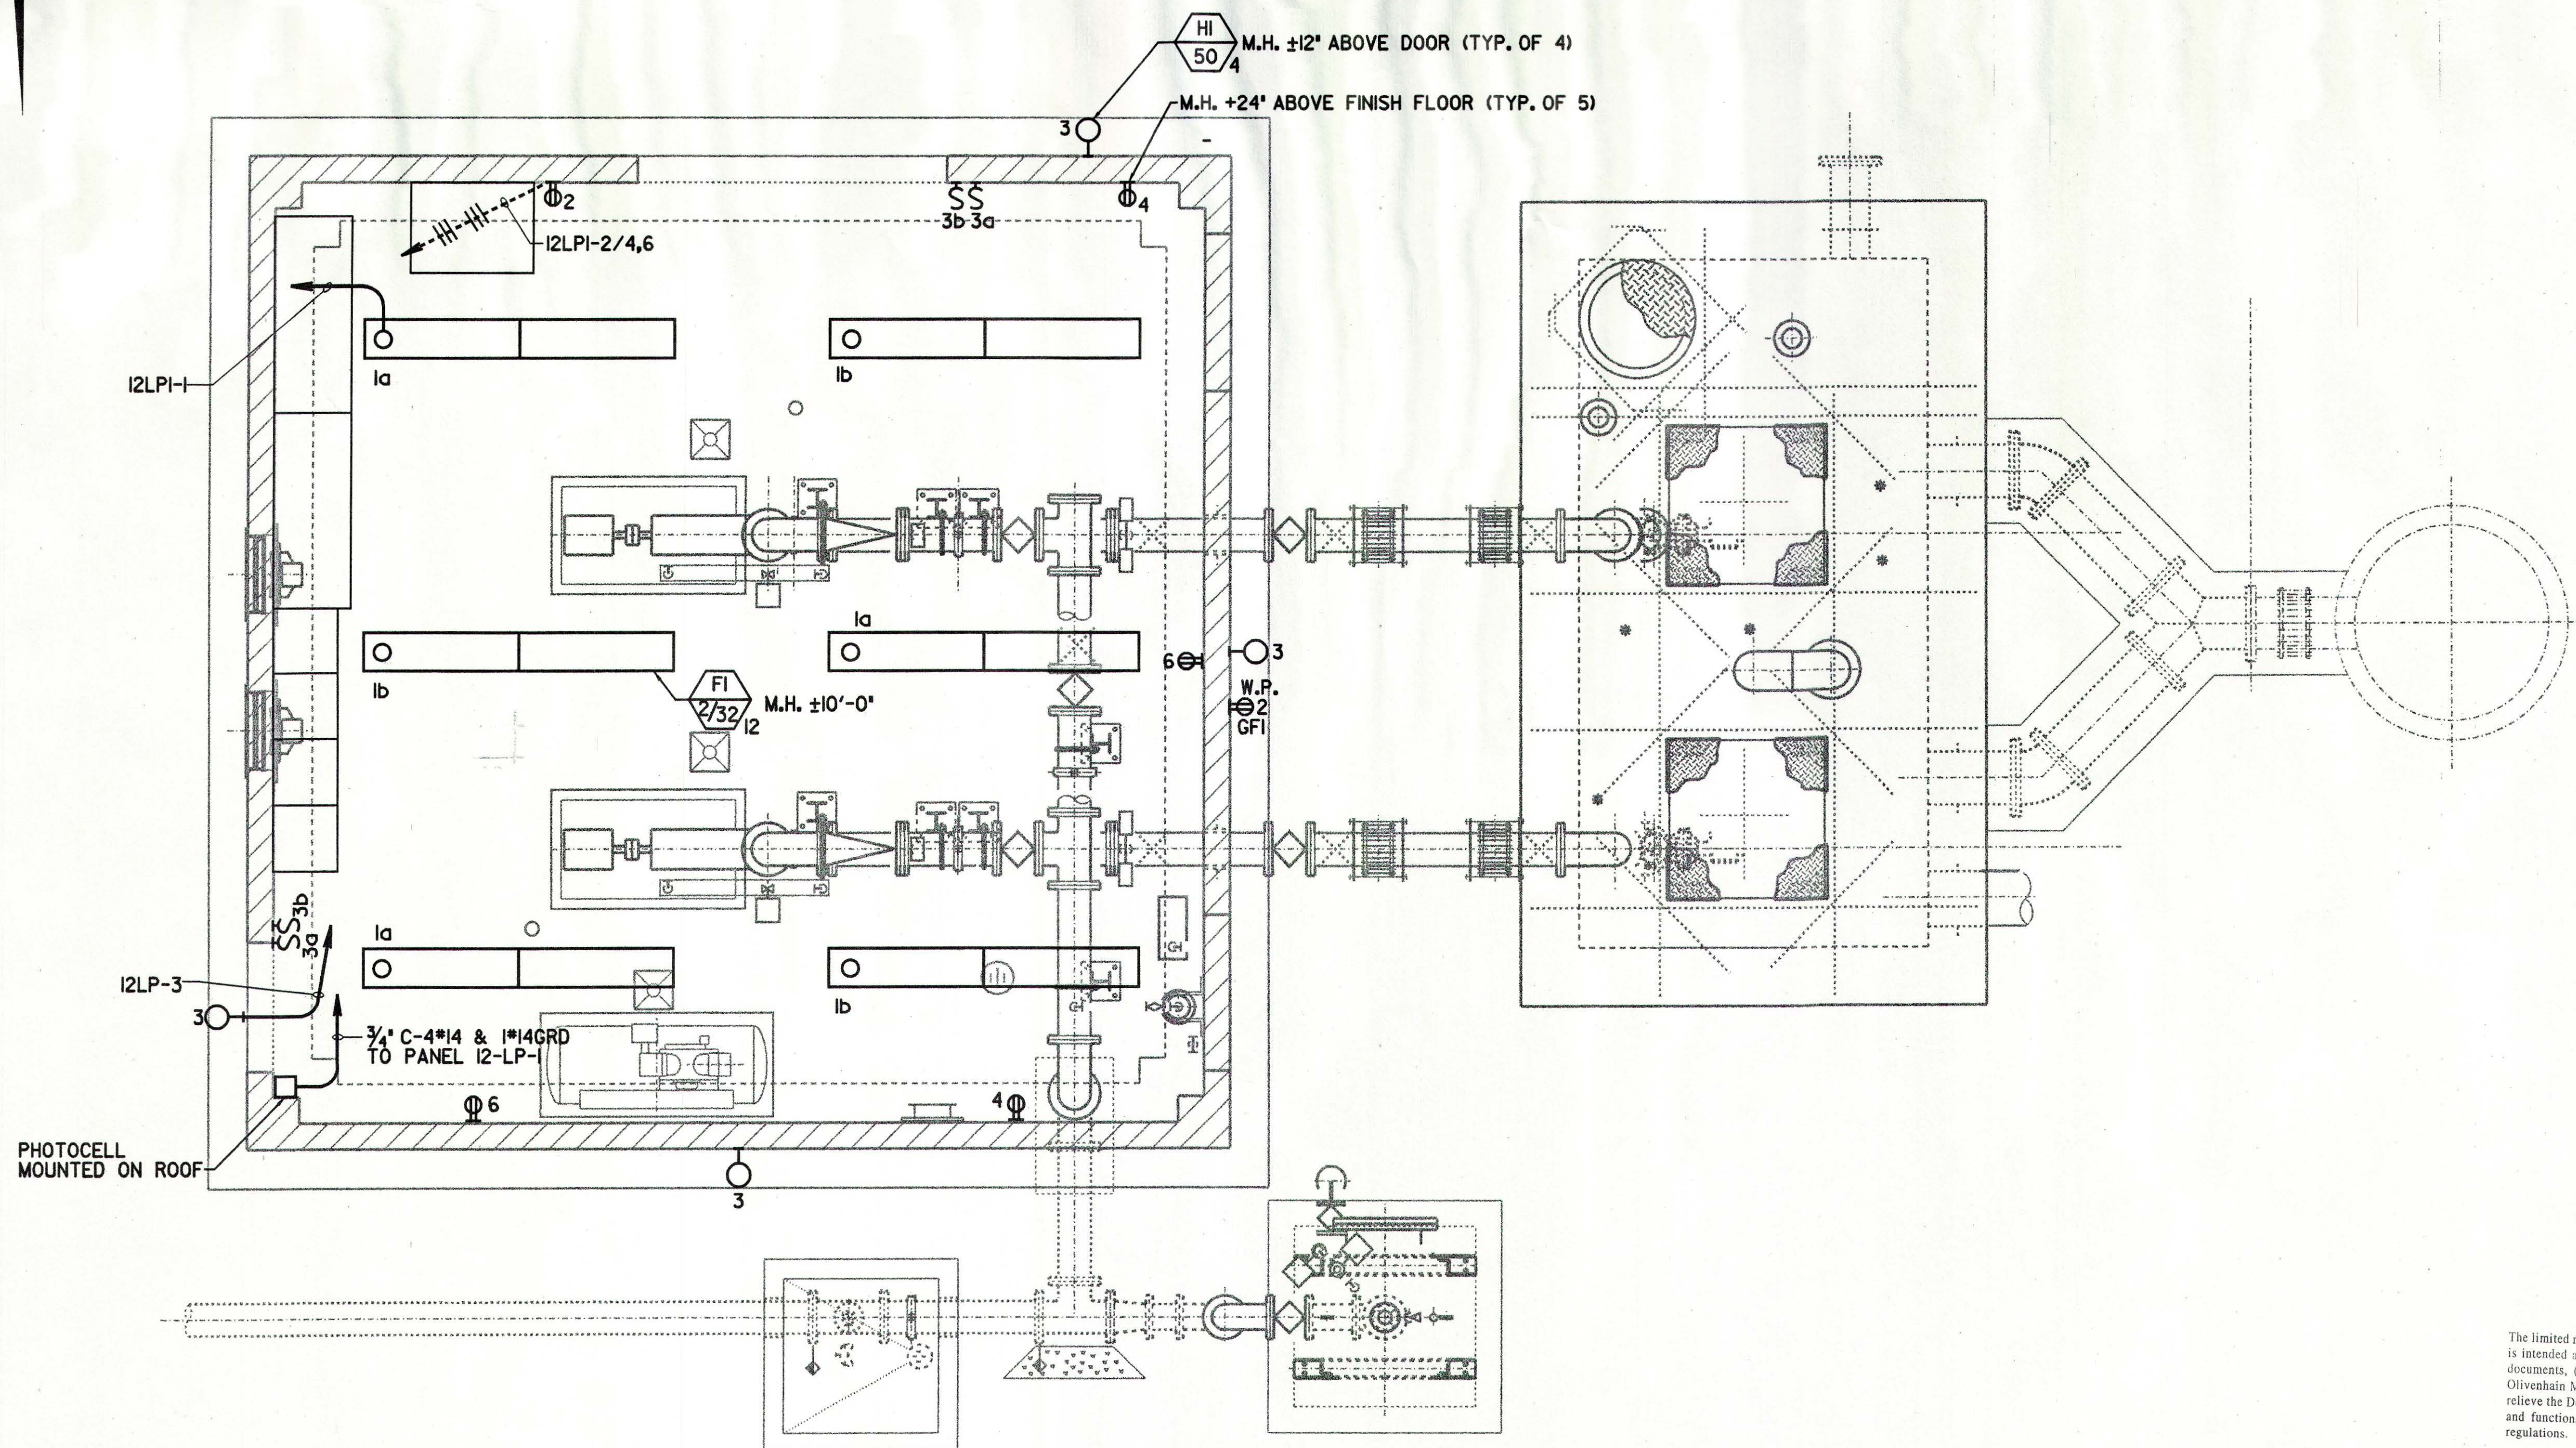

The limited review of this document by PBS & J on behalf of the Olivenhain Municipal Water District, is intended as a limited review only for general conformance with: (1) This approved Design/Build documents, (2) Accepted standards of practice within the industry, and (3) The standards of the Olivenhain Municipal Water District. This limited review in no way is intended, nor shall it act, to relieve the Design/Build Team of any professional liability to the responsibility to provide a complete and functional facility that is compliant with all applicable specifications, standards, codes, and regulations.

PBS & J  
Date 8/27/01 By A. 104

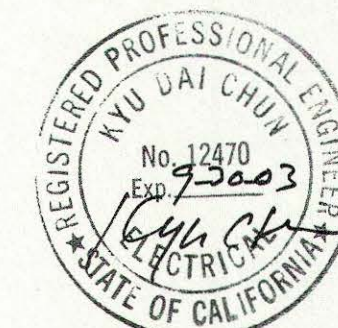

REV	DATE	BY	OMWD	DESCRIPTION

SCALE

3/8" = 1'-0"

WARNING

IF THIS BAR DOES NOT MEASURE 1" THEN DRAWING IS NOT TO SCALE

DESIGNED K.D. CHUN  
DRAWN N. CHRAKIAN  
CHECKED K.D. CHUN

SUBMITTED BY

PROJECT MANAGER  
COMPANY OFFICER

50802  
LICENSE NO.  
12/13/00  
DATE



**MONTGOMERY WATSON**  
Pasadena, California

APPROVED  
OLIVENHAIN MWD  
APPROVED

FILANC CONSTRUCTION CO.

8.29.01

DATE

DATE

KELWOOD DEVELOPMENT COMPANY  
45 RANCH SANITATION DISTRICT  
WASTEWATER TREATMENT PLANT EXPANSION TO 2.0 MGD  
NEIGHBORHOOD NO. 1 PUMP STATION  
LIGHTING AND RECEPTACLE PLAN

SHEET

12E-1


OF • SHEETS



Plot Date: 05-NOV-2001 14:51

File: p:\Projects\45R\U2\ele\45rmi2e02.dwg

Job No. MW Job #

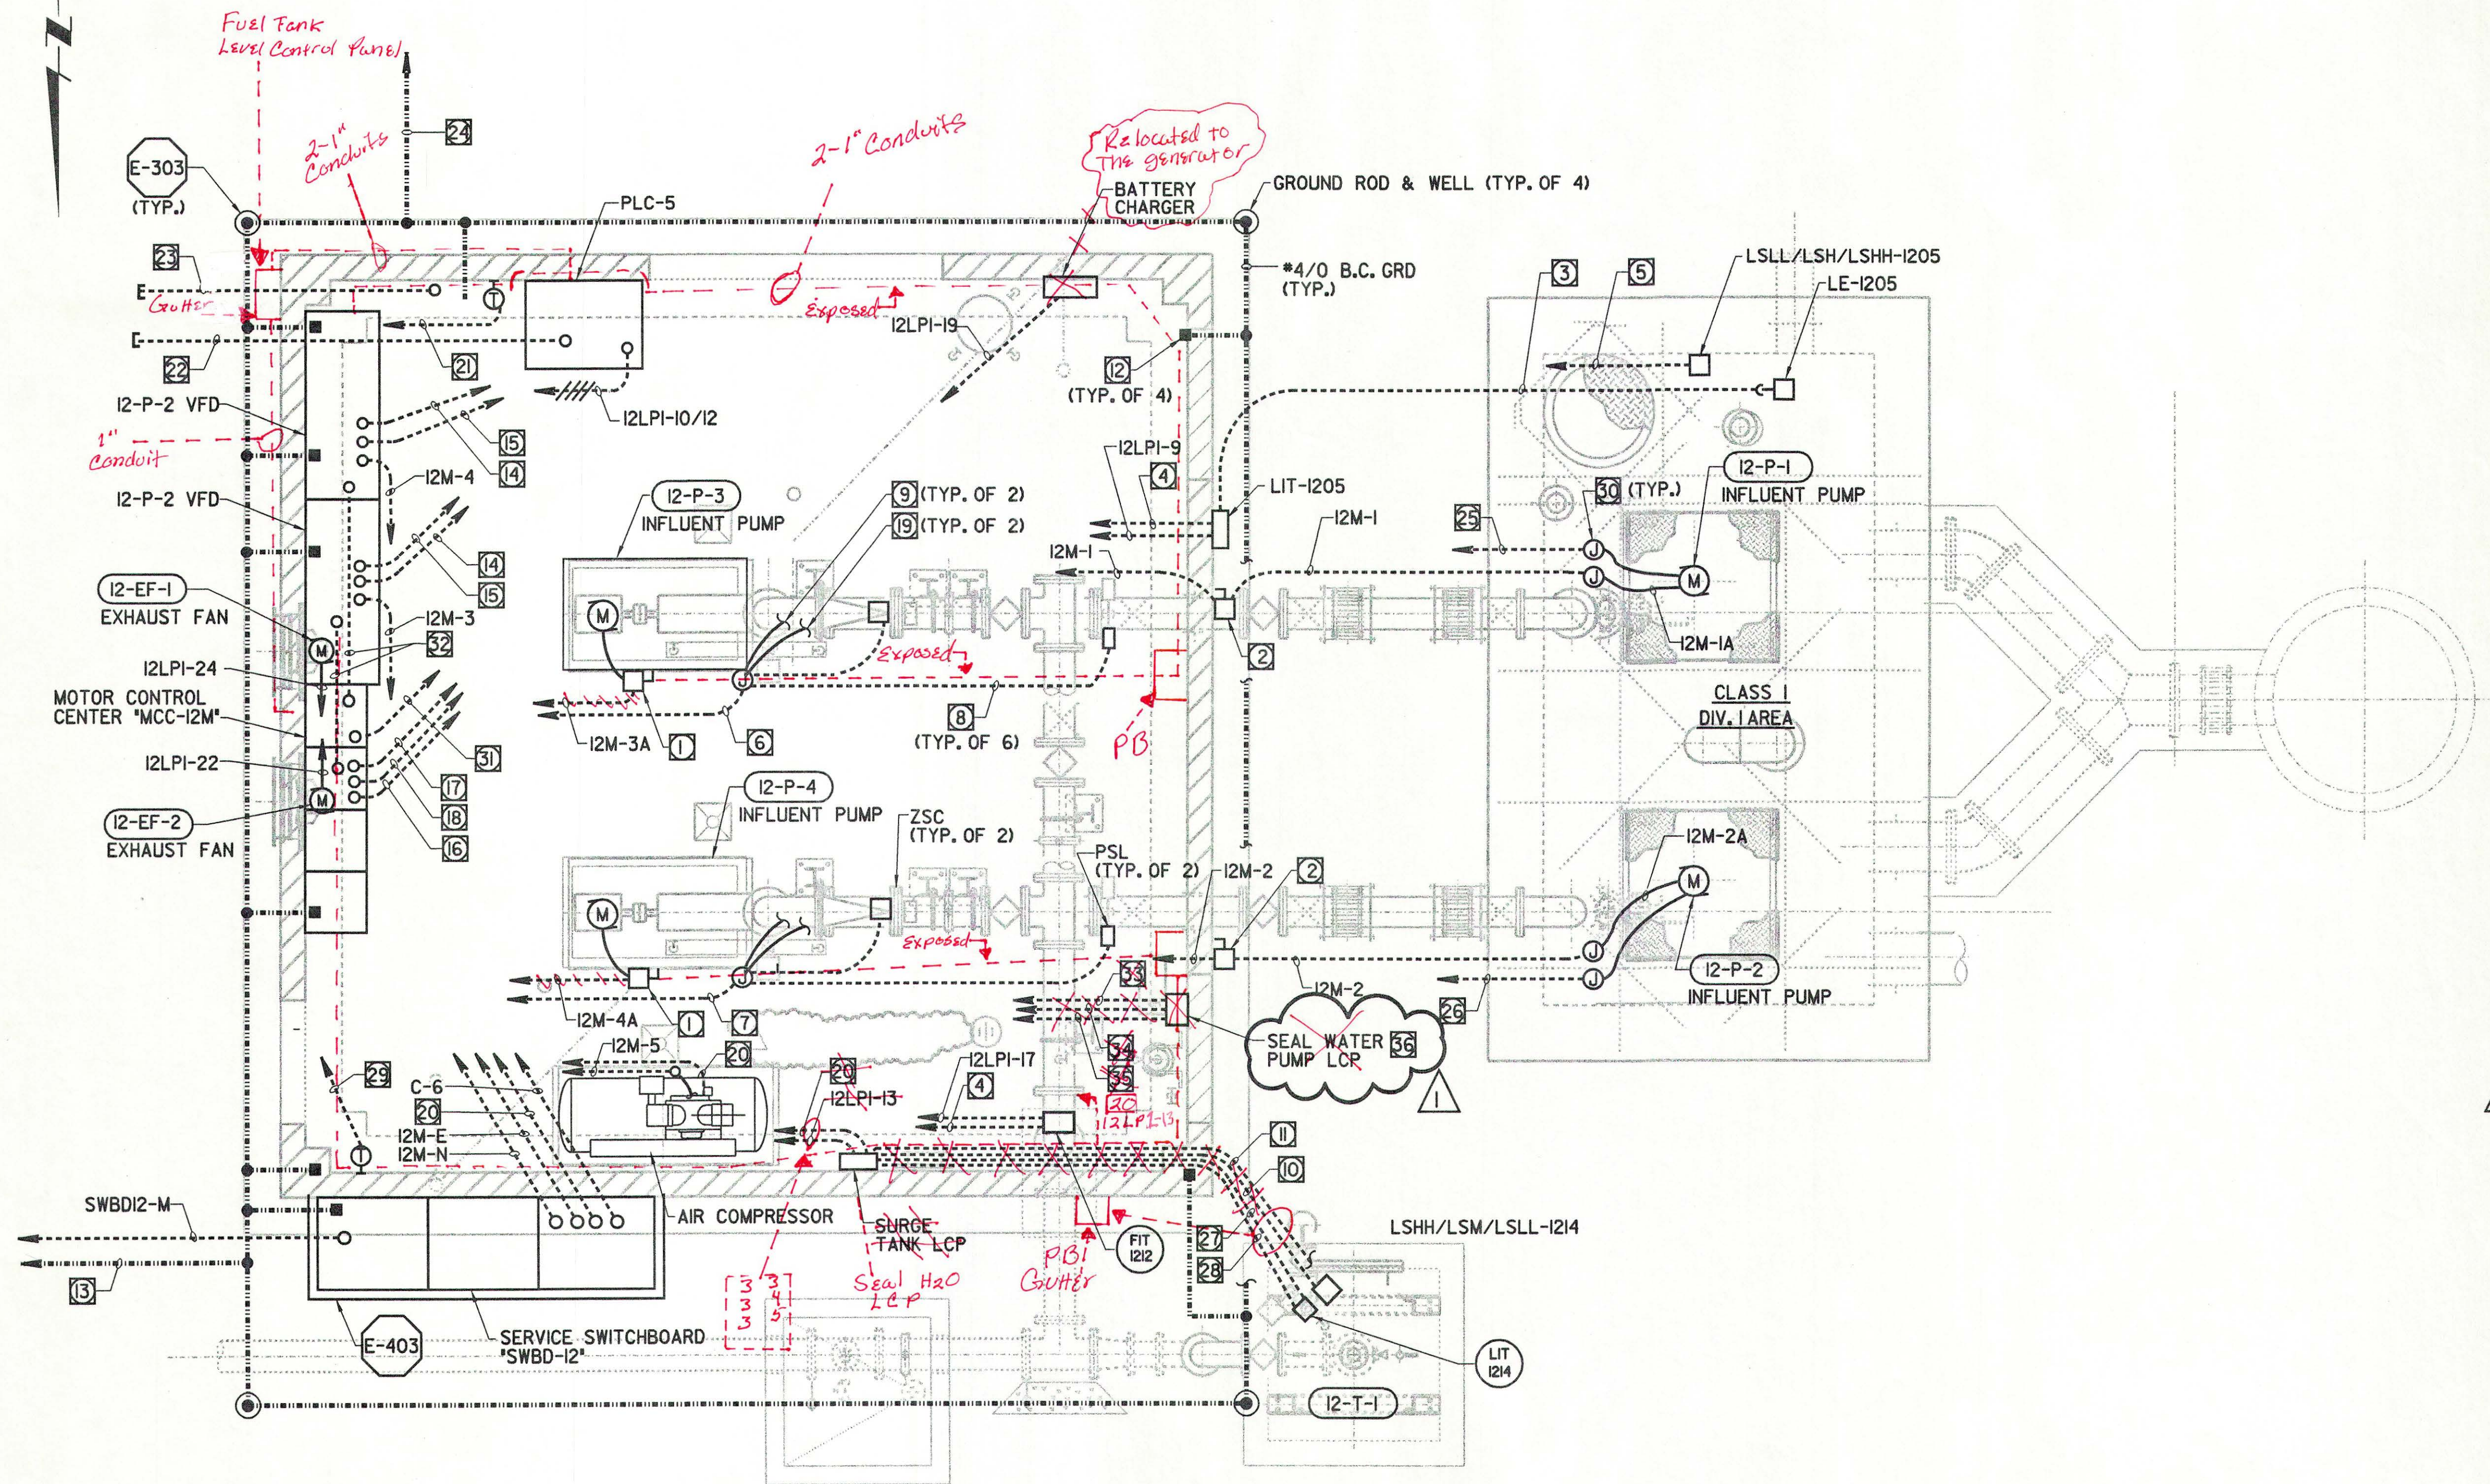


NOTES:

- 1 400A, 3P, 480V DISCONNECT SW.
- 2 200A, 3P, 480V DISCONNECT SW.
- 3 3/4\" C WITH CABLE SUPPLIED BY INSTRUMENT SUPPLIER.
- 4 3/4\" C-2/C\*16SHIELDED TO PLC-5
- 5 3/4\" C-6\*14 & 1\"14GRD TO MCC-I2M
- 6 1\" C-16\*14 & 1\"14GRD TO VFD-1.
- 7 1\" C-16\*14 & 1\"14GRD TO VFD-2.
- 8 3/4\" C-2\*14 & 1\"14GRD.
- 9 3/4\" C-5\*14 TO SEAL WATER SOLENOID VALVE & PSL.
- 10 3/4\" C-8\*14 & 1\"14GRD.
- 11 3/4\" C-4\*14 & 1\"14GRD TO AIRLINE SOLENOID VALVE.
- 12 CONNECT TO FOUNDATION REBAR.
- 13 TO SERVICE TRANSFORMER GROUND.
- 14 3/4\" C-(2) 2/C \*16SHLD TO PL-5
- 15 3/4\" C-14\*14 TO PLC-5
- 16 3/4\" C-2\*14 TO PLC-5
- 17 3/4\" C-12 \*14 TO VFD-1.
- 18 3/4\" C-12 \*14 TO VFD-2.
- 19 3/4\" C-4\*14 & 1\"14GRD TO MOTOR SPACE HEATER & WIND. TEMP. SW.
- 20 3/4\" C-8\*14 TO PLC.
- 21 3/4\" C-4\*14GRD TO I2-EF-1 CONTROL.
- 22 2\" C.O. (DATA HWY).
- 23 2\" C.O. TELEPHONE CONDUIT.
- 24 TO GENERATOR GROUND.
- 25 3/4\" C-7\*14 TO VFD-1.
- 26 3/4\" C-7\*14 TO VFD-2.
- 27 3/4\" C-2\*12 & 1\"12GRD.
- 28 3/4\" C-(1)-2/C\*16SHLD.
- 29 3/4\" C-2\*14 & 1\"14 TO I2-EF-2 CONTROL.
- 30 CABLE SPLICE BOX (NEMA -4X)
- 31 1\" C-20\*14 TO PLC-5.
- 32 1/2\" C-30\*14.
- 33 1\" C-2\*12 & 1\"12GRD TO I2-LP-1.
- 34 3/4\" C-4\*14 TO MCC.
- 35 3/4\" C-8\*14 TO PLC-5.
- 36 SEAL WATER PUMP LCP. SEE CONTROL SCHEMATIC DIAGRAM.

The limited review of this document by PBS & J on behalf of the Olivenhain Municipal Water District, is intended as a limited review only for general conformance with: (1) This approved Design/Build documents, (2) Accepted standards of practice within the industry, and (3) The standards of the Olivenhain Municipal Water District. This limited review in no way is intended, nor shall it act, to relieve the Design/Build Team of any professional liability to the responsibility to provide a complete and functional facility that is compliant with all applicable specifications, standards, codes, and regulations.

PBS & J  
Date 12/19/01 By [Signature]

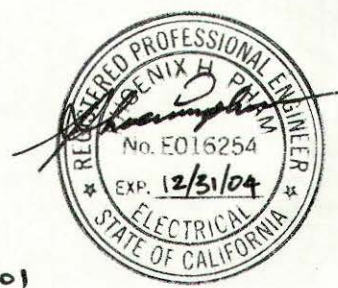

11/5/01

REV	DATE	BY	OMWD	DESCRIPTION
1	10/2/01	PHP		REVISE SEAL WATER PUMP CONTROL

SCALE
3/8\" = 1'-0"
WARNING
IF THIS BAR DOES NOT MEASURE 1\" THEN DRAWING IS NOT TO SCALE

DESIGNED	K.D. CHUN
DRAWN	N. CHRAKIAN
CHECKED	K.D. CHUN

SUBMITTED BY	PROJECT MANAGER	DATE
[Signature]		11/5/01
COMPANY OFFICER		11/5/01
	43137	
	33699	




**MONTGOMERY WATSON**  
Pasadena, California

APPROVED	DATE
[Signature]	1/2/02
APPROVED	DATE
FILANC CONSTRUCTION CO.	

KELWOOD DEVELOPMENT COMPANY
45 RANCH SANITATION DISTRICT
WASTEWATER TREATMENT PLANT EXPANSION TO 2.0 MGD
NEIGHBORHOOD NO. 1 PUMP STATION
POWER AND CONTROL PLAN

SHEET  
**12E-2**  
OF 5 SHEETS



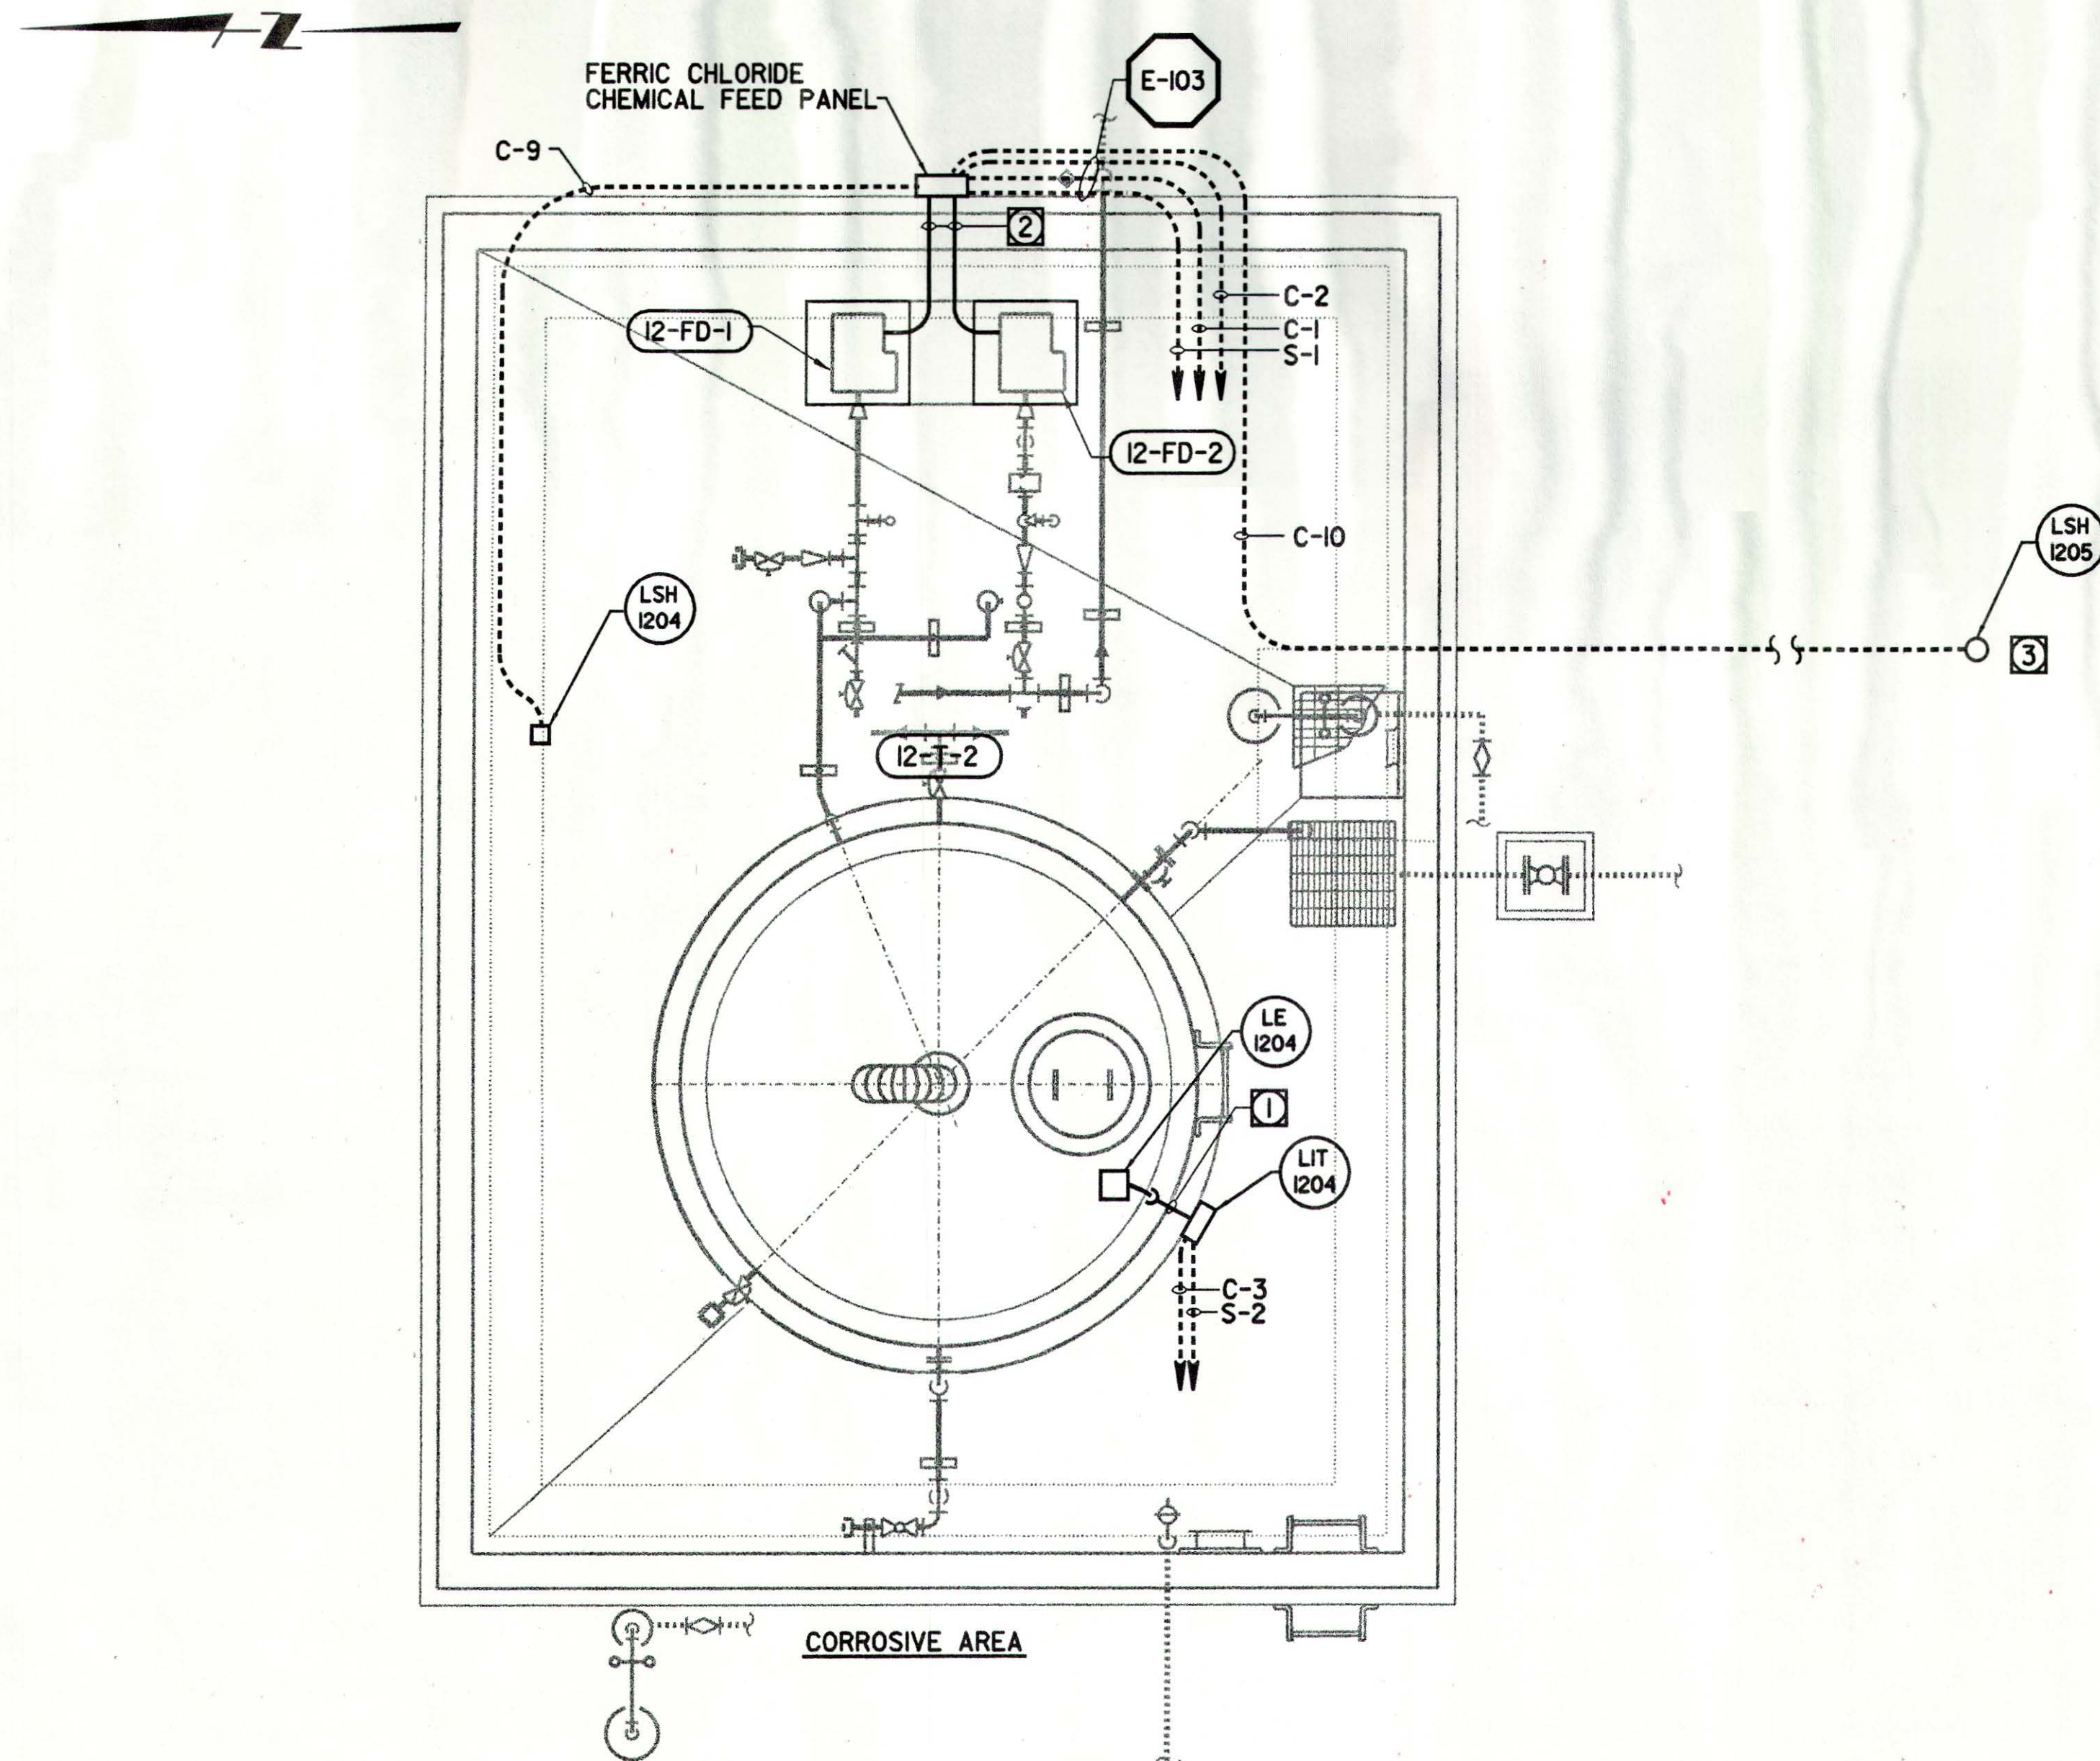


# NOTES:

- 1 3/4" CONDUIT WITH CABLE BY INSTRUMENT SUPPLIER.
- 2 3/4" C-4\*12 & 1\*12GRD.
- 3 CONTRACTOR SHALL FIELD LOCATE LS-1205 (LEAK DETECTOR) AT LOW POINT OF PIPING.
- 4 ALL AREAS SHOWN SHALL BE CORROSIVE AREAS AND ALL WORK SHALL COMPLY WITH THE SPECIFICATIONS.

## FERRIC CHLORIDE FEED AND STORAGE FACILITY

The limited review of this document by PBS & J on behalf of the Olivenhain Municipal Water District, is intended as a limited review only for general conformance with: (1) This approved Design/Build documents, (2) Accepted standards of practice within the industry, and (3) The standards of the Olivenhain Municipal Water District. This limited review in no way is intended, nor shall it act, to relieve the Design/Build Team of any professional liability to the responsibility to provide a complete and functional facility that is compliant with all applicable specifications, standards, codes, and regulations.

PBS & J  
Date 8/23/01 By *[Signature]*

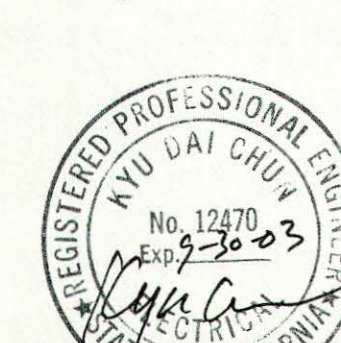

REV	DATE	BY	OMWD	DESCRIPTION

SCALE  
3/8" = 1'-0"

WARNING  
IF THIS BAR DOES NOT MEASURE 1" THEN DRAWING IS NOT TO SCALE

DESIGNED	K.D. CHUN	SUBMITTED BY	<i>[Signature]</i>
DRAWN	N. CHRAKIAN	PROJECT MANAGER	<i>[Signature]</i>
CHECKED	K.D. CHUN	COMPANY OFFICER	<i>[Signature]</i>
LICENSE NO.	50802	LICENSE NO.	33699
DATE	12/13/00	DATE	12/13/00



**MONTGOMERY WATSON**  
Pasadena, California

APPROVED	<i>[Signature]</i>	8.29.01
OLIVENHAIN MWD		DATE
APPROVED		DATE
FILANC CONSTRUCTION CO.		DATE


KELWOOD DEVELOPMENT COMPANY
4S RANCH SANITATION DISTRICT
WASTEWATER TREATMENT PLANT EXPANSION TO 2.0 MGD
NEIGHBORHOOD NO. 1 PUMP STATION
FERRIC CHLORIDE FEED FACILITY - ELECTRICAL PLAN

SHEET  
**12E-3**  
OF 5 SHEETS




**NOTES:**

- ① COMPLETE WIRING FOR LEVEL AND LEAK SENSORS.
- ② COMPLETE WIRING FOR CRANK CASE, HEATER, SPACE HEATER, ETC.

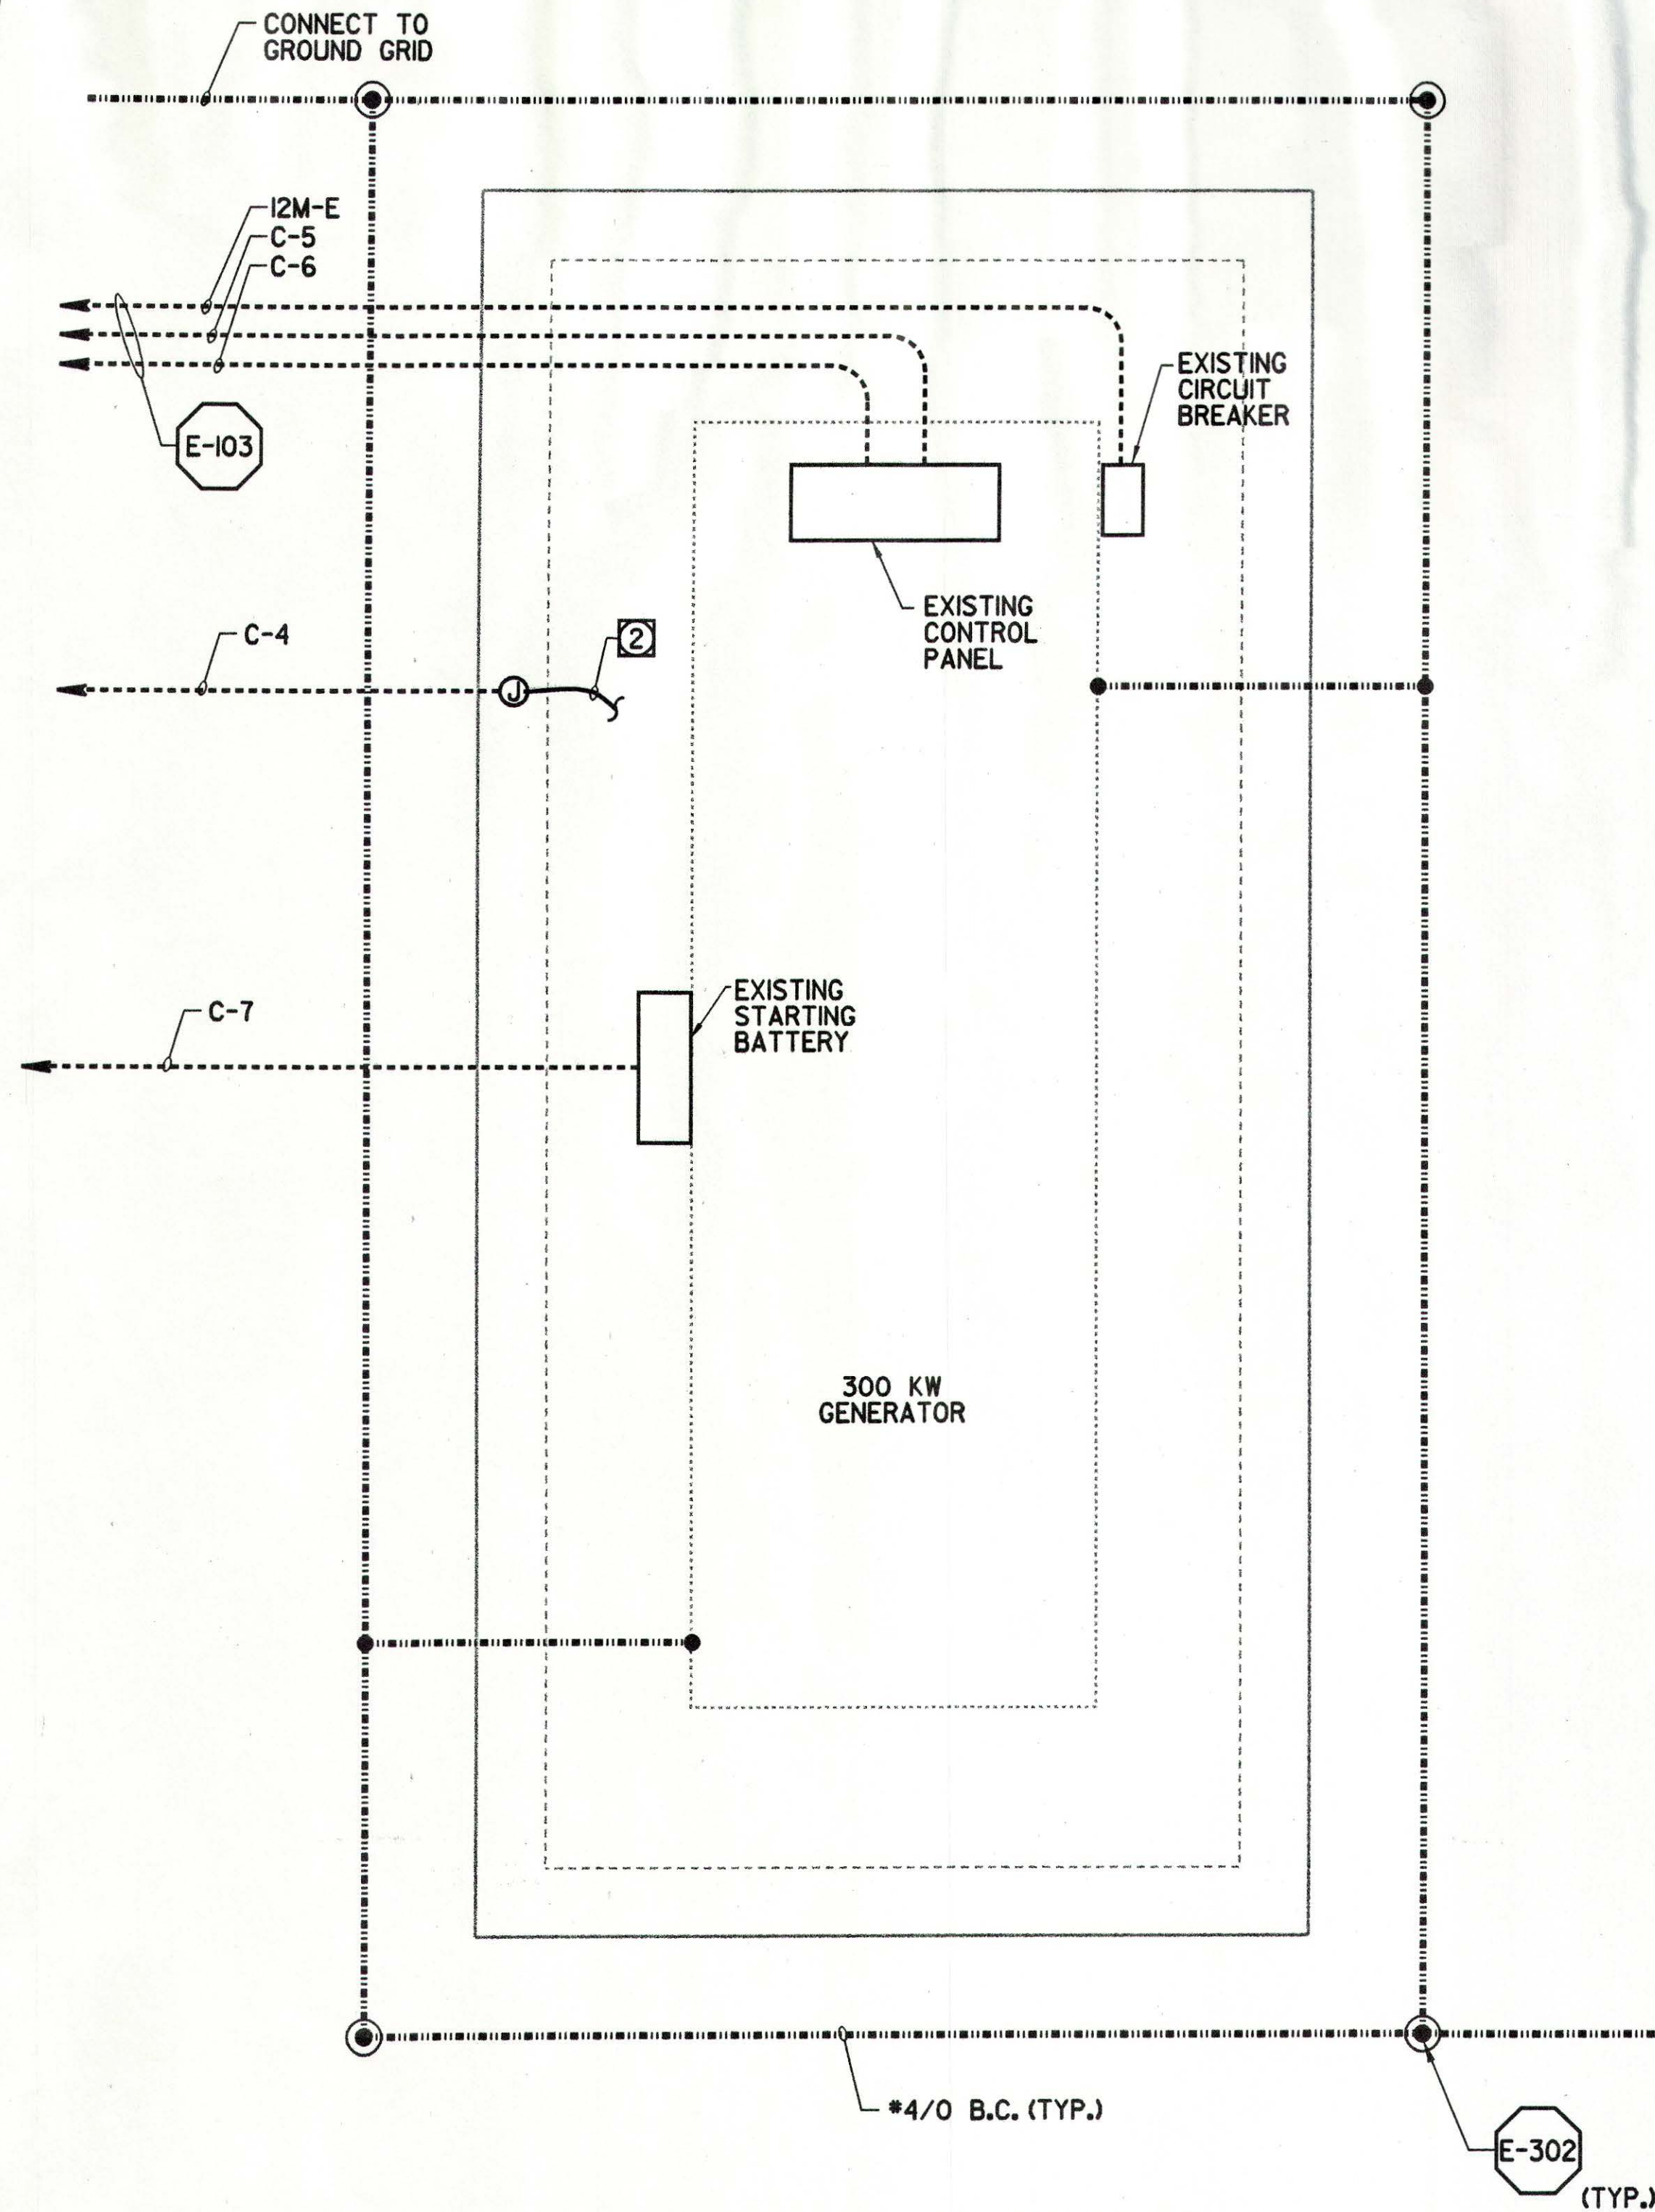



**RELOCATED GENERATOR PLAN**

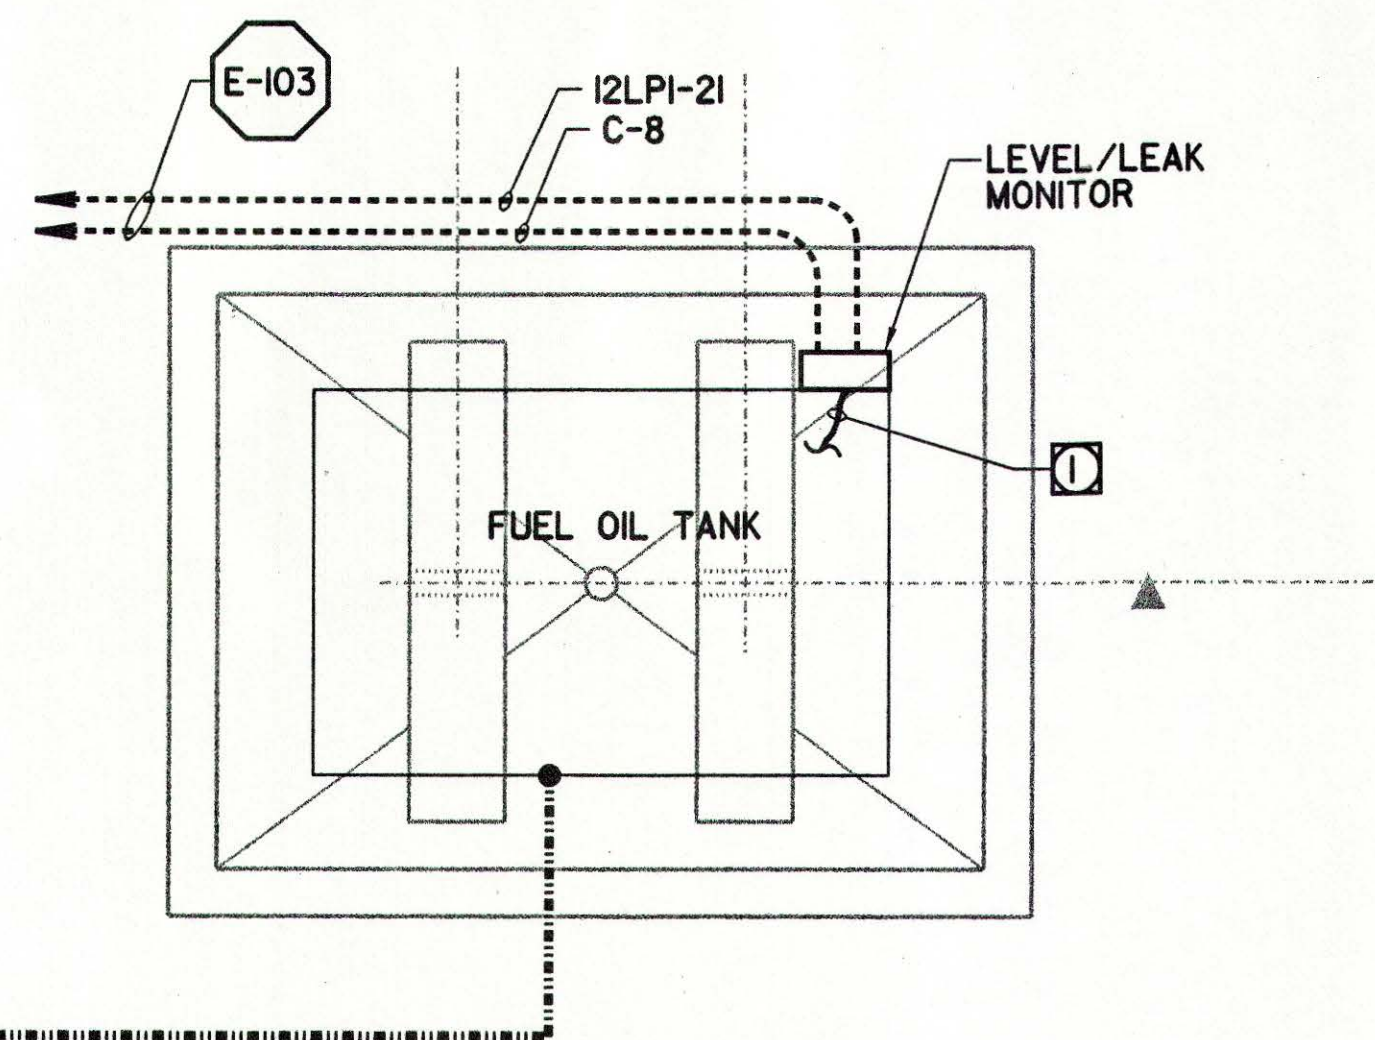

**RELOCATED FUEL TANK PLAN**

The limited review of this document by PBS & J on behalf of the Olivenhain Municipal Water District, is intended as a limited review only for general conformance with; (1) This approved Design/Build documents, (2) Accepted standards of practice within the industry, and (3) The standards of the Olivenhain Municipal Water District. This limited review in no way is intended, nor shall it act, to relieve the Design/Build Team of any professional liability to the responsibility to provide a complete and functional facility that is compliant with all applicable specifications, standards, codes, and regulations.

PBS & J  
Date 8/23/01 By *[Signature]*

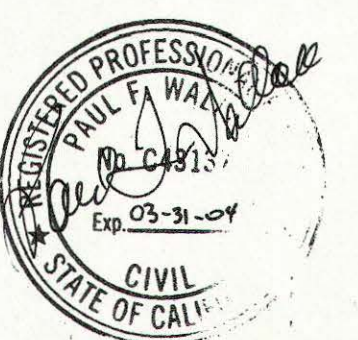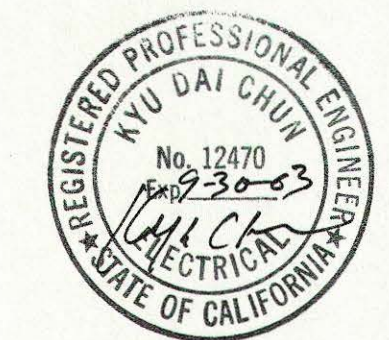












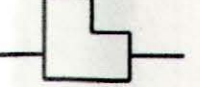
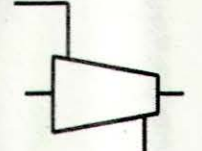
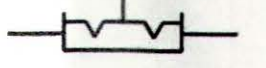






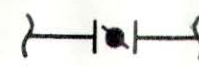






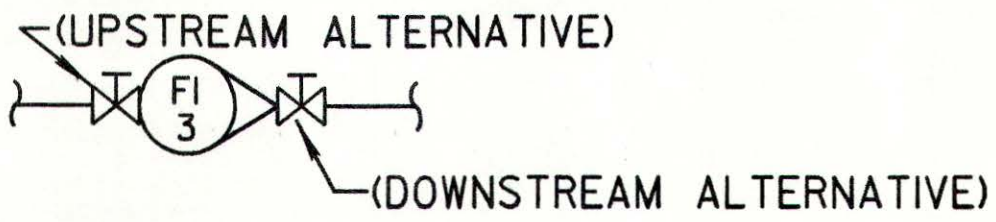
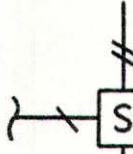
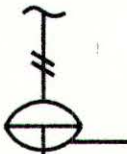
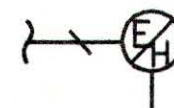
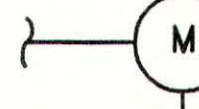
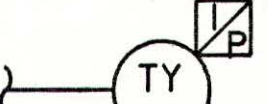
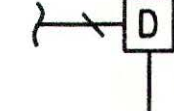


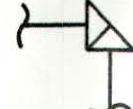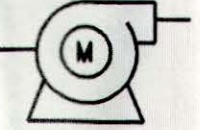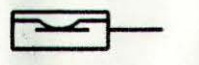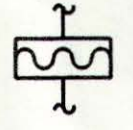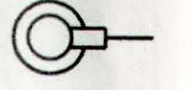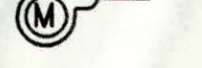

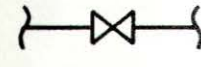					SCALE		<div>WARNING</div> <div>0 1/2</div>		DESIGNED <u>K.D. CHUN</u>		SUBMITTED BY <u><i>George R. Bant</i></u>		APPROVED <u><i>George R. Bant</i></u> <u>8.29.01</u>		KELWOOD DEVELOPMENT COMPANY		SHEET	
					1/2"=1'-0"		IF THIS BAR DOES NOT MEASURE 1" THEN DRAWING IS NOT TO SCALE		DRAWN <u>N. CHRAKIAN</u>		PROJECT MANAGER <u><i>George R. Bant</i></u> <u>50802</u> <u>12/13/00</u>		OLIVENHAIN MWD <u>DATE</u>		4S RANCH SANITATION DISTRICT		12E-4	
									CHECKED <u>K.D. CHUN</u>		COMPANY OFFICER <u><i>David A. Niglar</i></u> <u>33699</u> <u>12/13/00</u>		APPROVED <u>DATE</u>		WASTEWATER TREATMENT PLANT EXPANSION TO 2.0 MGD		OF • SHEETS	
REV DATE BY OMWD DESCRIPTION											MONTGOMERY WATSON		FILANC CONSTRUCTION CO. <u>DATE</u>		NEIGHBORHOOD NO. 1 PUMP STATION			
											Pasadena, California				GENERATOR PAD AND FUEL TANK - ELECTRICAL PLAN			



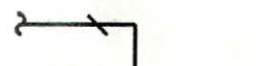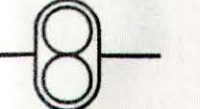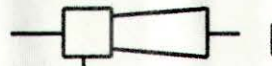

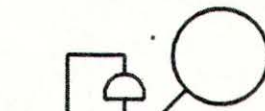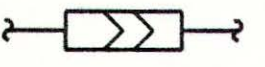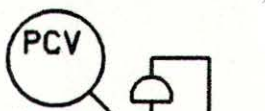

VALVE SYMBOLS				PUMP AND COMPRESSOR SYMBOLS				MISCELLANEOUS SYMBOLS			
					CENTRIFUGAL PUMP		PROGRESSIVE CAVITY PUMP	 DIAPHRAGM SEAL			
BUTTERFLY	GLOBE	ROTARY VALVE	ANGLE		CENTRIFUGAL WET PIT PUMP OR TURBINE PUMP		SUBMERSIBLE SUMP PUMP				
					CHEMICAL FEED PUMP		COMPRESSOR (CENTRIFUGAL), OR TURBINE MOTOR	<div>NOTES</div> <div>1. ADDITIONAL INSTRUMENTATION AND CONTROL SYMBOLS MAY BE USED AS REQUIRED. SYMBOLS AND NOMENCLATURE ARE BASED ON ISA STANDARDS S5.1, S5.2, S5.4.</div> <div>2. SEE ASSOCIATED ELECTRICAL AND MECHANICAL SYMBOL SHEETS FOR ADDITIONAL SYMBOLS AND ABBREVIATIONS.</div> <div>3. FOR PIPE SIZES, MATERIAL, AS WELL AS DETAILS OF METER COUPLING AND OTHER MECHANICAL EQUIPMENT (E.G. VALVE, PUMP ETC.) SEE PROCESS AND INSTRUMENTATION DIAGRAMS, MECHANICAL DRAWINGS AND SPECIFICATION.</div> <div>4. POWER SUPPLIES FOR LOOPS OR SYSTEMS SHALL BE FURNISHED BY THE INSTRUMENTATION SUPPLIER TO MEET THE PARTICULAR CHARACTERISTICS (E.G. VOLTAGE AND CURRENT REQUIREMENTS) OF COMPONENTS IN EACH LOOP OR SYSTEM.</div>			
SWING CHECK VALVE	BALL CHECK VALVE	GATE VALVE	PLUG VALVE		DIAPHRAGM PUMP		COMPRESSOR (PISTON)				
					GEAR PUMP OR BLOWER (POSITIVE DISPLACEMENT)		EJECTOR				
BALL VALVE	VACUUM RELIEF VALVE	PRESSURE RELIEF OR SAFETY VALVE	SOLENOID VALVE		PISTON PUMP		BLOWER				
											
BACKPRESSURE REGULATOR	BACKFLOW PREVENTOR	PRESSURE-REDUCING REGULATOR	LEVEL CONTROL VALVE LINKAGE								
											
(UPSTREAM ALTERNATIVE) (DOWNSTREAM ALTERNATIVE) INDICATING VARIABLE AREA METER											
VALVE ACTUATORS											
											
SOLENOID	DIAPHRAGM PRESSURE-BALANCED	ELECTROHYDRAULIC									
											
ROTARY MOTOR (SHOWN TYPICALLY WITH ELECTRIC SIGNAL, MAY BE HYDRAULIC OR PNEUMATIC)	VALVE ACTUATOR WITH ATTACHED ELECTRO-PNEUMATIC CONVERTER	DIGITAL									
											
WITH OR WITHOUT POSITIONER OR OTHER PILOT	PREFERRED FOR DIAPHRAGM ASSEMBLED WITH PILOT. ONE INPUT SHOWN (TYP. WITH ELECTRIC INPUT)										
DIAPHRAGM, SPRING-OPPOSED OR UNSPECIFIED ACTUATOR											
				</							



Plot Date: 05-NOV-2001 15:08


File: p:\Projects\4SR\12\12\ms\4srn1201.dwg

Job No: MW Job #

LOCAL  
OPERATOR  
INTERFACE & MMI

PLC

FIELD

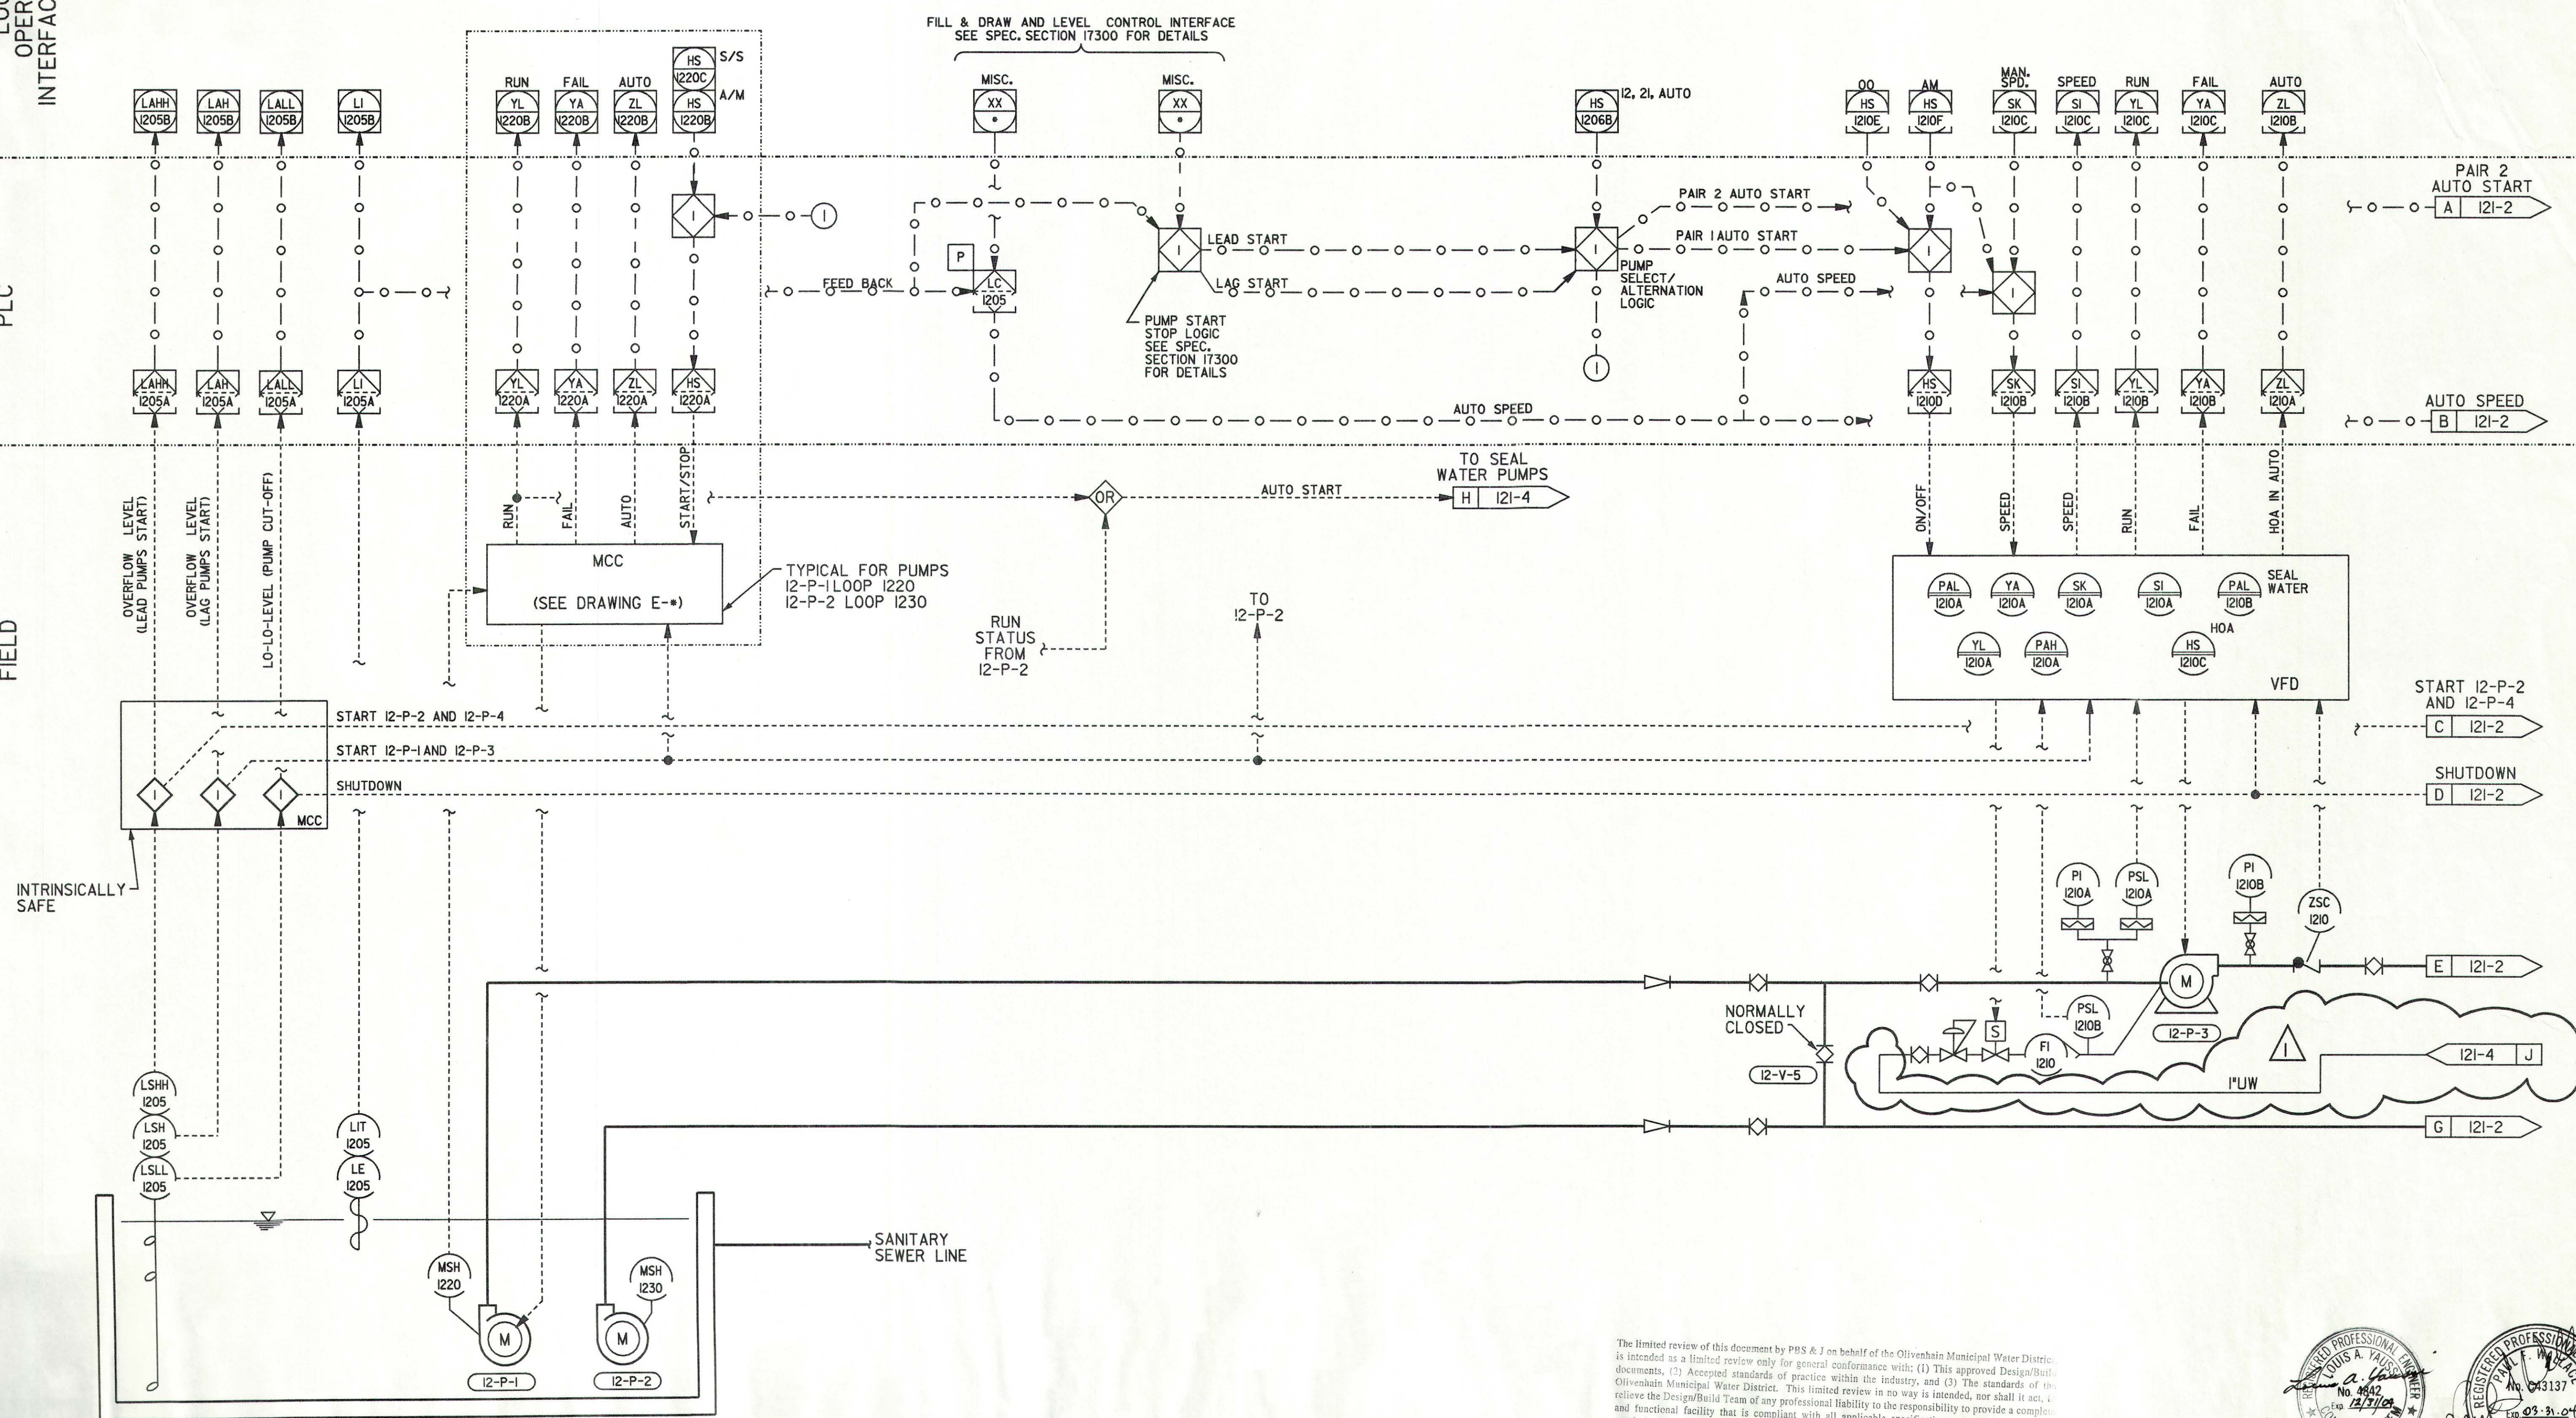

The limited review of this document by PBS & J on behalf of the Olivenhain Municipal Water District, is intended as a limited review only for general conformance with: (1) This approved Design/Build documents, (2) Accepted standards of practice within the industry, and (3) The standards of the Olivenhain Municipal Water District. This limited review in no way is intended, nor shall it act, to relieve the Design/Build Team of any professional liability to the responsibility to provide a complete and functional facility that is compliant with all applicable specifications, standards, codes, and regulations.

PBS & J  
Date: 12/19/01 By: [Signature]



				SCALE		WARNING 0 1/2 1 IF THIS BAR DOES NOT MEASURE 1" THEN DRAWING IS NOT TO SCALE		DESIGNED B. ZINN		SUBMITTED BY <i>George R. Bent</i>		APPROVED <i>George R. Bent</i>		KELWOOD DEVELOPMENT COMPANY		SHEET	
				NONE				DRAWN G. KHOUDANIAN		PROJECT MANAGER		43137 11/5/01 LICENSE NO. DATE		4S RANCH SANITATION DISTRICT		121-1	
								CHECKED L. YAUSSI		COMPANY OFFICER		33699 11/5/01 LICENSE NO. DATE		WASTEWATER TREATMENT PLANT EXPANSION TO 2.0 MGD		OF 5 SHEETS	
REV DATE BY OMWD DESCRIPTION												MONTGOMERY WATSON Pasadena, California		NEIGHBORHOOD NO. 1 PUMP STATION P & ID - 1			



15:07

Plot Date: 05-NOV-2001


File: D:\Projects\ASR\2\ins\4srn12102.dwg

Job No: MW Job #

LOCAL  
OPERATOR  
INTERFACE & MMI

PLC

FIELD

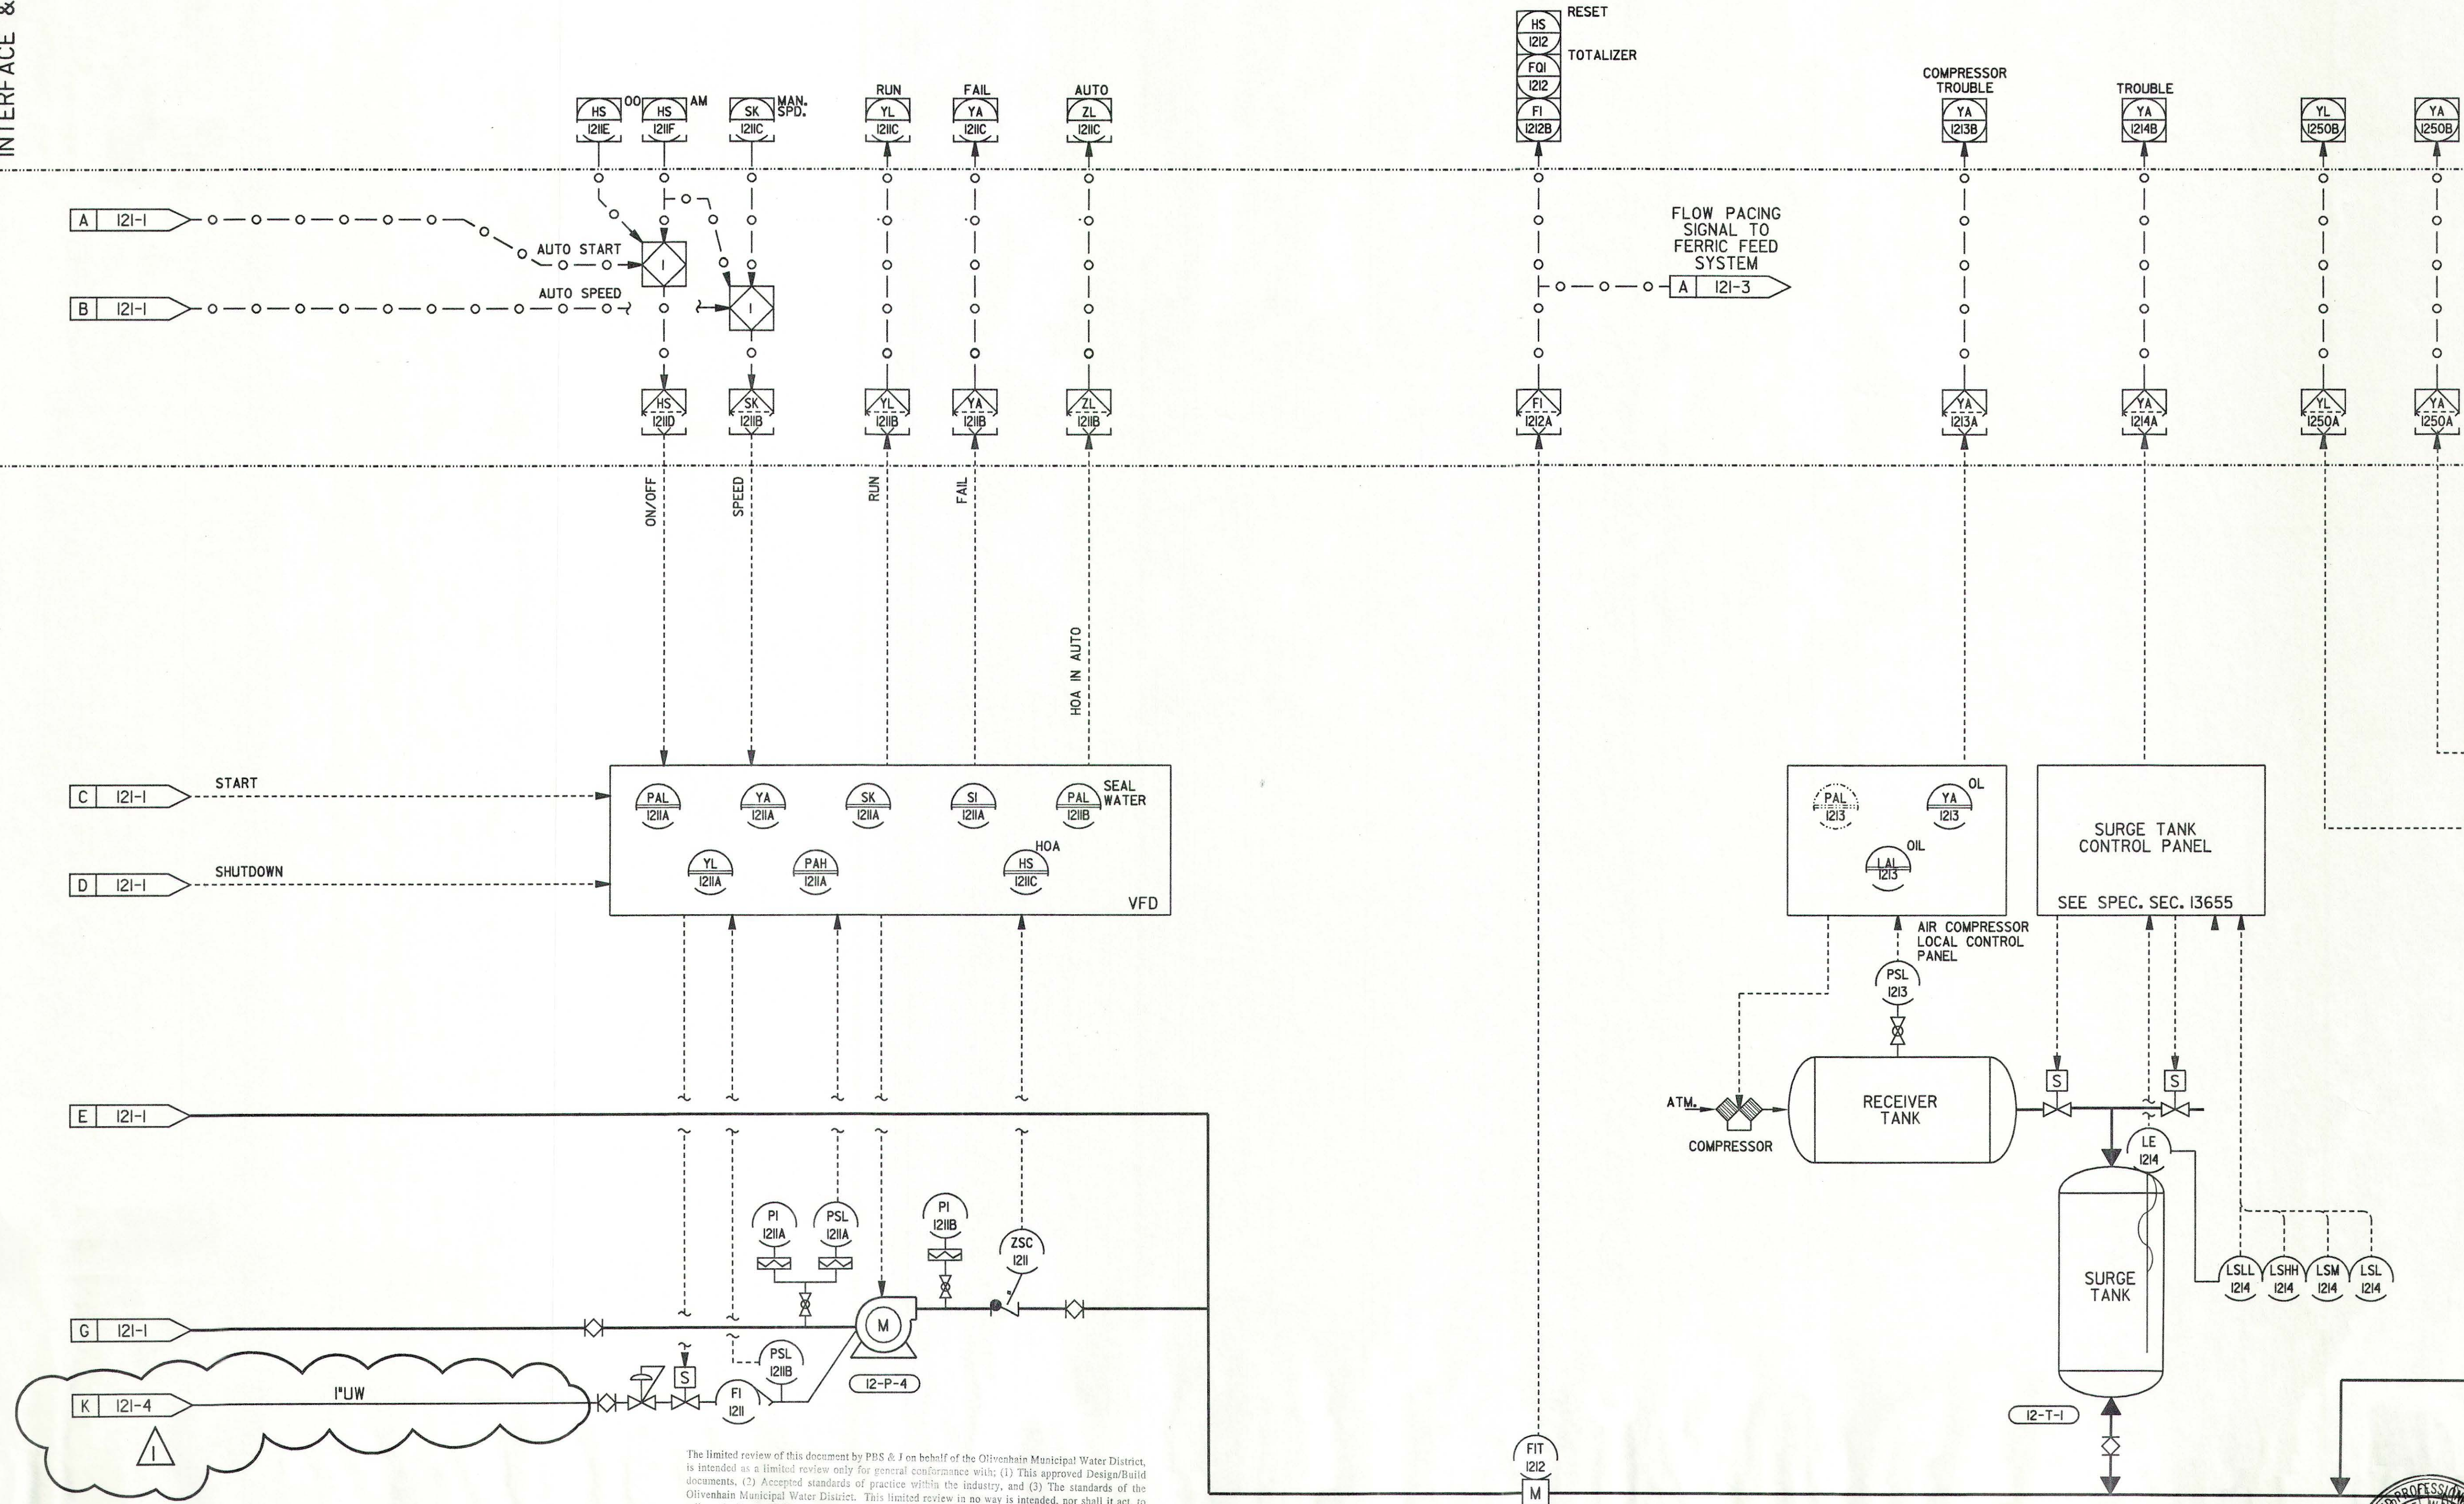

The limited review of this document by PBS & J on behalf of the Olivenhain Municipal Water District, is intended as a limited review only for general conformance with: (1) This approved Design/Build documents, (2) Accepted standards of practice within the industry, and (3) The standards of the Olivenhain Municipal Water District. This limited review in no way is intended, nor shall it act, to relieve the Design/Build Team of any professional liability to the responsibility to provide a complete and functional facility that is compliant with all applicable specifications, standards, codes, and regulations.

PBS & J  
Date: 12/19/01 By: *[Signature]*

REV	DATE	BY	OMWD	DESCRIPTION
1	10/4/01	LY		REVISE SEAL WATER CONTROLS

SCALE  
NONE

WARNING  
0 1/2 1  
IF THIS BAR DOES NOT MEASURE 1" THEN DRAWING IS NOT TO SCALE

DESIGNED B. ZINN  
DRAWN G. KHOUDANIAN  
CHECKED L. YAUSSI

SUBMITTED BY *[Signature]*  
PROJECT MANAGER  
COMPANY OFFICER

43137  
LICENSE NO.  
11/5/01  
DATE  
33699  
LICENSE NO.  
11/5/01  
DATE



MONTGOMERY WATSON  
Pasadena, California

APPROVED *[Signature]*  
OLIVENHAIN MWD  
APPROVED  
FILANC CONSTRUCTION CO.


1/2/02  
DATE

KELWOOD DEVELOPMENT COMPANY  
4S RANCH SANITATION DISTRICT  
WASTEWATER TREATMENT PLANT EXPANSION TO 2.0 MGD  
NEIGHBORHOOD NO. 1 PUMP STATION  
P & ID - 11

SHEET  
121-2  
OF 5 SHEETS




- ① PLC SHALL AUTOMATICALLY ALTERNATE THE DUTY AND STANDBY PUMPS.
- ② THE PLC SHALL CALCULATE AND DISPLAY THE PUMP FEED FLOW BASED ON PUMP CHARACTERISTICS AND SPEED.

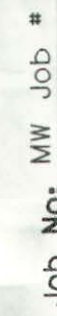

				SCALE		DESIGNED <u>B. ZINN</u>	SUBMITTED BY <u>George R. Bunt</u>	APPROVED <u>George R. Bunt</u>	KELWOOD DEVELOPMENT COMPANY	SHEET
				NONE	IF THIS BAR DOES NOT MEASURE 1" THEN DRAWING IS NOT TO SCALE	DRAWN <u>G. KHOUDANIAN</u>	<u>43137</u> <u>11/5/01</u> LICENSE NO. DATE	<u>1/2/02</u> DATE	4S RANCH SANITATION DISTRICT	121-3
						CHECKED <u>L. YAUSSI</u>	<u>33699</u> <u>11/5/01</u> LICENSE NO. DATE		WASTEWATER TREATMENT PLANT EXPANSION TO 2.0 MGD	
10/4/01 PFW REV DATE BY OMWD				EDIT NOTE				APPROVED	NEIGHBORHOOD NO. 1 PUMP STATION	OF <input type="text"/> SHEETS
								FILANC CONSTRUCTION CO.	FERRIC CHLORIDE FEED SYSTEM - P & ID	



Job No.	MW	Job #
1		
2		
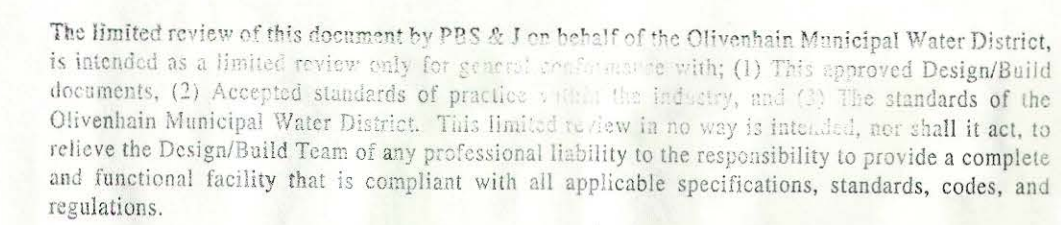

REGISTERED PROFESSIONAL ENGINEER  
 LOUIS A. GIVENS  
 No. 4472  
 Exp. 12/31/04  
 CONTROL SYSTEMS  
 STATE OF CALIFORNIA  
 11/05/01

REGISTERED PROFESSIONAL ENGINEER  
 PAUL F. WALCOTT  
 No. C49437  
 Exp. 03/31/04  
 CIVIL  
 STATE OF CALIFORNIA

				SCALE	<div>WARNING</div> <div><div><div></div><div>0</div><div>1/2</div><div>1</div></div></div>		DESIGNED L. YAUSSI			SUBMITTED BY <i>Paul S. Allen</i>			4/3/37			11/5/01			<div></div> <div>MONTGOMERY WATSON</div> <div>Pasadena, California</div>			APPROVED <i>George R. Bond</i>			1/2/02			KELWOOD DEVELOPMENT COMPANY			SHEET		
				NONE	IF THIS BAR DOES NOT MEASURE 1" THEN DRAWING IS NOT TO SCALE		DRAWN G. KHOUDANIAN			PROJECT MANAGER			LICENSE NO.			DATE						4S RANCH SANITATION DISTRICT			121-4								
							CHECKED L. YAUSSI			<i>M. J. Gail</i>			3/3/69			11/3/01			<div></div> <div>MONTGOMERY WATSON</div> <div>Pasadena, California</div>			APPROVED			DATE			WASTEWATER TREATMENT PLANT EXPANSION TO 2.0 MGD			OF * SHEET		
NEW SHEET										COMPANY OFFICER			LICENSE NO.			DATE						UTILITY WATER SYSTEM											
REV 10/4/01 BY LY OMWD DESCRIPTION																			FILANC CONSTRUCTION CO.			DATE			P & ID								